




115+00.00

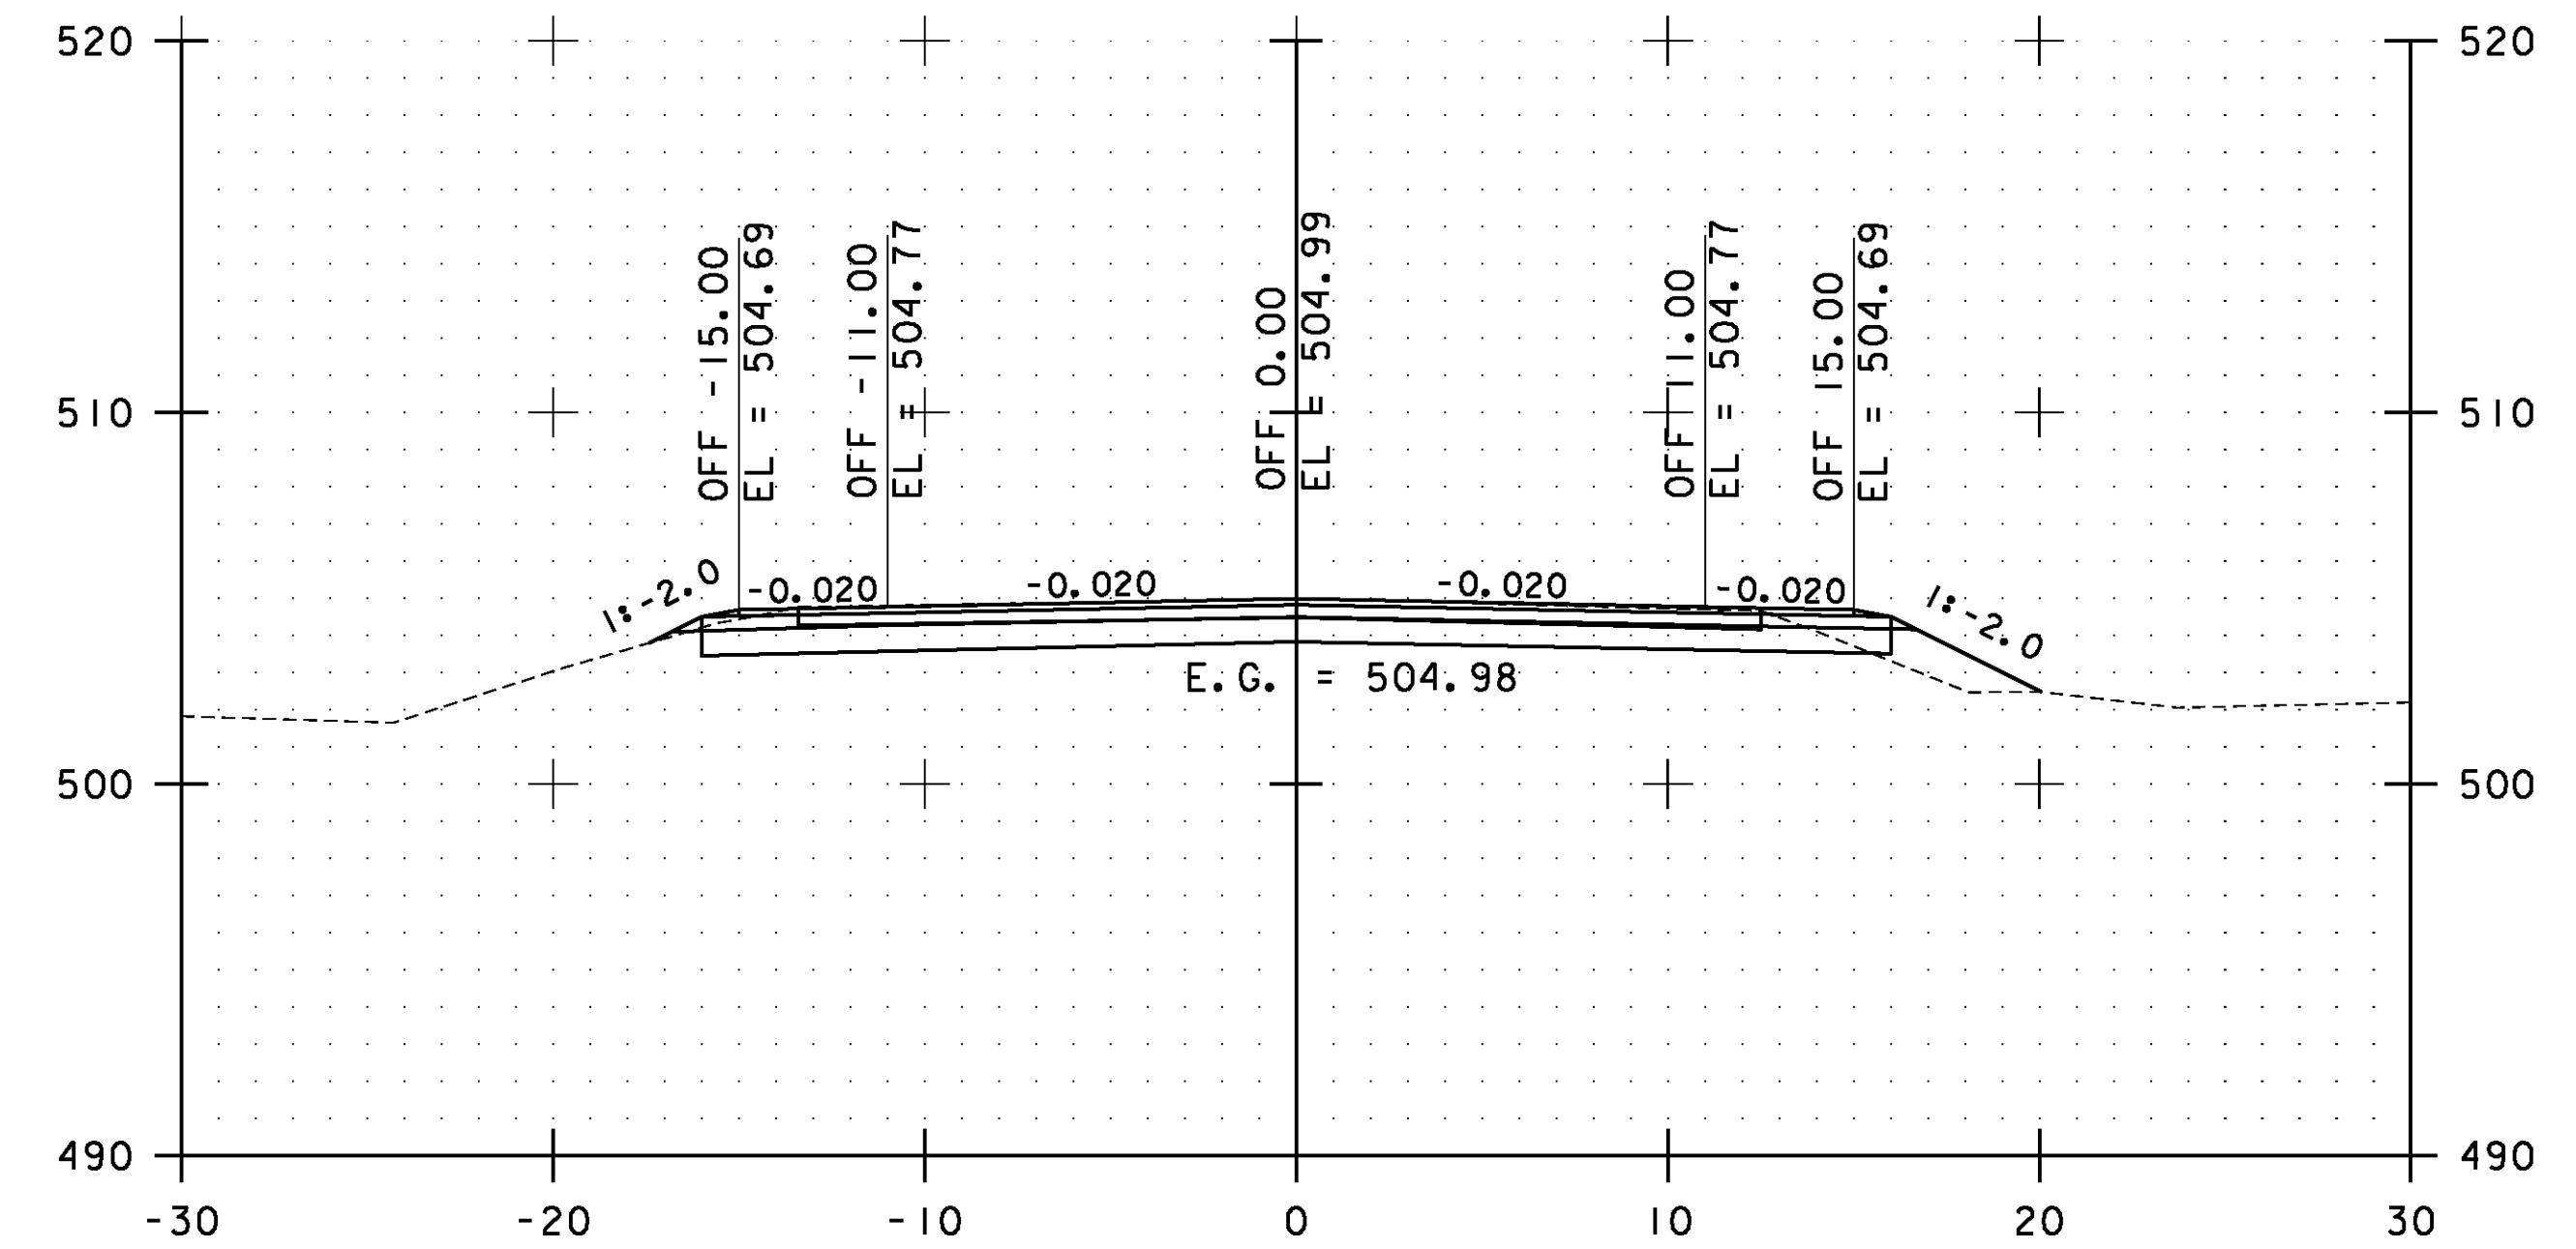

116+00.00

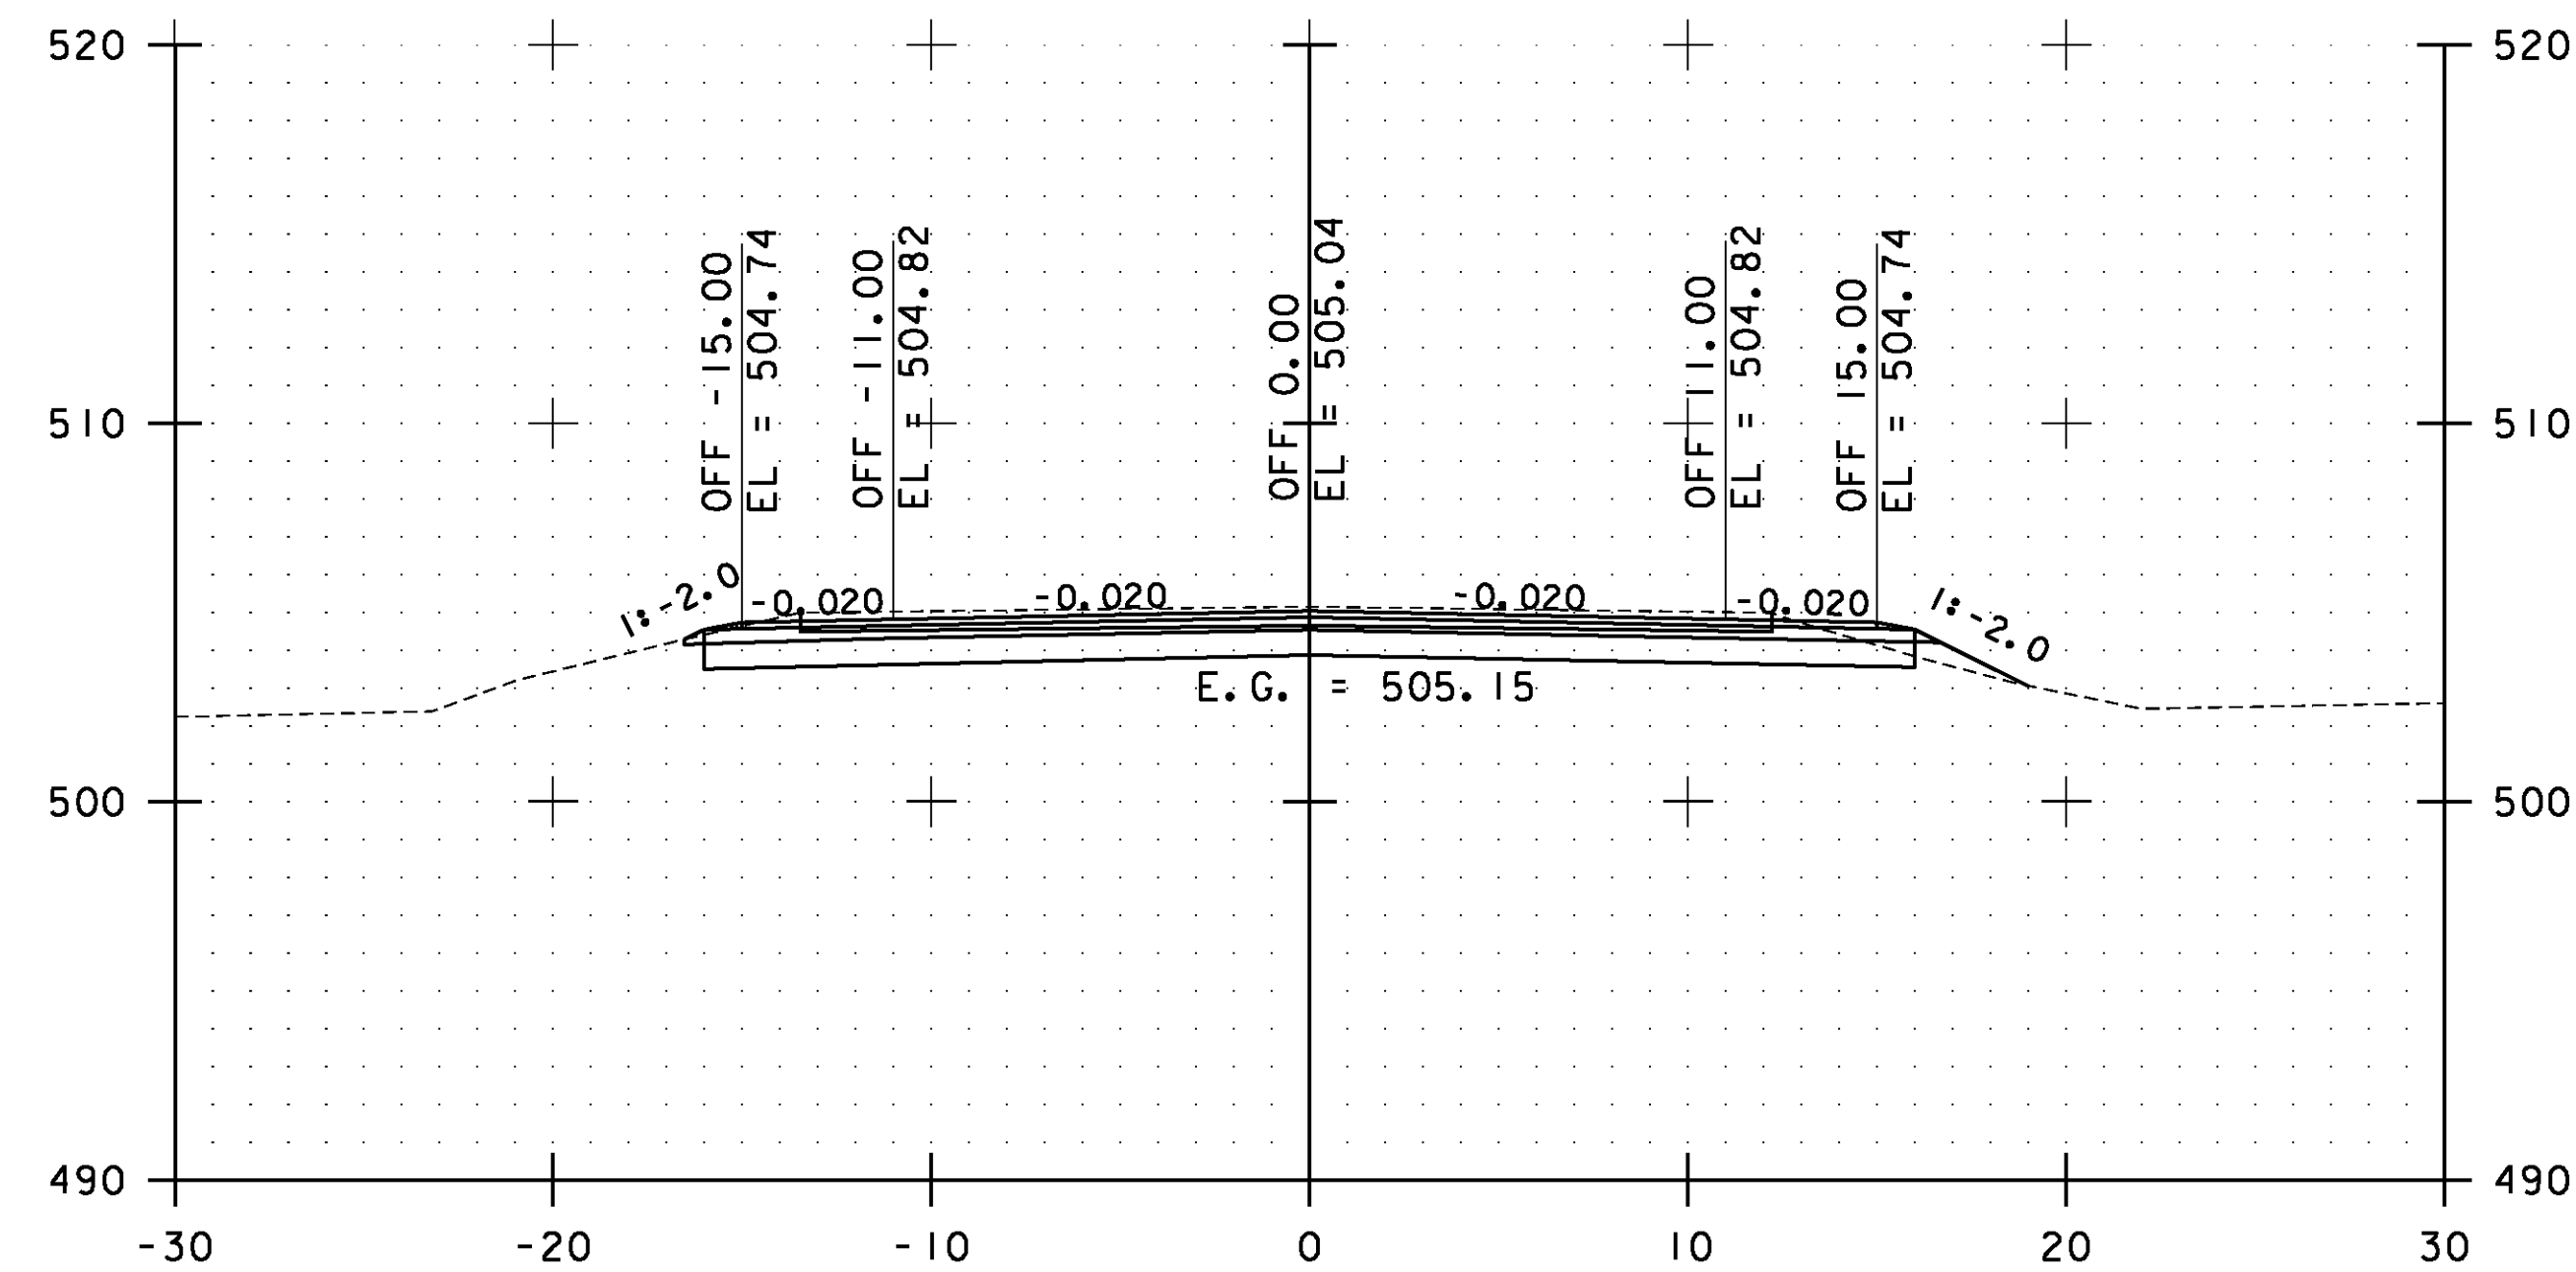


114+50.00

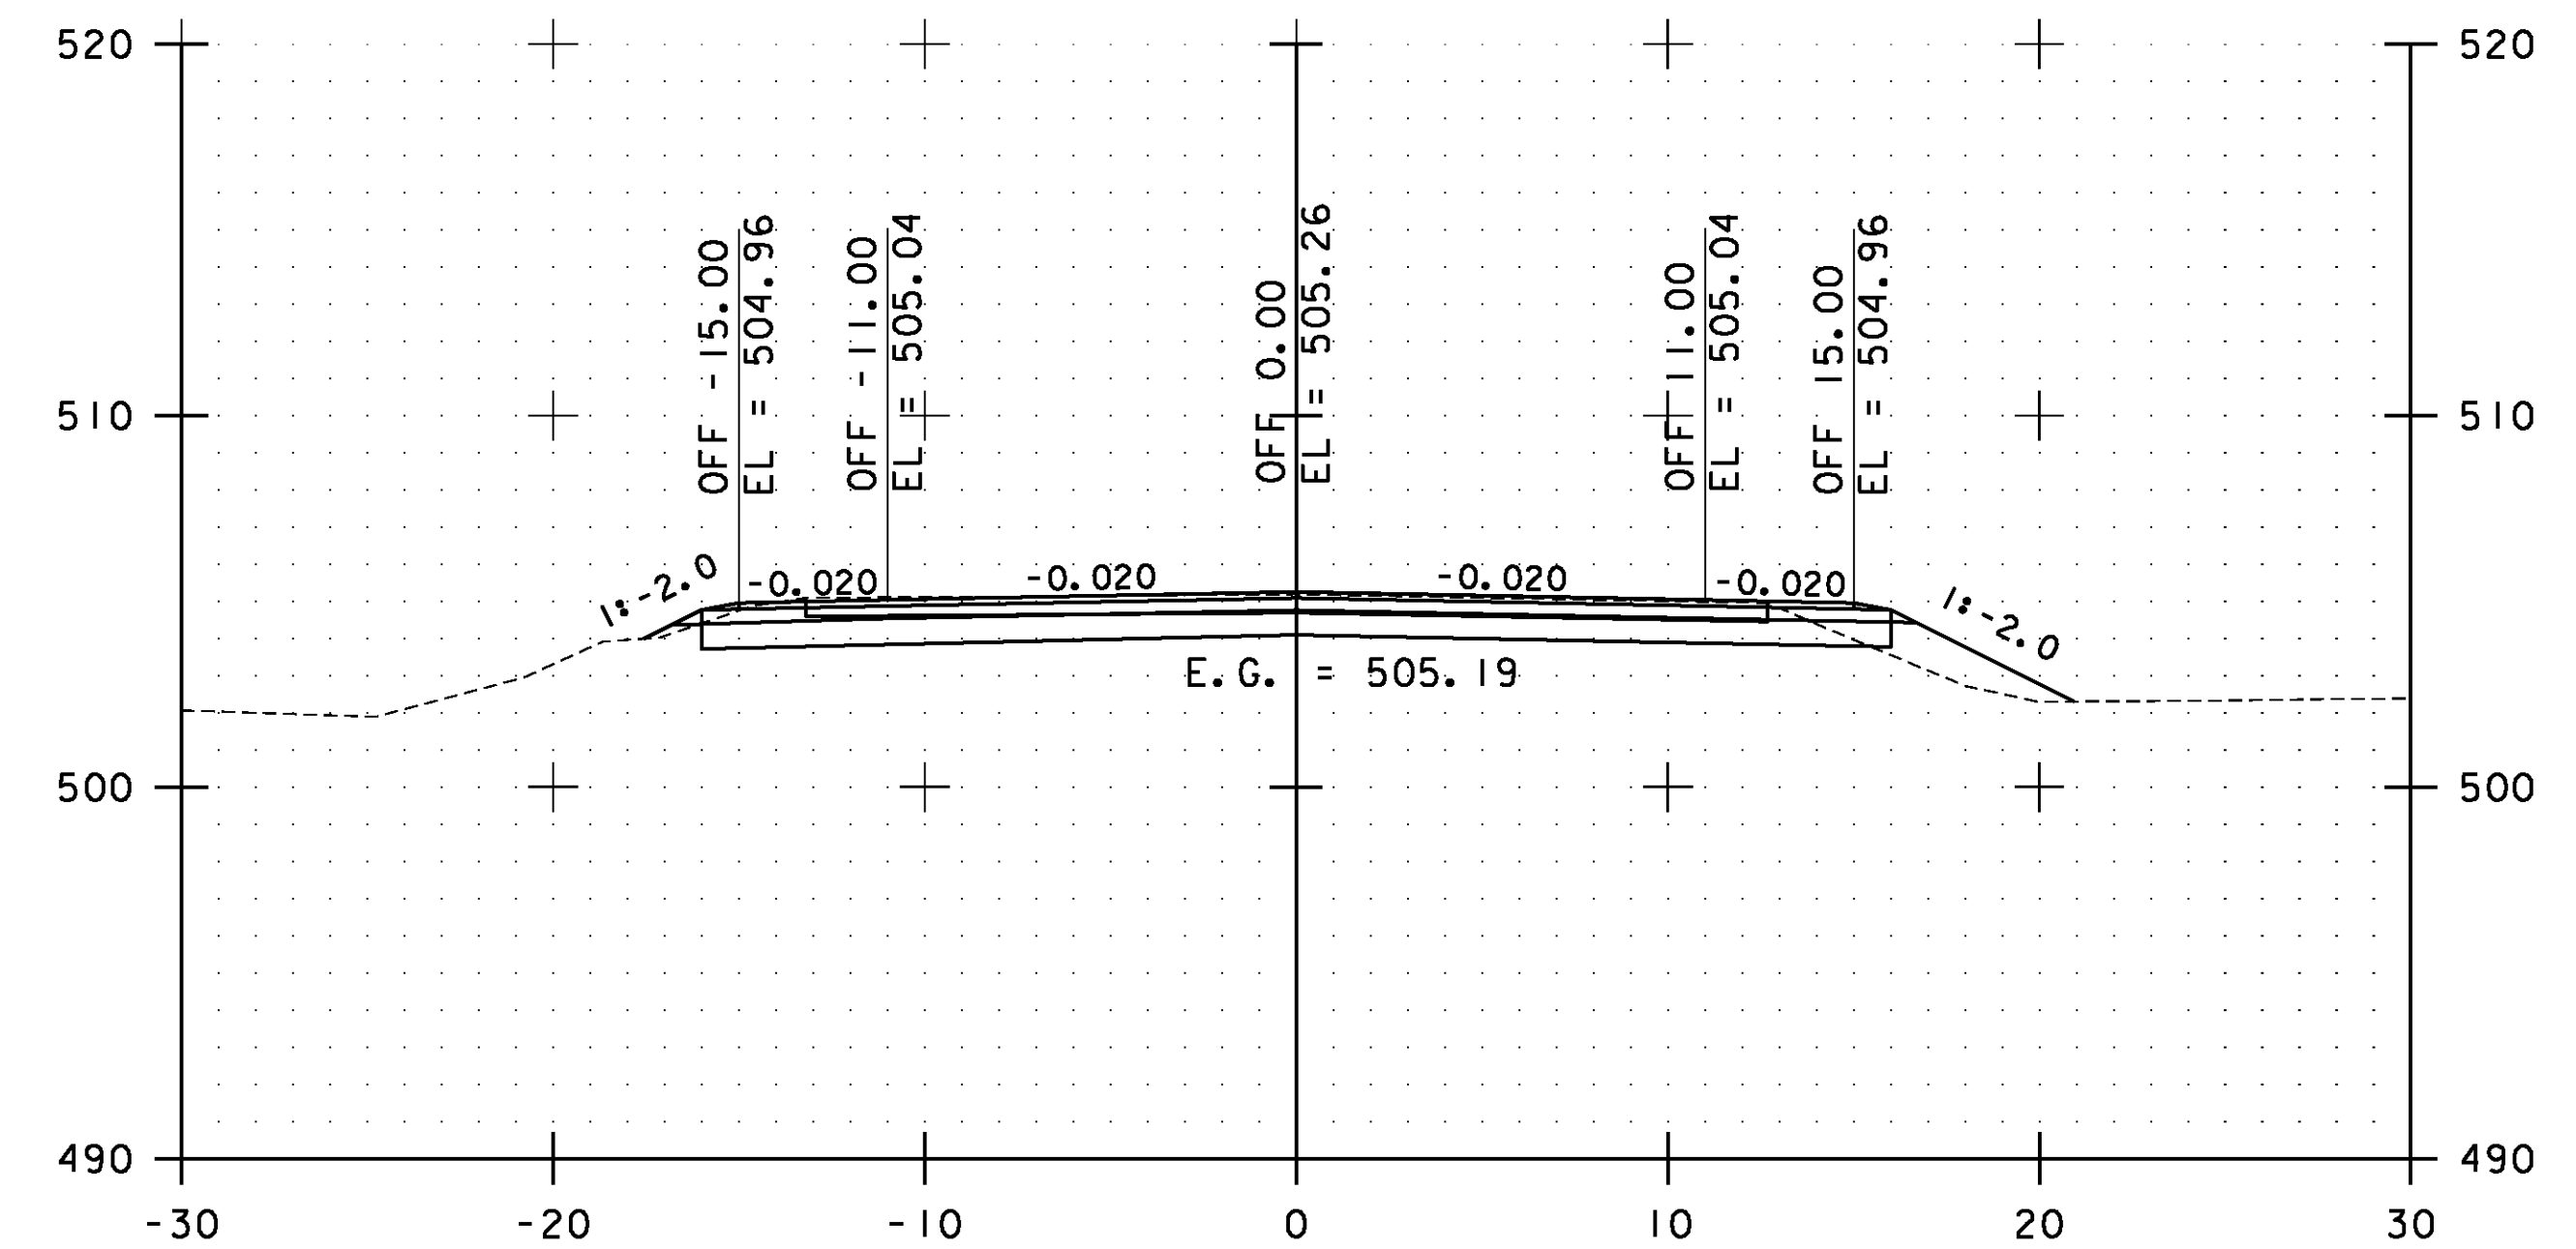

115+50.00

STA. 114+50.00 TO STA. 116+00.00

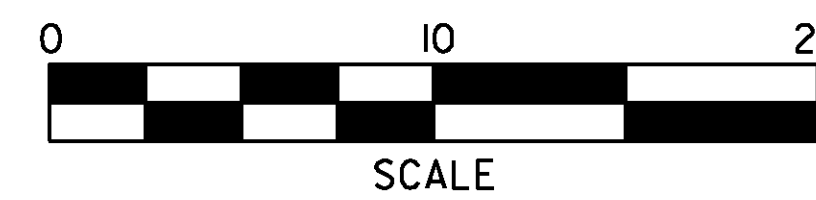

**ESSEX
CROSS
SECTIONS
SHEET #52**

PROJECT NAME: ESSEX-WESTFORD
PROJECT NUMBER: STP 2912(I)

FILE NAME: p10c226.dgn
PROJECT LEADER: JLL
DESIGNED BY: STANTEC
IPARM FILE: p10c226xs052.i

PLOT DATE: 2/20/2013
DRAWN BY: STANTEC
CHECKED BY: STANTEC
SHEET 143 OF 239