


STA. 116+50.00 TO STA. 118+00.00

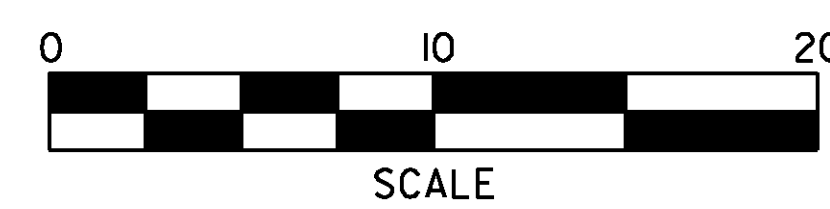

**ESSEX  
CROSS  
SECTIONS  
SHEET #53**

PROJECT NAME:	ESSEX-WESTFORD	PLOT DATE:	2/20/2013
PROJECT NUMBER:	STP 2912(I)	DRAWN BY:	STANTEC
FILE NAME:	p10c226.dgn	DESIGNED BY:	STANTEC
PROJECT LEADER:	JLL	CHECKED BY:	STANTEC
IPARM FILE:	p10c226xs053.i	SHEET	144 OF 239