


STA. 120+50.00 TO STA. 122+00.00

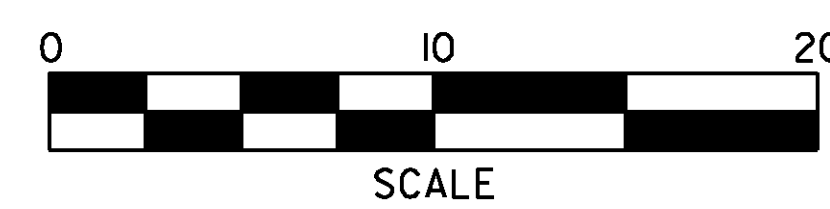

**ESSEX
CROSS
SECTIONS
SHEET #55**

PROJECT NAME: ESSEX-WESTFORD	PLOT DATE: 2/20/2013
PROJECT NUMBER: STP 2912(I)	DRAWN BY: STANTEC
FILE NAME: p10c226.dgn	CHECKED BY: STANTEC
PROJECT LEADER: JLL	SHEET 146 OF 239
DESIGNED BY: STANTEC	
IPARM FILE: p10c226xs055.i	