




125+00.00

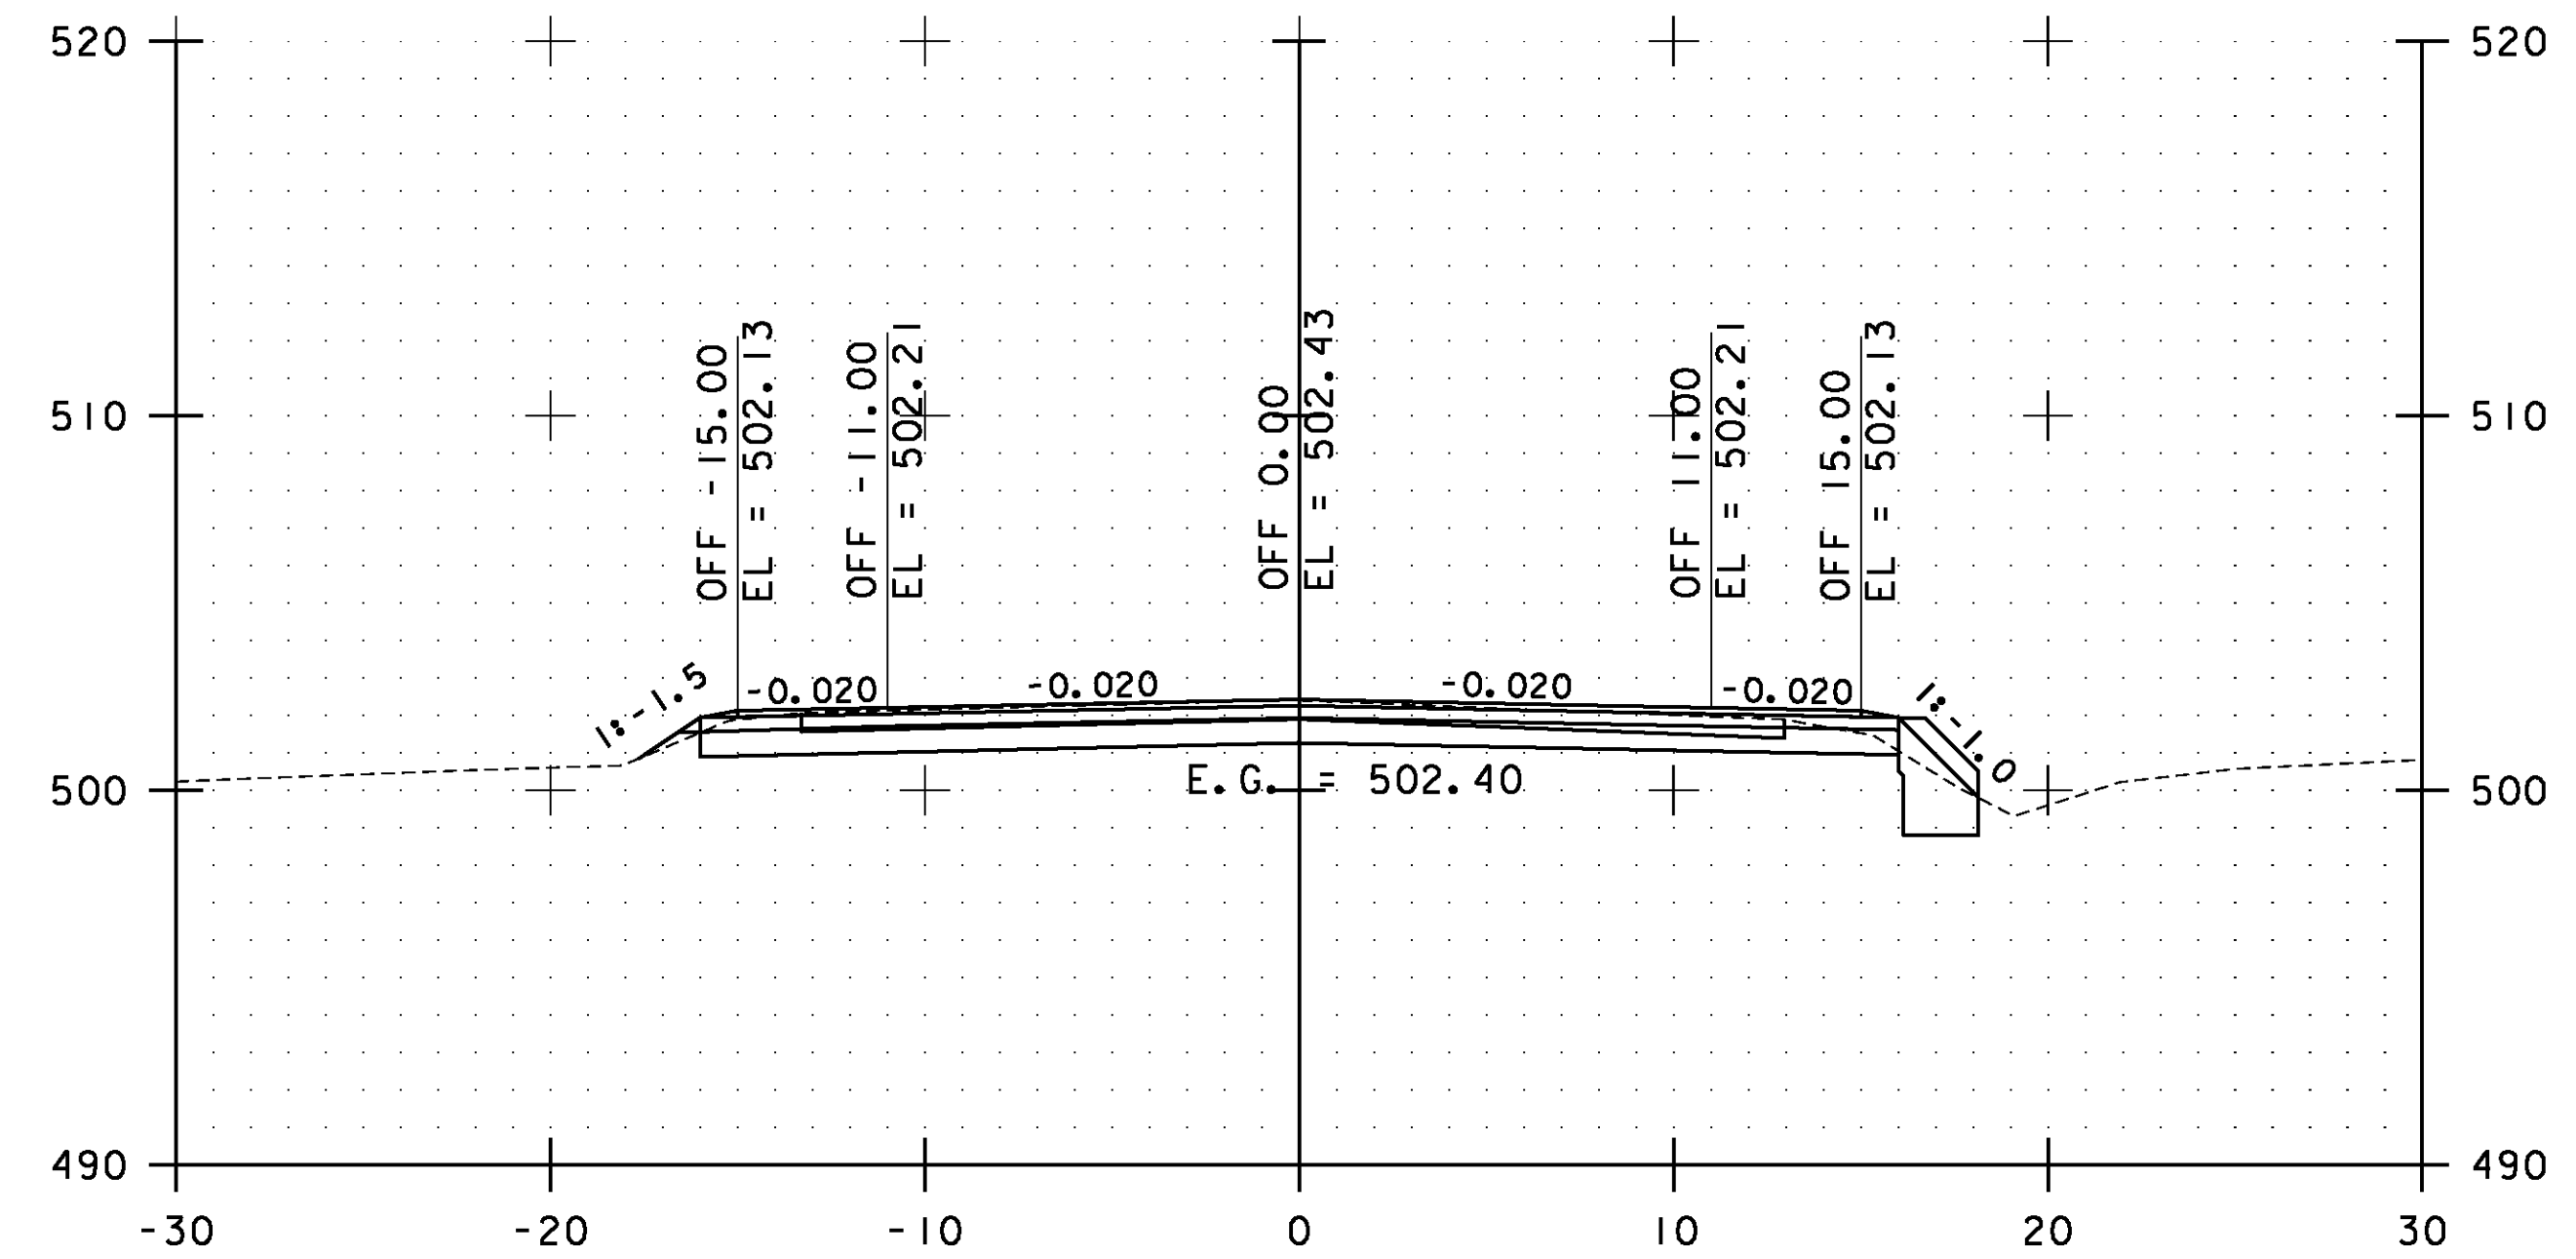

126+00.00

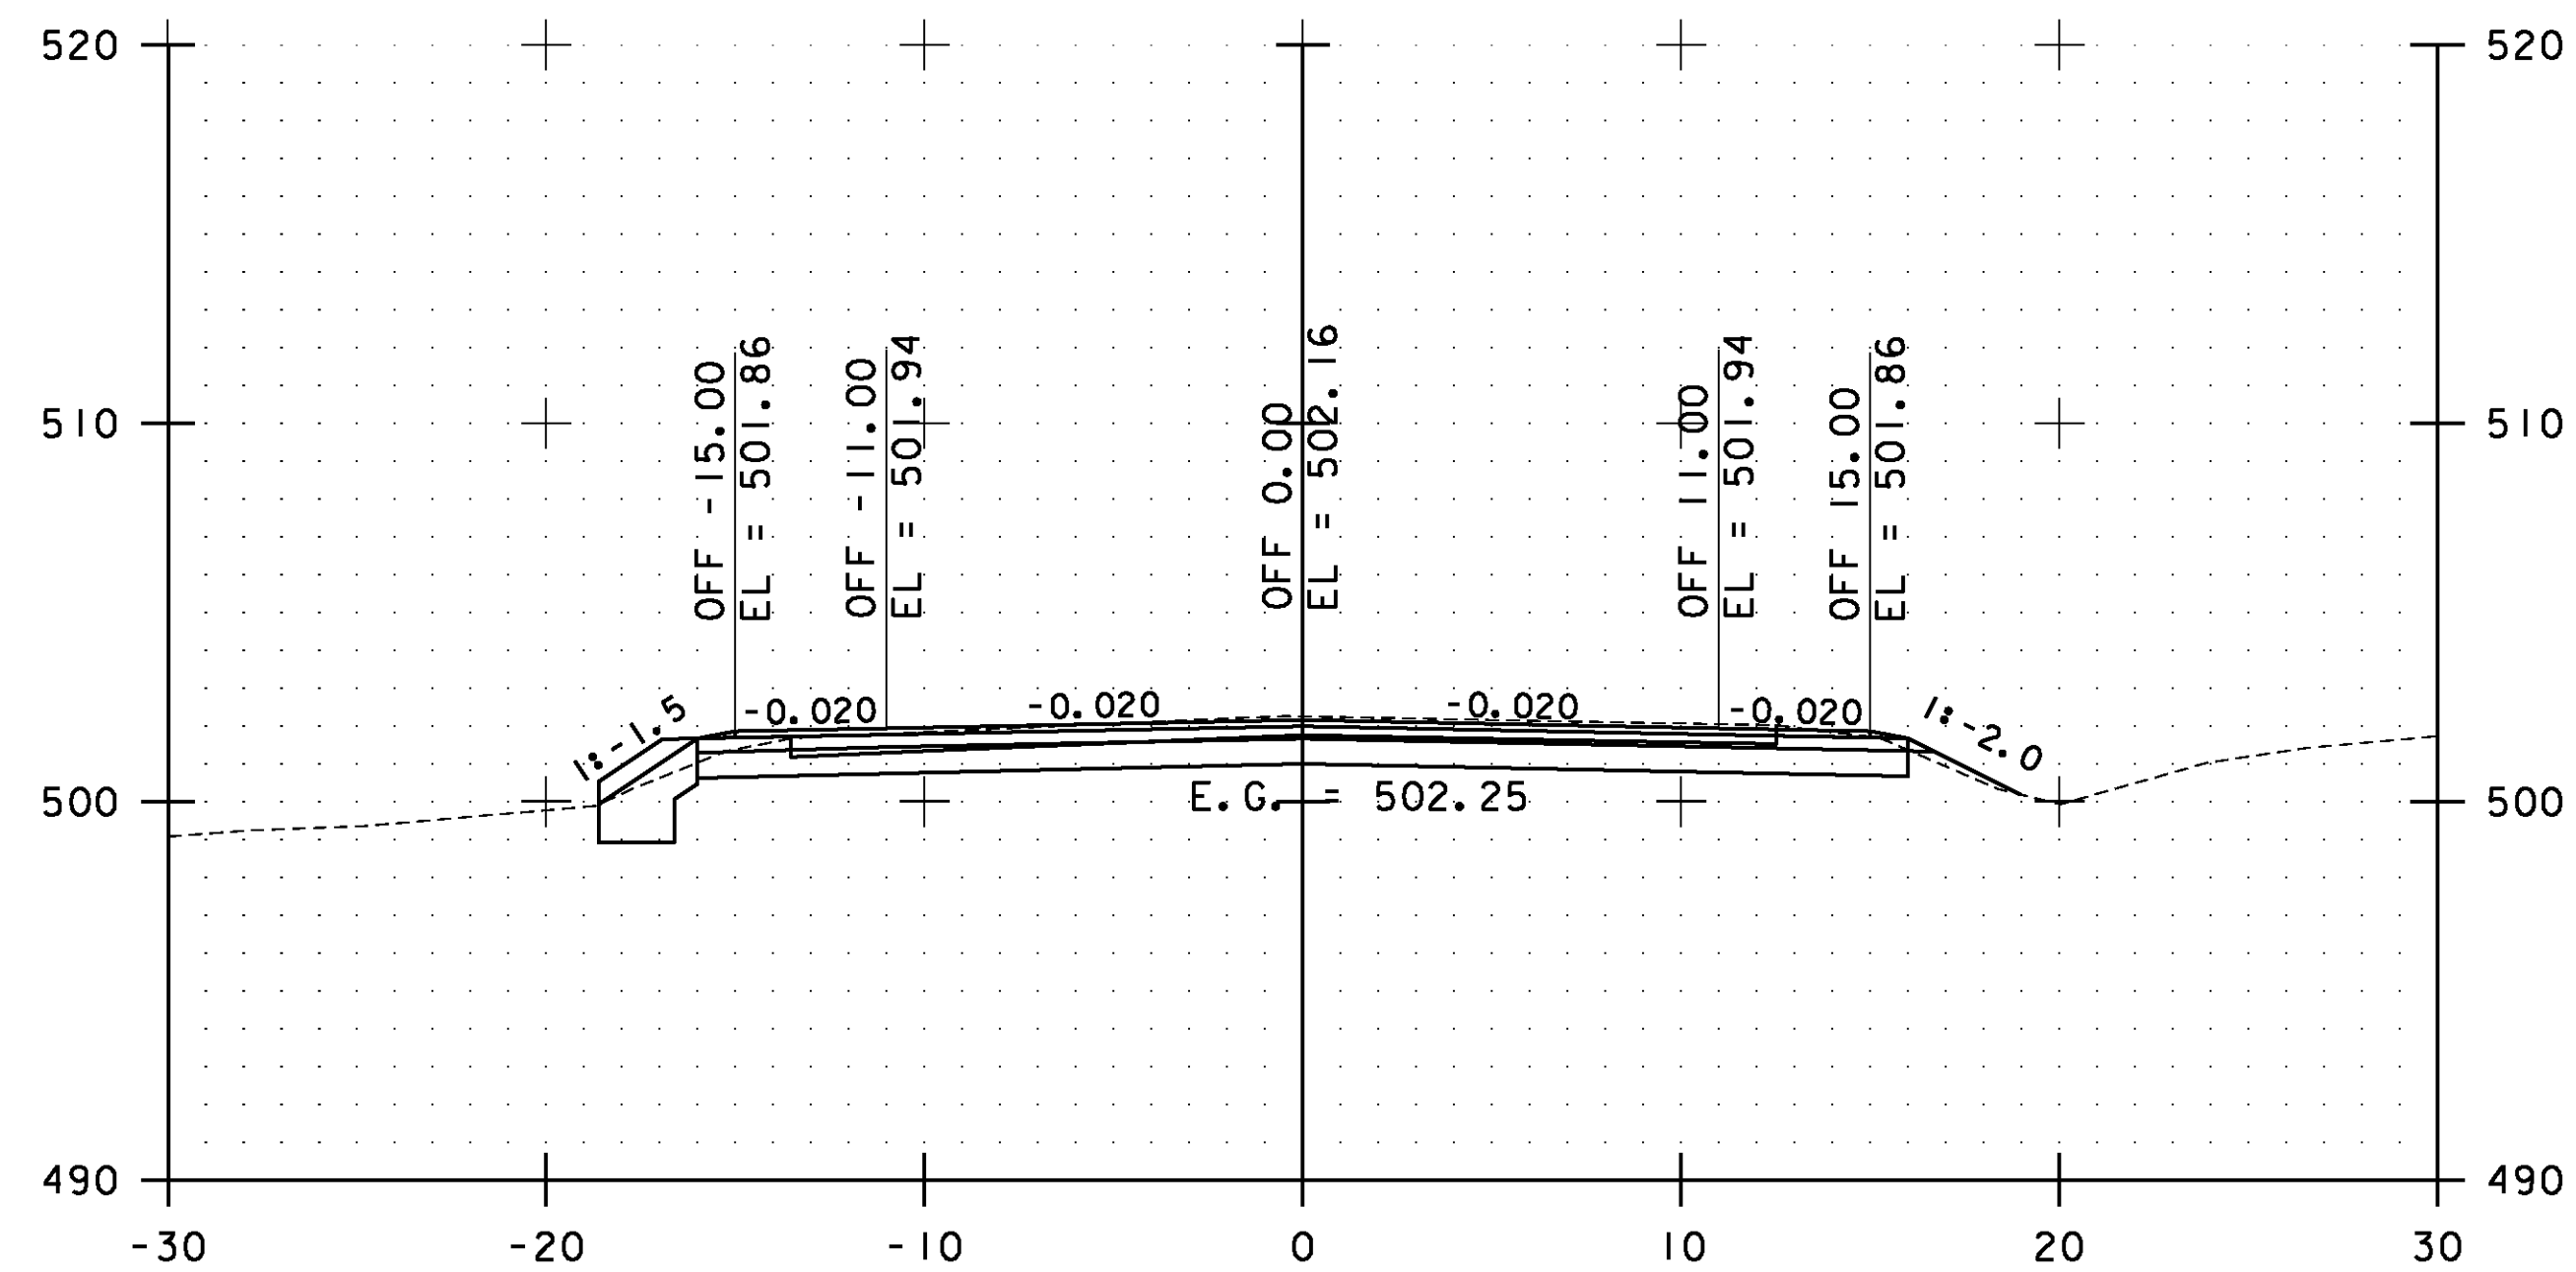

124+50.00

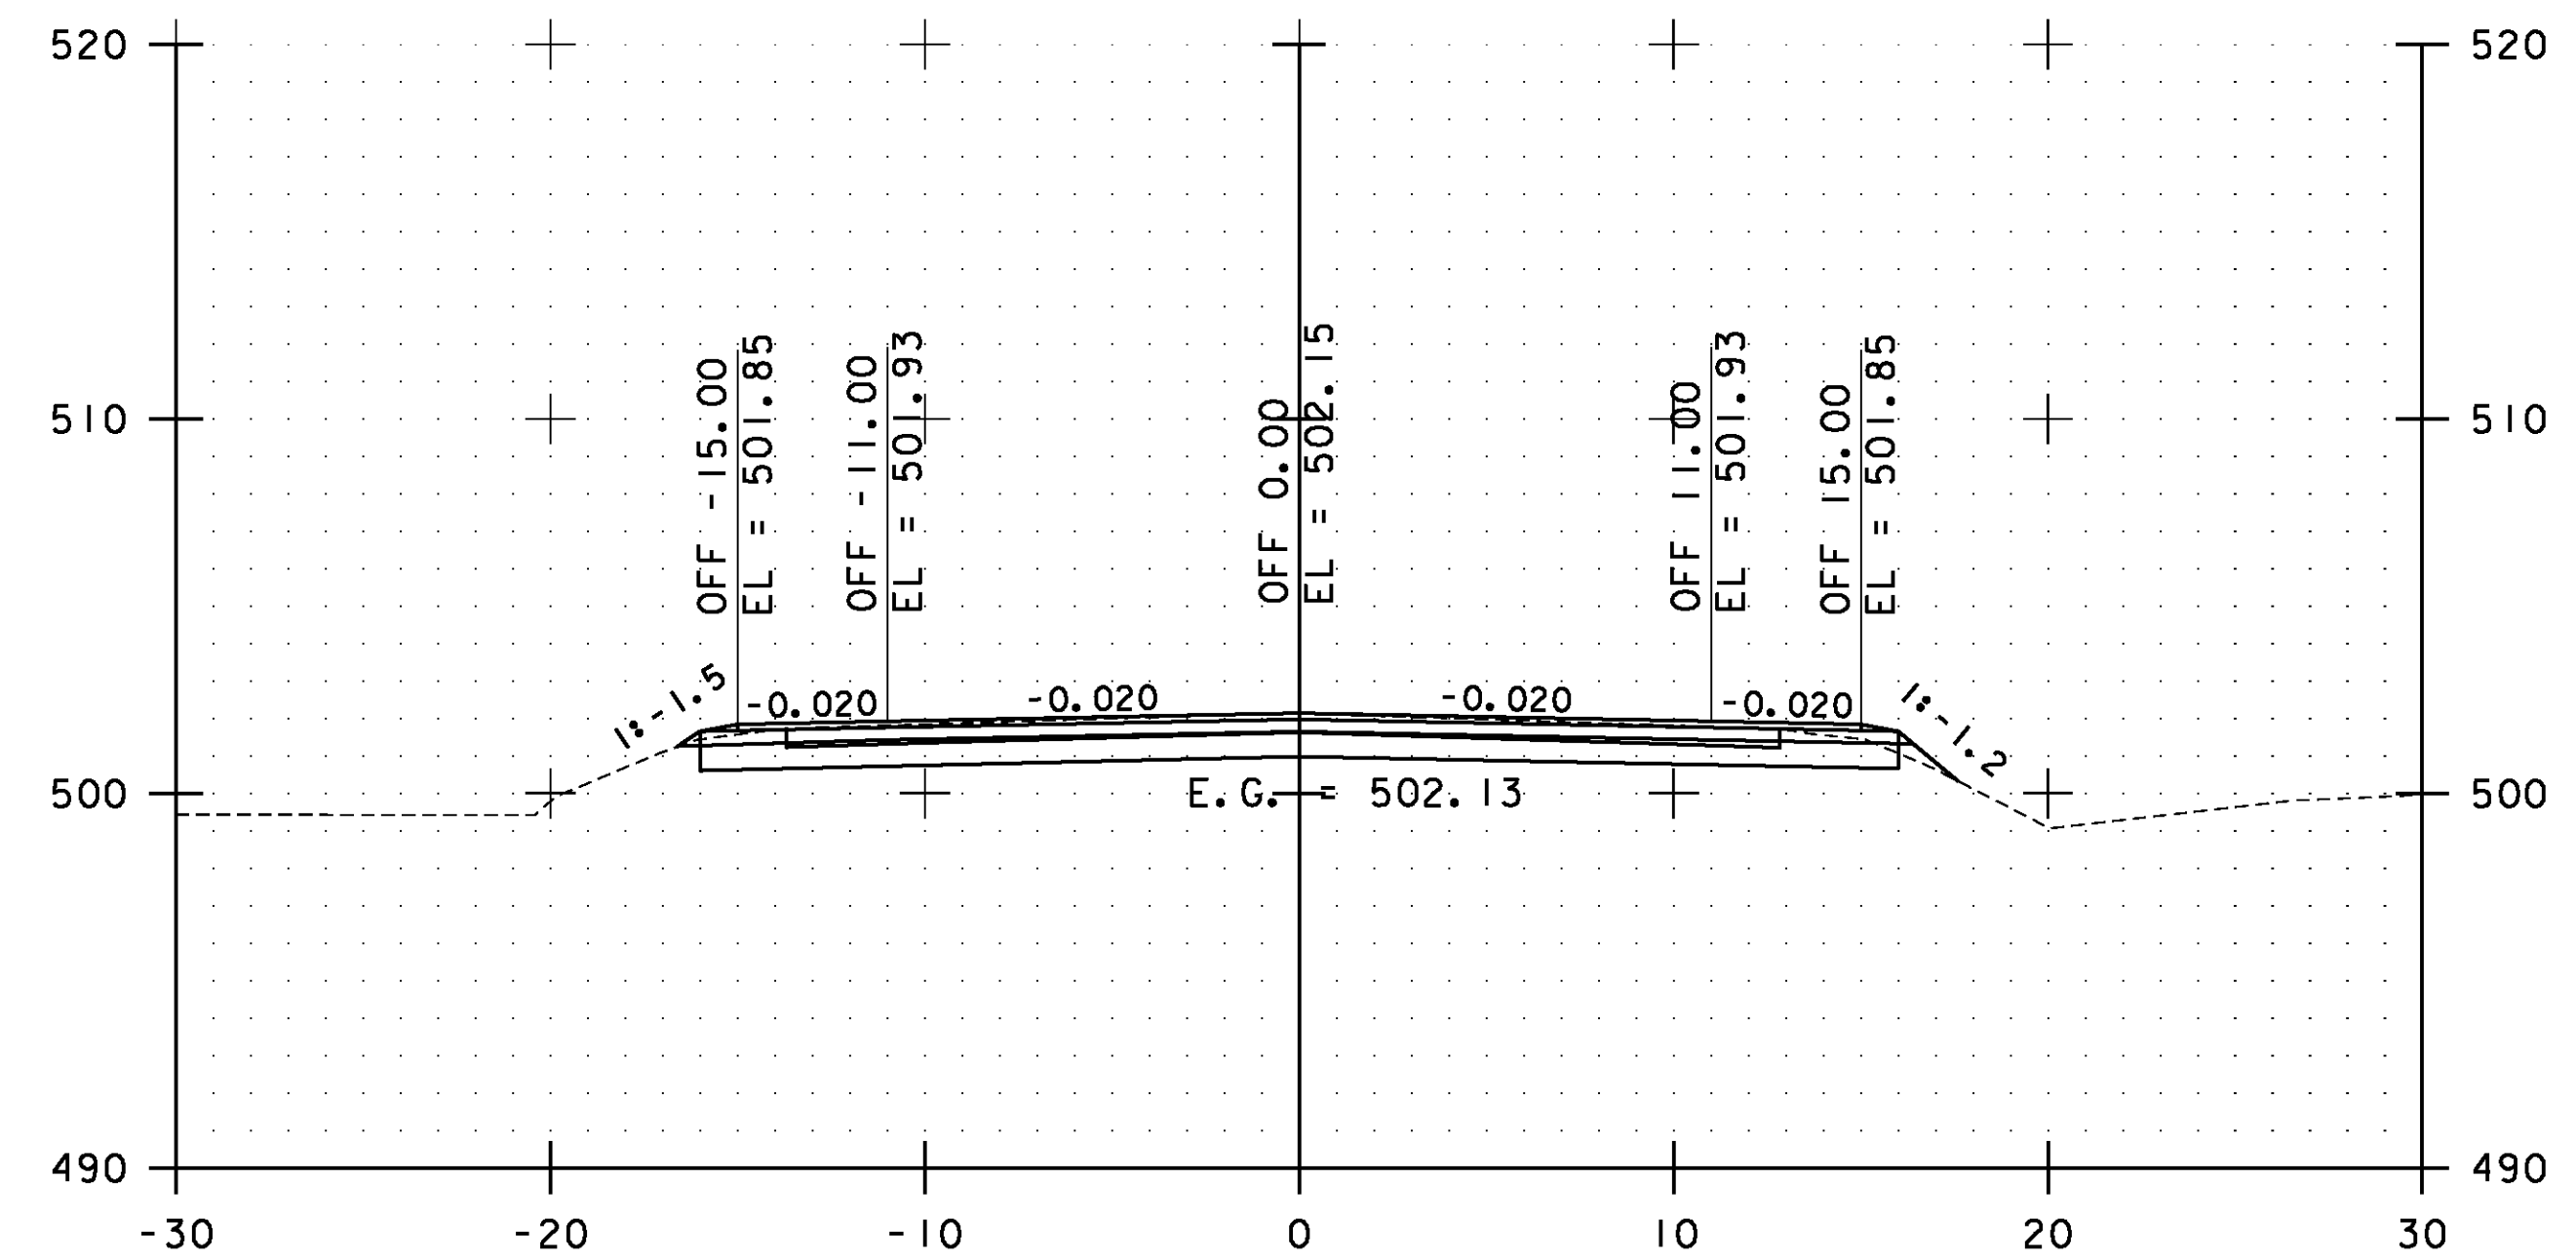

125+50.00

STA. 124+50.00 TO STA. 126+00.00



**ESSEX
CROSS
SECTIONS
SHEET #57**

PROJECT NAME:	ESSEX-WESTFORD	PLOT DATE:	2/20/2013
PROJECT NUMBER:	STP 2912(I)	DRAWN BY:	STANTEC
FILE NAME:	p10c226.dgn	DESIGNED BY:	STANTEC
PROJECT LEADER:	JLL	CHECKED BY:	STANTEC
IPARM FILE:	p10c226xs057.i	SHEET	148 OF 239