




131+00.00

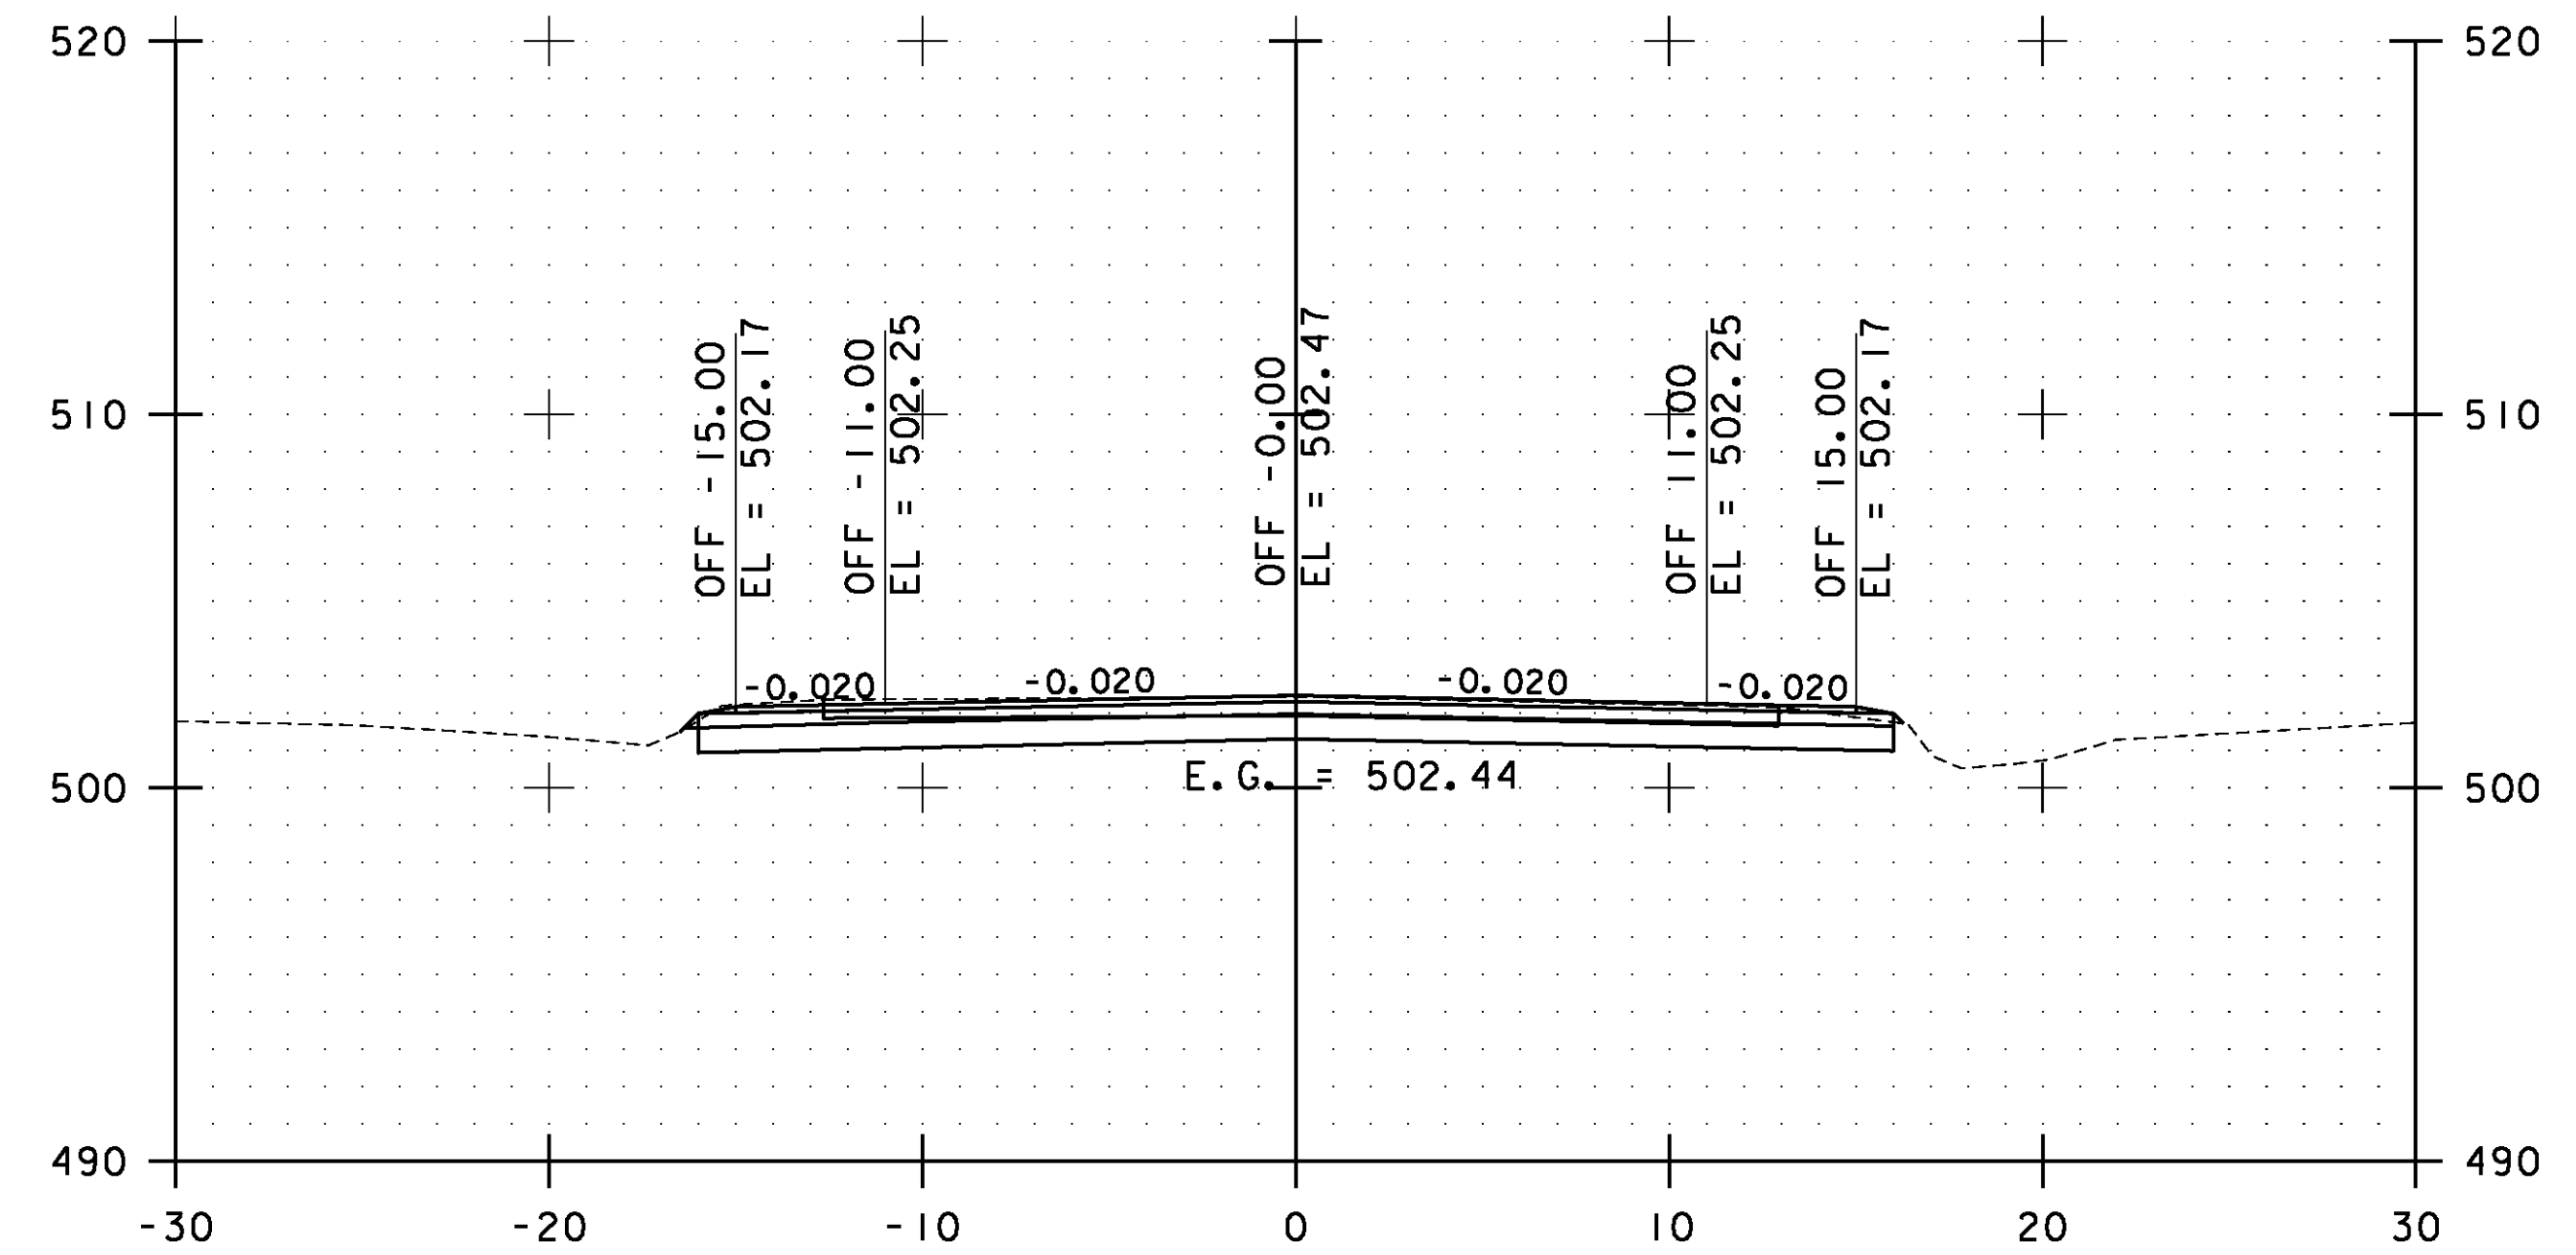

132+00.00

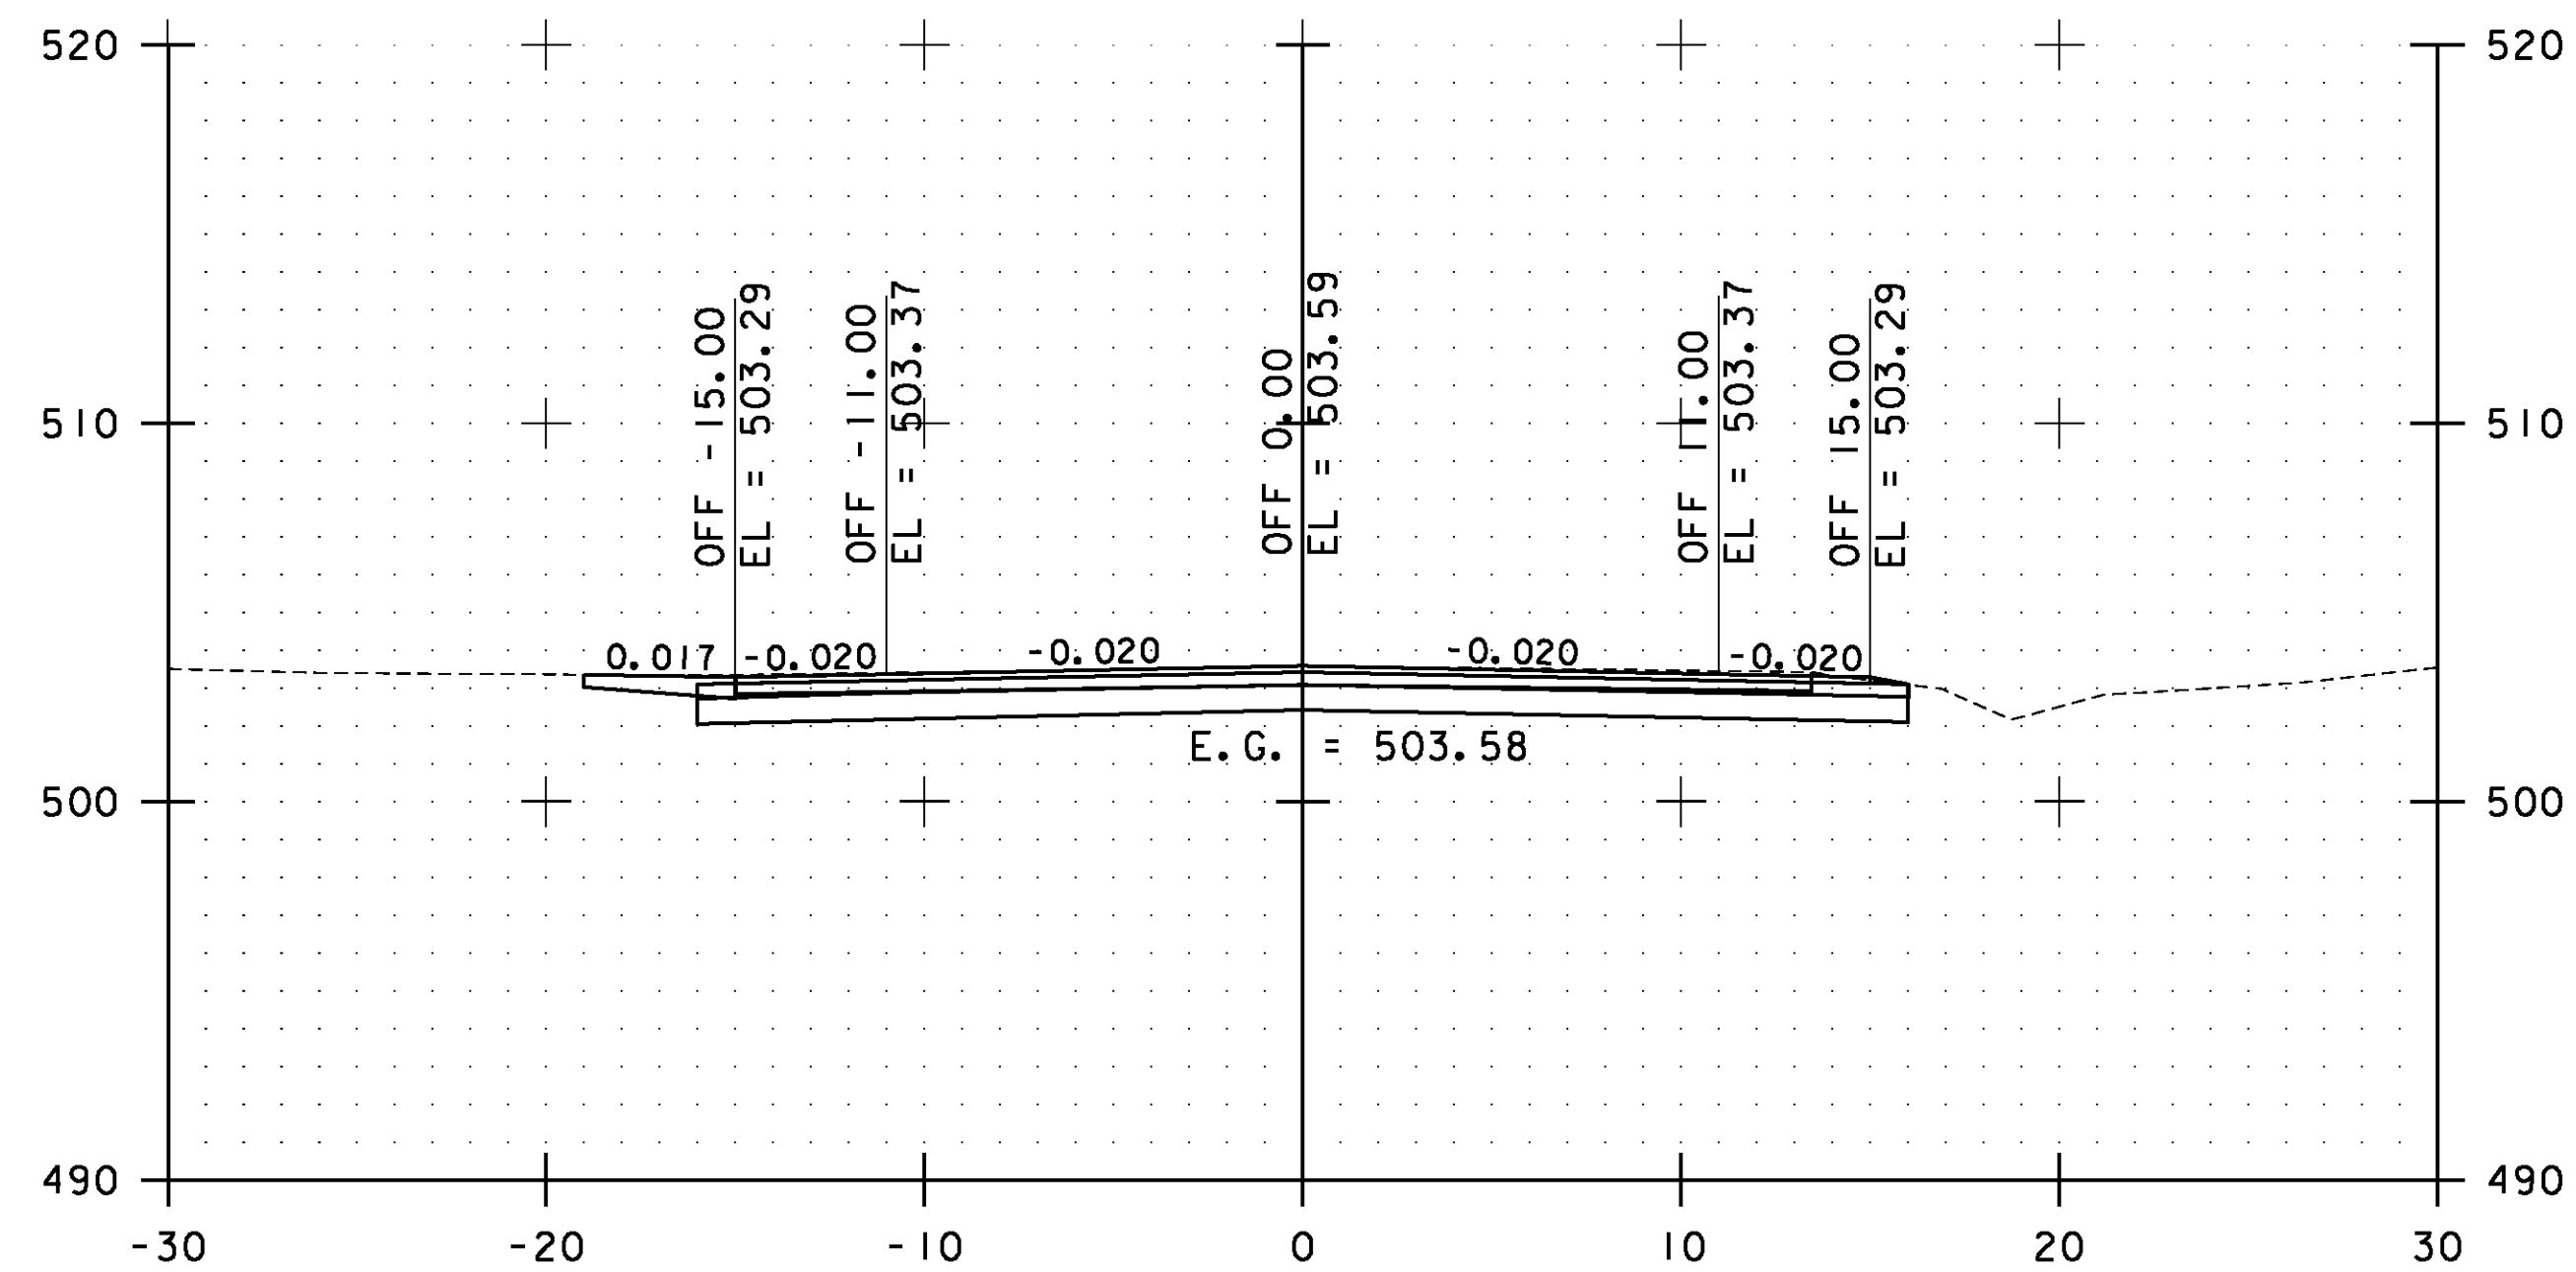

130+50.00

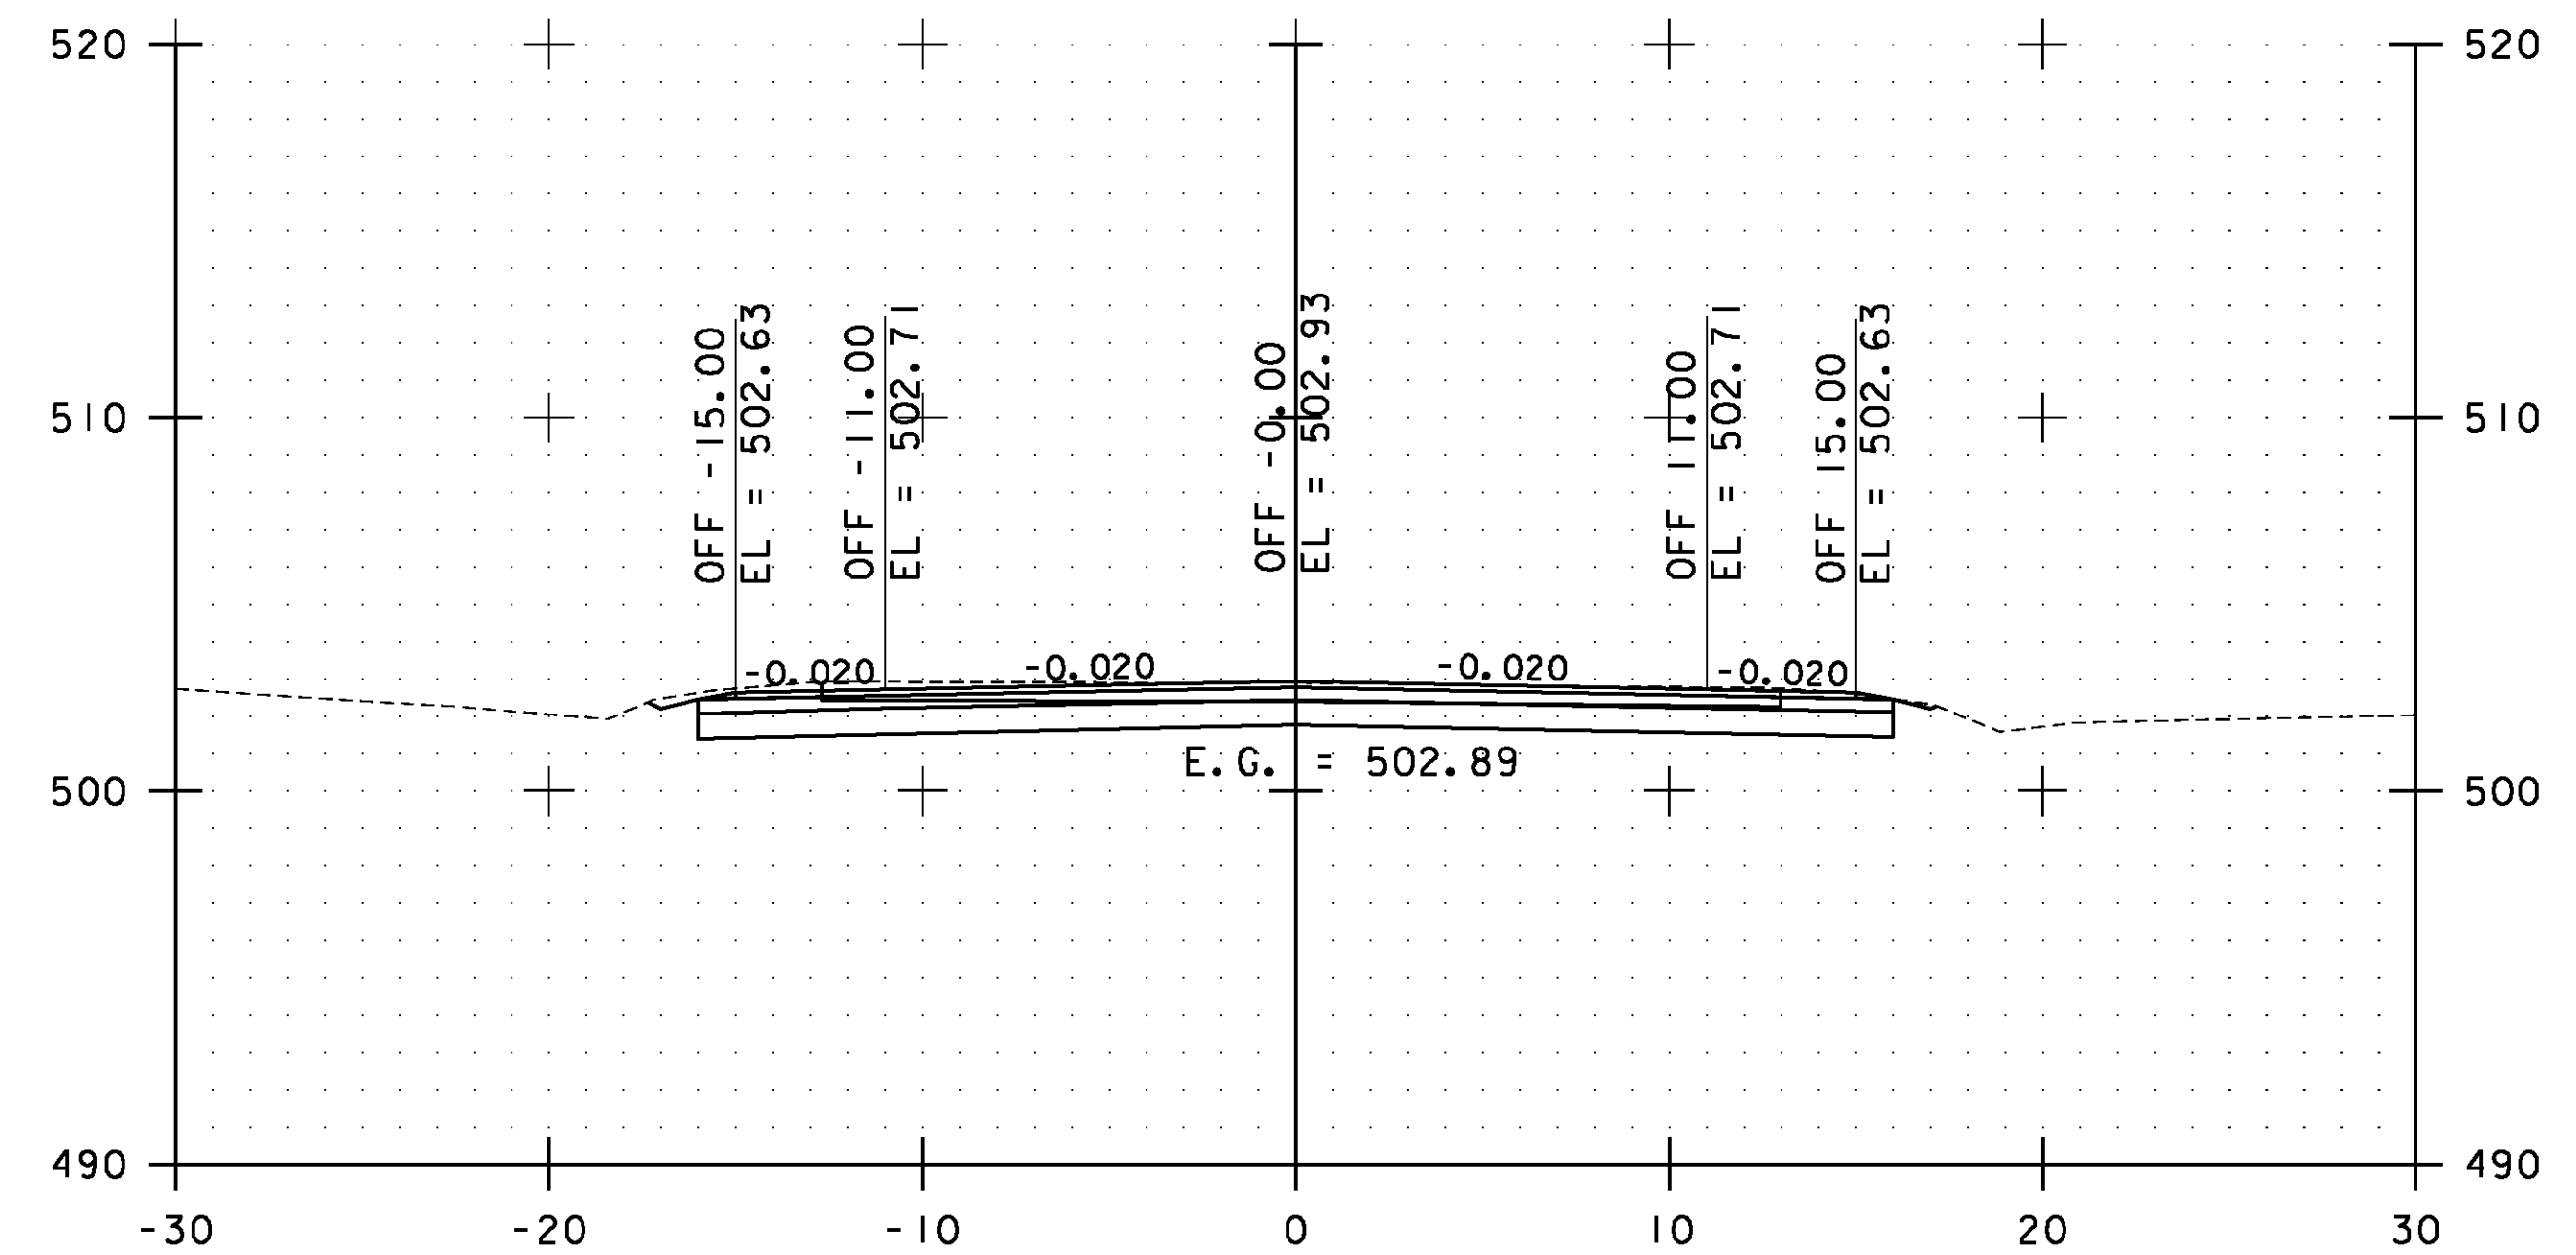

131+50.00

STA. 130+50.00 TO STA. 132+00.00



**ESSEX  
CROSS  
SECTIONS  
SHEET #60**

PROJECT NAME: ESSEX-WESTFORD  
PROJECT NUMBER: STP 2912(I)

FILE NAME: p10c226.dgn  
PROJECT LEADER: JLL  
DESIGNED BY: STANTEC  
IPARM FILE: p10c226xs060.i

PLOT DATE: 2/20/2013  
DRAWN BY: STANTEC  
CHECKED BY: STANTEC  
SHEET 151 OF 239