




135+00.00

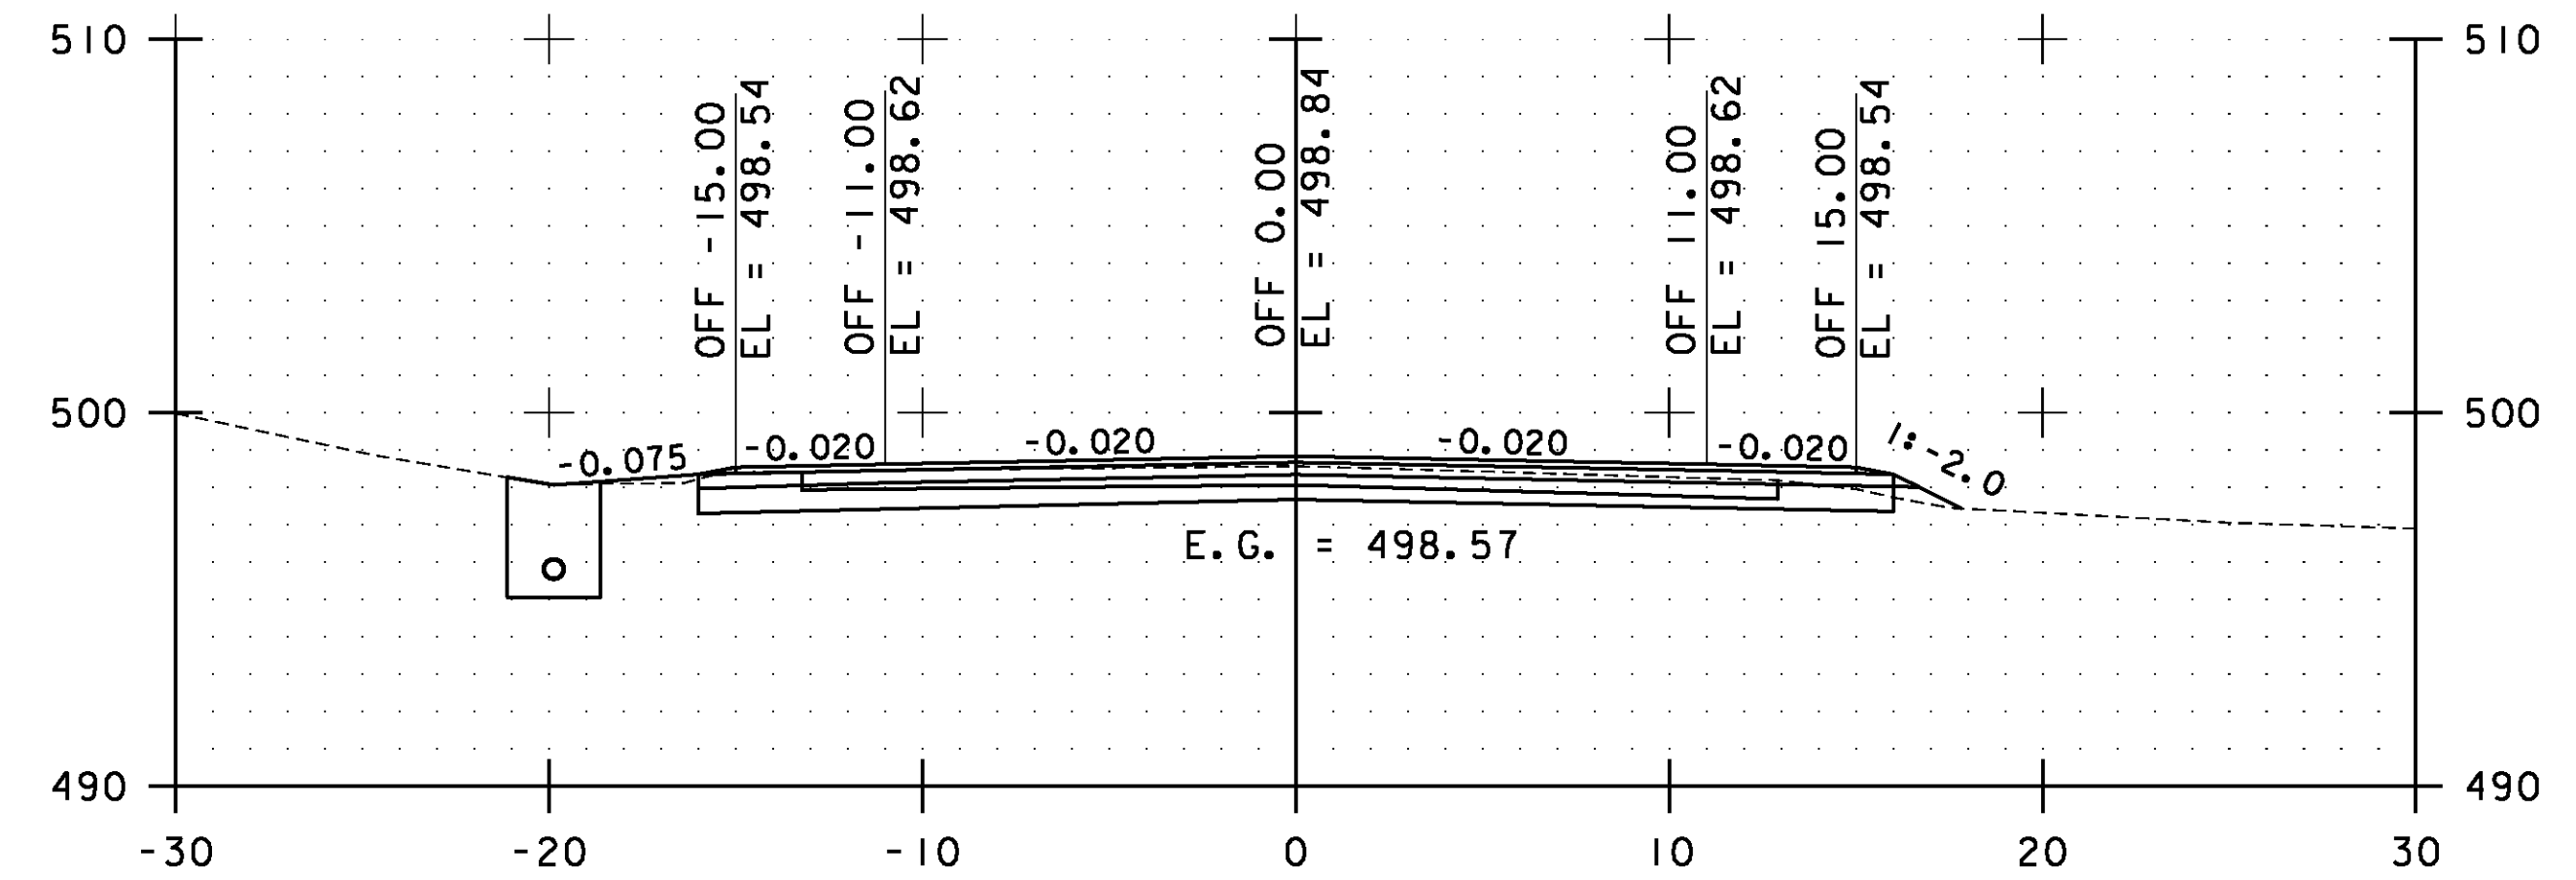

136+00.00

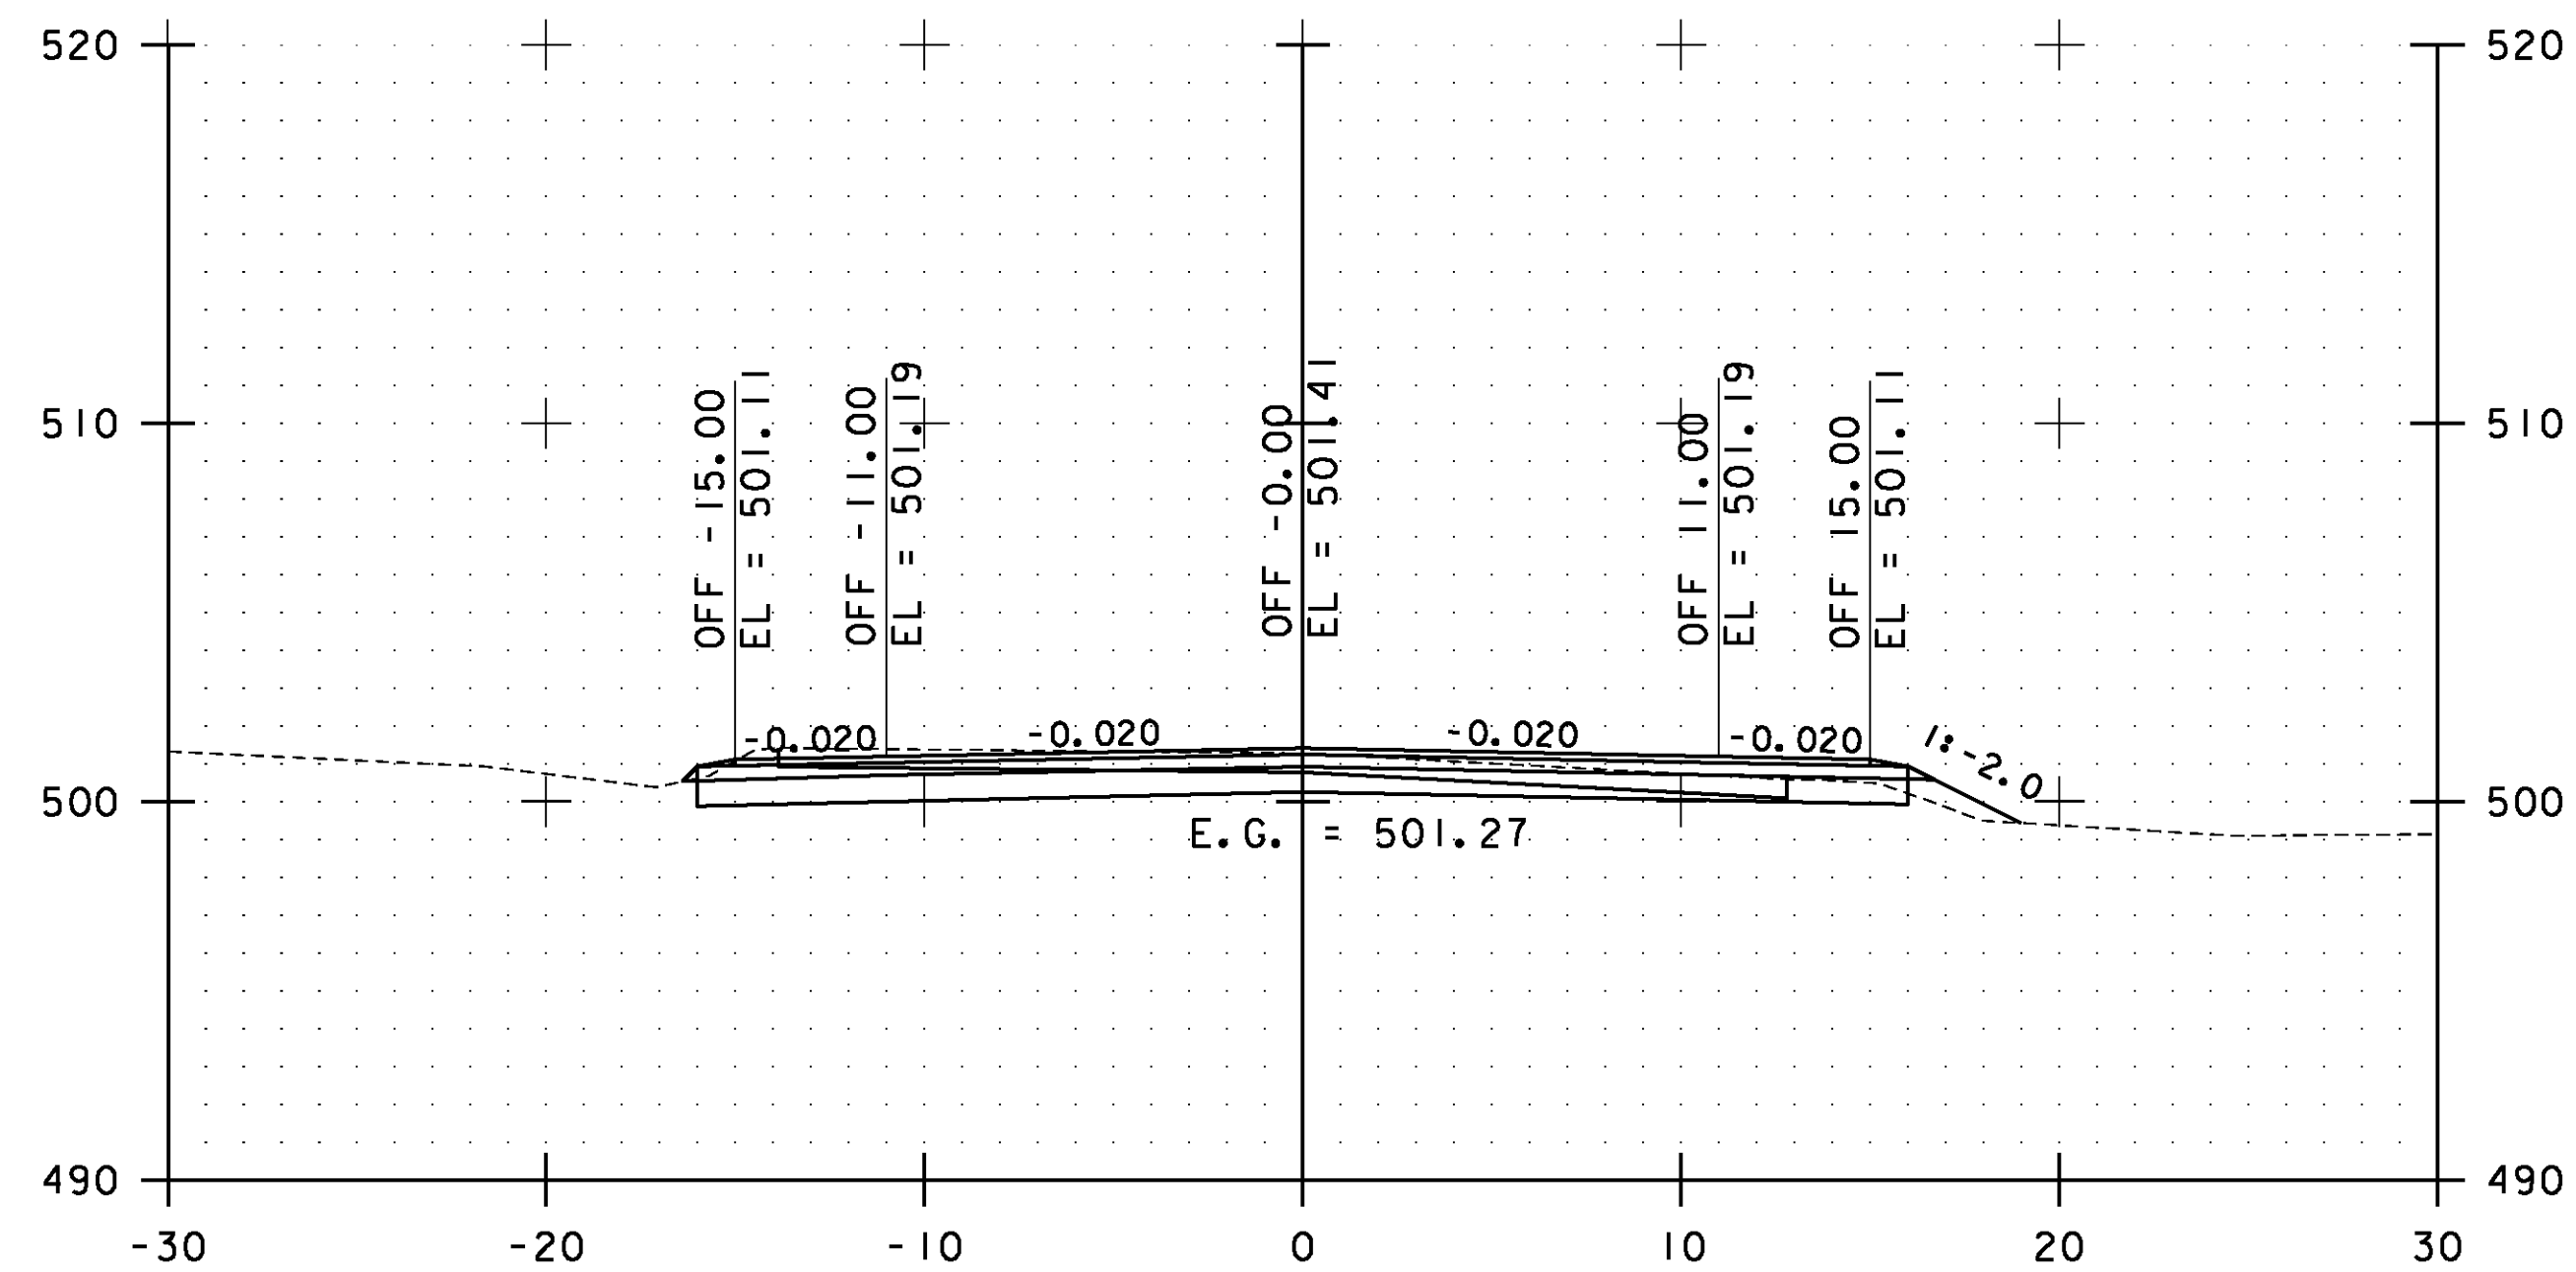


134+50.00

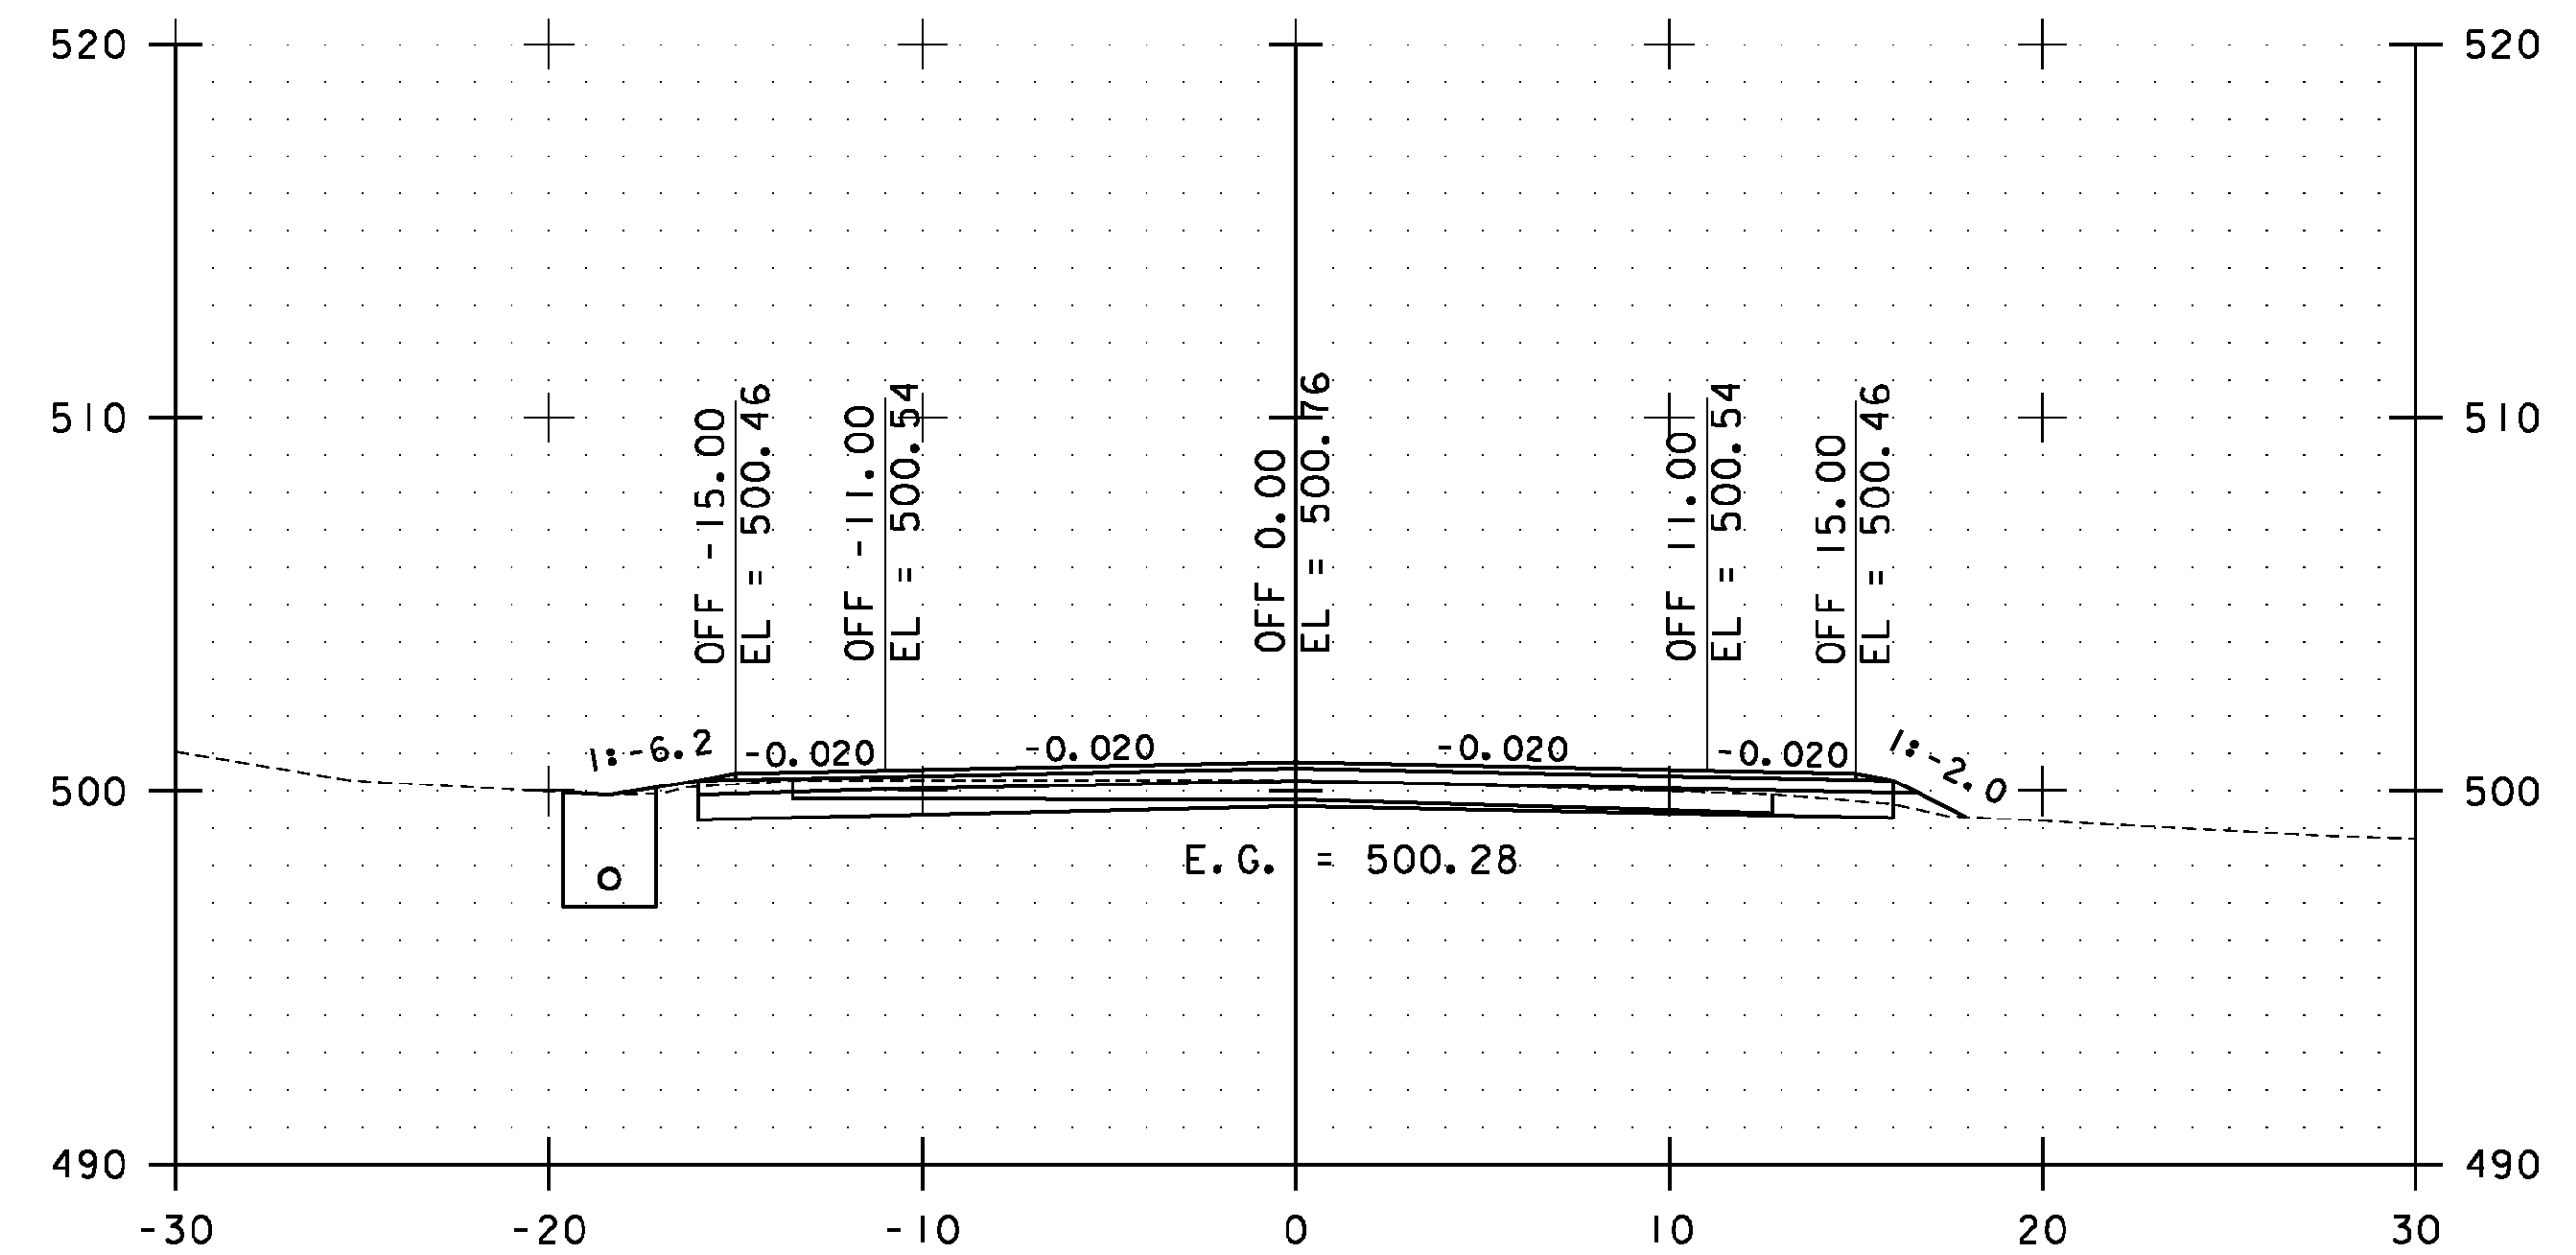

135+50.00

STA. 134+50.00 TO STA. 136+00.00

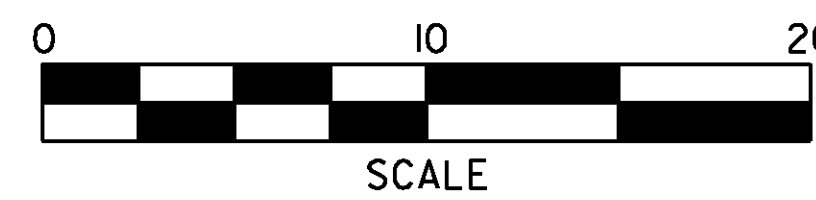

**ESSEX  
CROSS  
SECTIONS  
SHEET #62**

PROJECT NAME: ESSEX-WESTFORD  
PROJECT NUMBER: STP 2912(I)

FILE NAME: p10c226.dgn  
PROJECT LEADER: JLL  
DESIGNED BY: STANTEC  
IPARM FILE: p10c226xs062.i

PLOT DATE: 2/20/2013  
DRAWN BY: STANTEC  
CHECKED BY: STANTEC  
SHEET 153 OF 239