




137+00.00

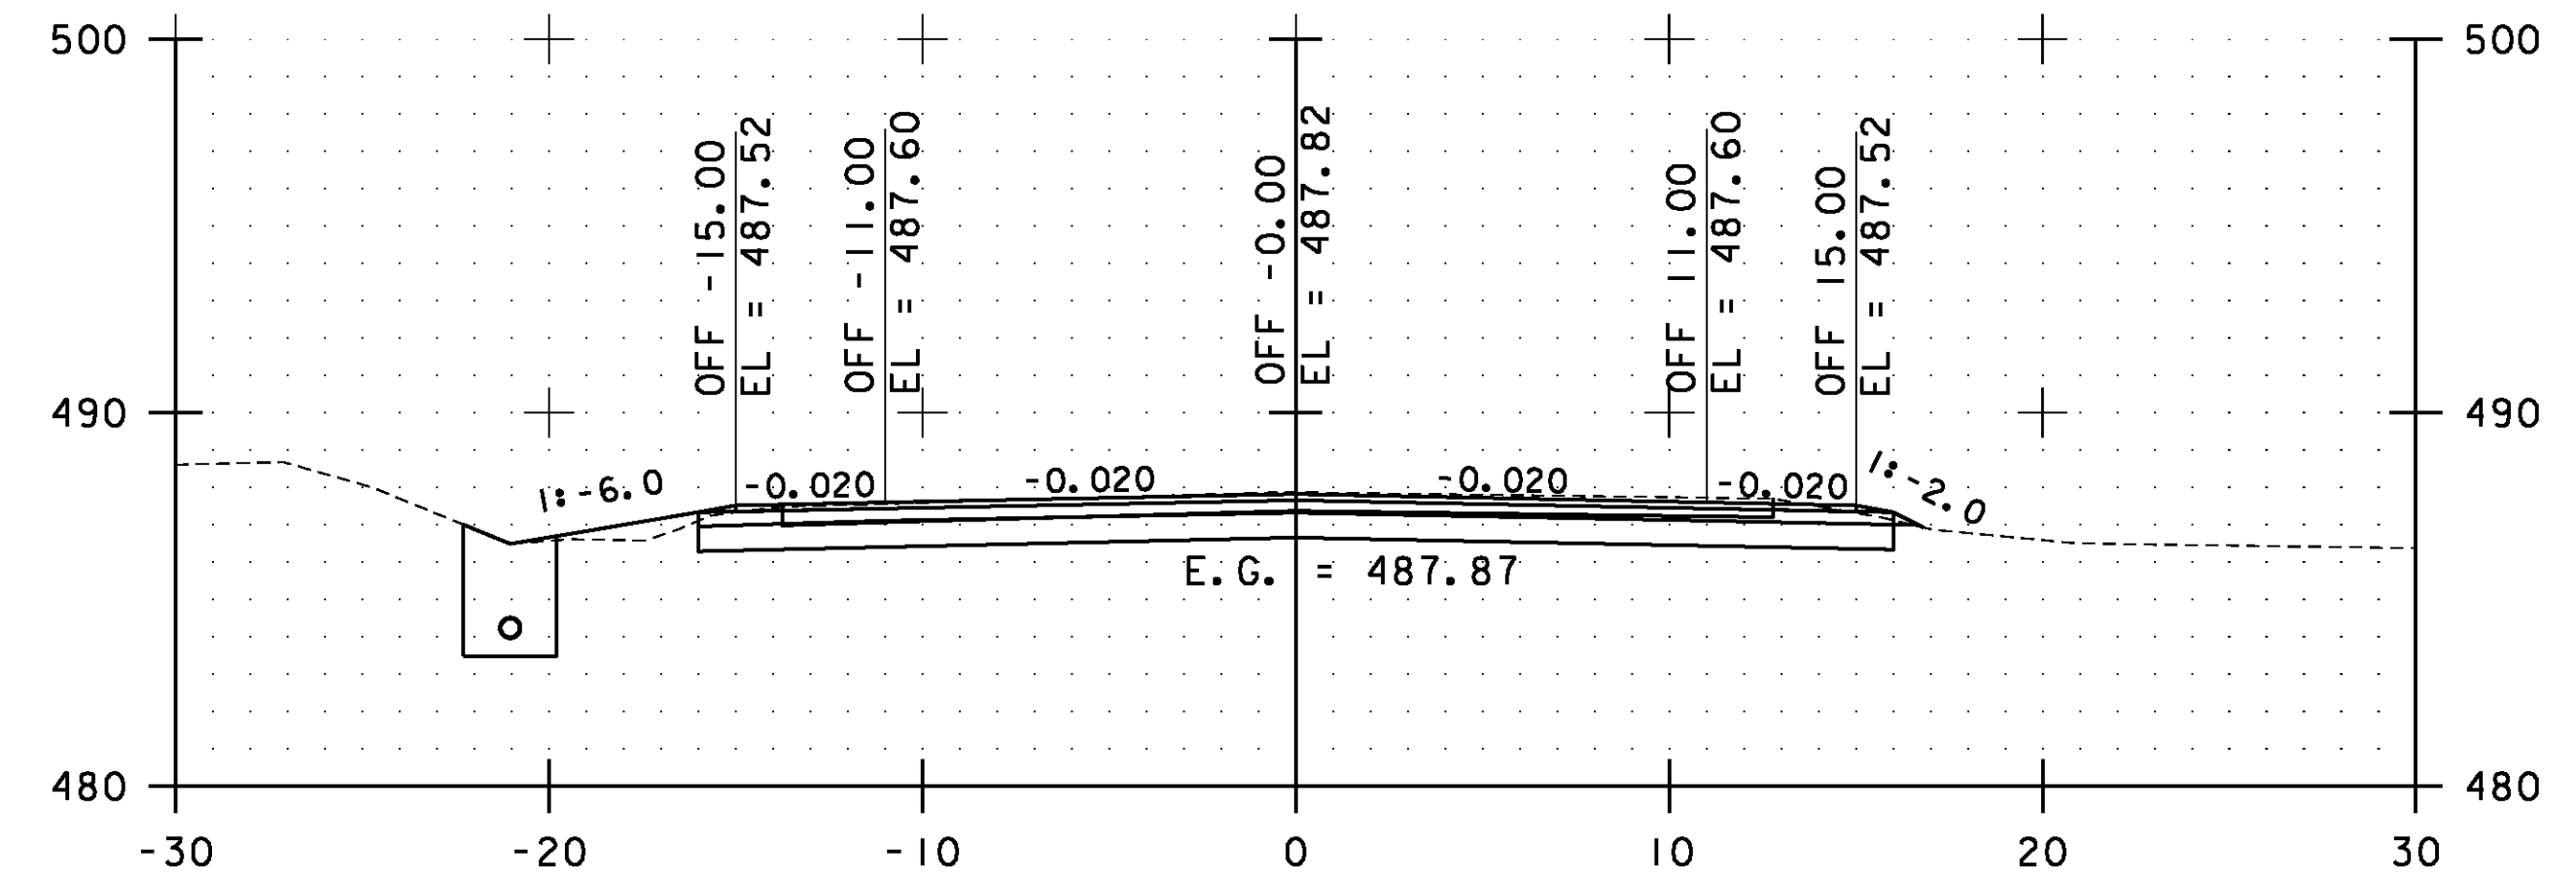

138+00.00

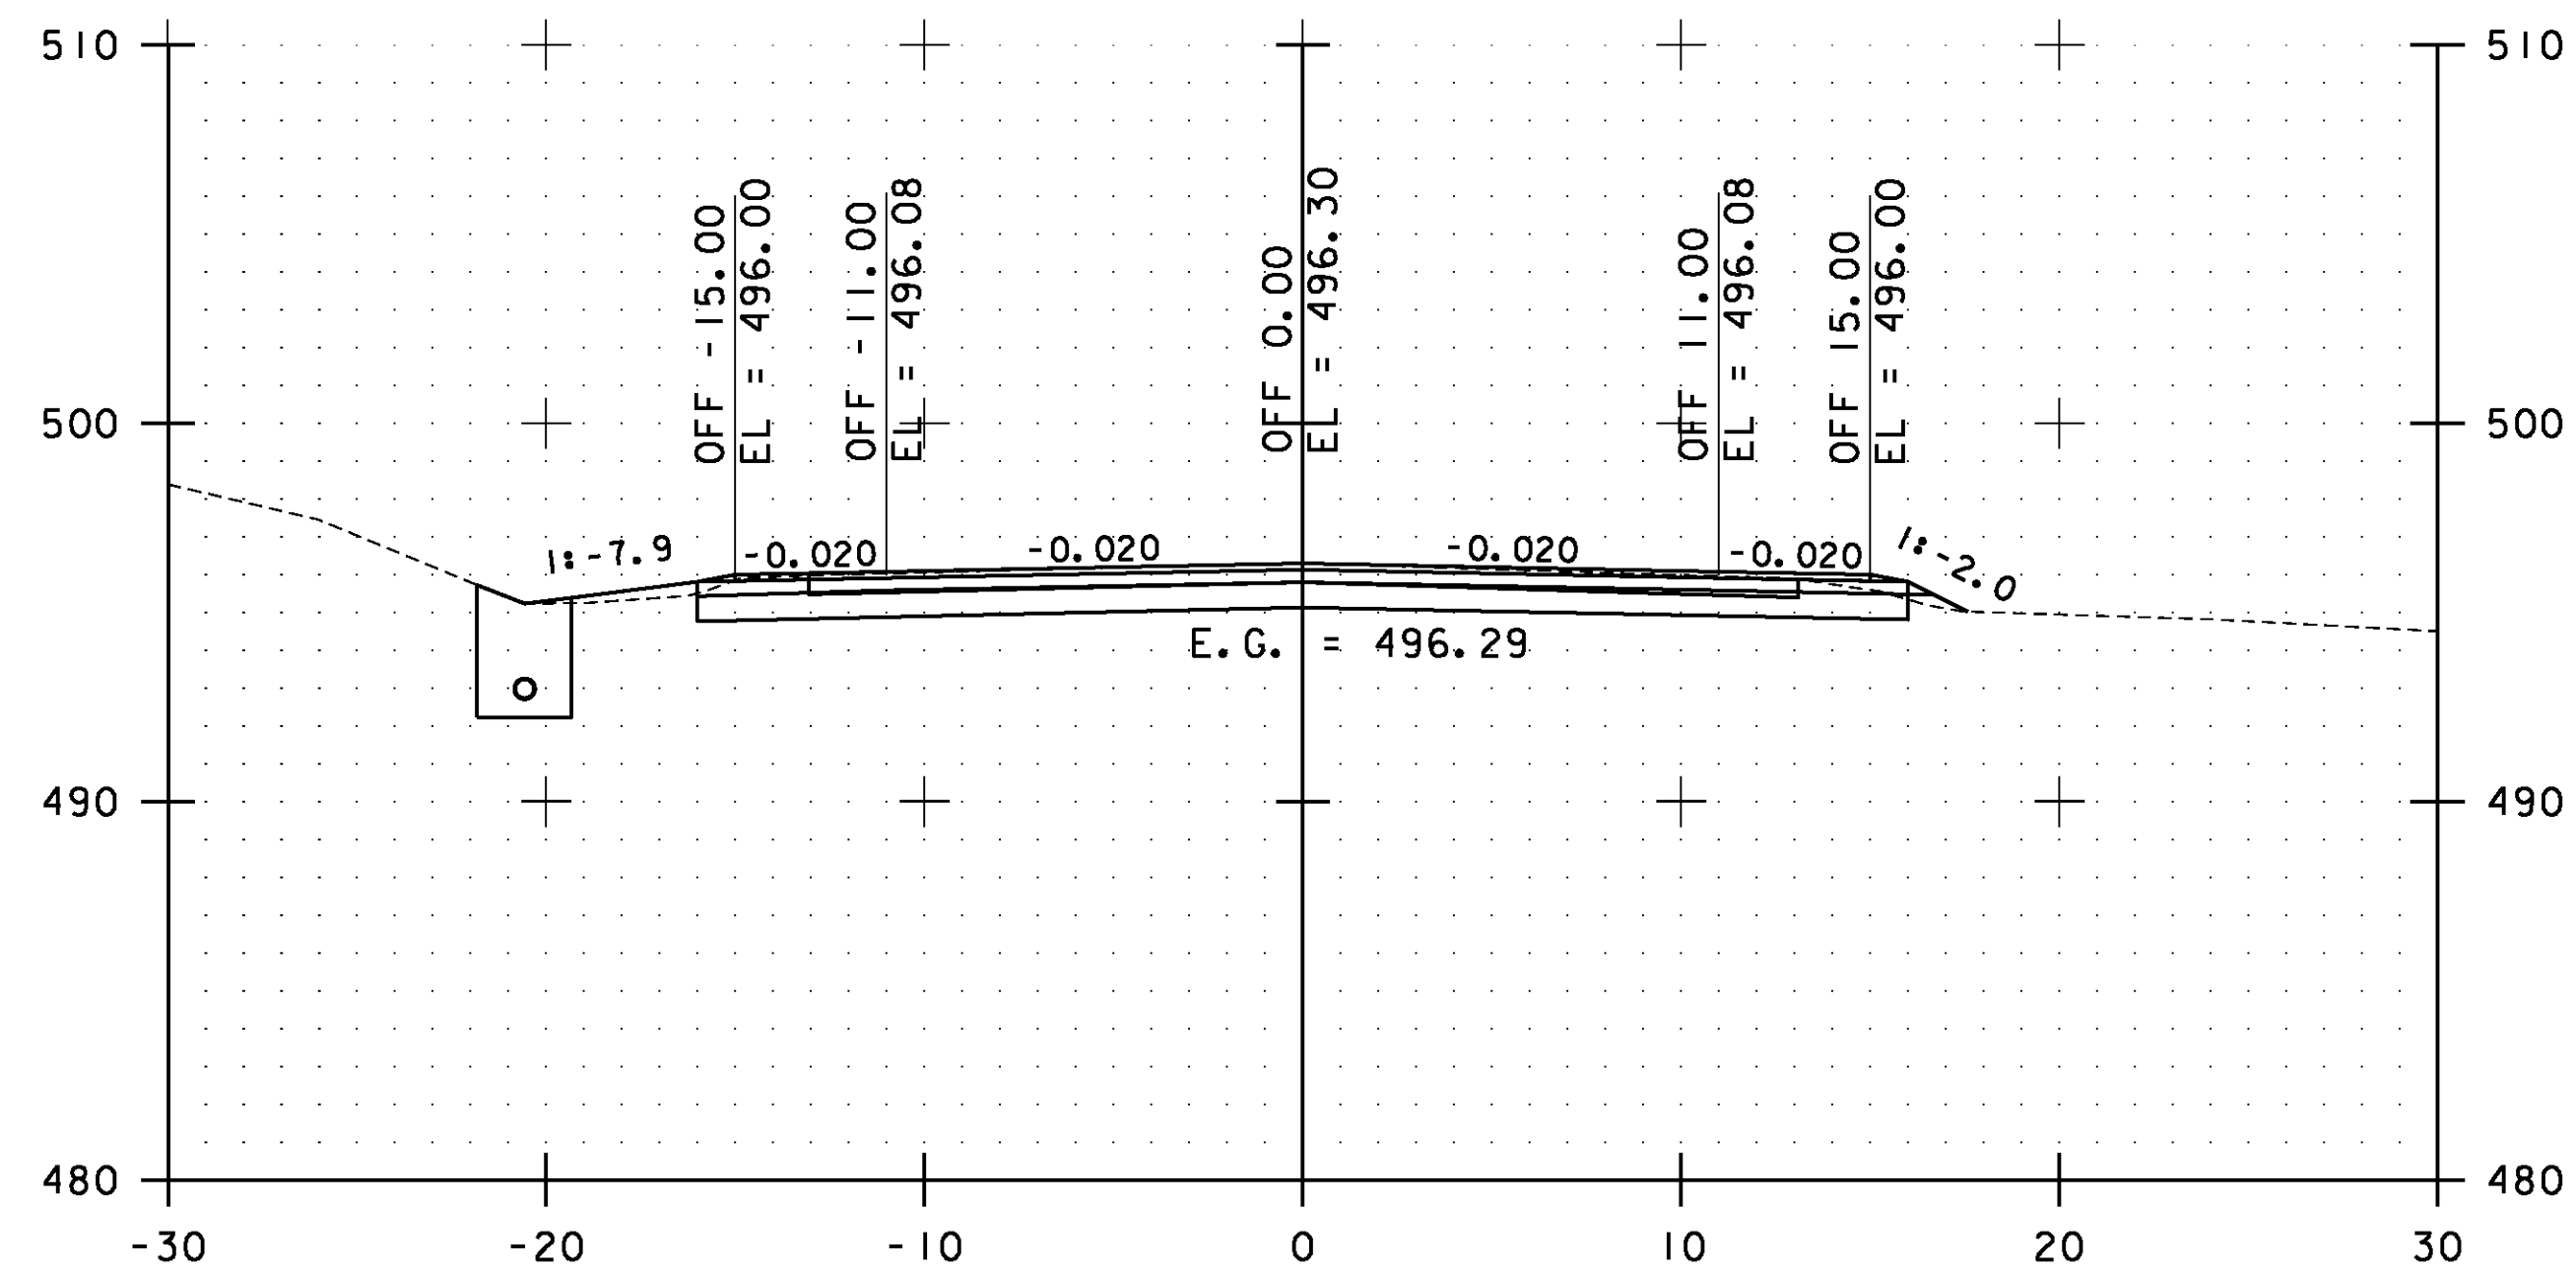


136+50.00

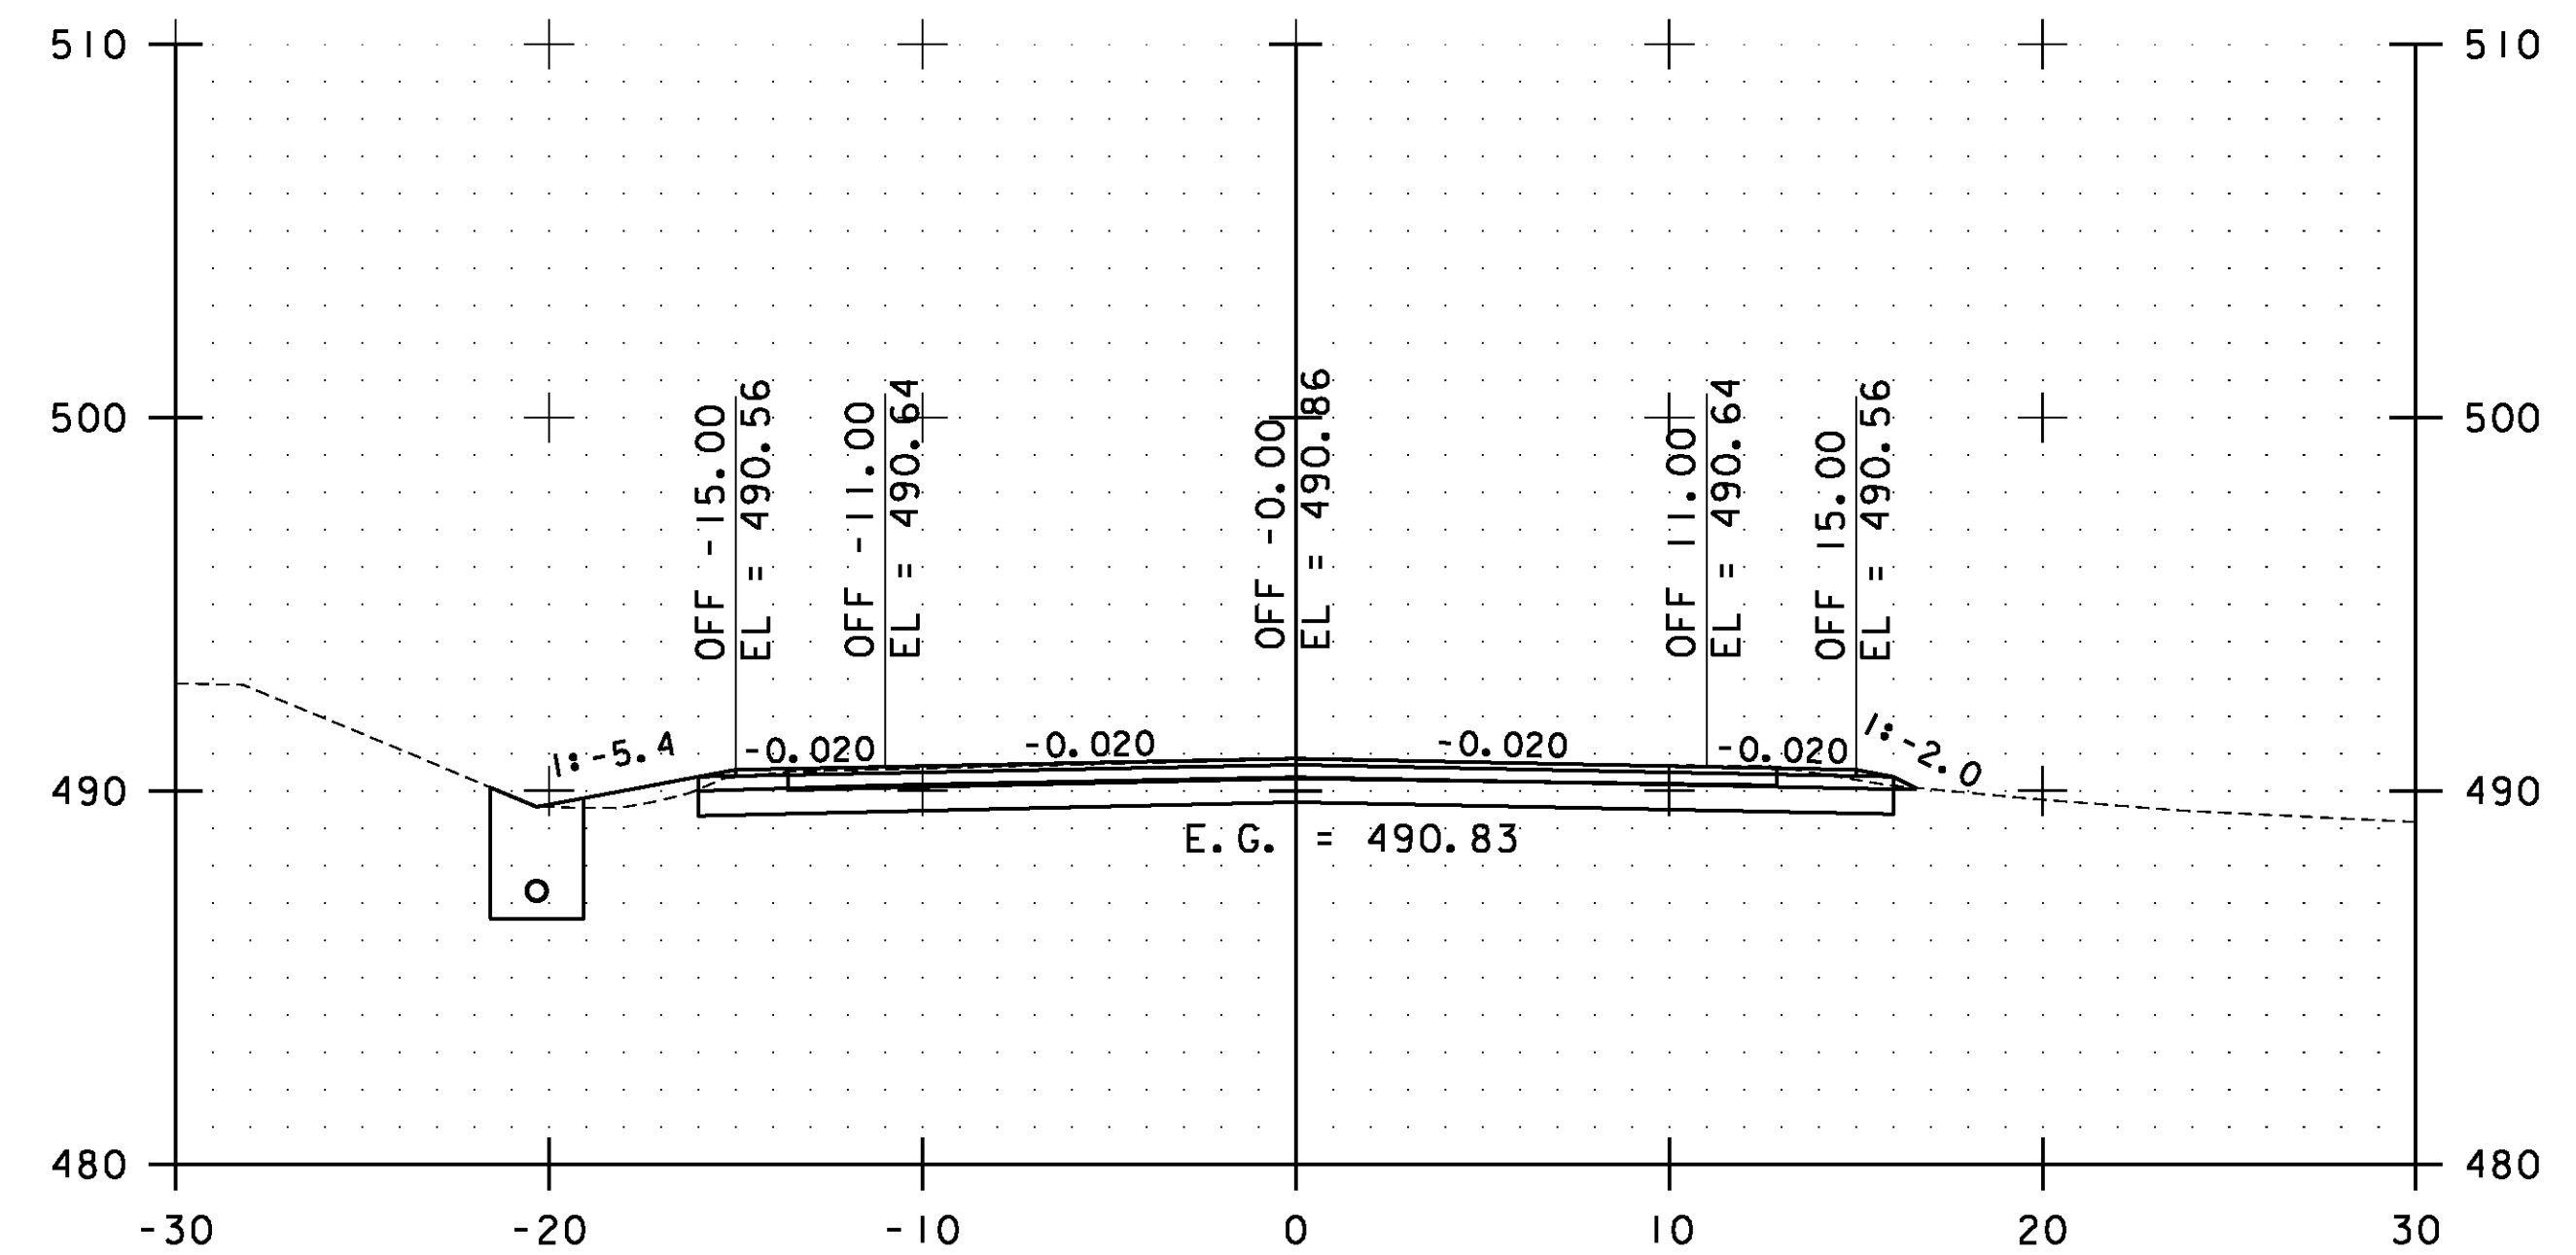

137+50.00

STA. 136+50.00 TO STA. 138+00.00

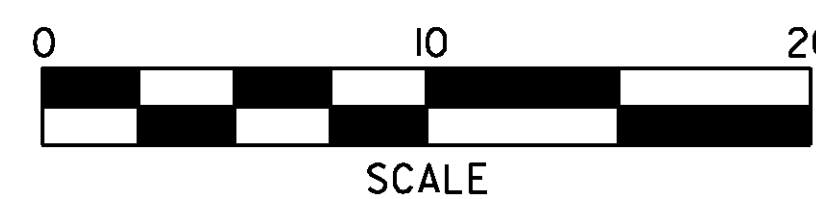

**ESSEX
CROSS
SECTIONS
SHEET #63**

PROJECT NAME: ESSEX-WESTFORD
PROJECT NUMBER: STP 2912(I)

FILE NAME: p10c226.dgn
PROJECT LEADER: JLL
DESIGNED BY: STANTEC
IPARM FILE: p10c226xs063.i

PLOT DATE: 2/20/2013
DRAWN BY: STANTEC
CHECKED BY: STANTEC
SHEET 154 OF 239