




139+00.00

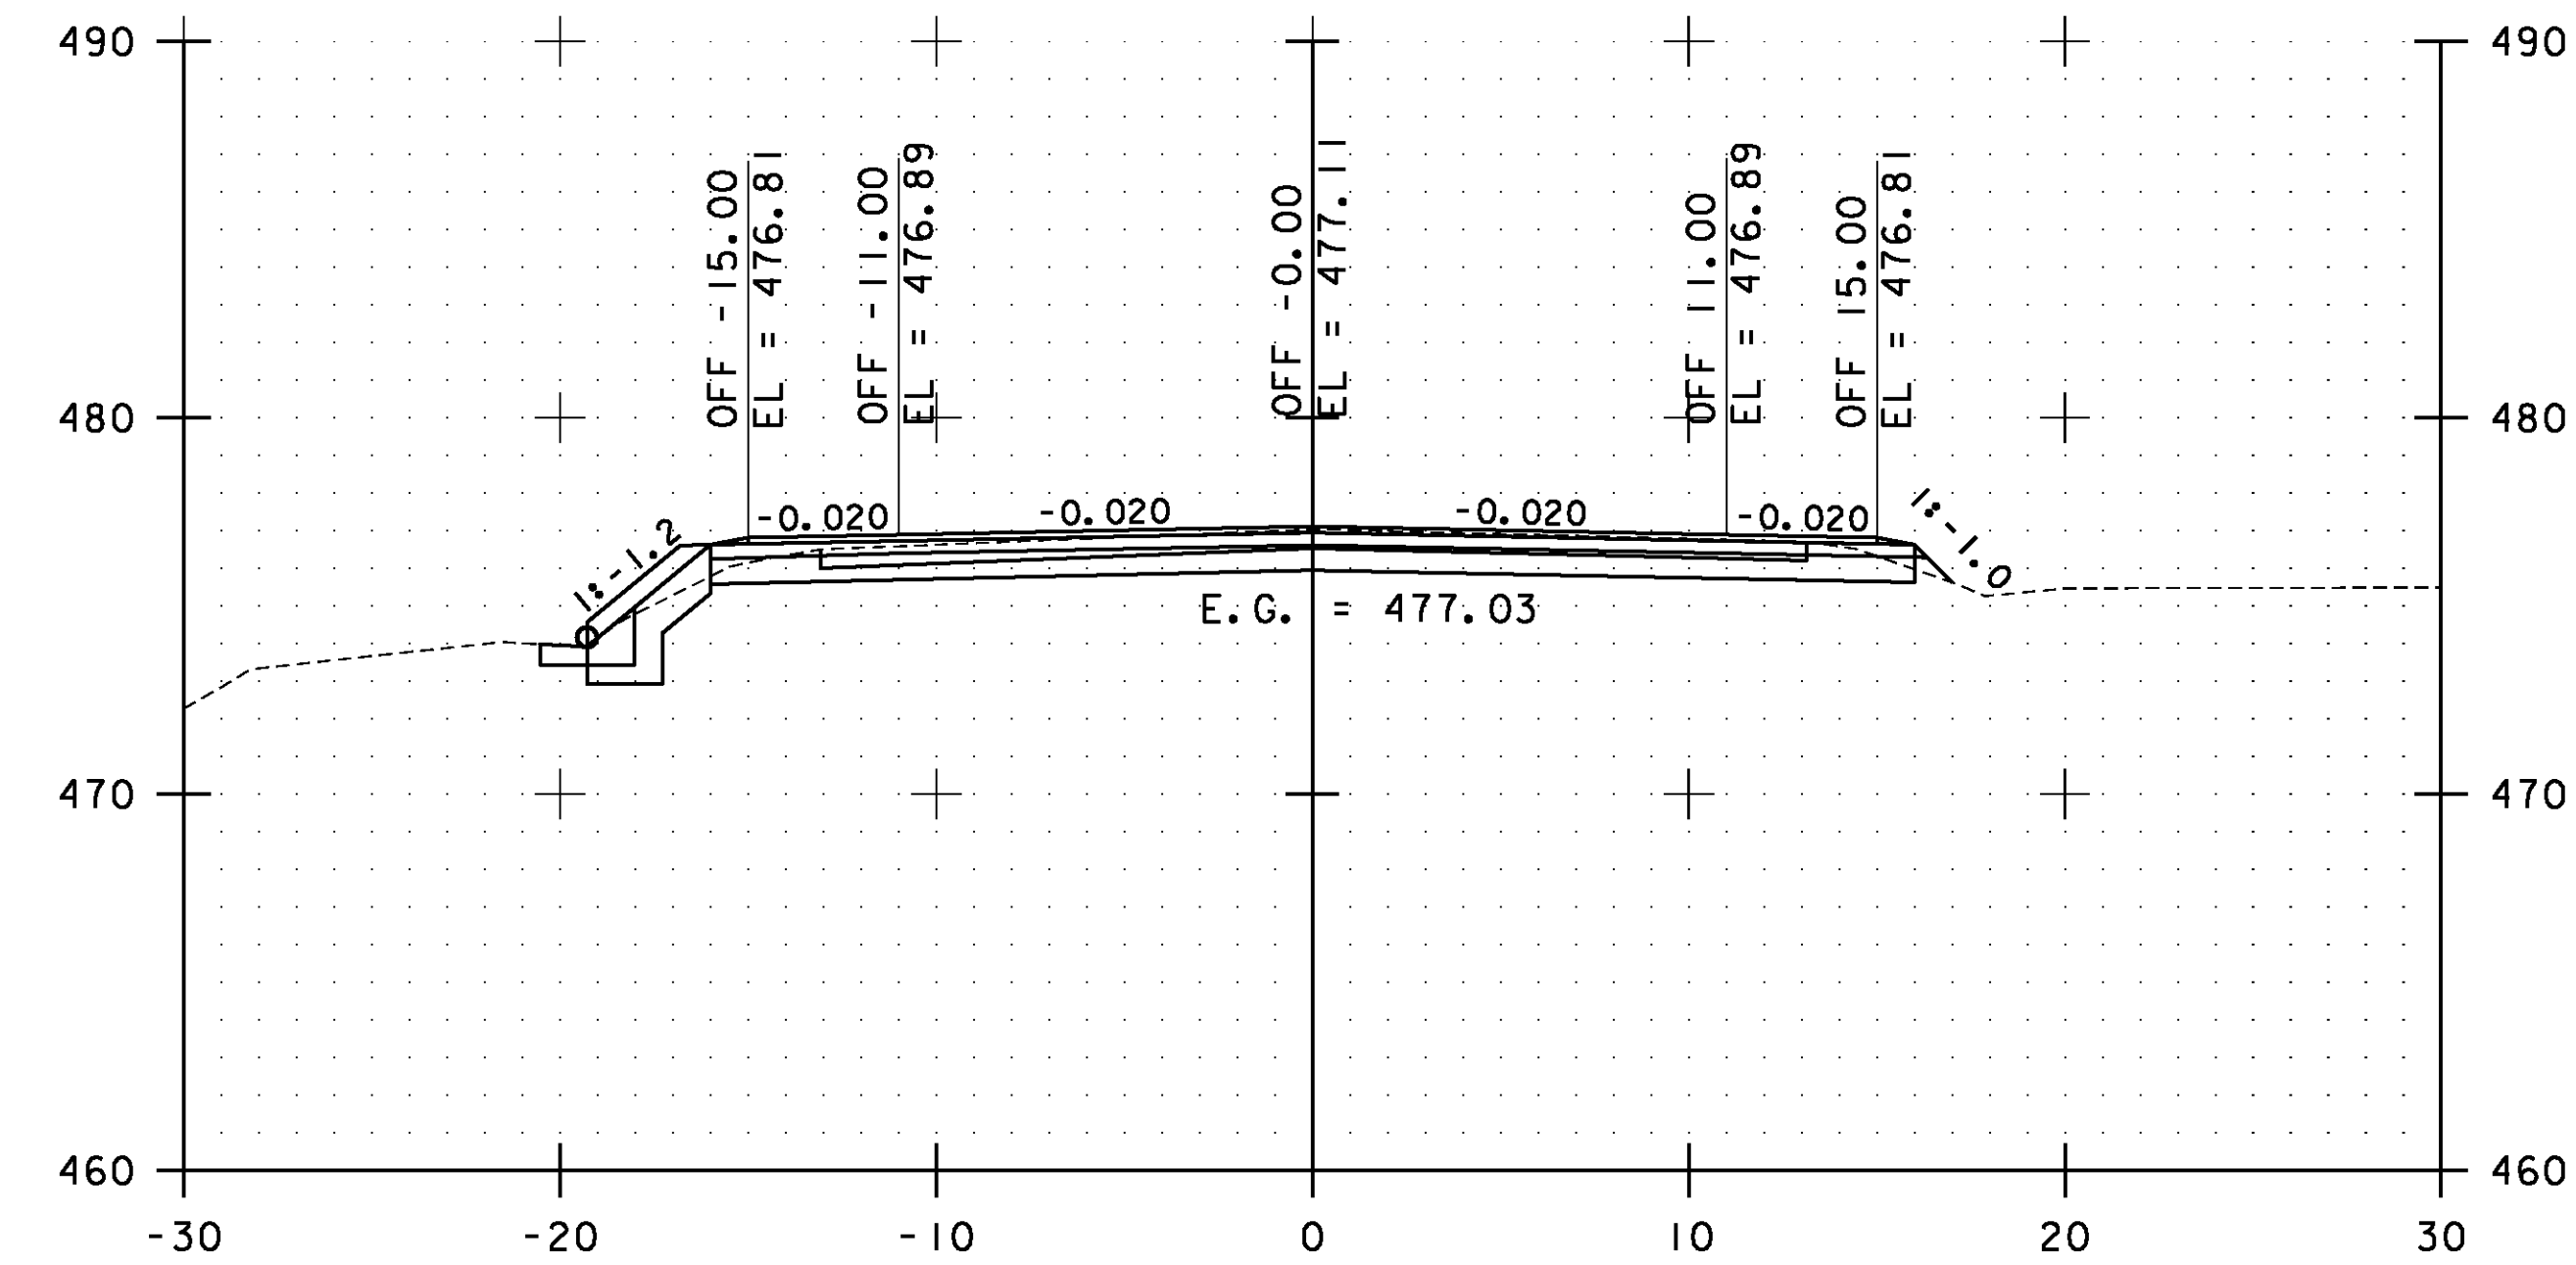

140+00.00

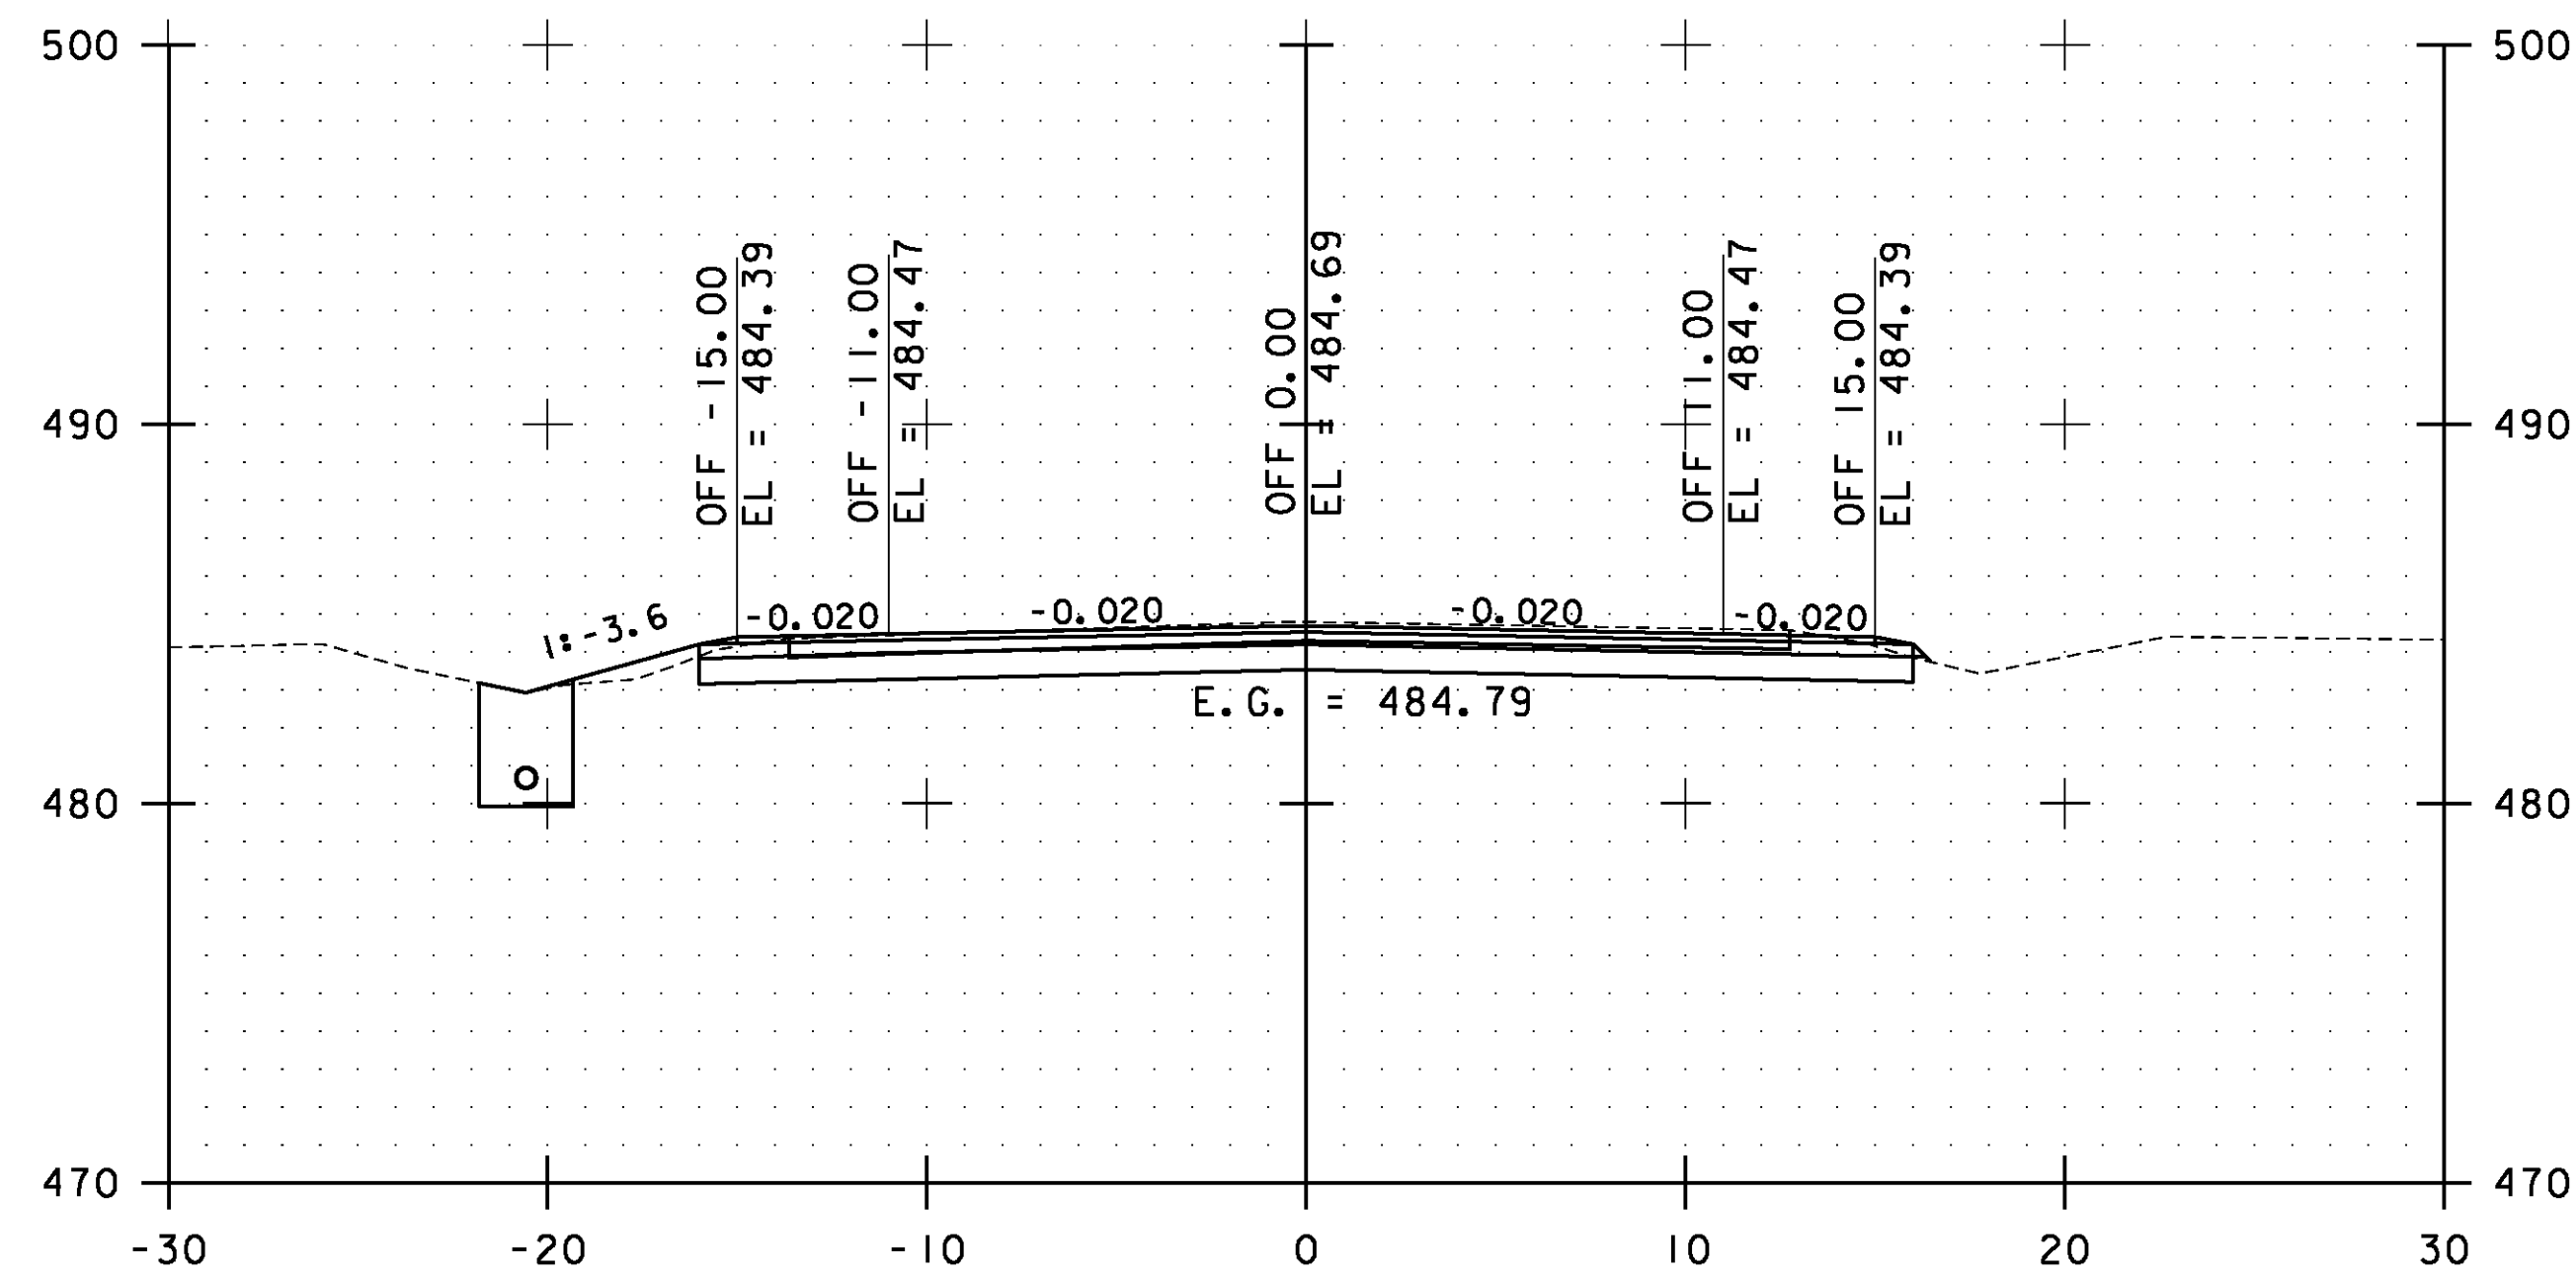


138+50.00

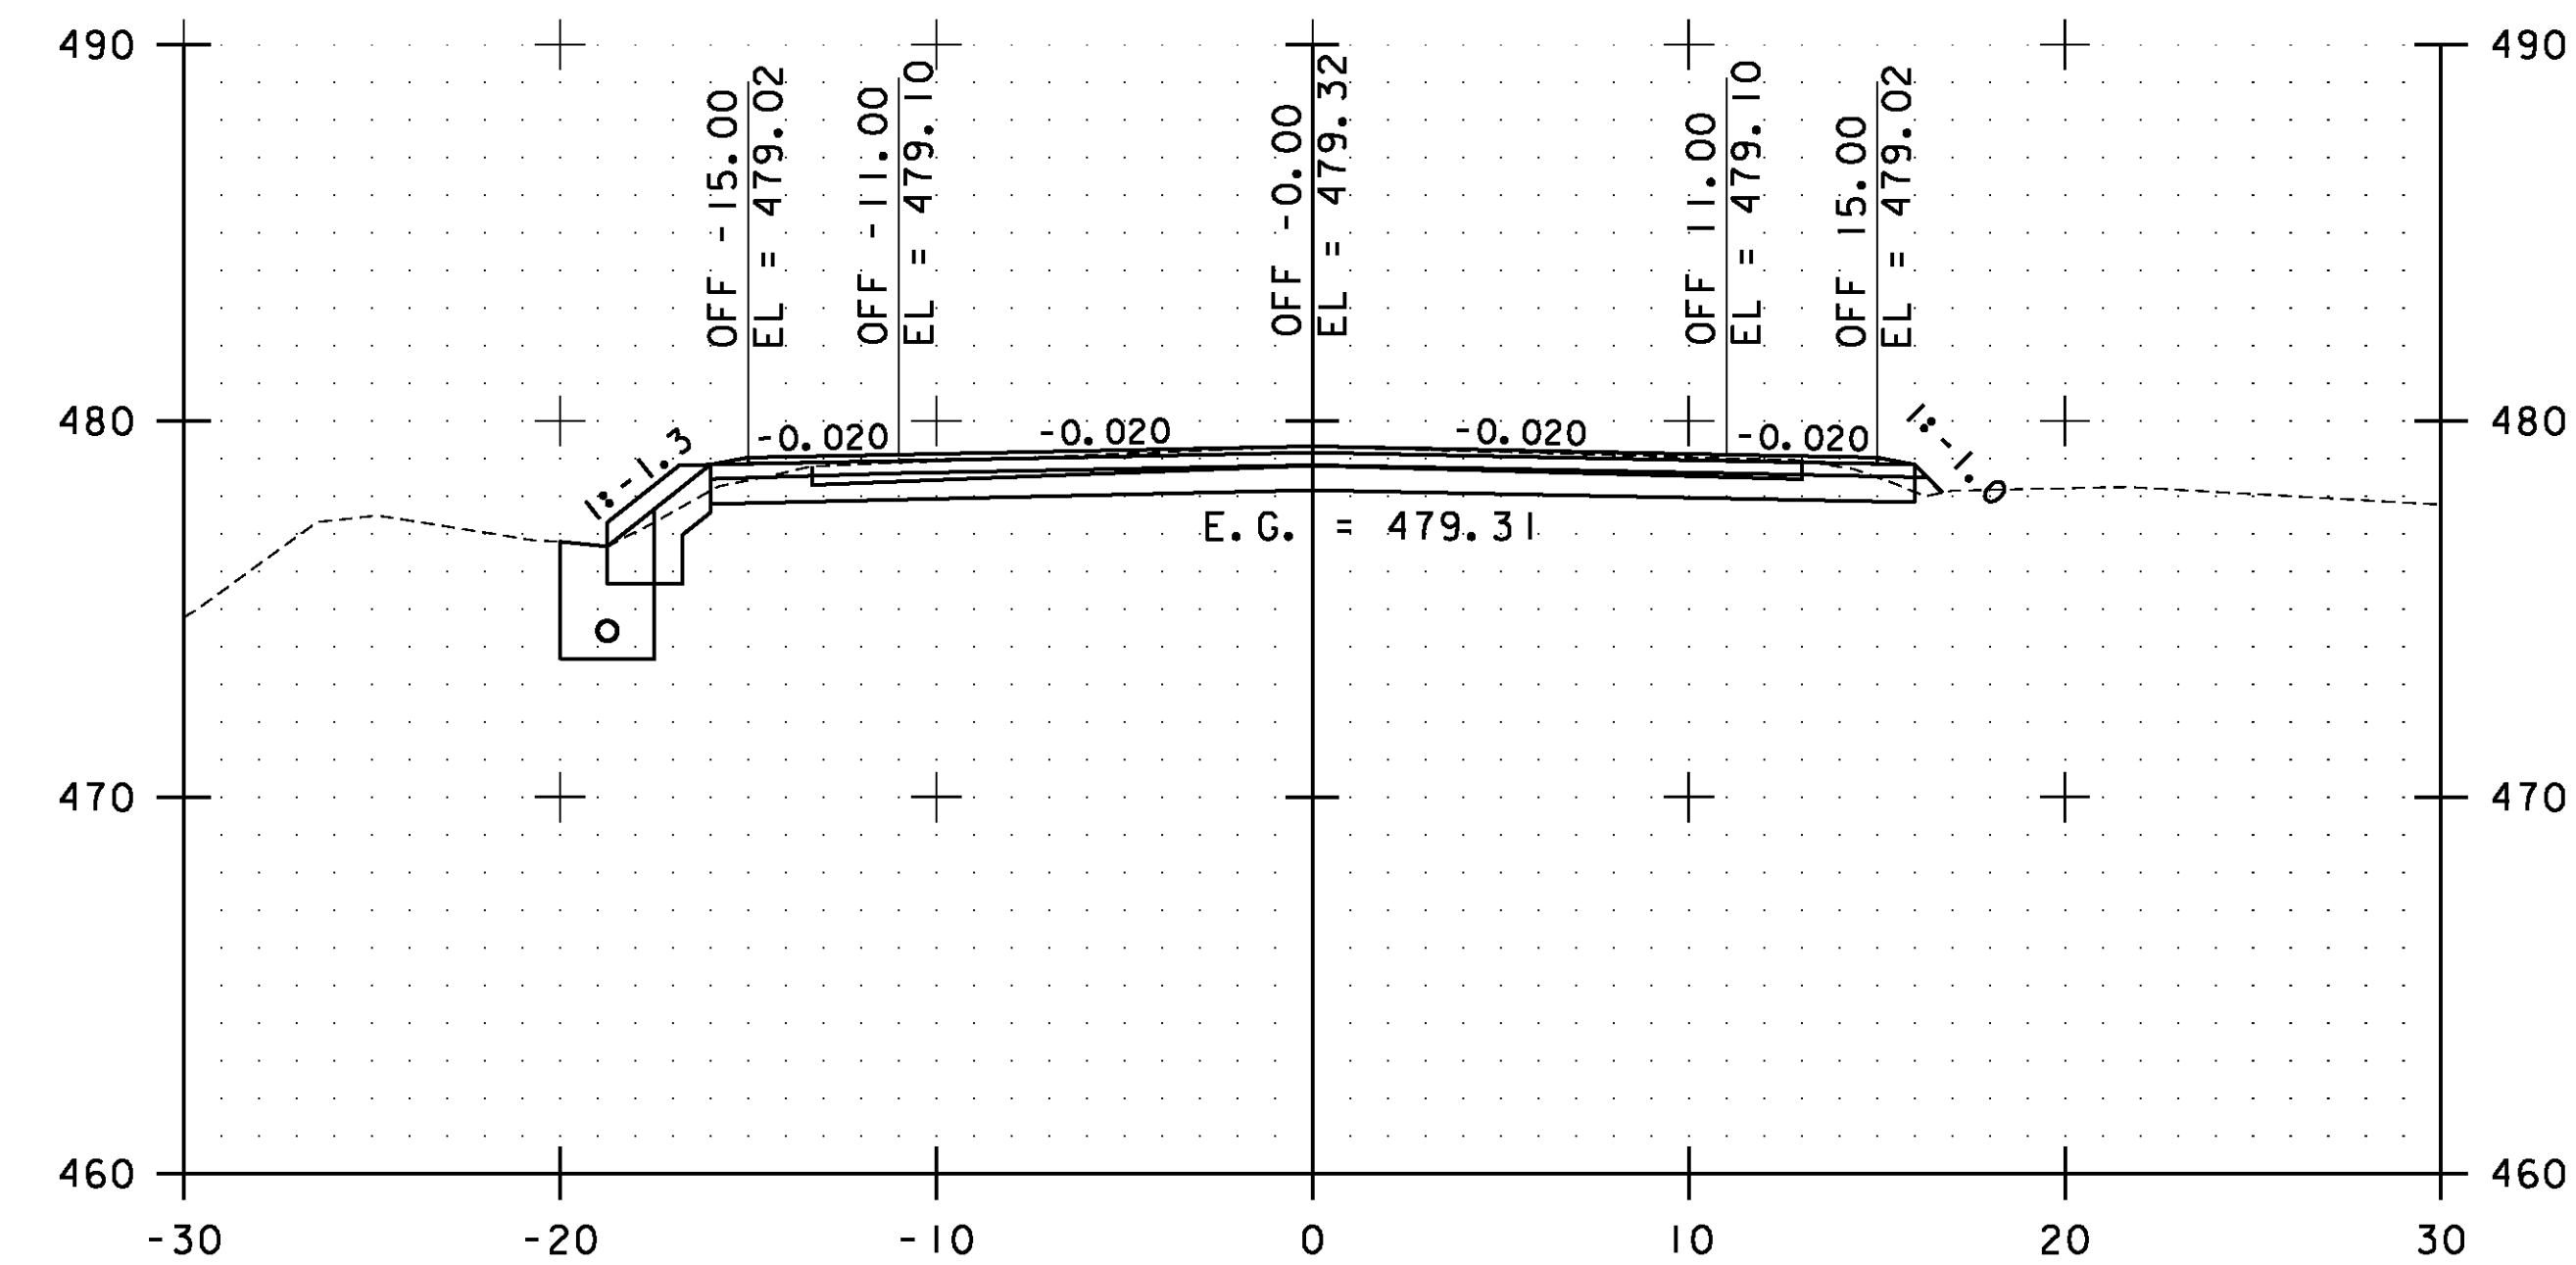

139+50.00

STA. 138+50.00 TO STA. 140+00.00

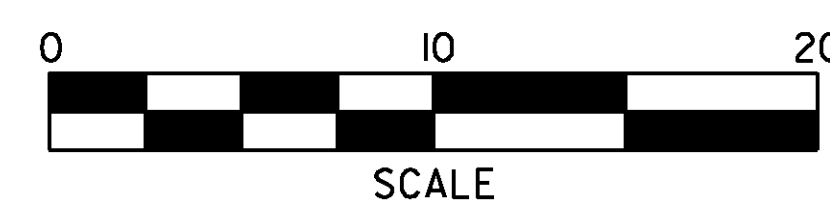

**ESSEX
CROSS
SECTIONS
SHEET #64**

PROJECT NAME: ESSEX-WESTFORD	PLOT DATE: 2/20/2013
PROJECT NUMBER: STP 2912(I)	DRAWN BY: STANTEC
FILE NAME: p10c226.dgn	CHECKED BY: STANTEC
PROJECT LEADER: JLL	SHEET 155 OF 239
DESIGNED BY: STANTEC	
IPARM FILE: p10c226xs064.i	