




147+00.00

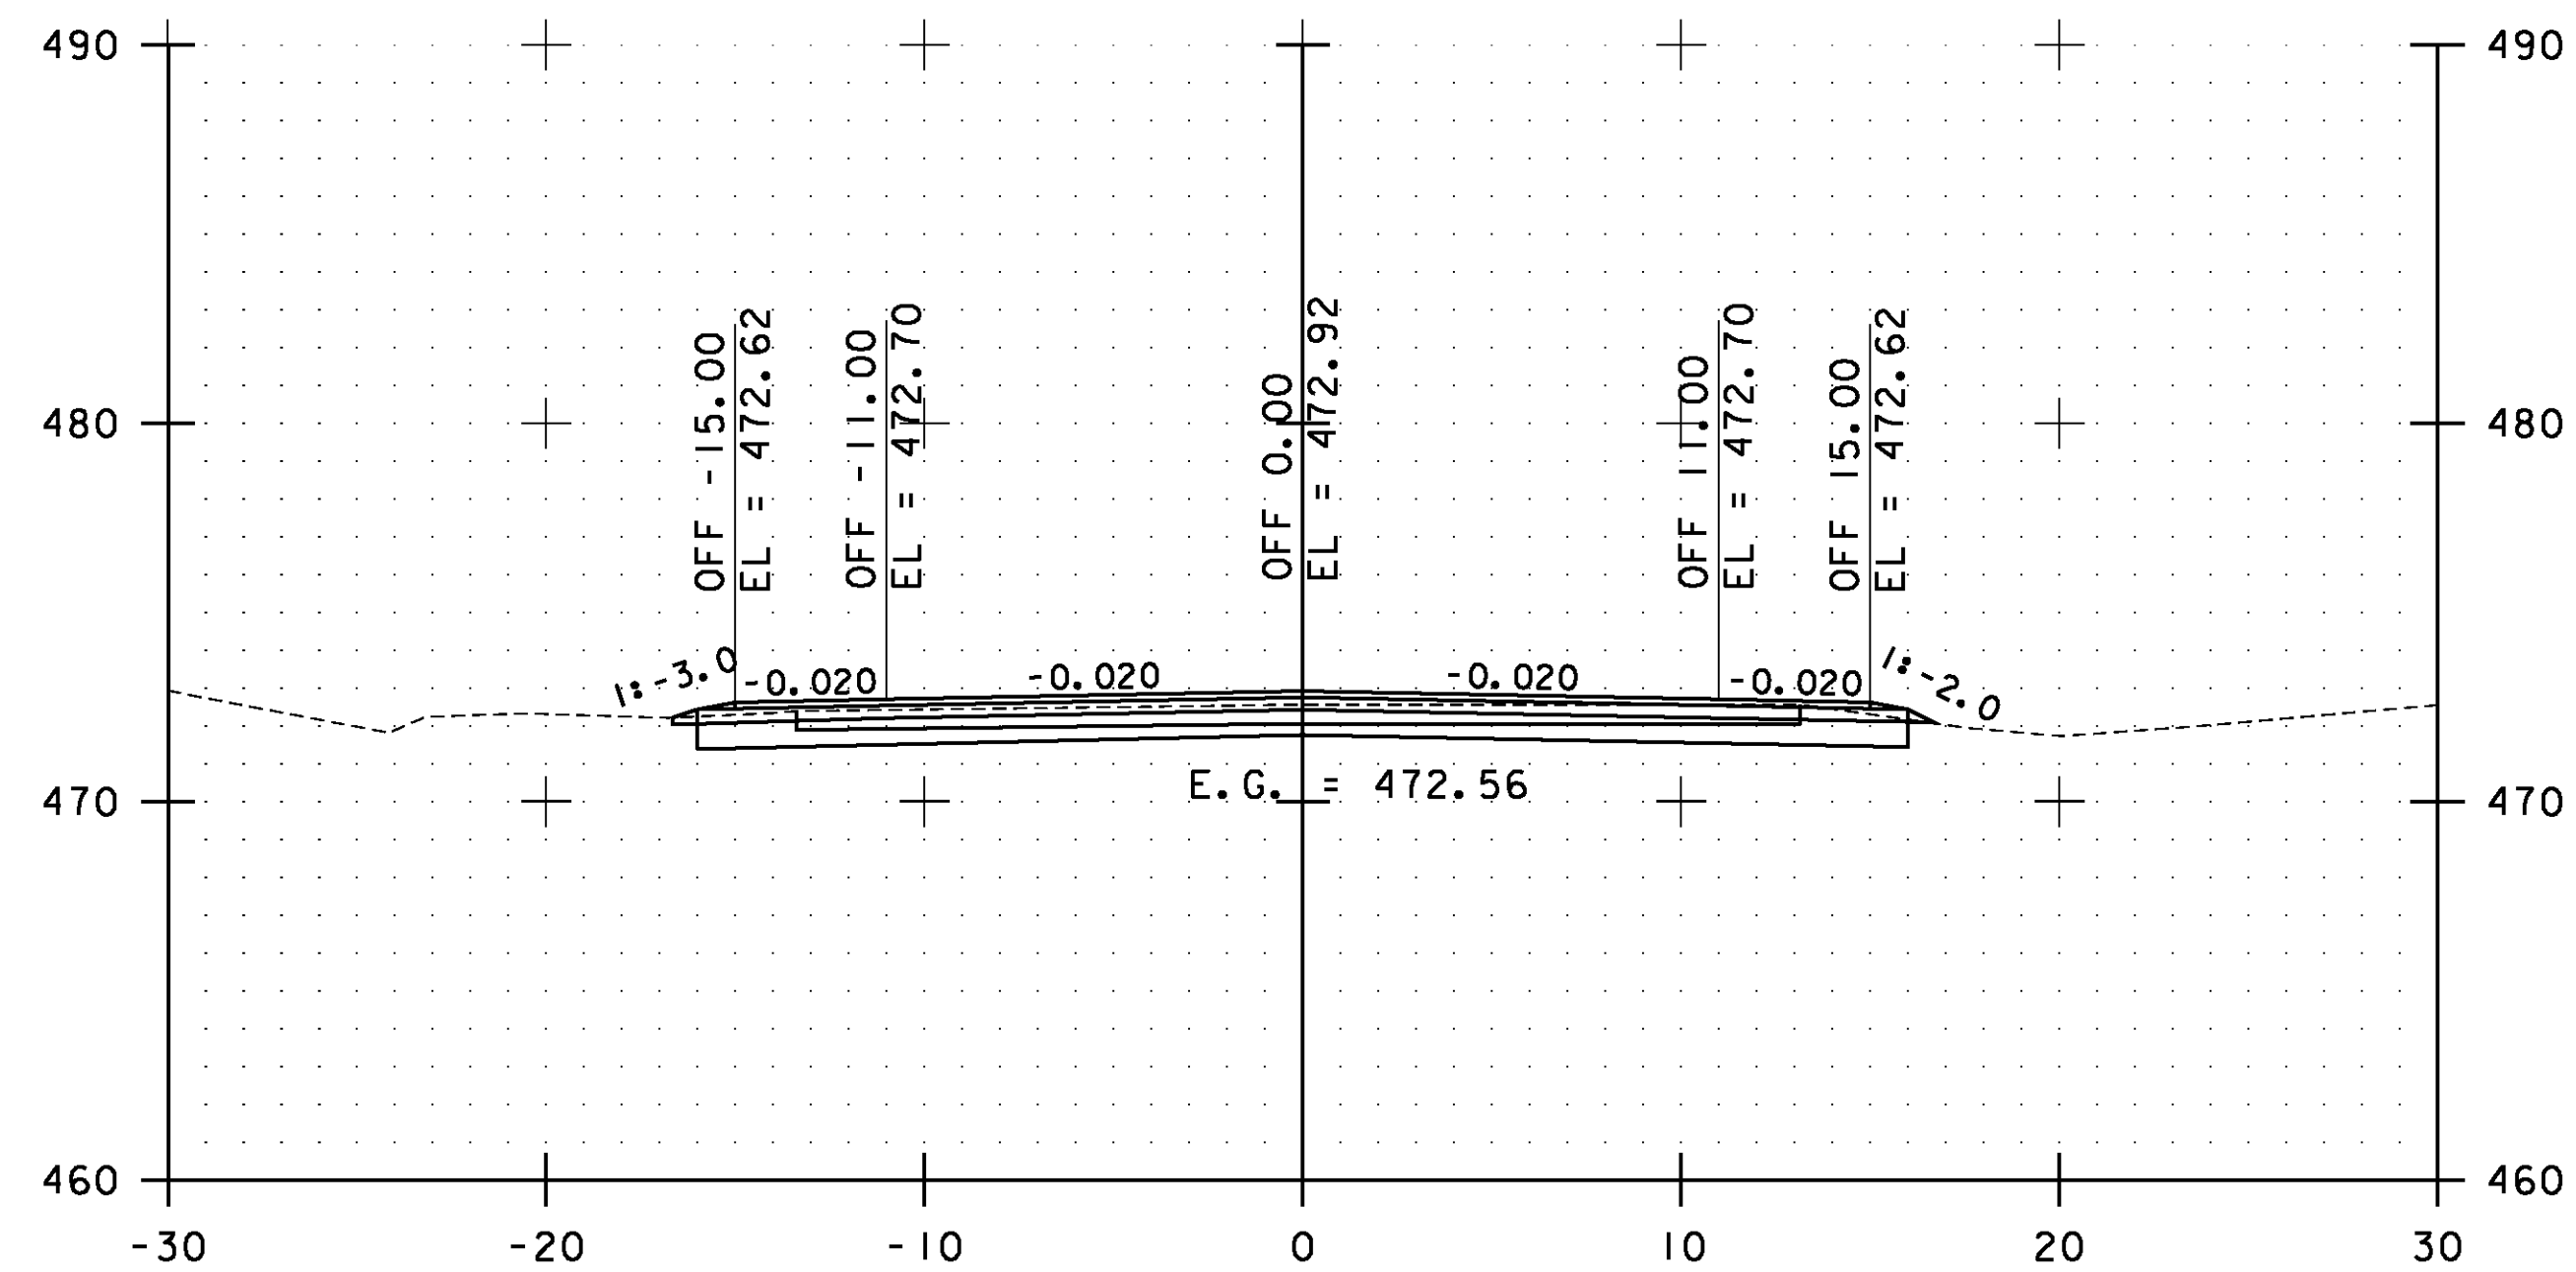


146+50.00

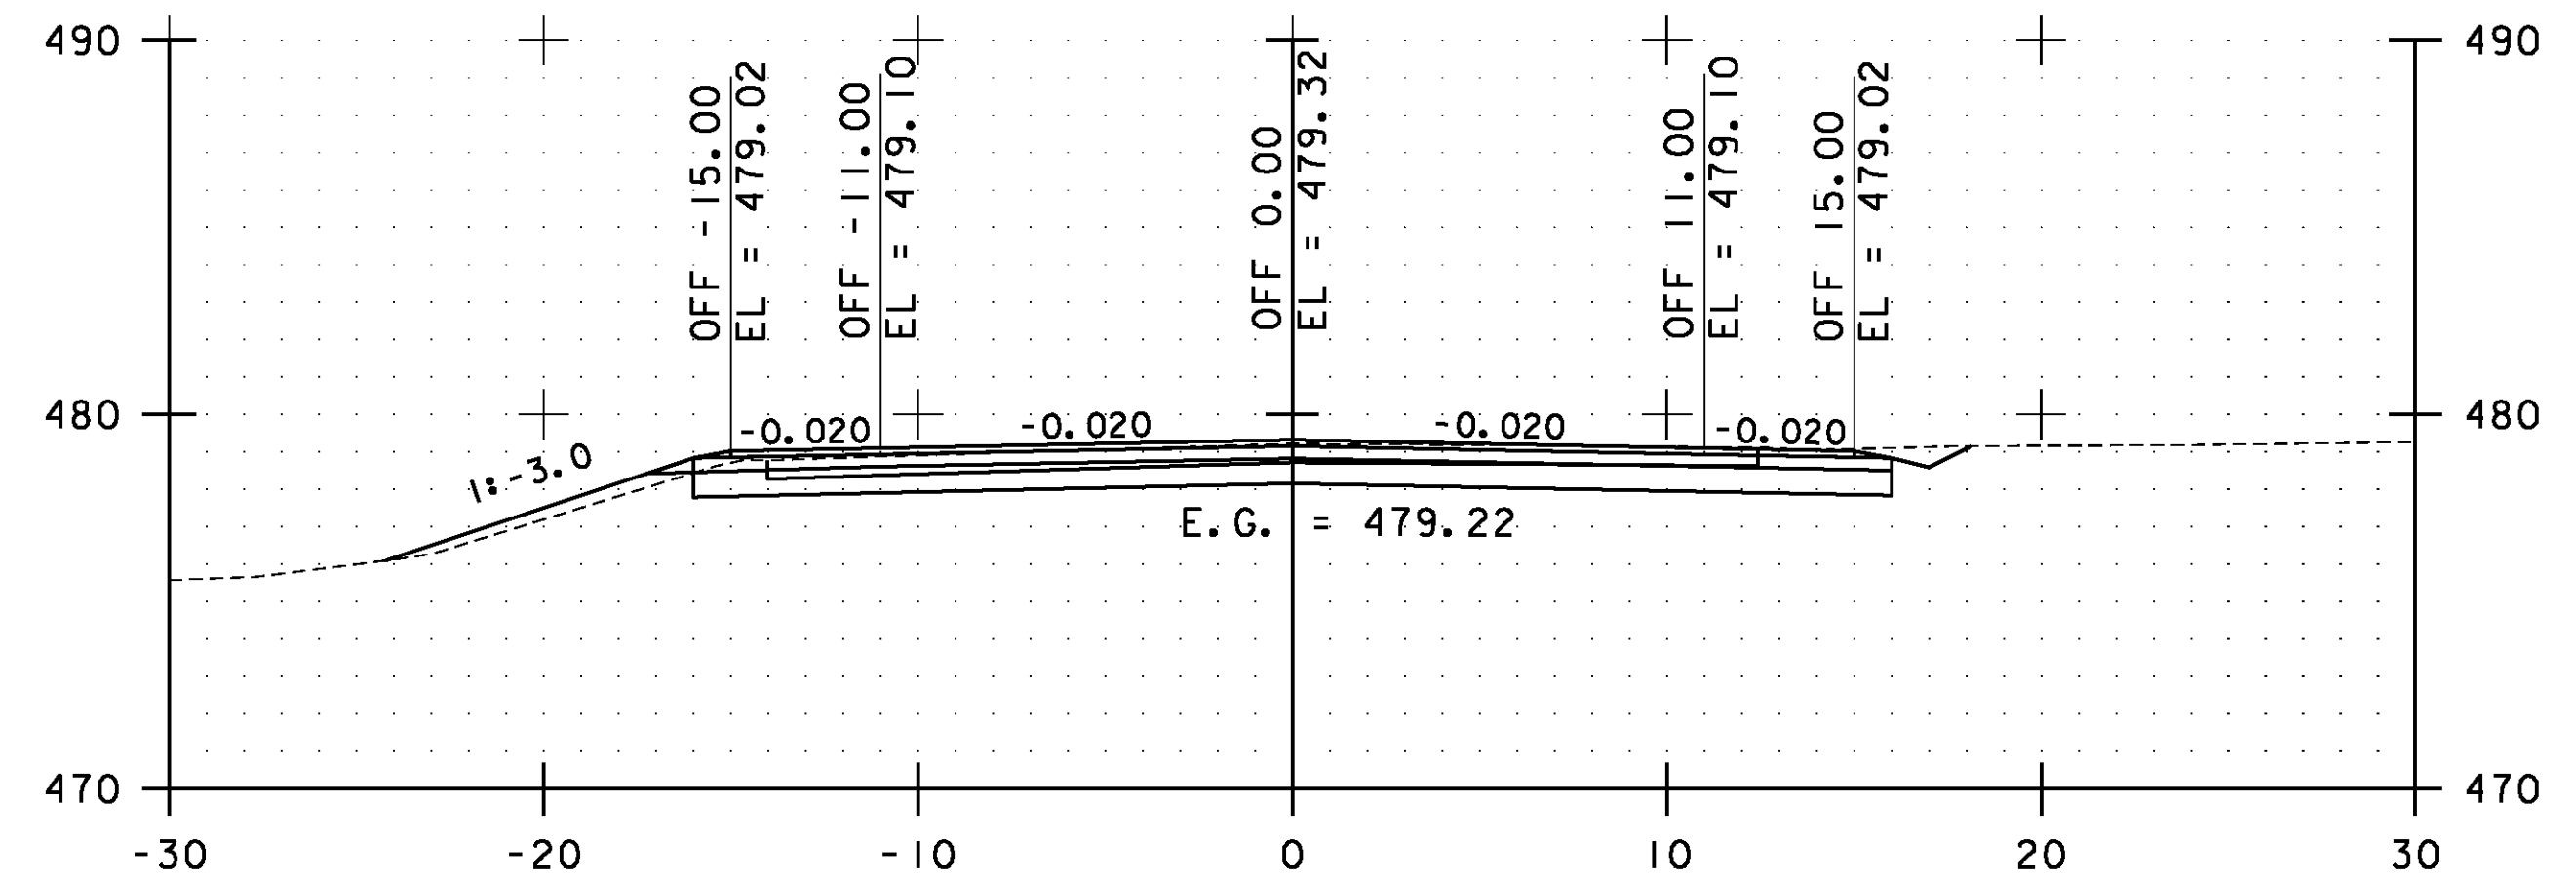

148+50.00

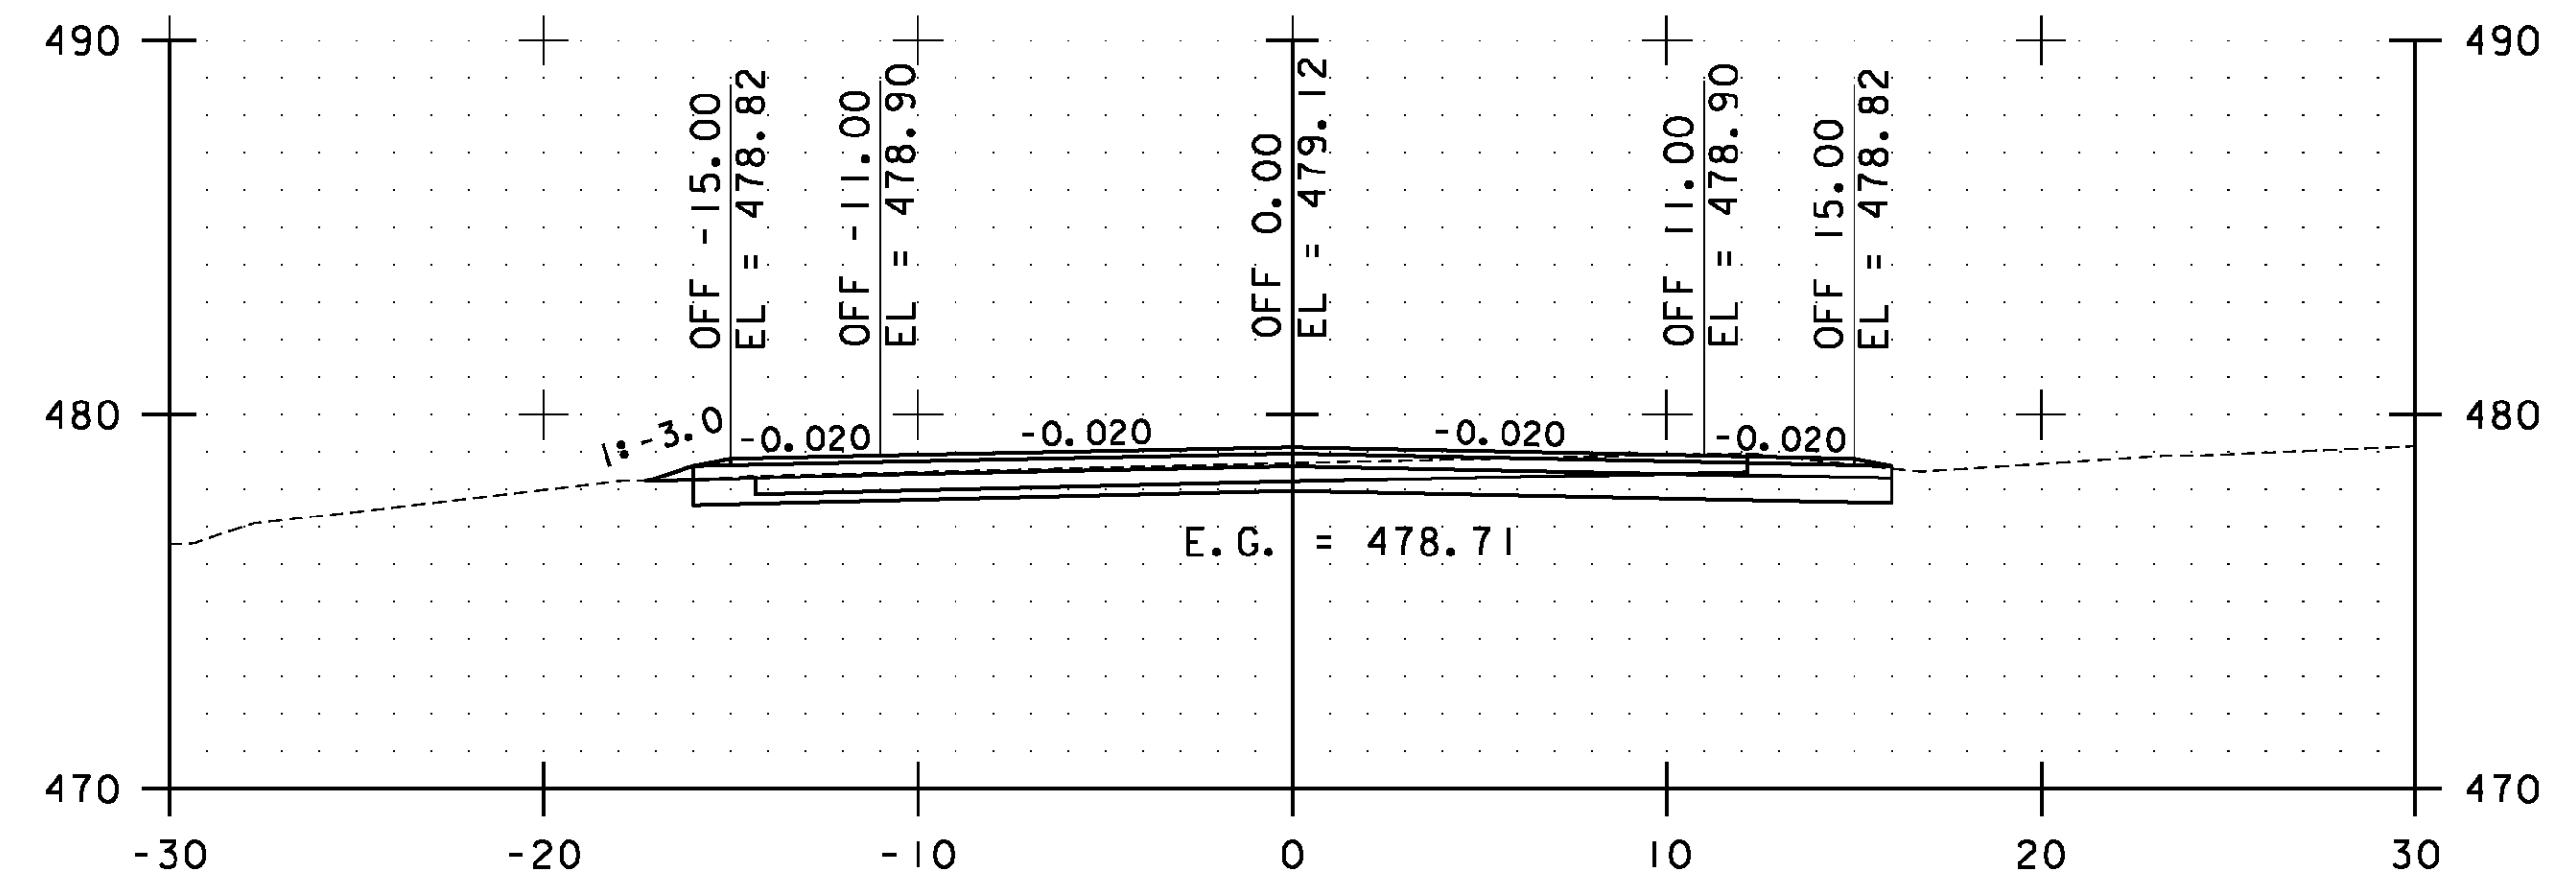


148+00.00

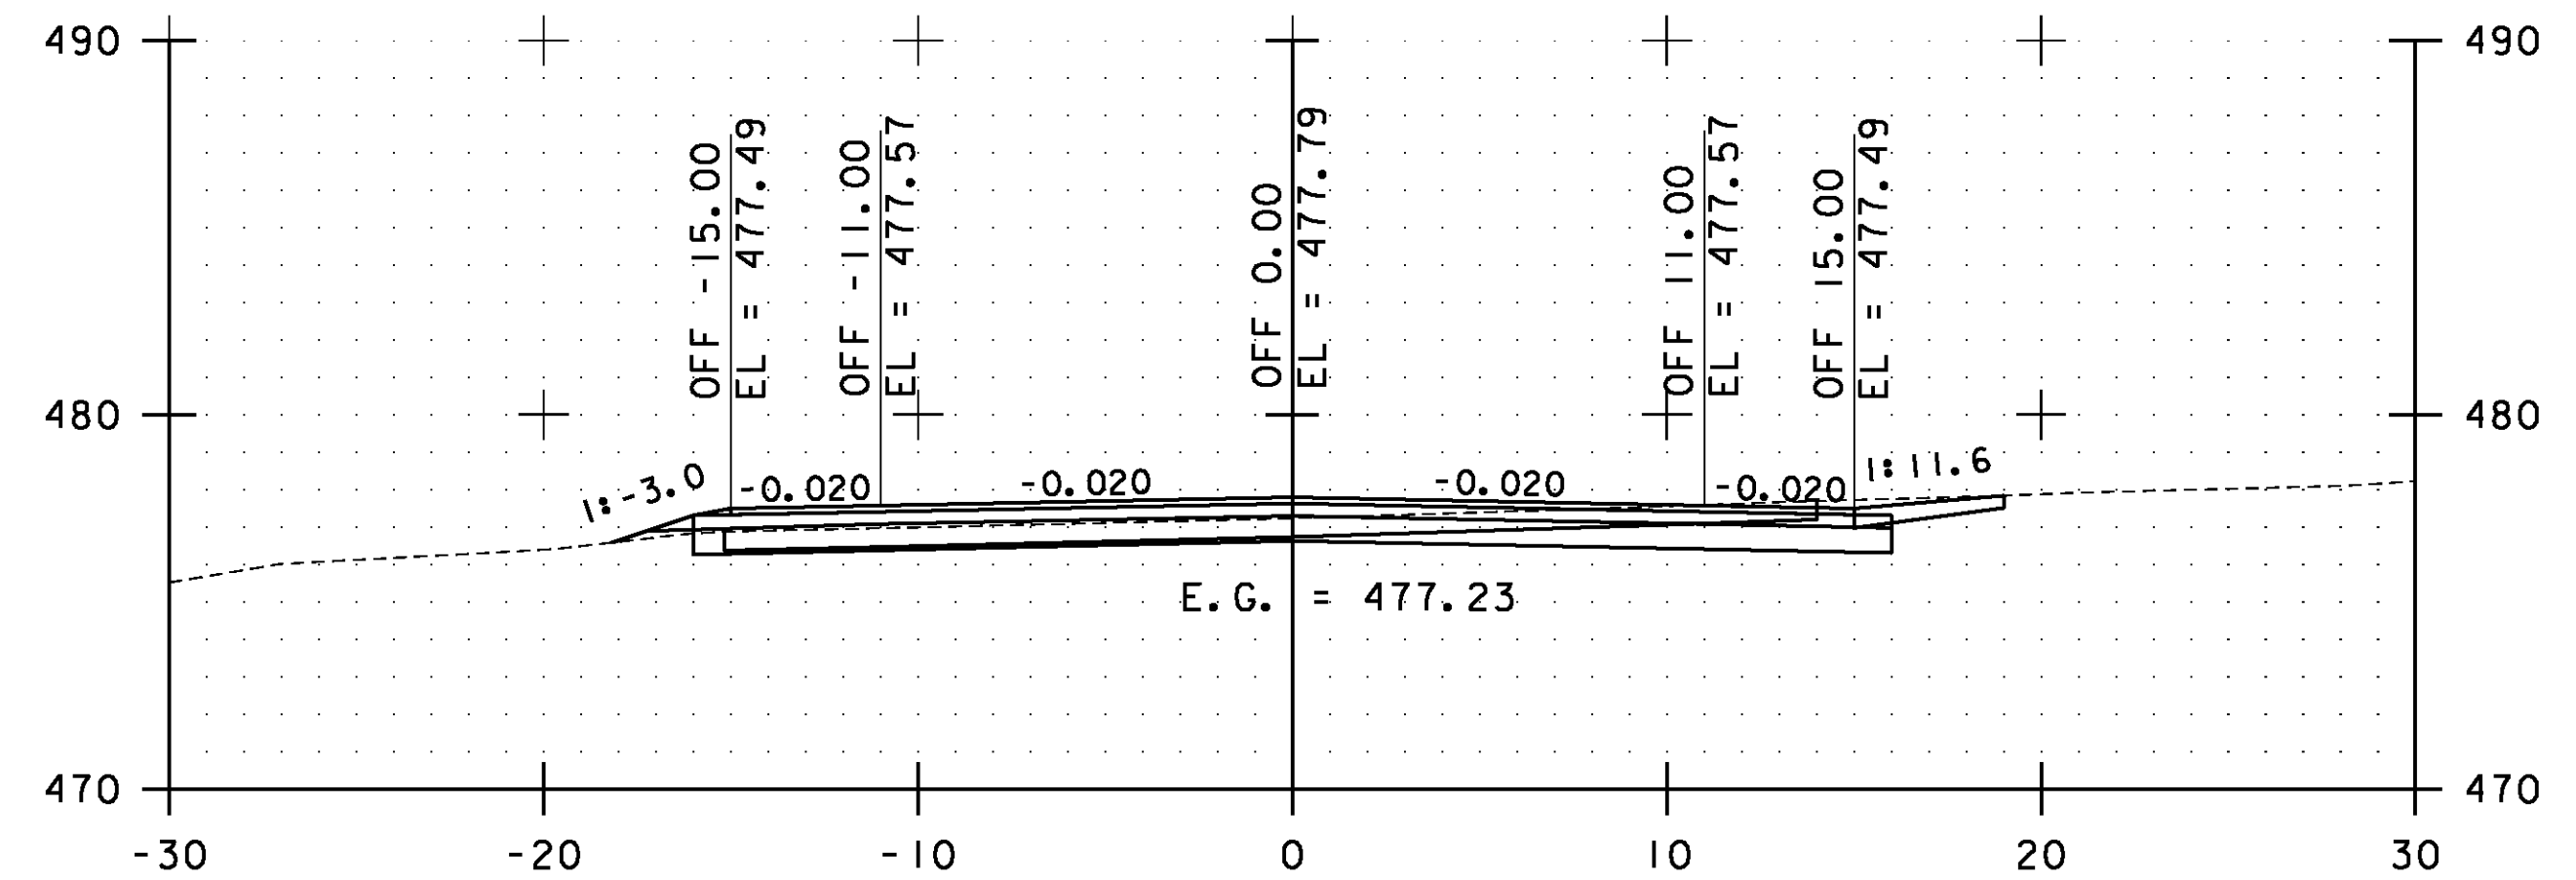

147+50.00

STA. 146+50.00 TO STA. 148+50.00

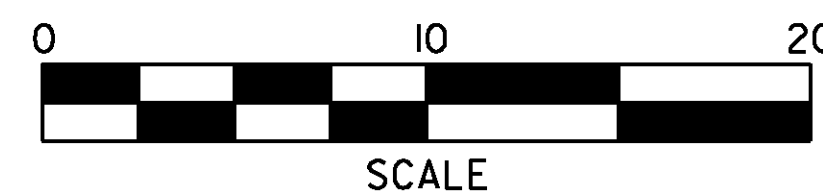

**ESSEX  
CROSS  
SECTIONS  
SHEET #68**

PROJECT NAME: ESSEX-WESTFORD  
PROJECT NUMBER: STP 2912(I)

FILE NAME: p10c226.dgn  
PROJECT LEADER: JLL  
DESIGNED BY: STANTEC  
IPARM FILE: p10c226xs068.i

PLOT DATE: 2/20/2013  
DRAWN BY: STANTEC  
CHECKED BY: STANTEC  
SHEET 159 OF 239