


STA. 151+50.00 TO STA. 153+00.00

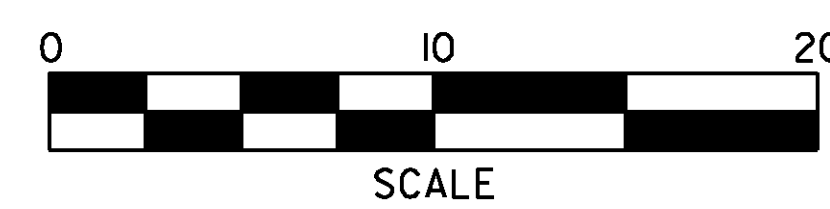

**ESSEX  
CROSS  
SECTIONS  
SHEET #70**

PROJECT NAME: ESSEX-WESTFORD	PLOT DATE: 2/20/2013
PROJECT NUMBER: STP 2912(I)	DRAWN BY: STANTEC
FILE NAME: p10c226.dgn	CHECKED BY: STANTEC
PROJECT LEADER: JLL	SHEET 161 OF 239
DESIGNED BY: STANTEC	
IPARM FILE: p10c226xs070.i	