




154+00.00

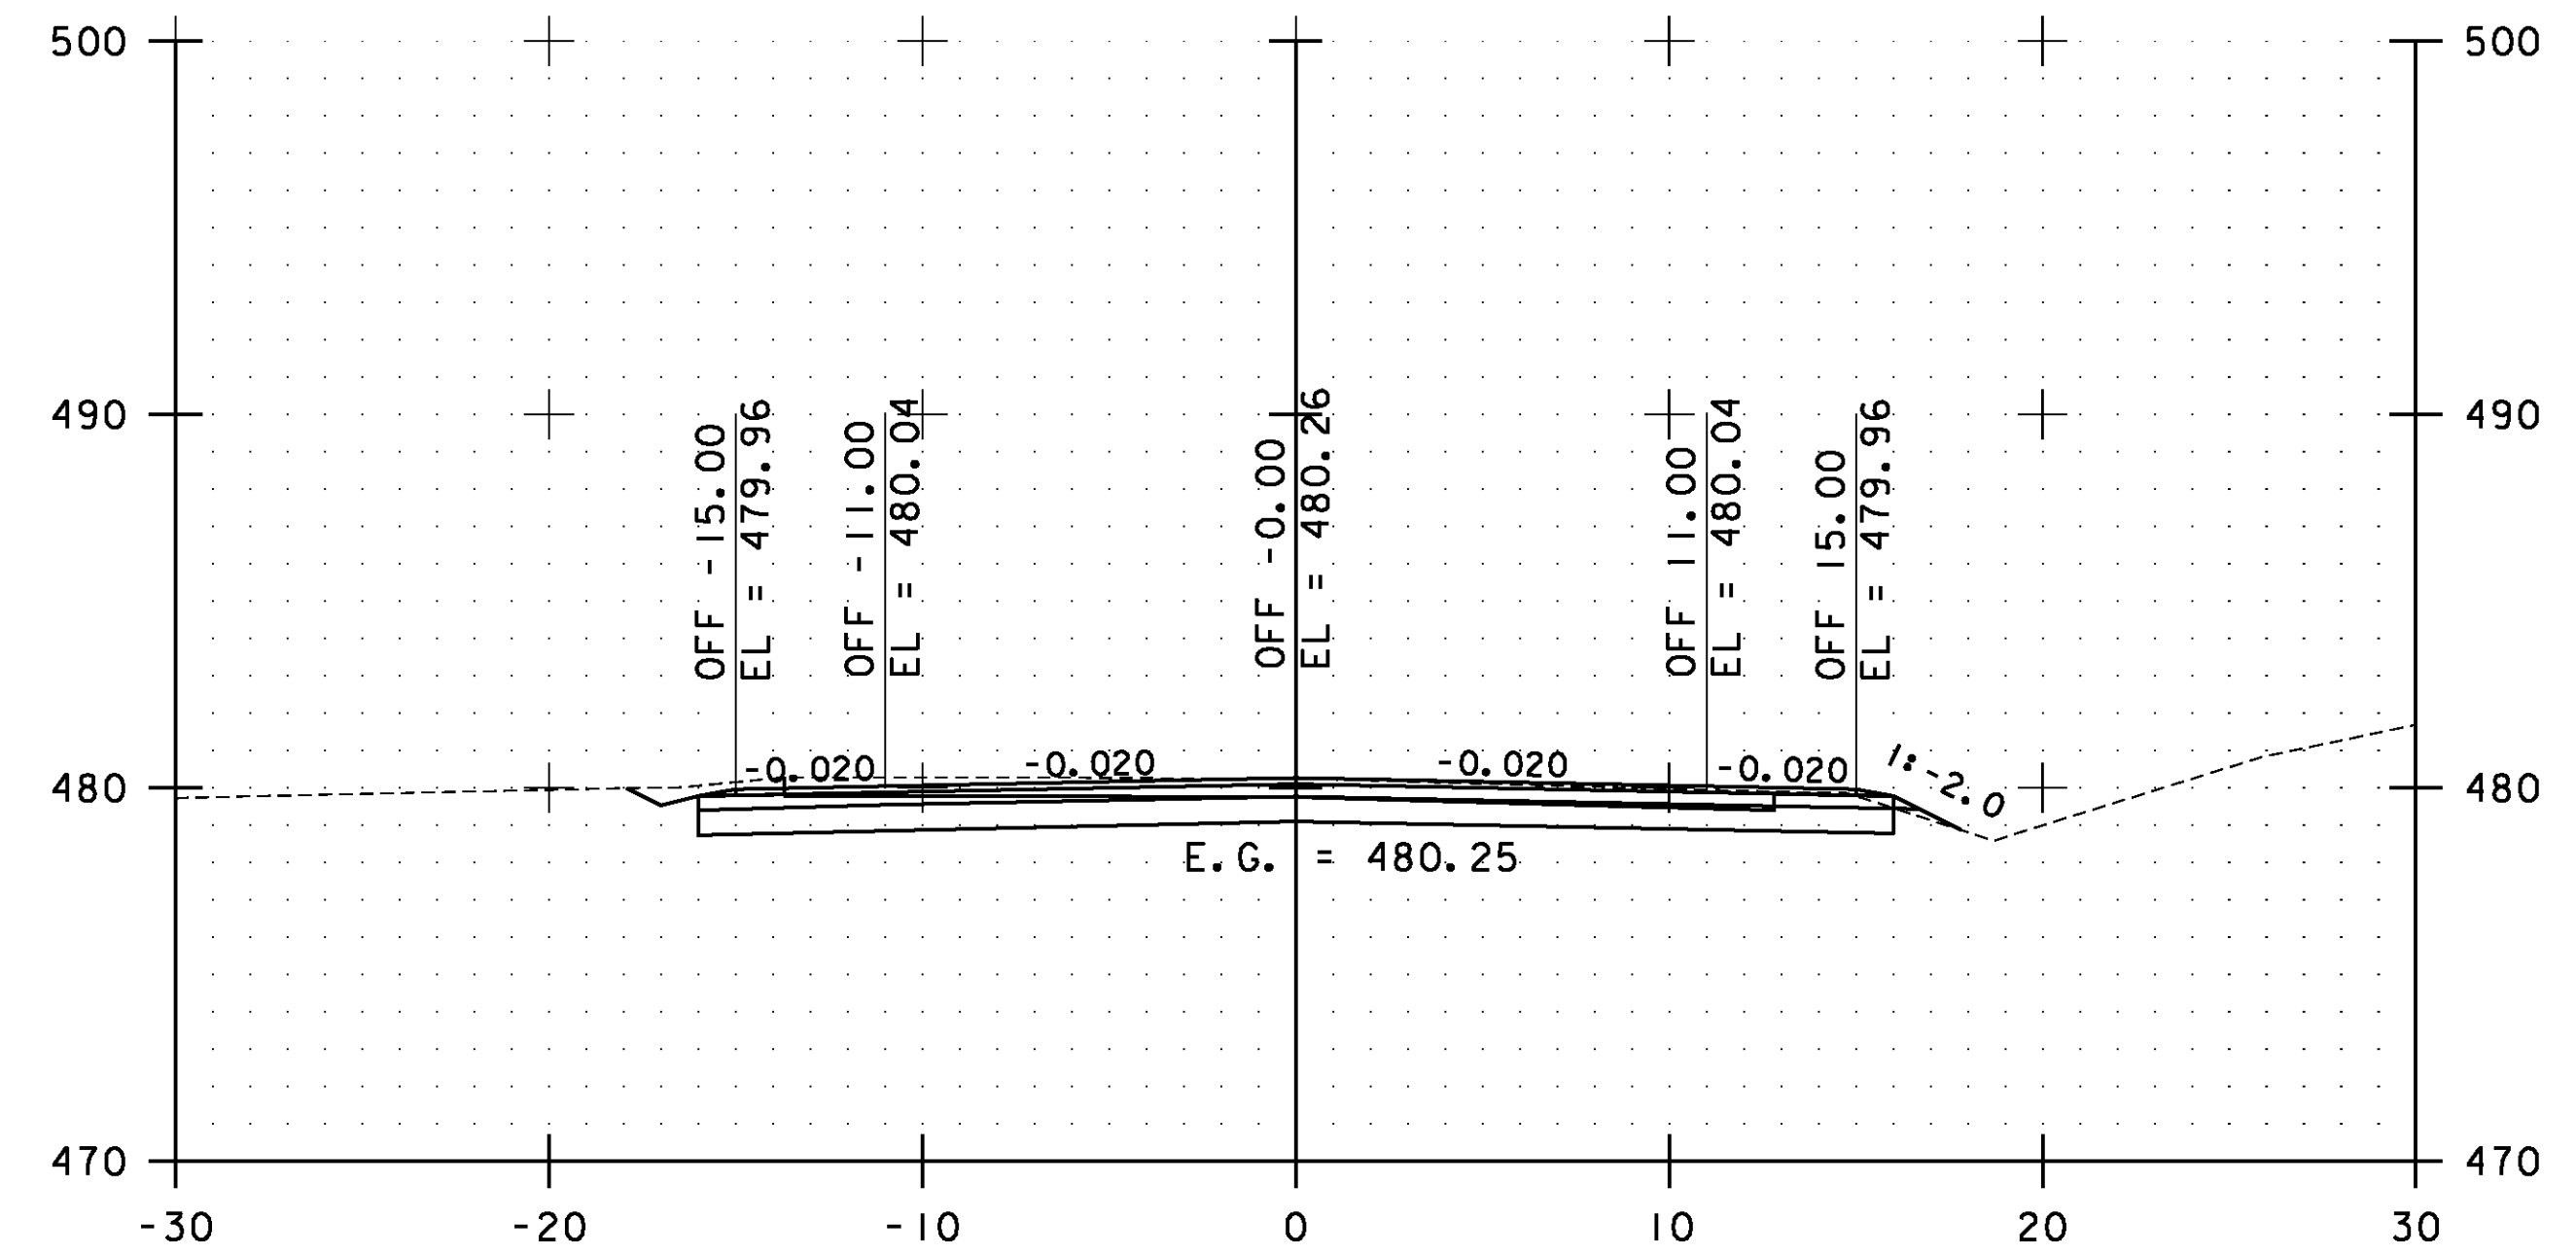

155+00.00

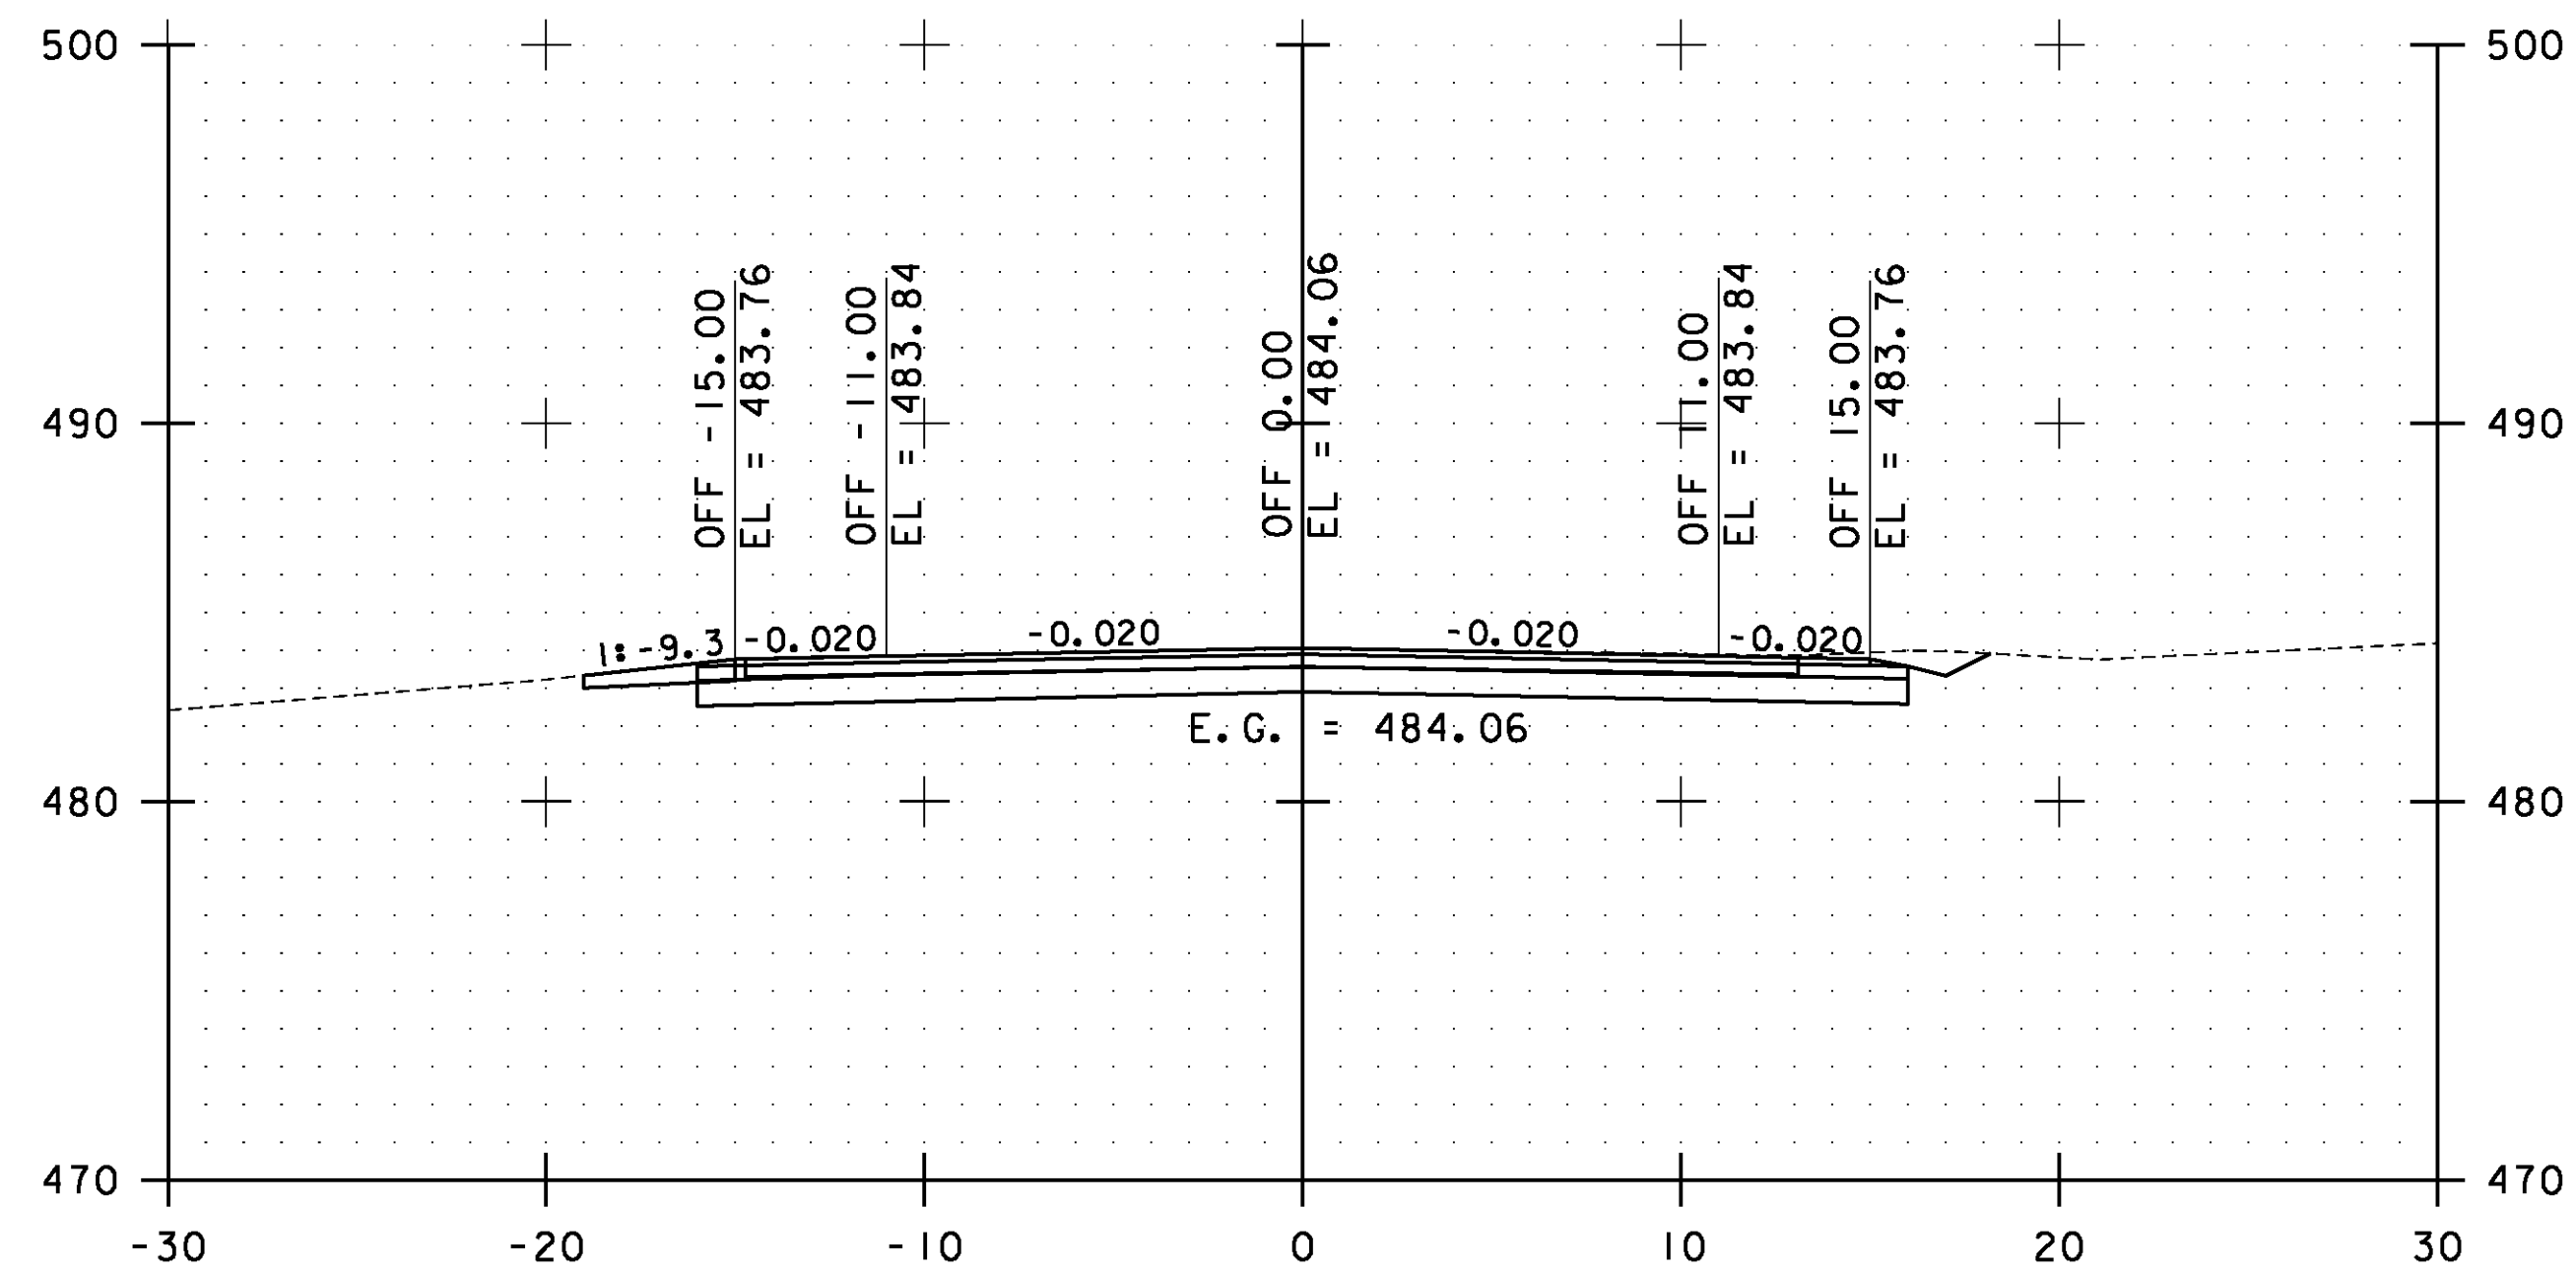


153+50.00

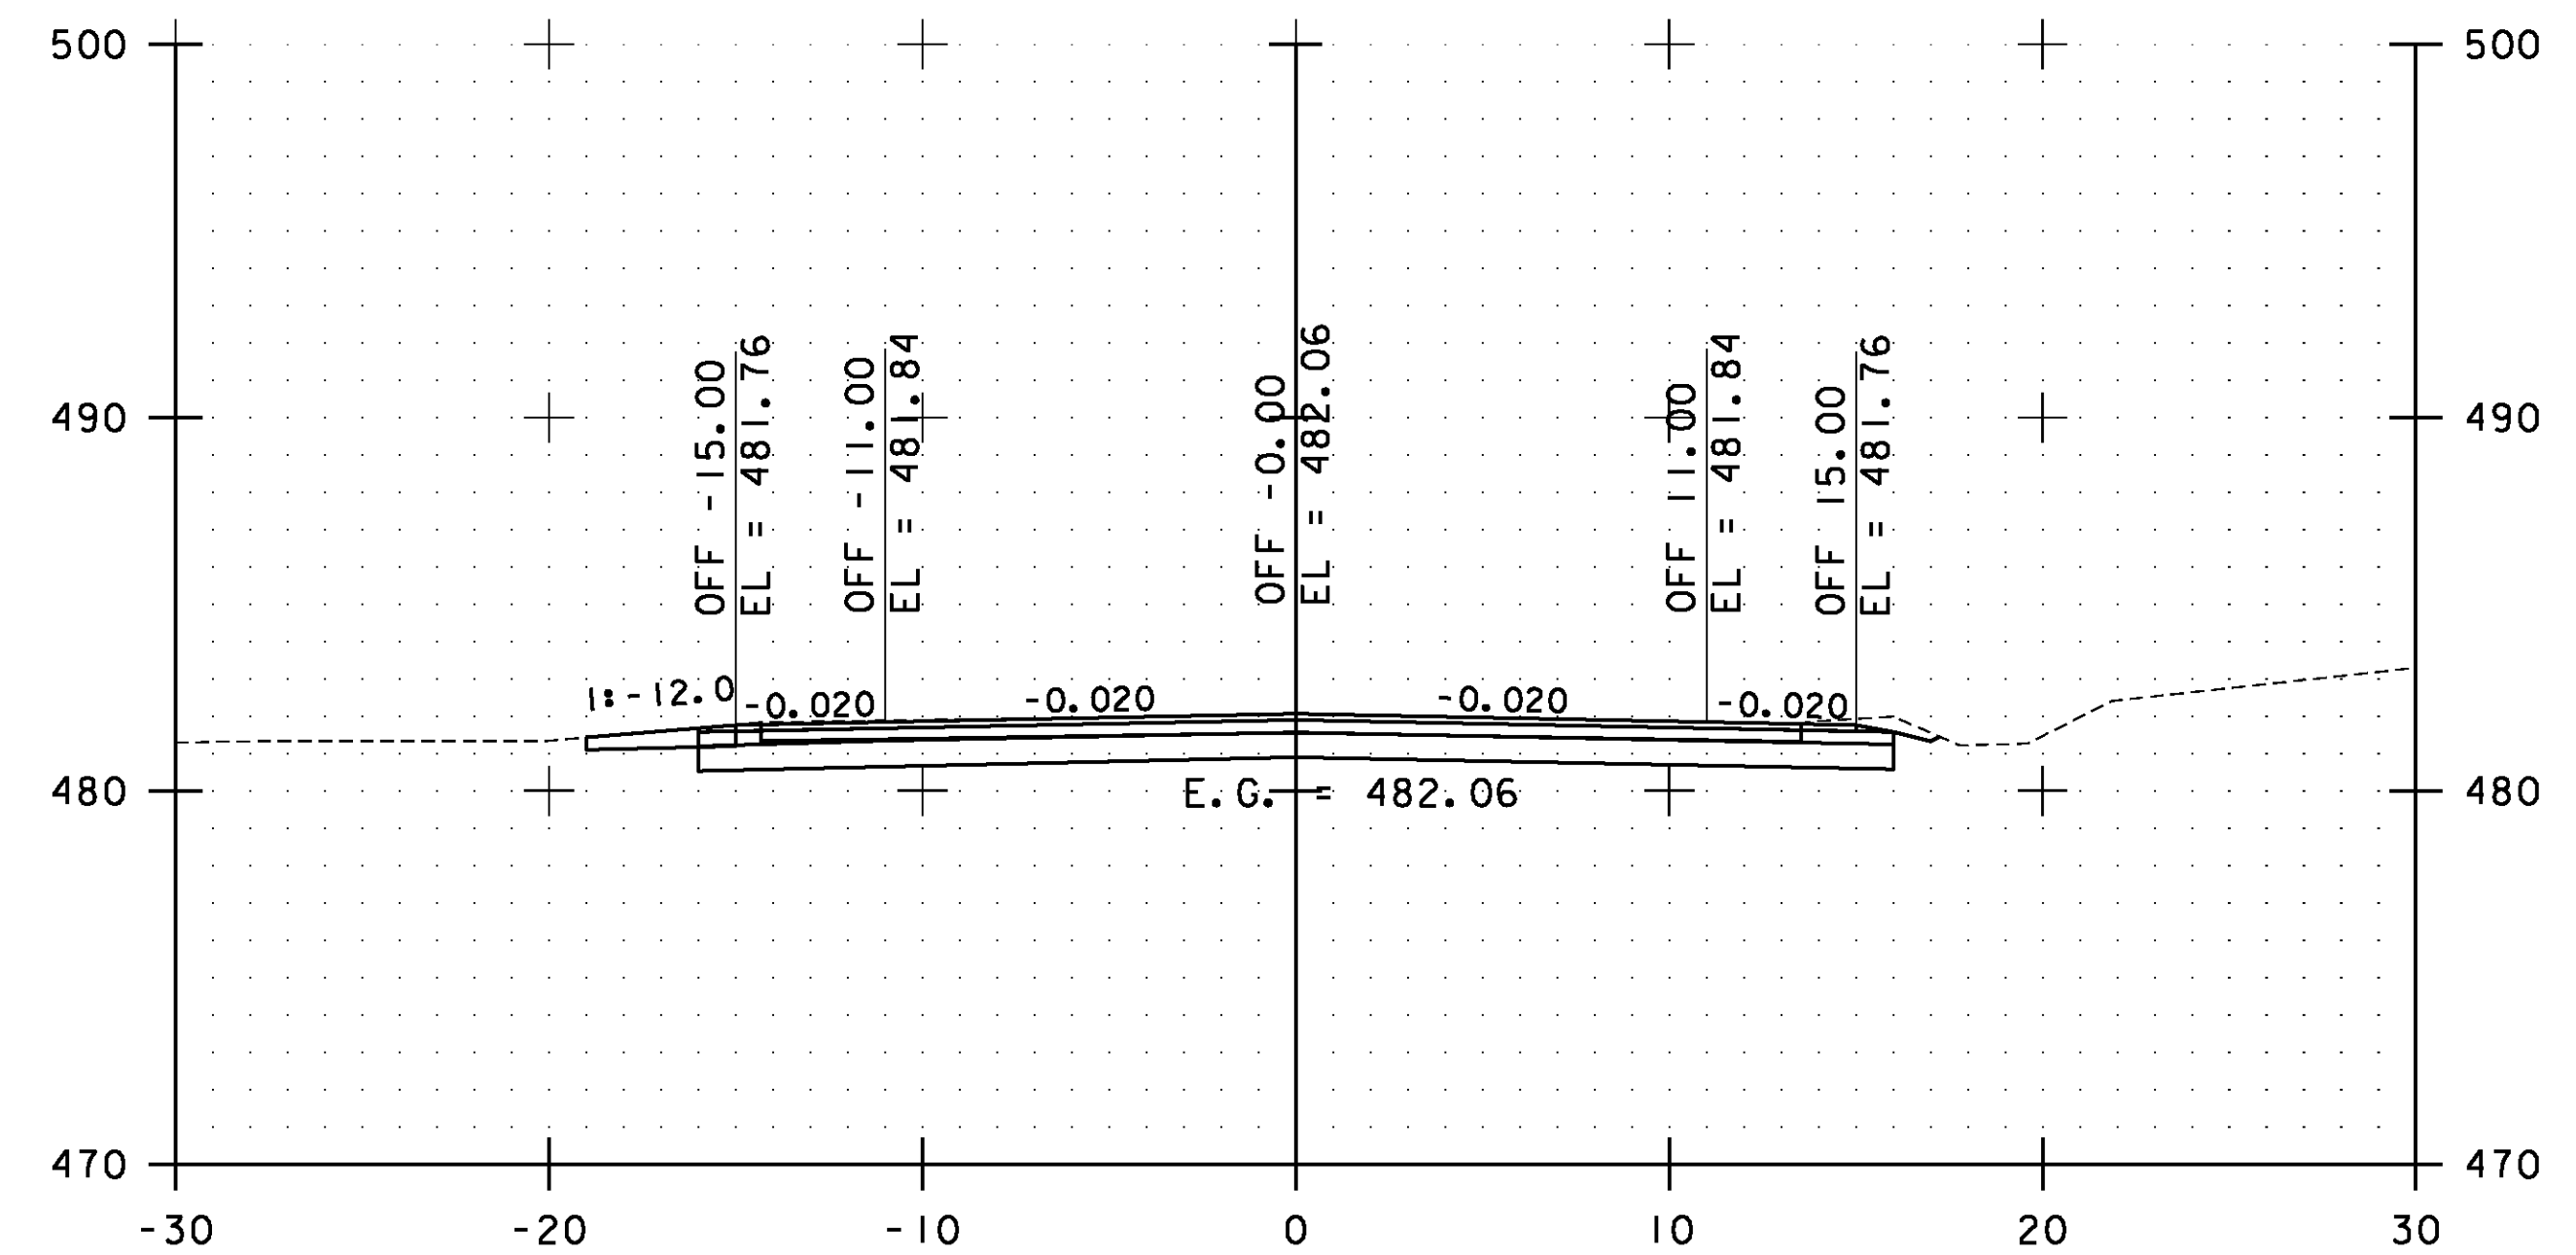

154+50.00

STA. 153+50.00 TO STA. 155+00.00

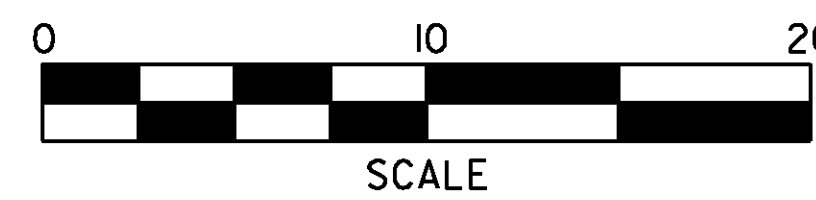

**ESSEX
CROSS
SECTIONS
SHEET #71**

PROJECT NAME: ESSEX-WESTFORD
PROJECT NUMBER: STP 2912(I)

FILE NAME: p10c226.dgn
PROJECT LEADER: JLL
DESIGNED BY: STANTEC
IPARM FILE: p10c226xs071.i

PLOT DATE: 2/20/2013
DRAWN BY: STANTEC
CHECKED BY: STANTEC
SHEET 162 OF 239