


STA. 157+50.00 TO STA. 159+00.00

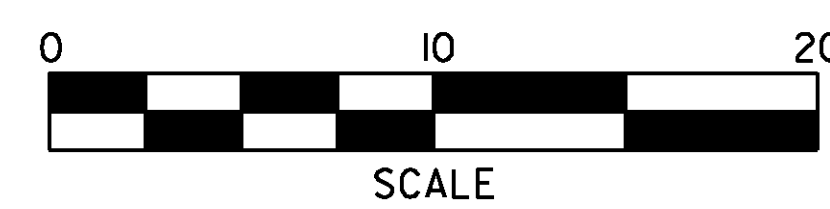

**ESSEX
CROSS
SECTIONS
SHEET #73**

PROJECT NAME:	ESSEX-WESTFORD
PROJECT NUMBER:	STP 2912(I)
FILE NAME:	p10c226.dgn
PROJECT LEADER:	JLL
DESIGNED BY:	STANTEC
IPARM FILE:	p10c226xs073.i
PLOT DATE:	2/20/2013
DRAWN BY:	STANTEC
CHECKED BY:	STANTEC
SHEET	164 OF 239