




160+00.00

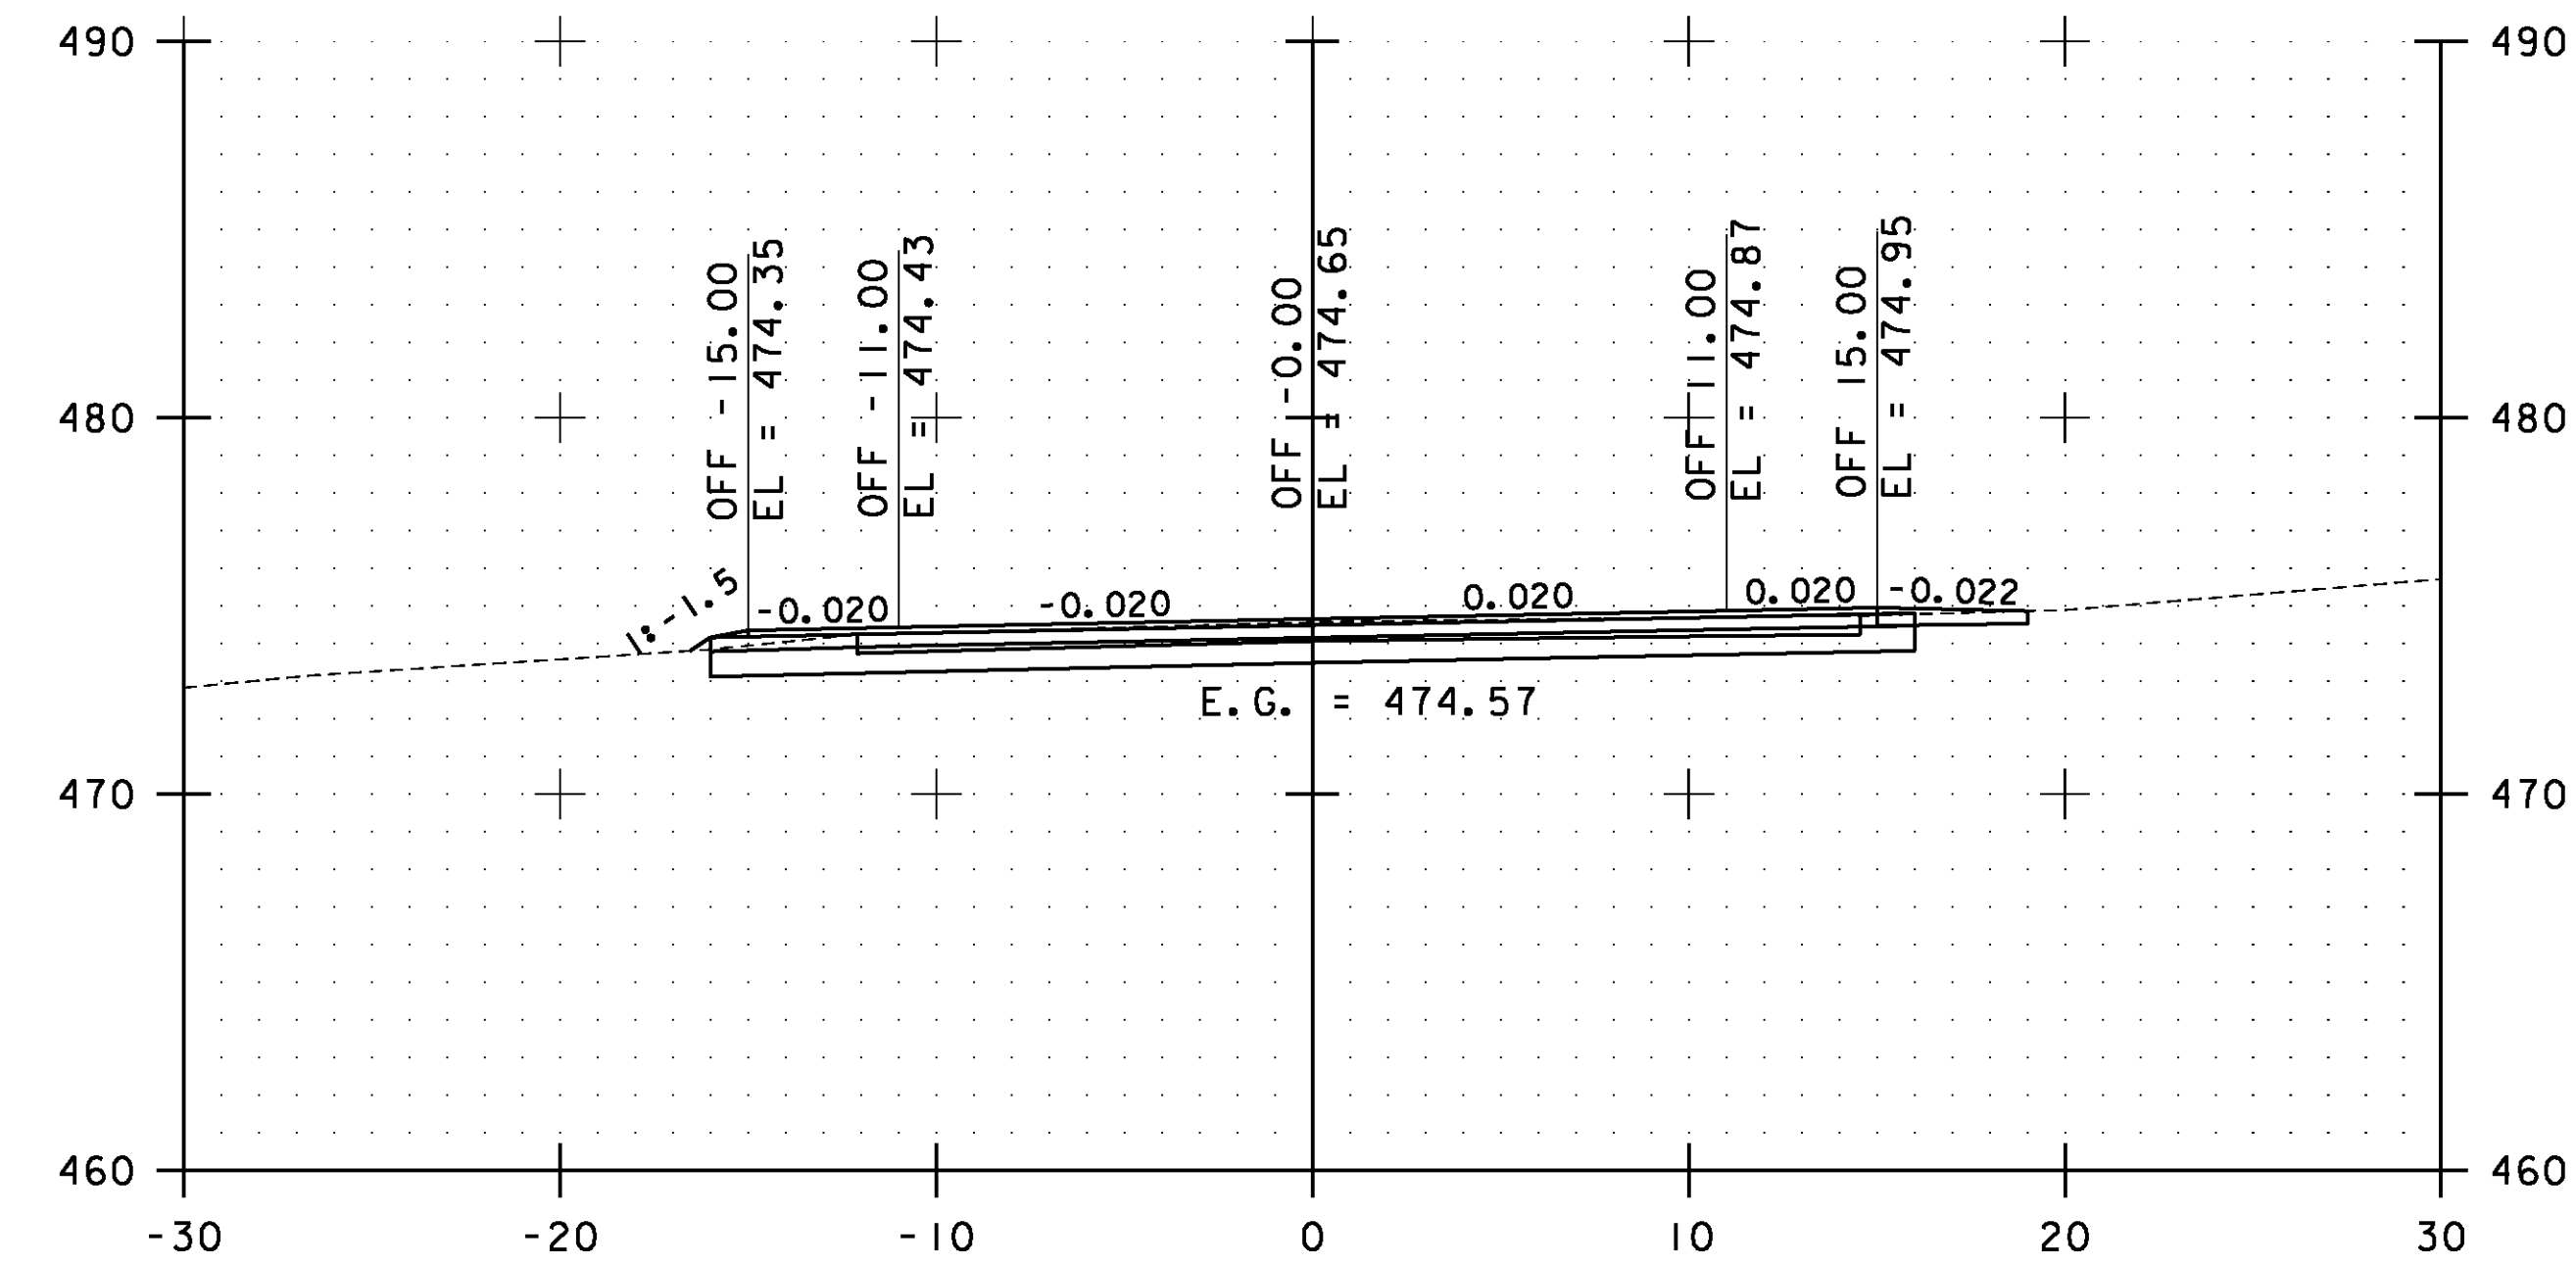

161+00.00

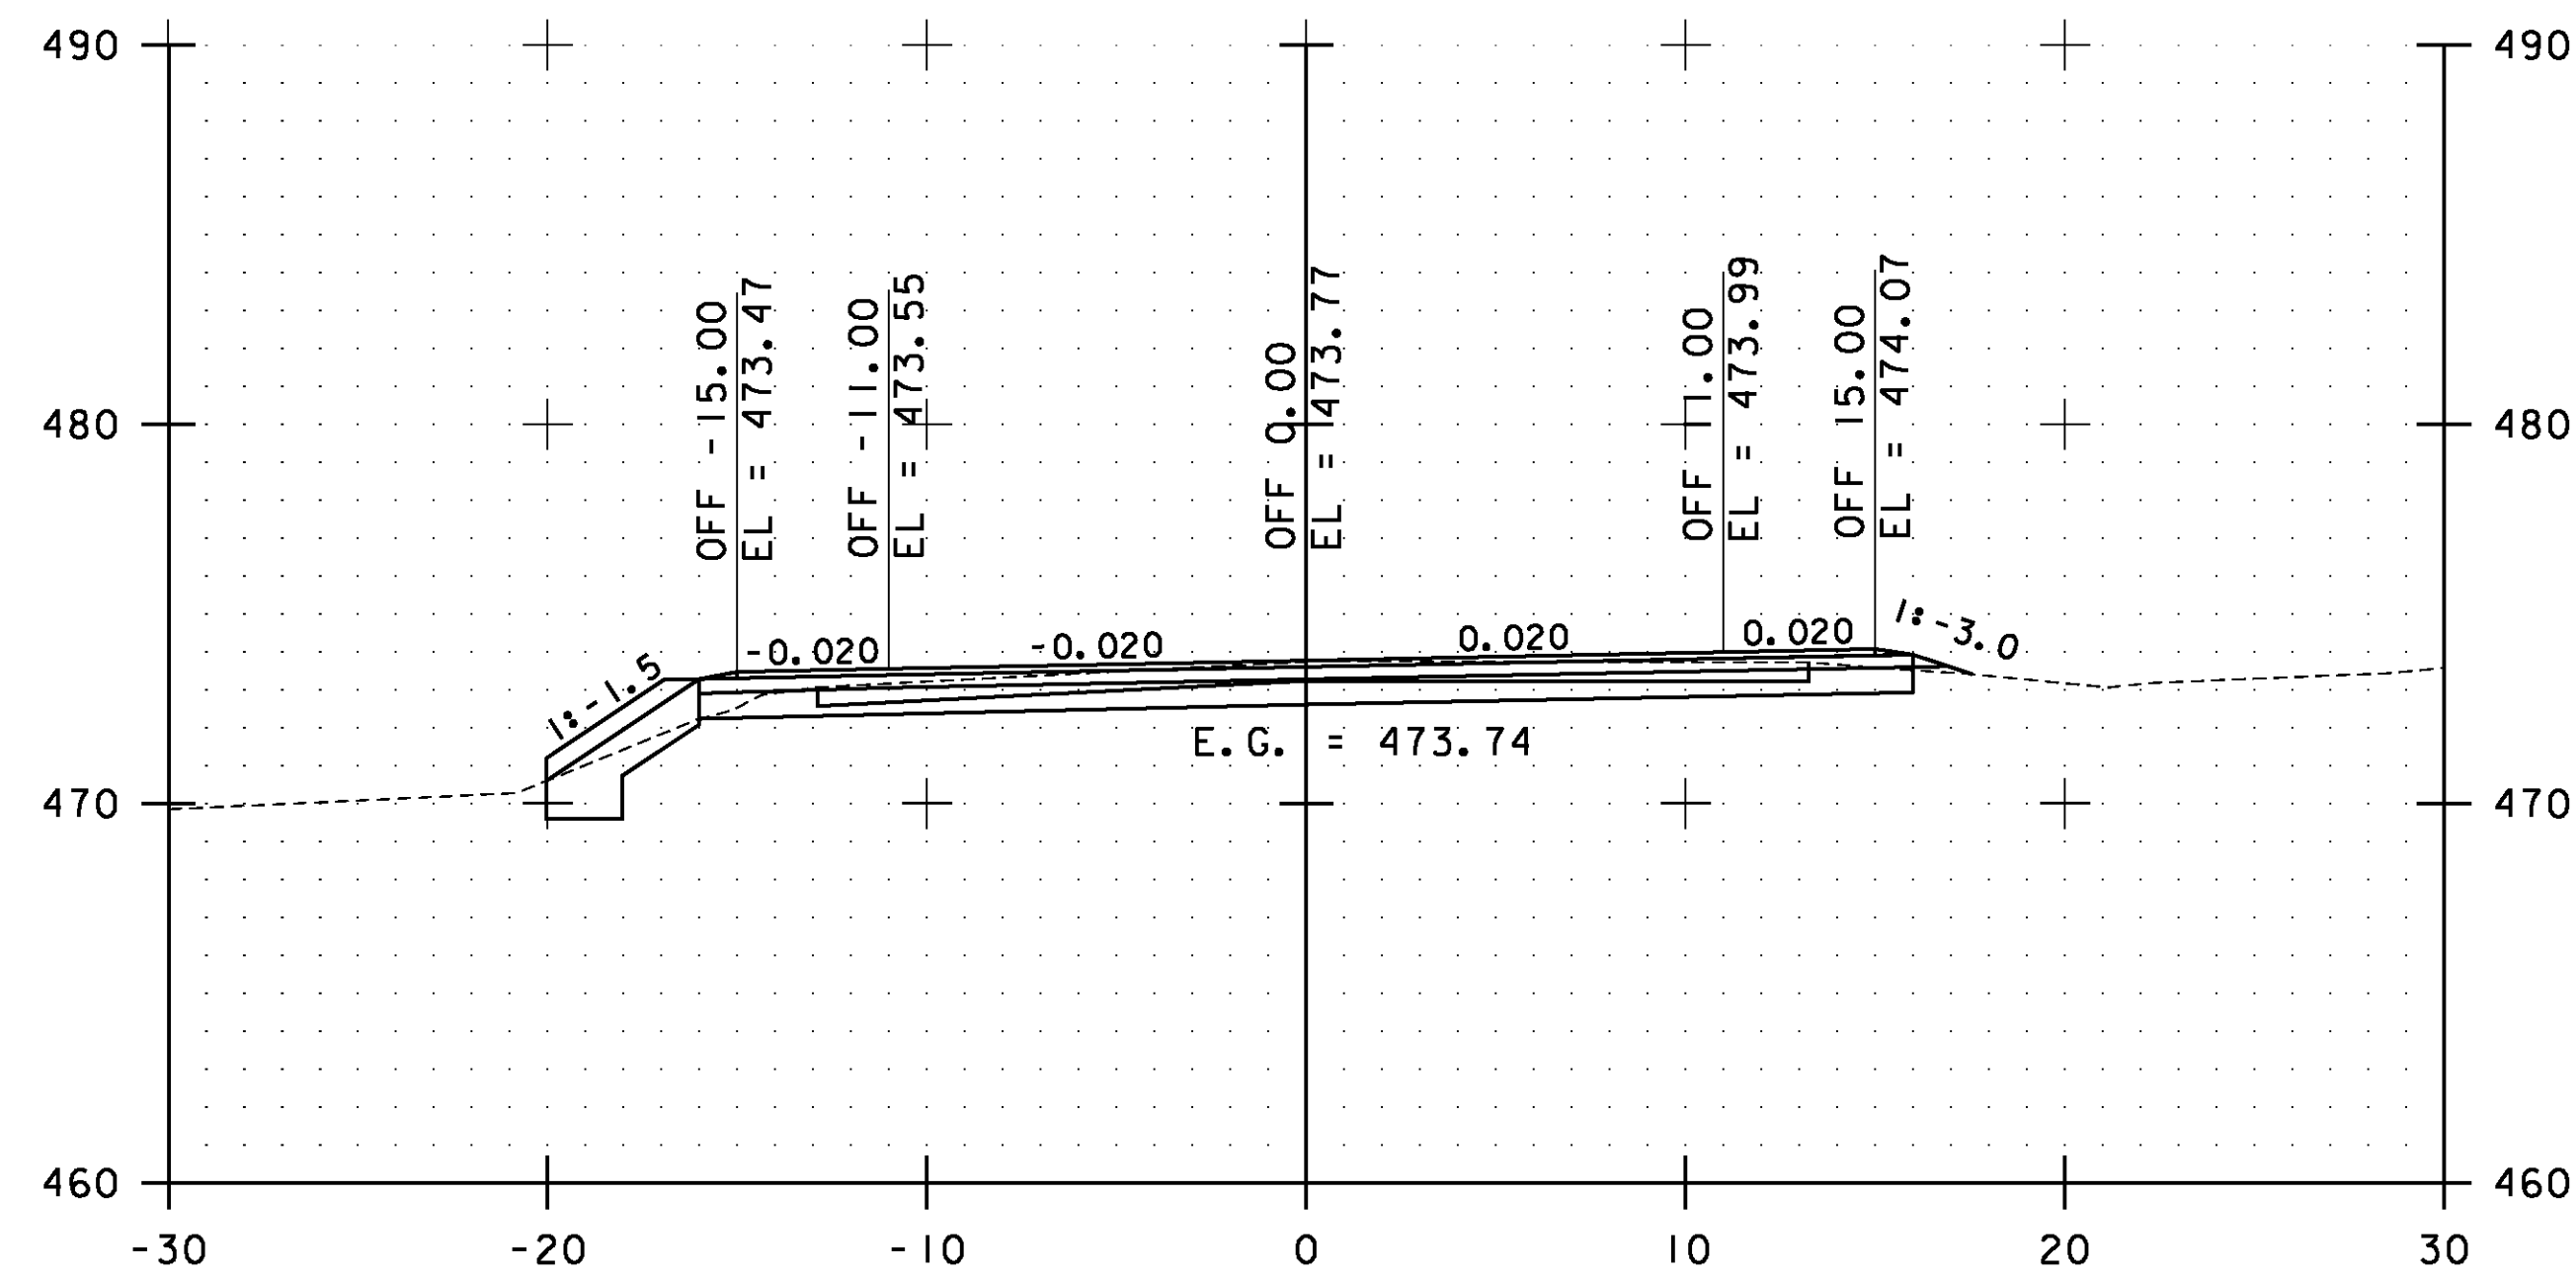


159+50.00

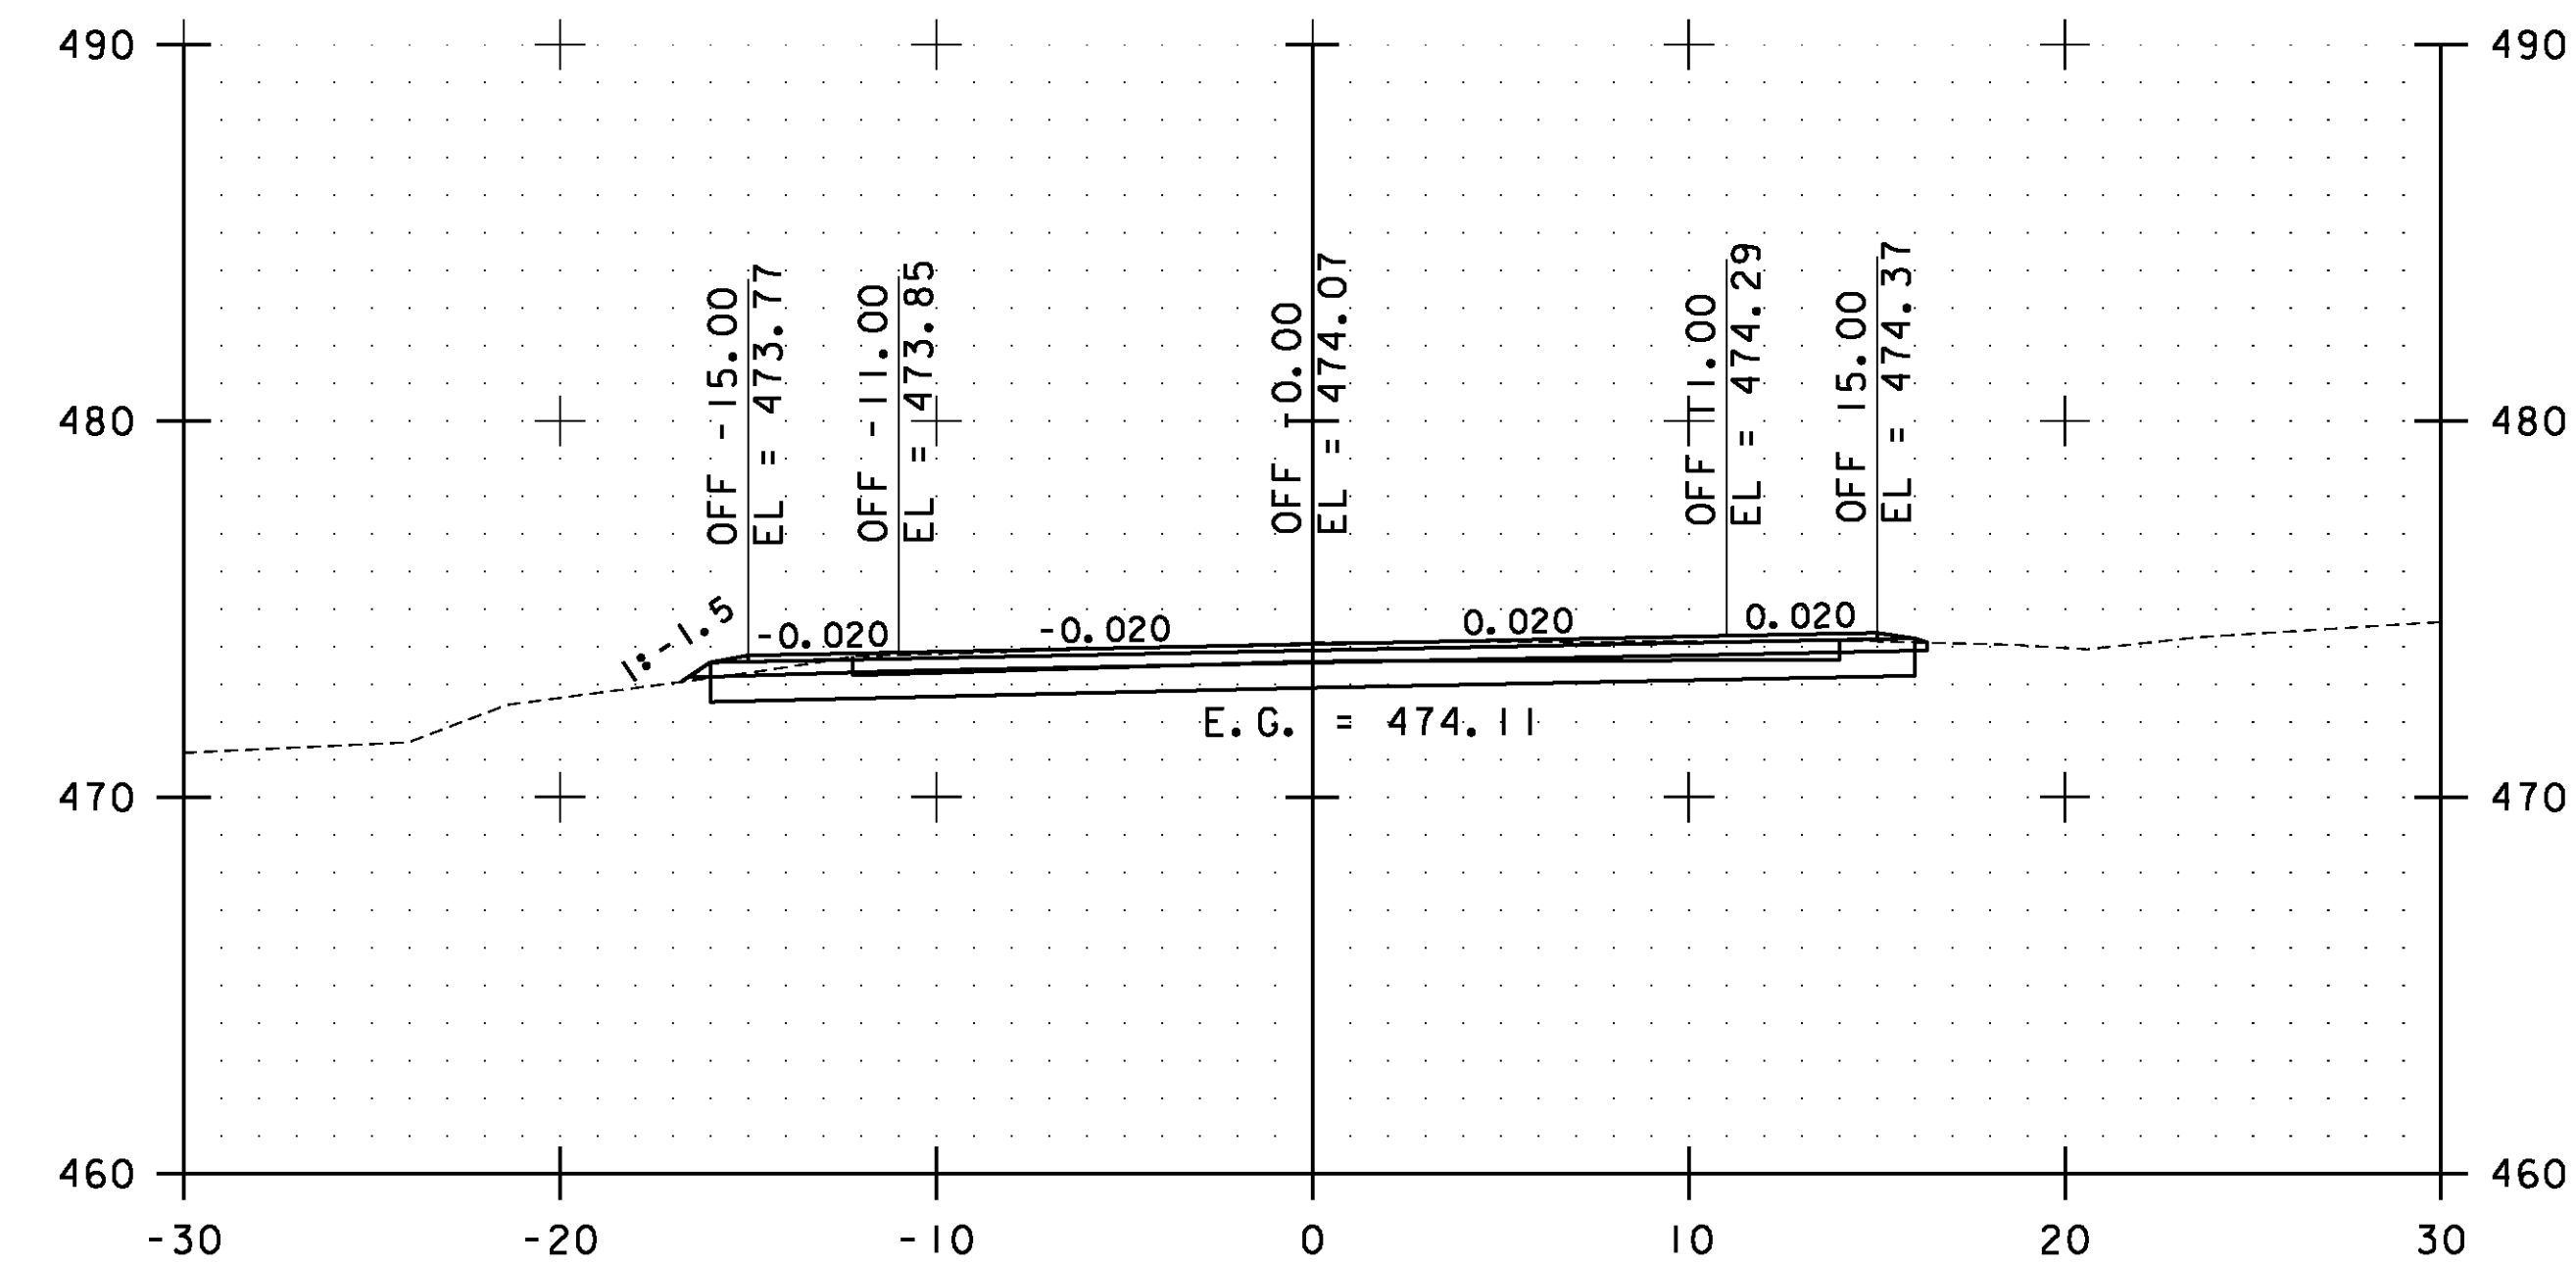

160+50.00

STA. 159+50.00 TO STA. 161+00.00

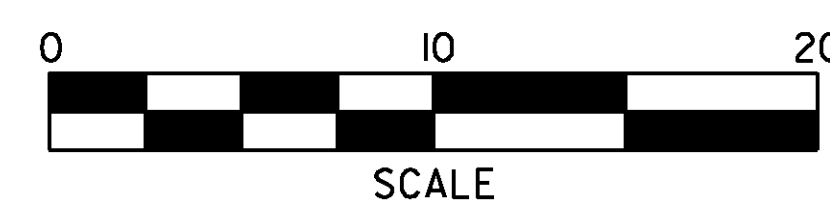

**ESSEX
CROSS
SECTIONS
SHEET #74**

PROJECT NAME: ESSEX-WESTFORD	PLOT DATE: 2/20/2013
PROJECT NUMBER: STP 2912(I)	DRAWN BY: STANTEC
FILE NAME: p10c226.dgn	CHECKED BY: STANTEC
PROJECT LEADER: JLL	SHEET 165 OF 239
DESIGNED BY: STANTEC	
IPARM FILE: p10c226xs074.i	