




170+00.00

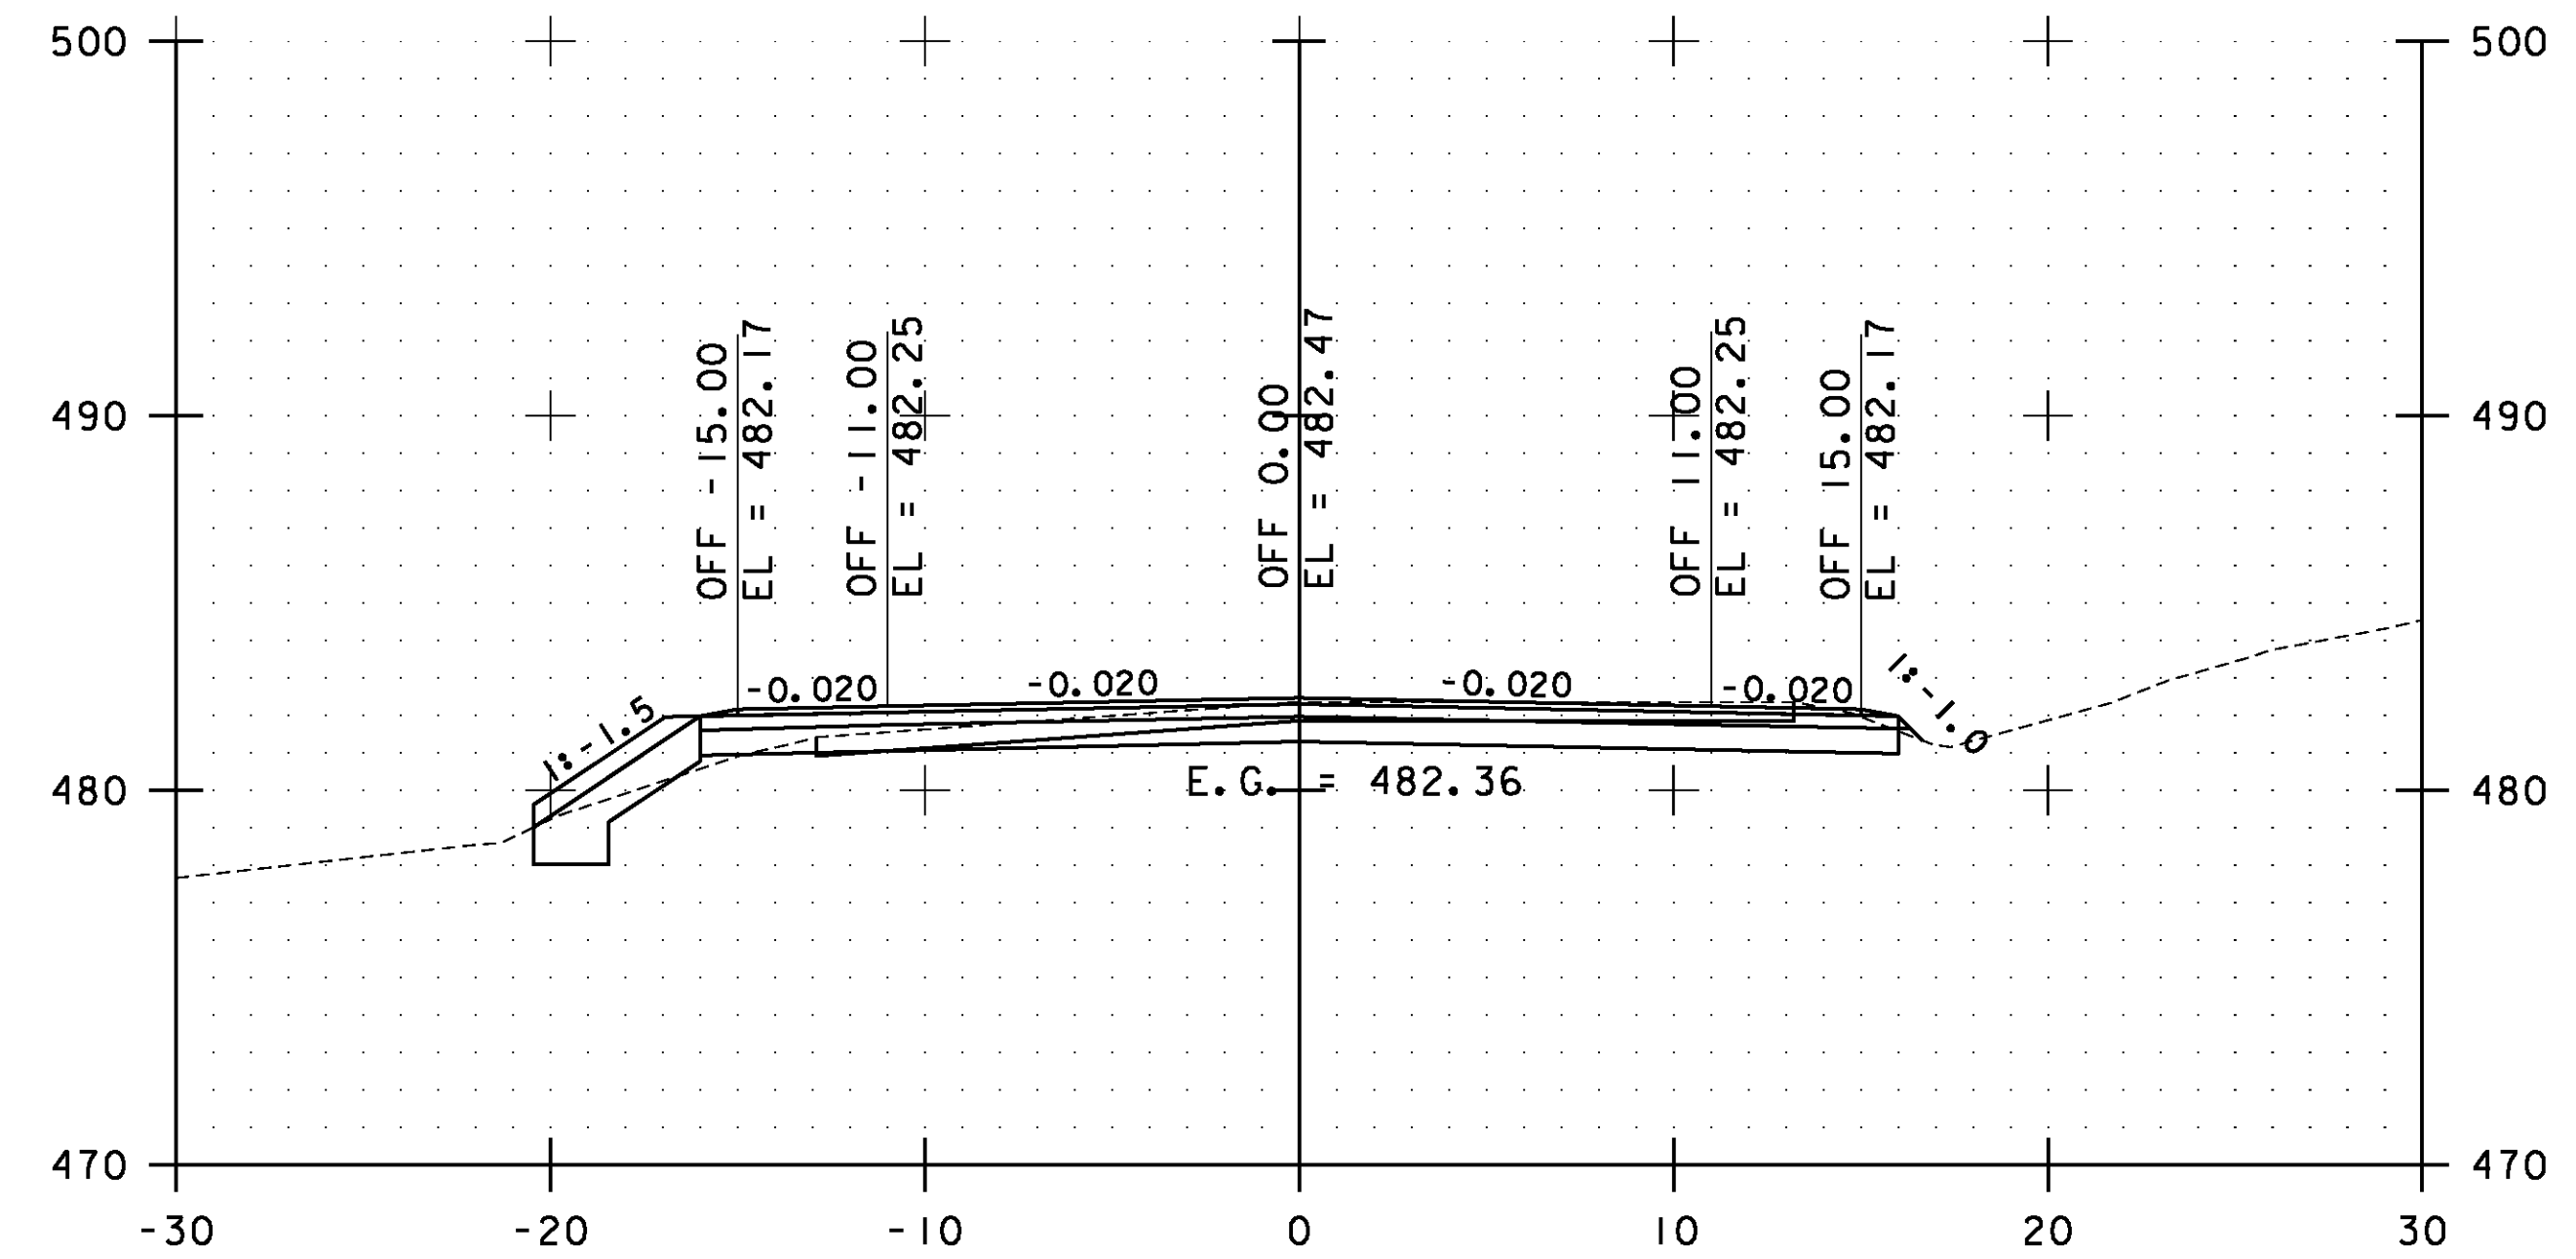

171+00.00

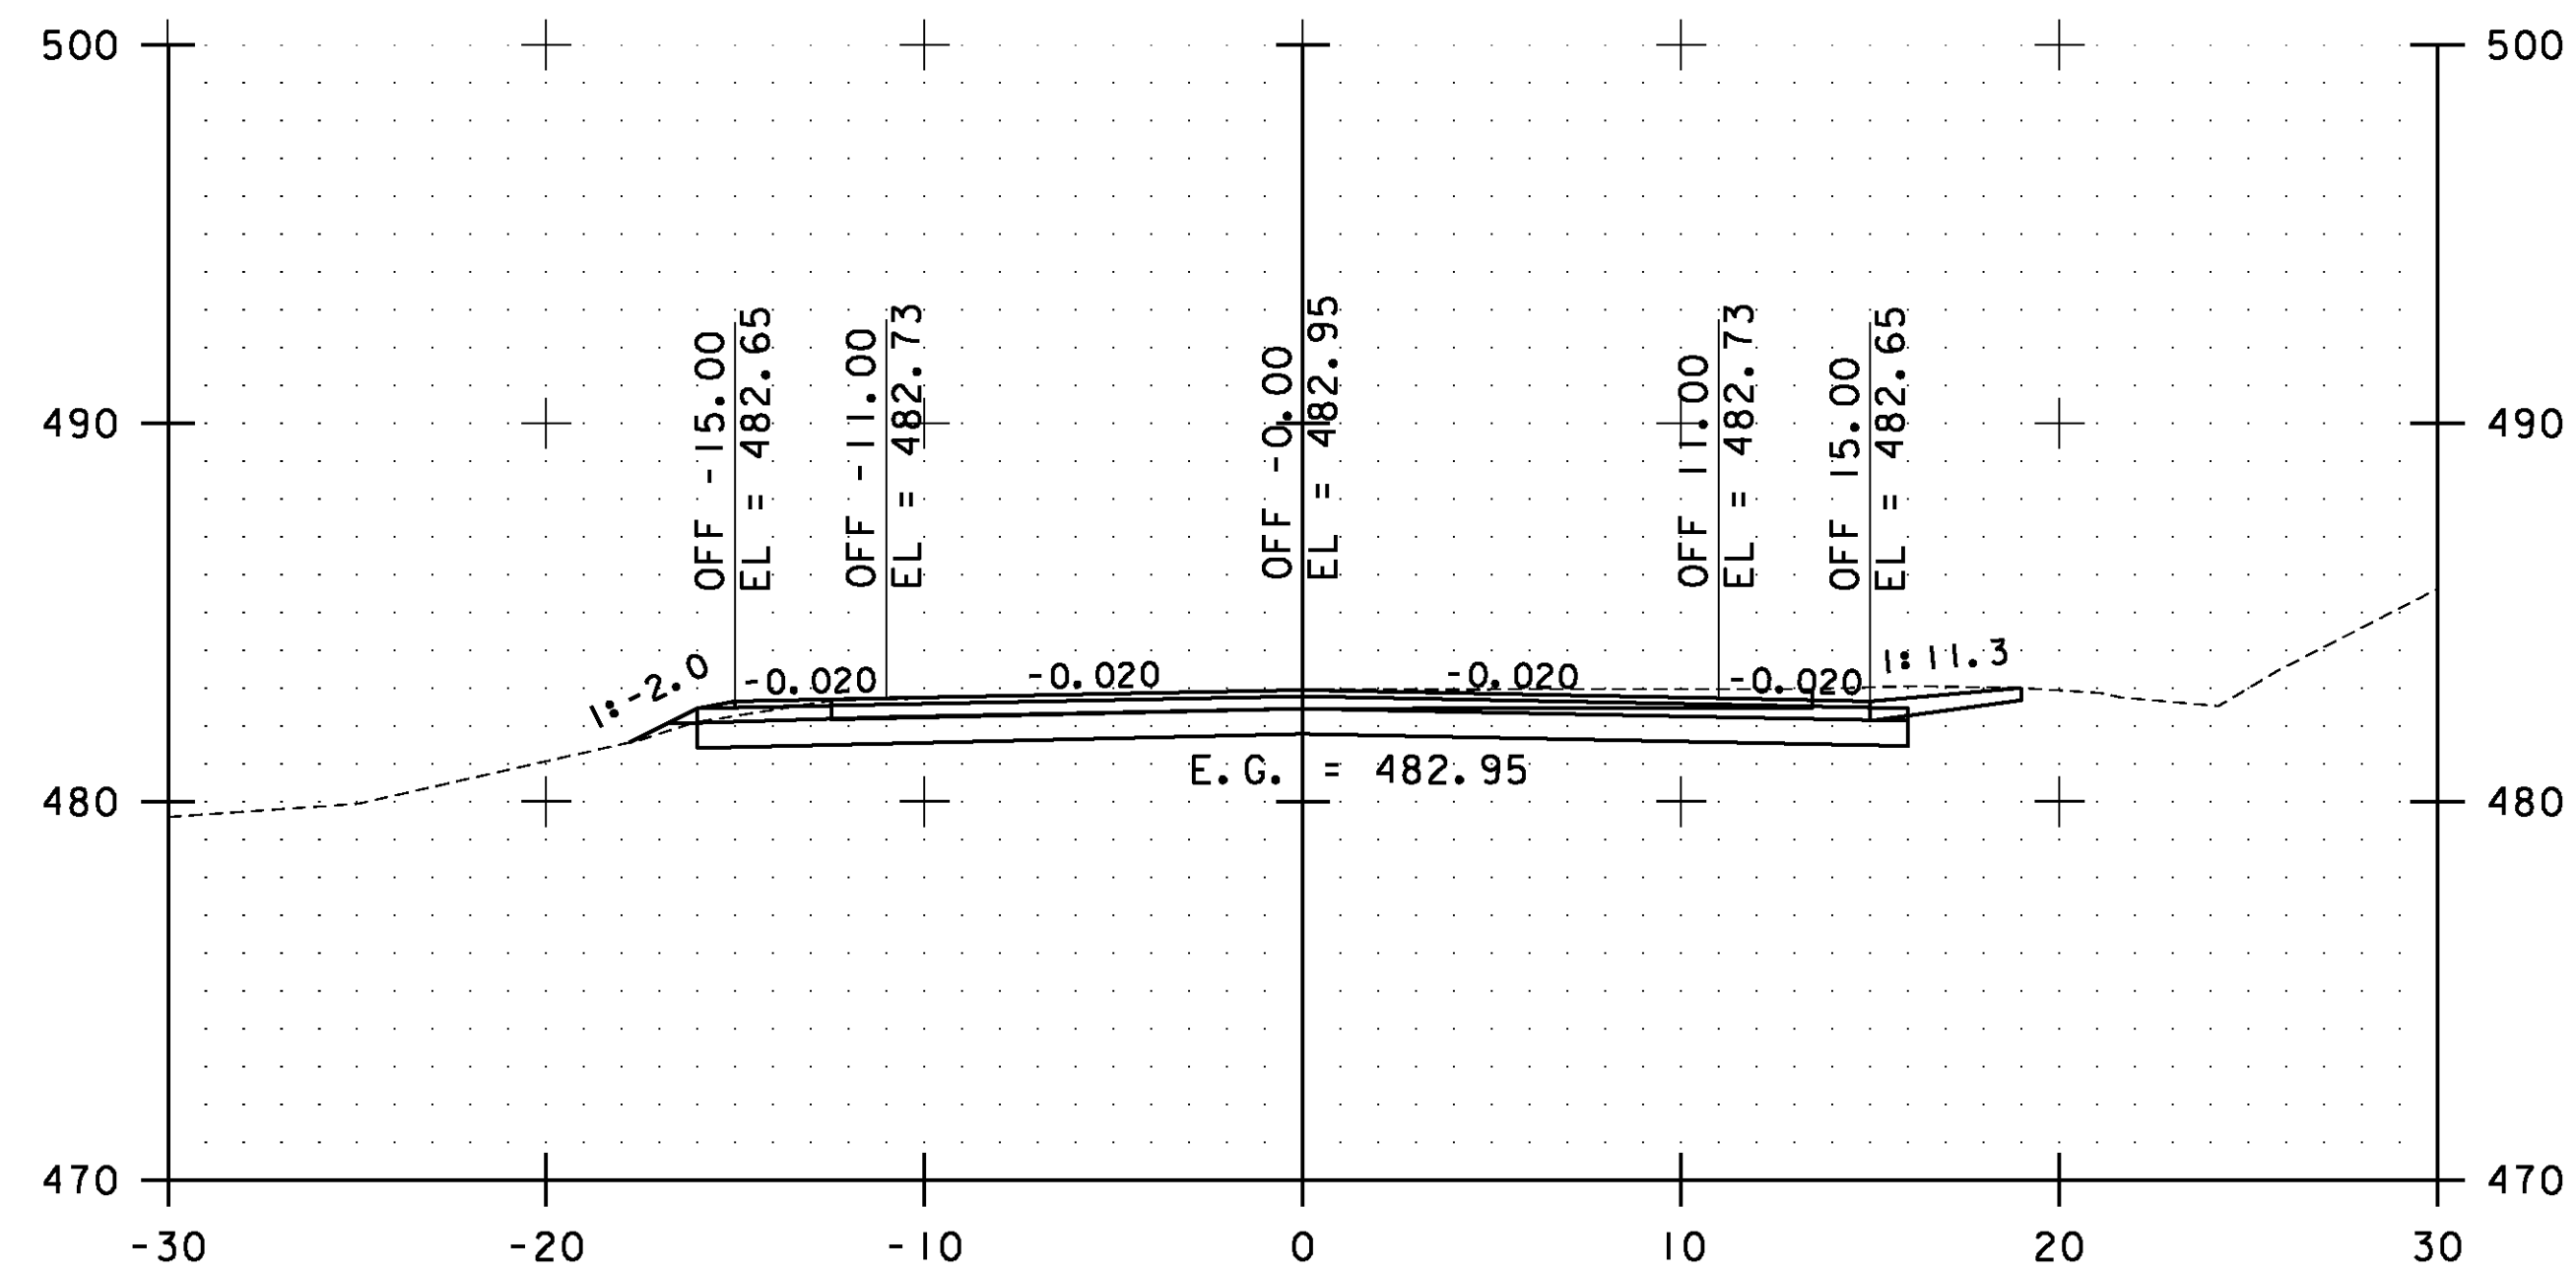


169+50.00

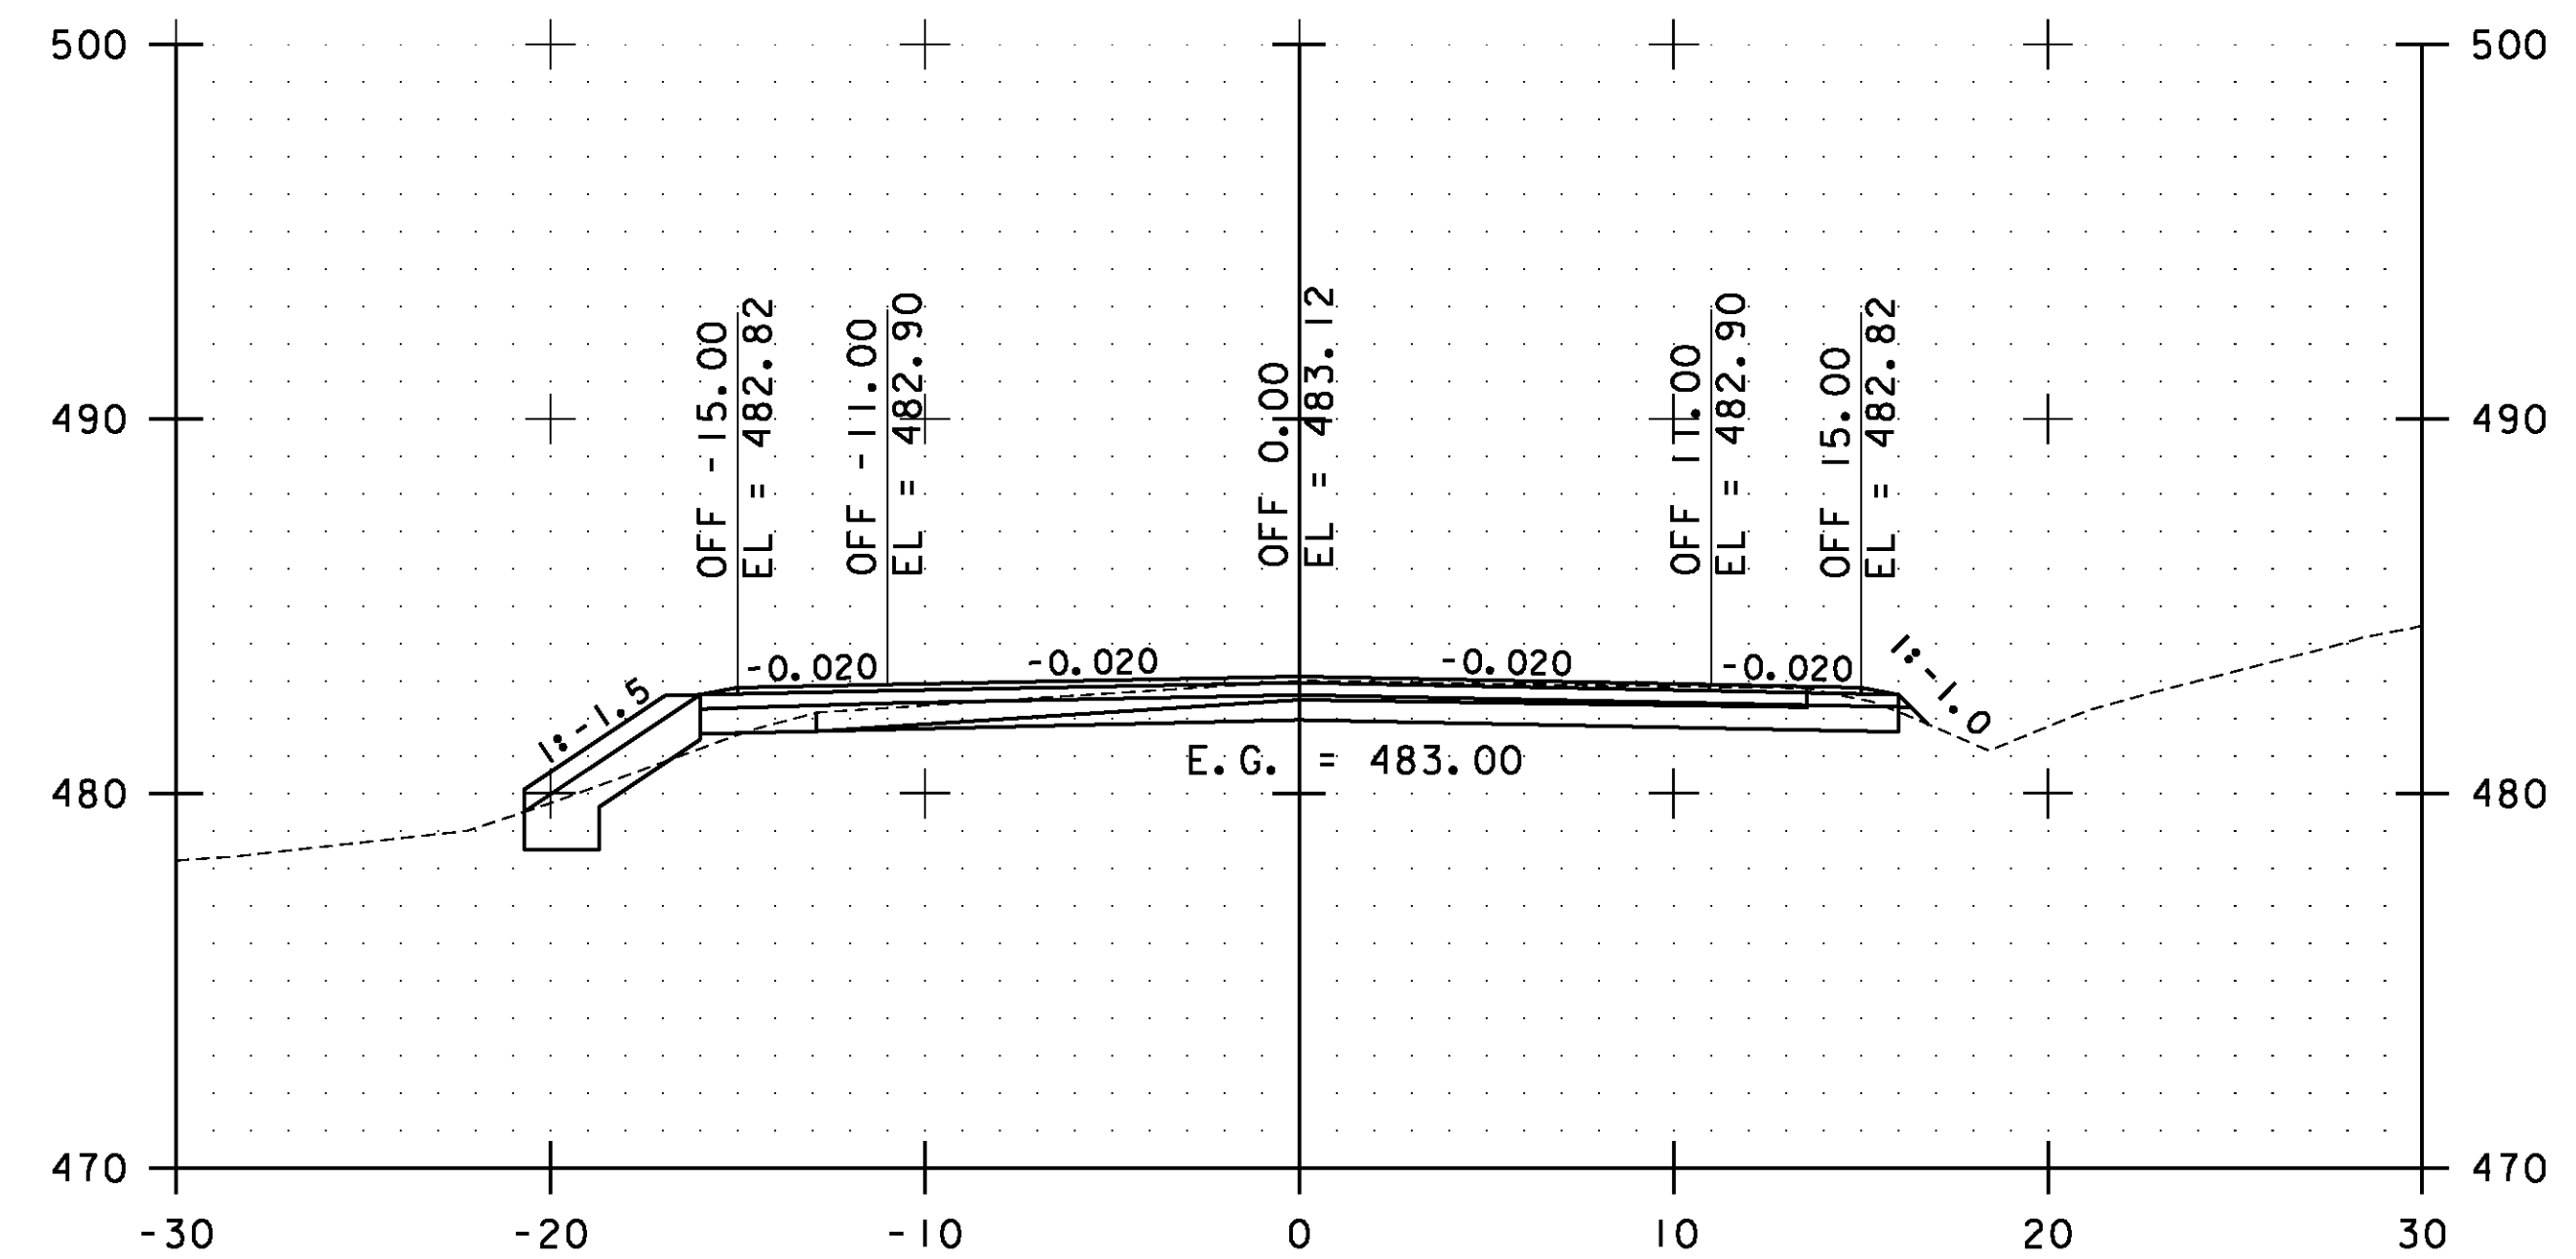

170+50.00

STA. 169+50.00 TO STA. 171+00.00

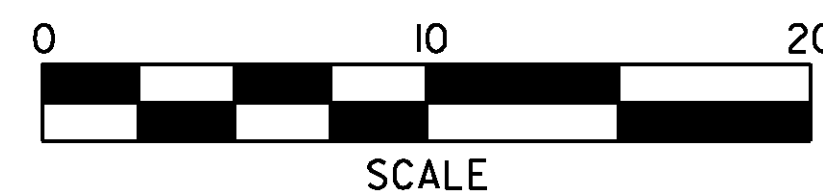

**ESSEX
CROSS
SECTIONS
SHEET #79**

PROJECT NAME: ESSEX-WESTFORD
PROJECT NUMBER: STP 2912(I)

FILE NAME: p10c226.dgn
PROJECT LEADER: JLL
DESIGNED BY: STANTEC
IPARM FILE: p10c226xs079.i

PLOT DATE: 2/20/2013
DRAWN BY: STANTEC
CHECKED BY: STANTEC
SHEET 170 OF 239