




173+50.00

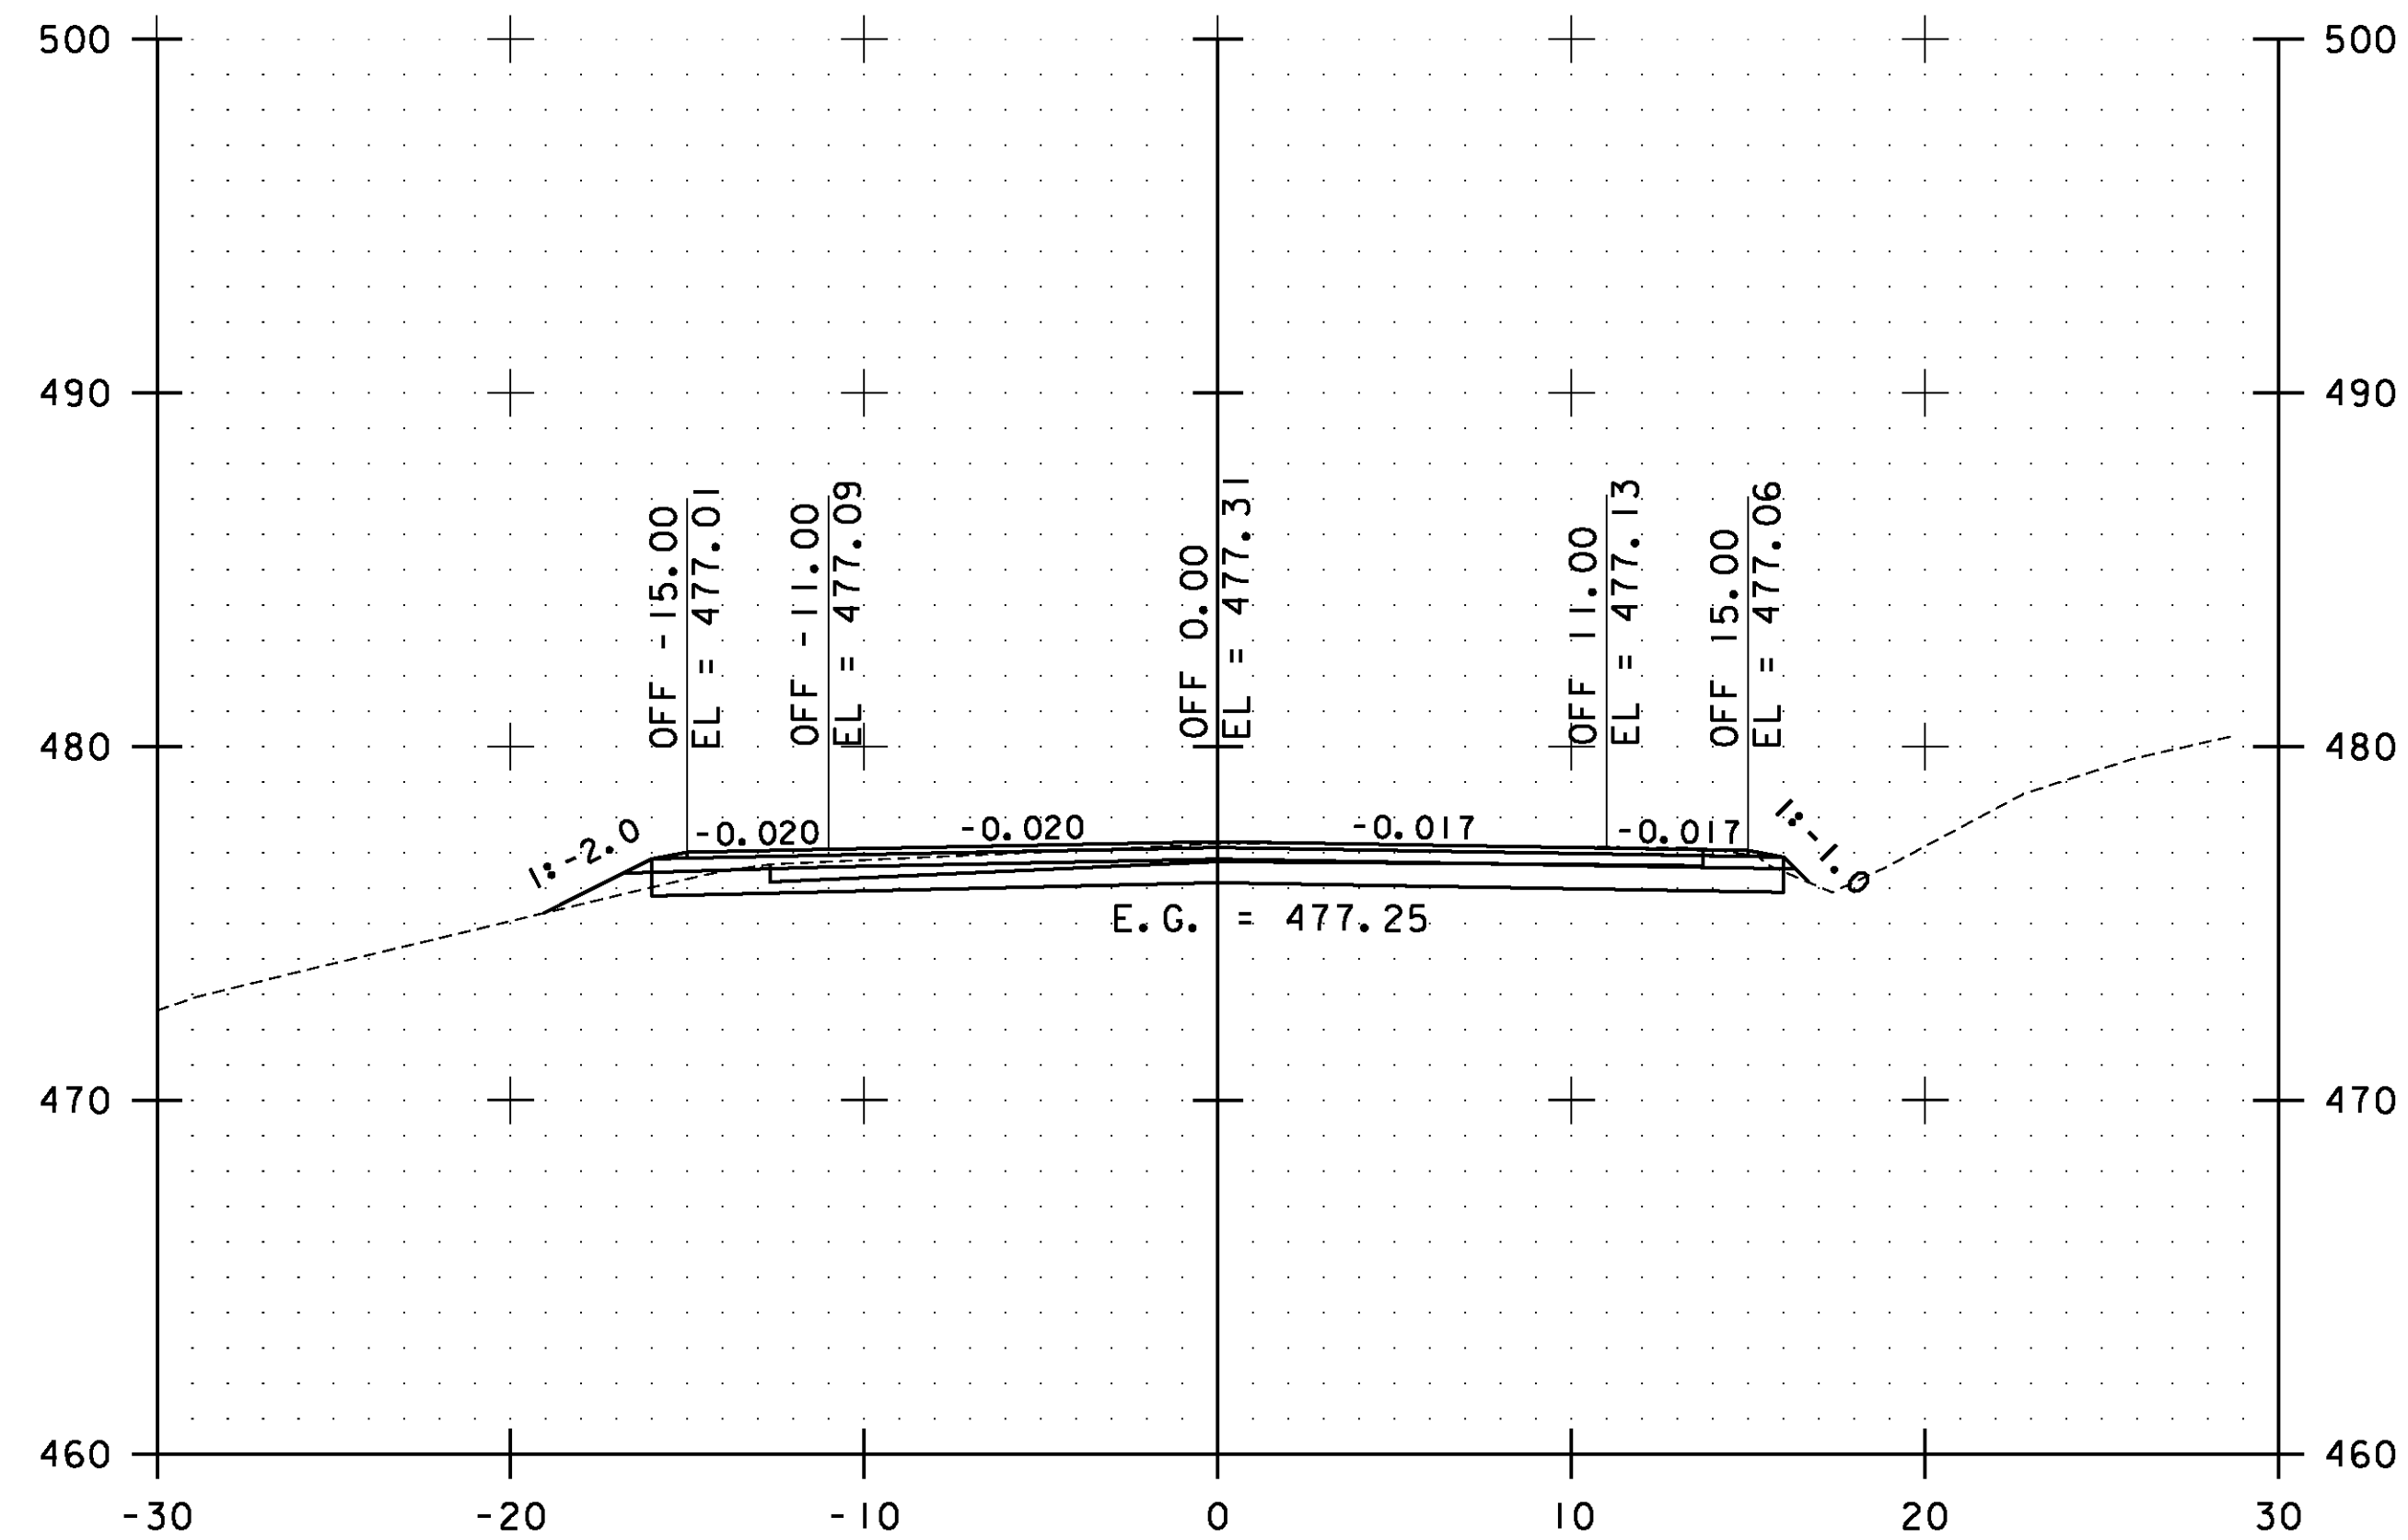

173+00.00

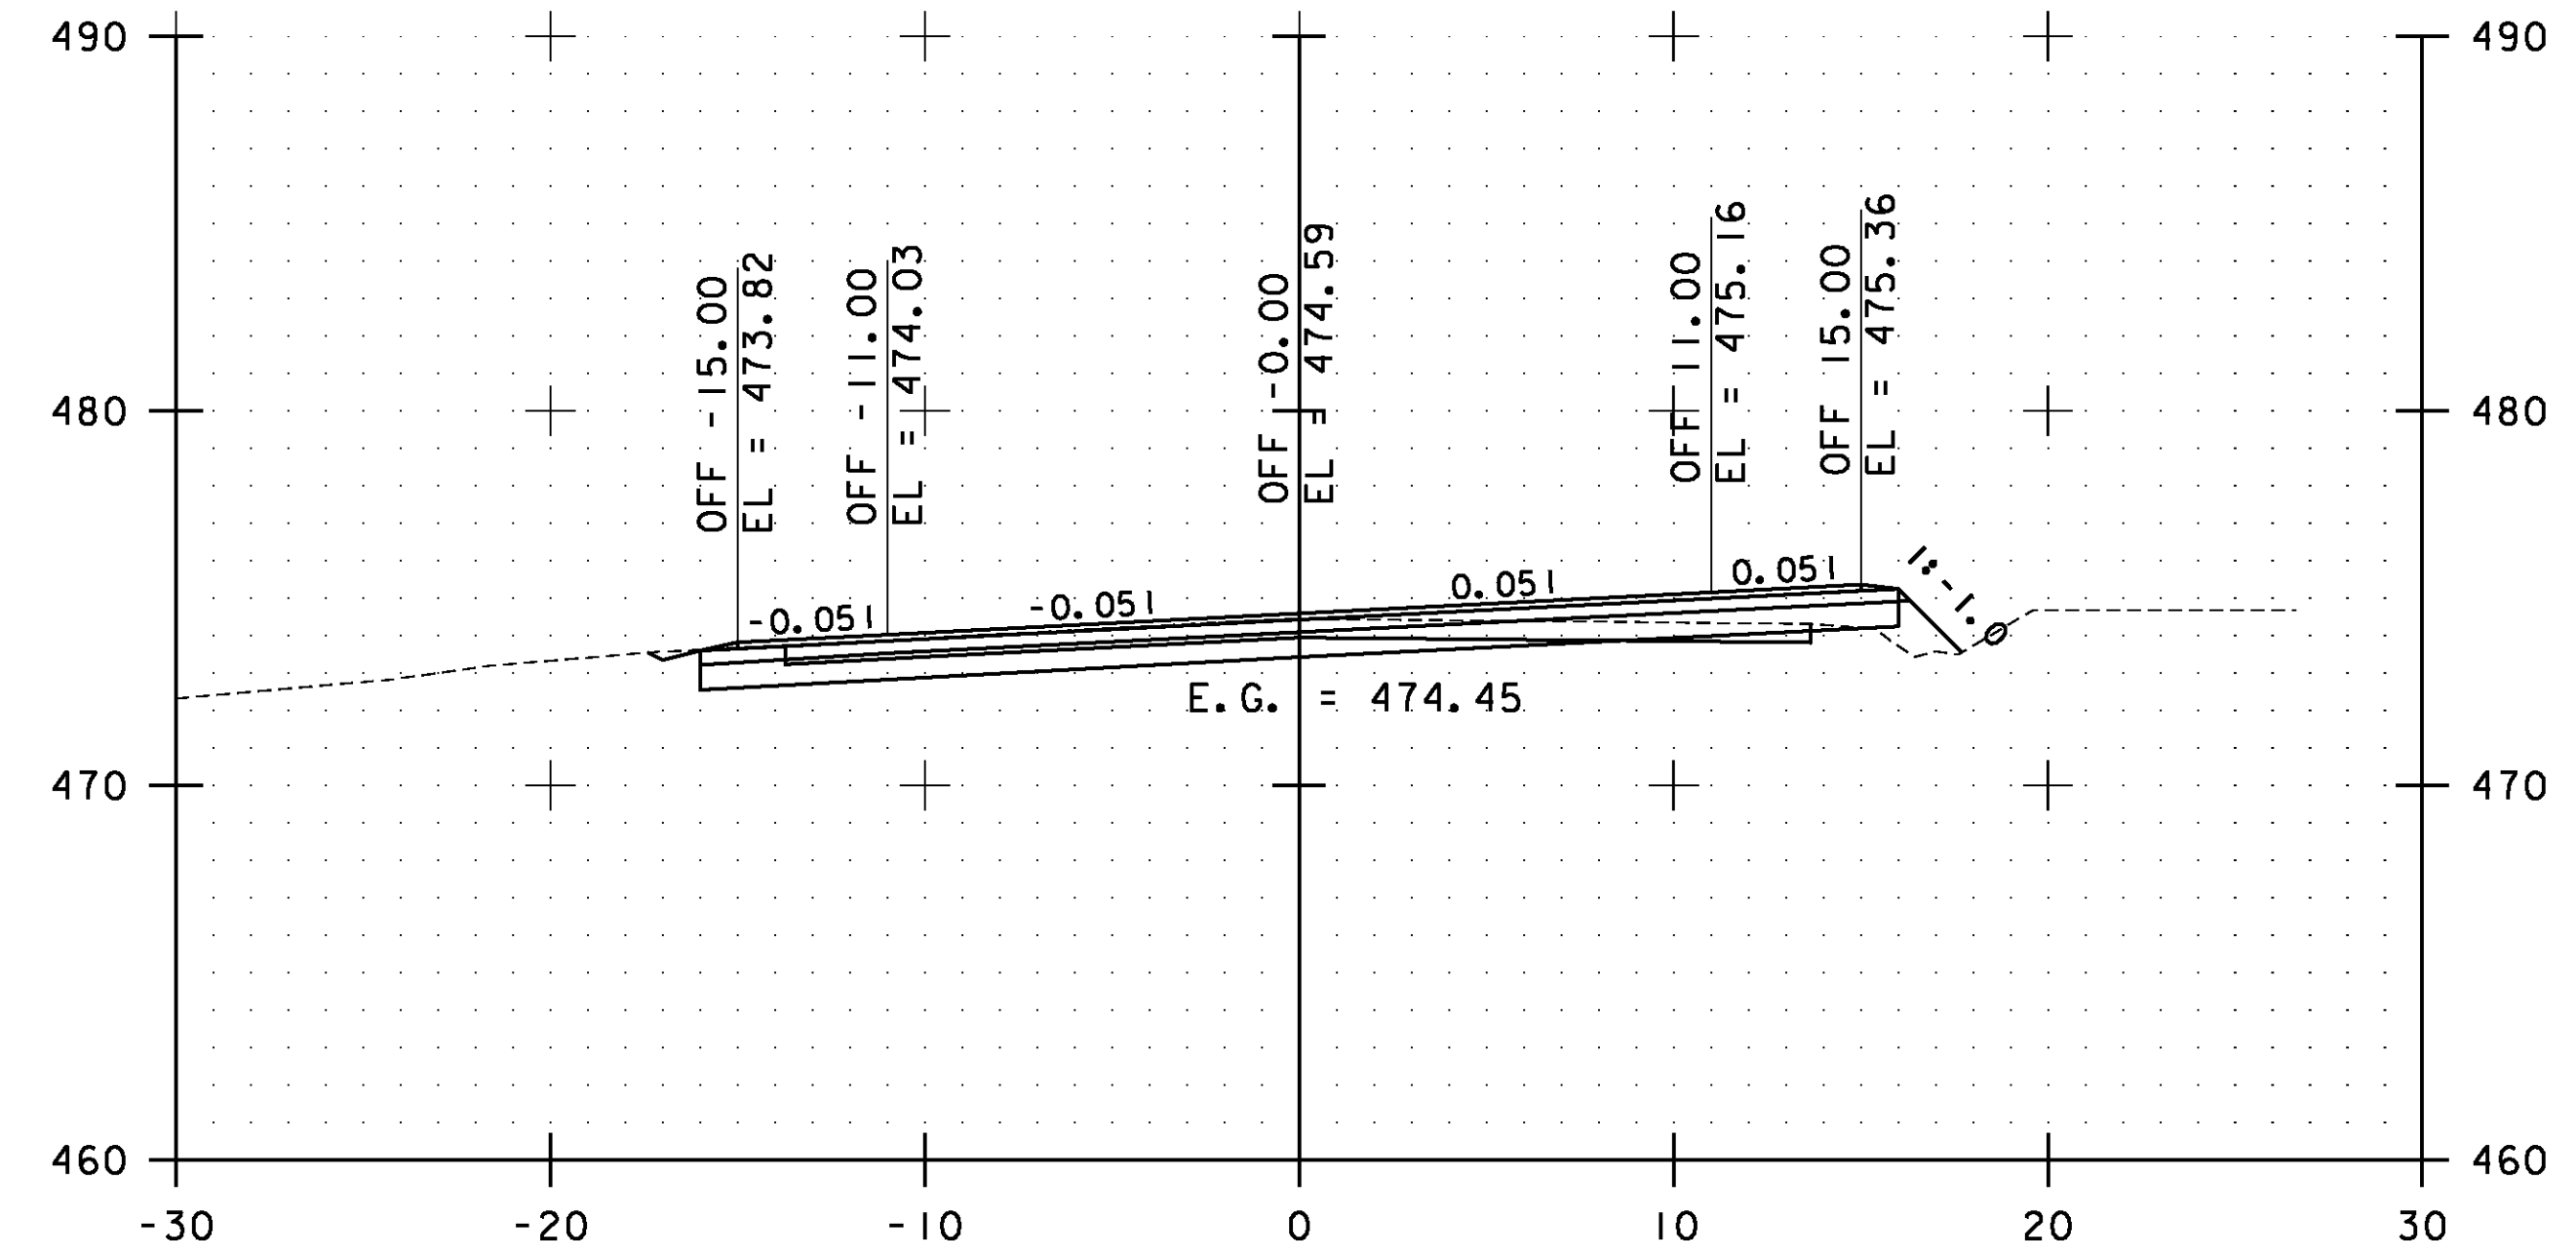


174+50.00

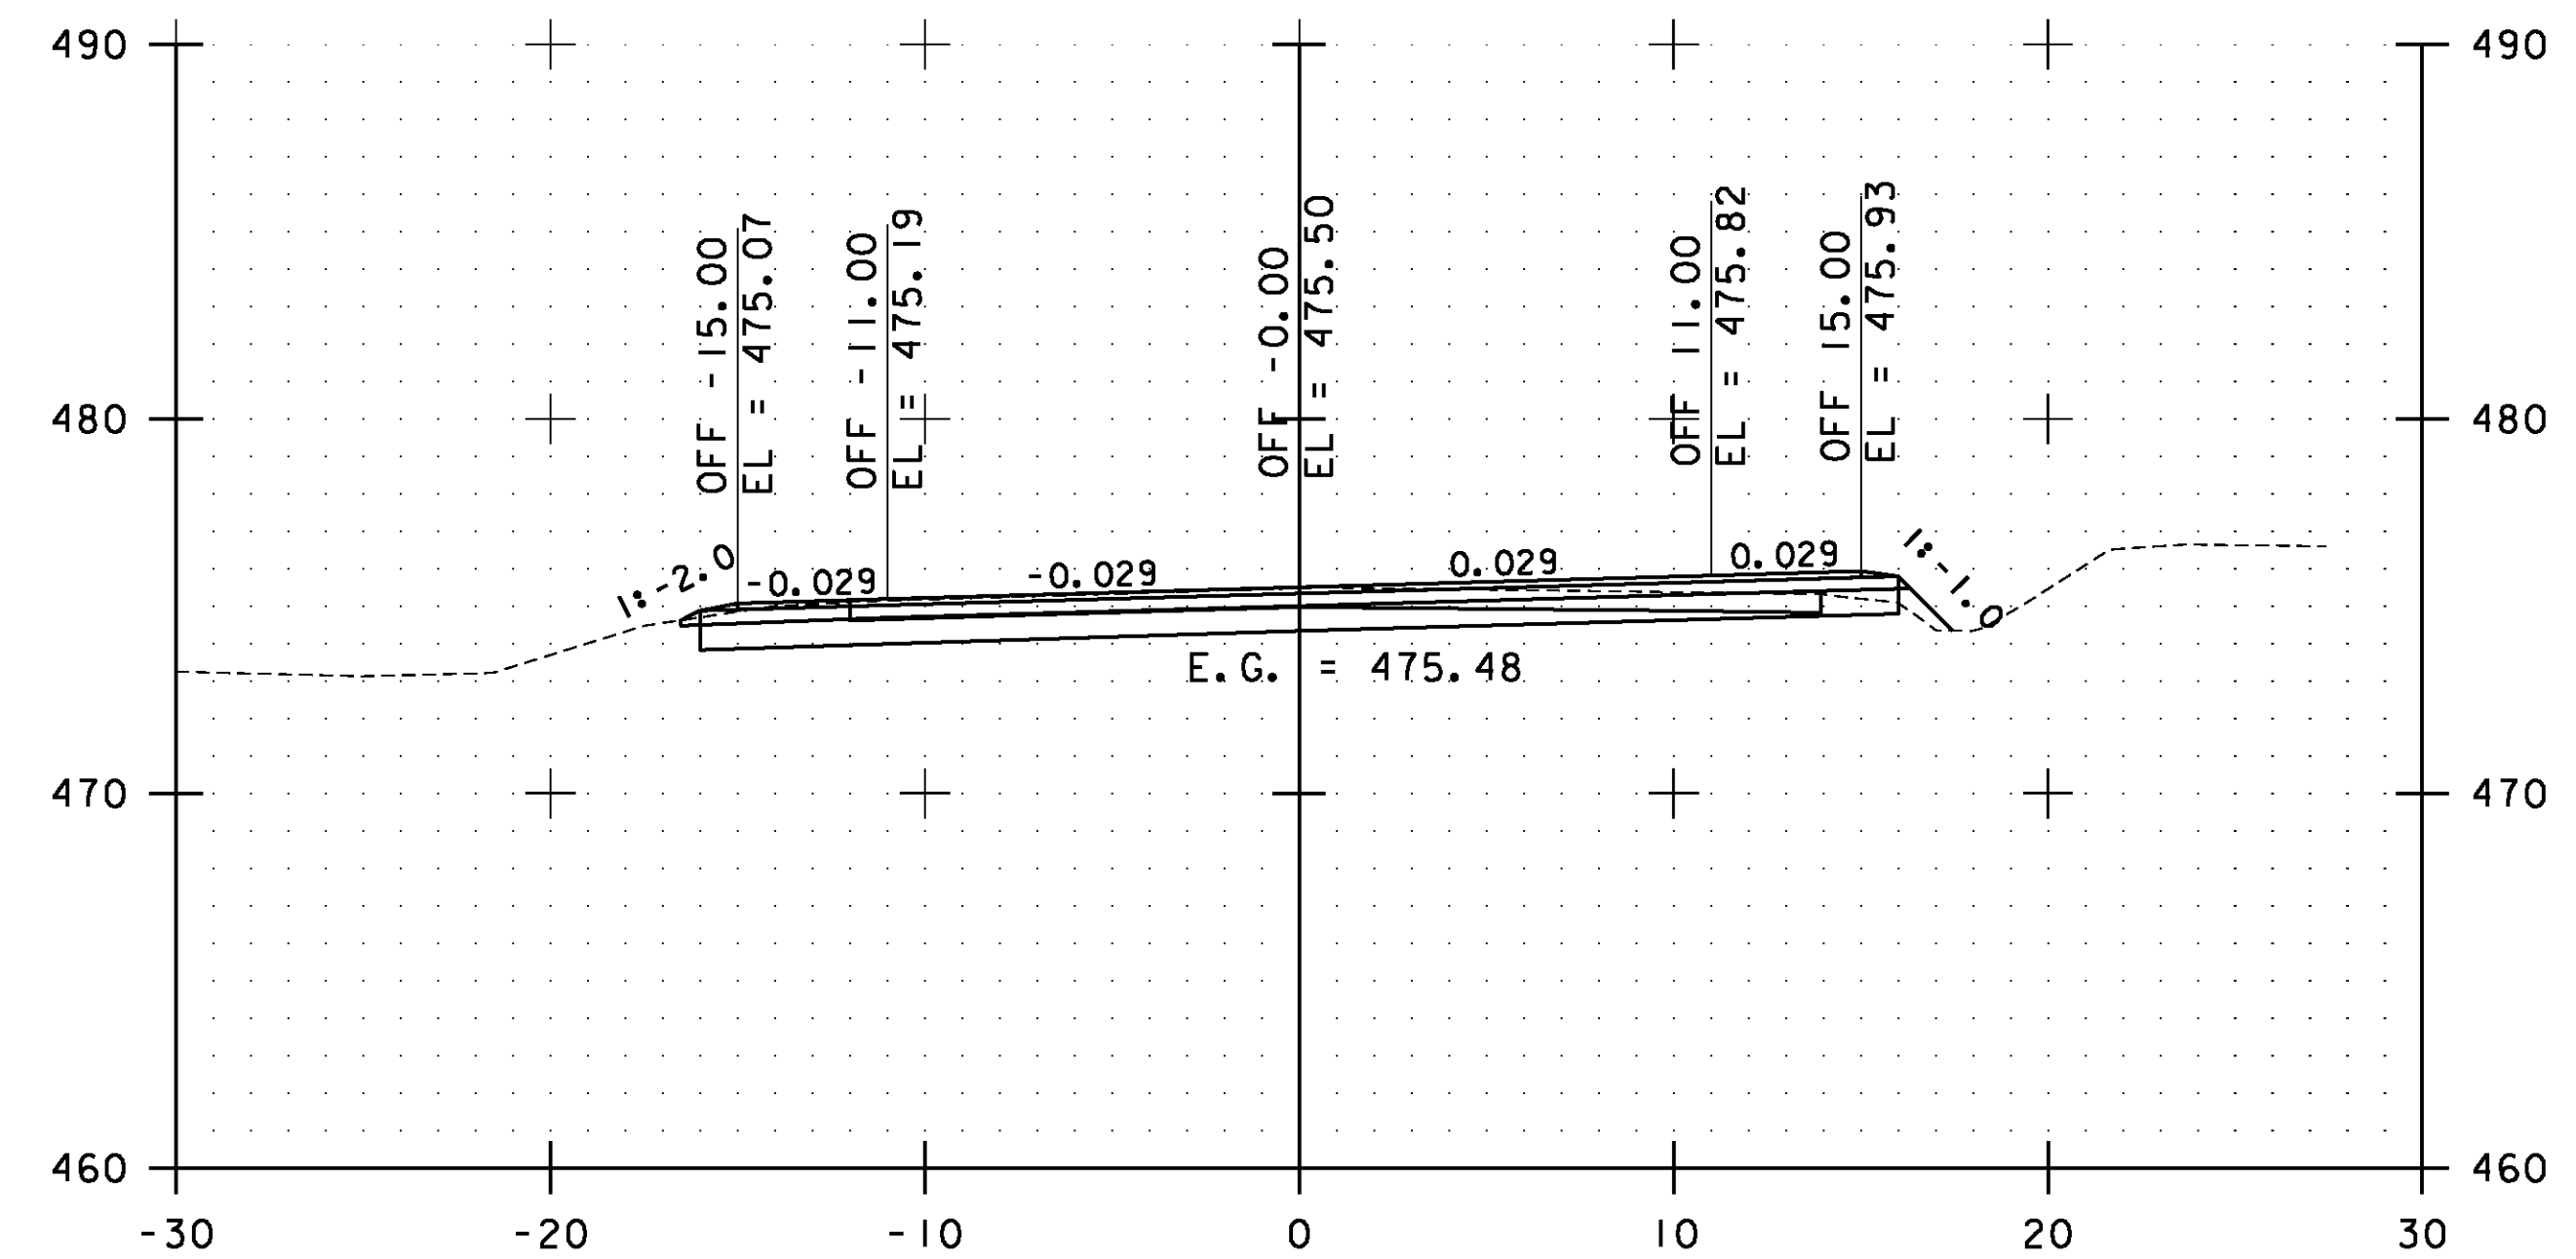

174+00.00

STA. 173+00.00 TO STA. 174+50.00

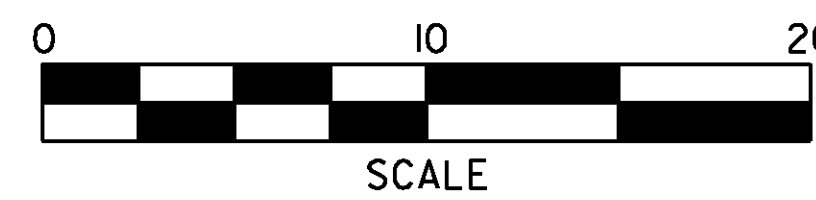

**ESSEX  
CROSS  
SECTIONS  
SHEET #81**

PROJECT NAME: ESSEX-WESTFORD  
PROJECT NUMBER: STP 2912(I)

FILE NAME: p10c226.dgn  
PROJECT LEADER: JLL  
DESIGNED BY: STANTEC  
IPARM FILE: p10c226xs081.i

PLOT DATE: 2/20/2013  
DRAWN BY: STANTEC  
CHECKED BY: STANTEC  
SHEET 172 OF 239