




177+50.00

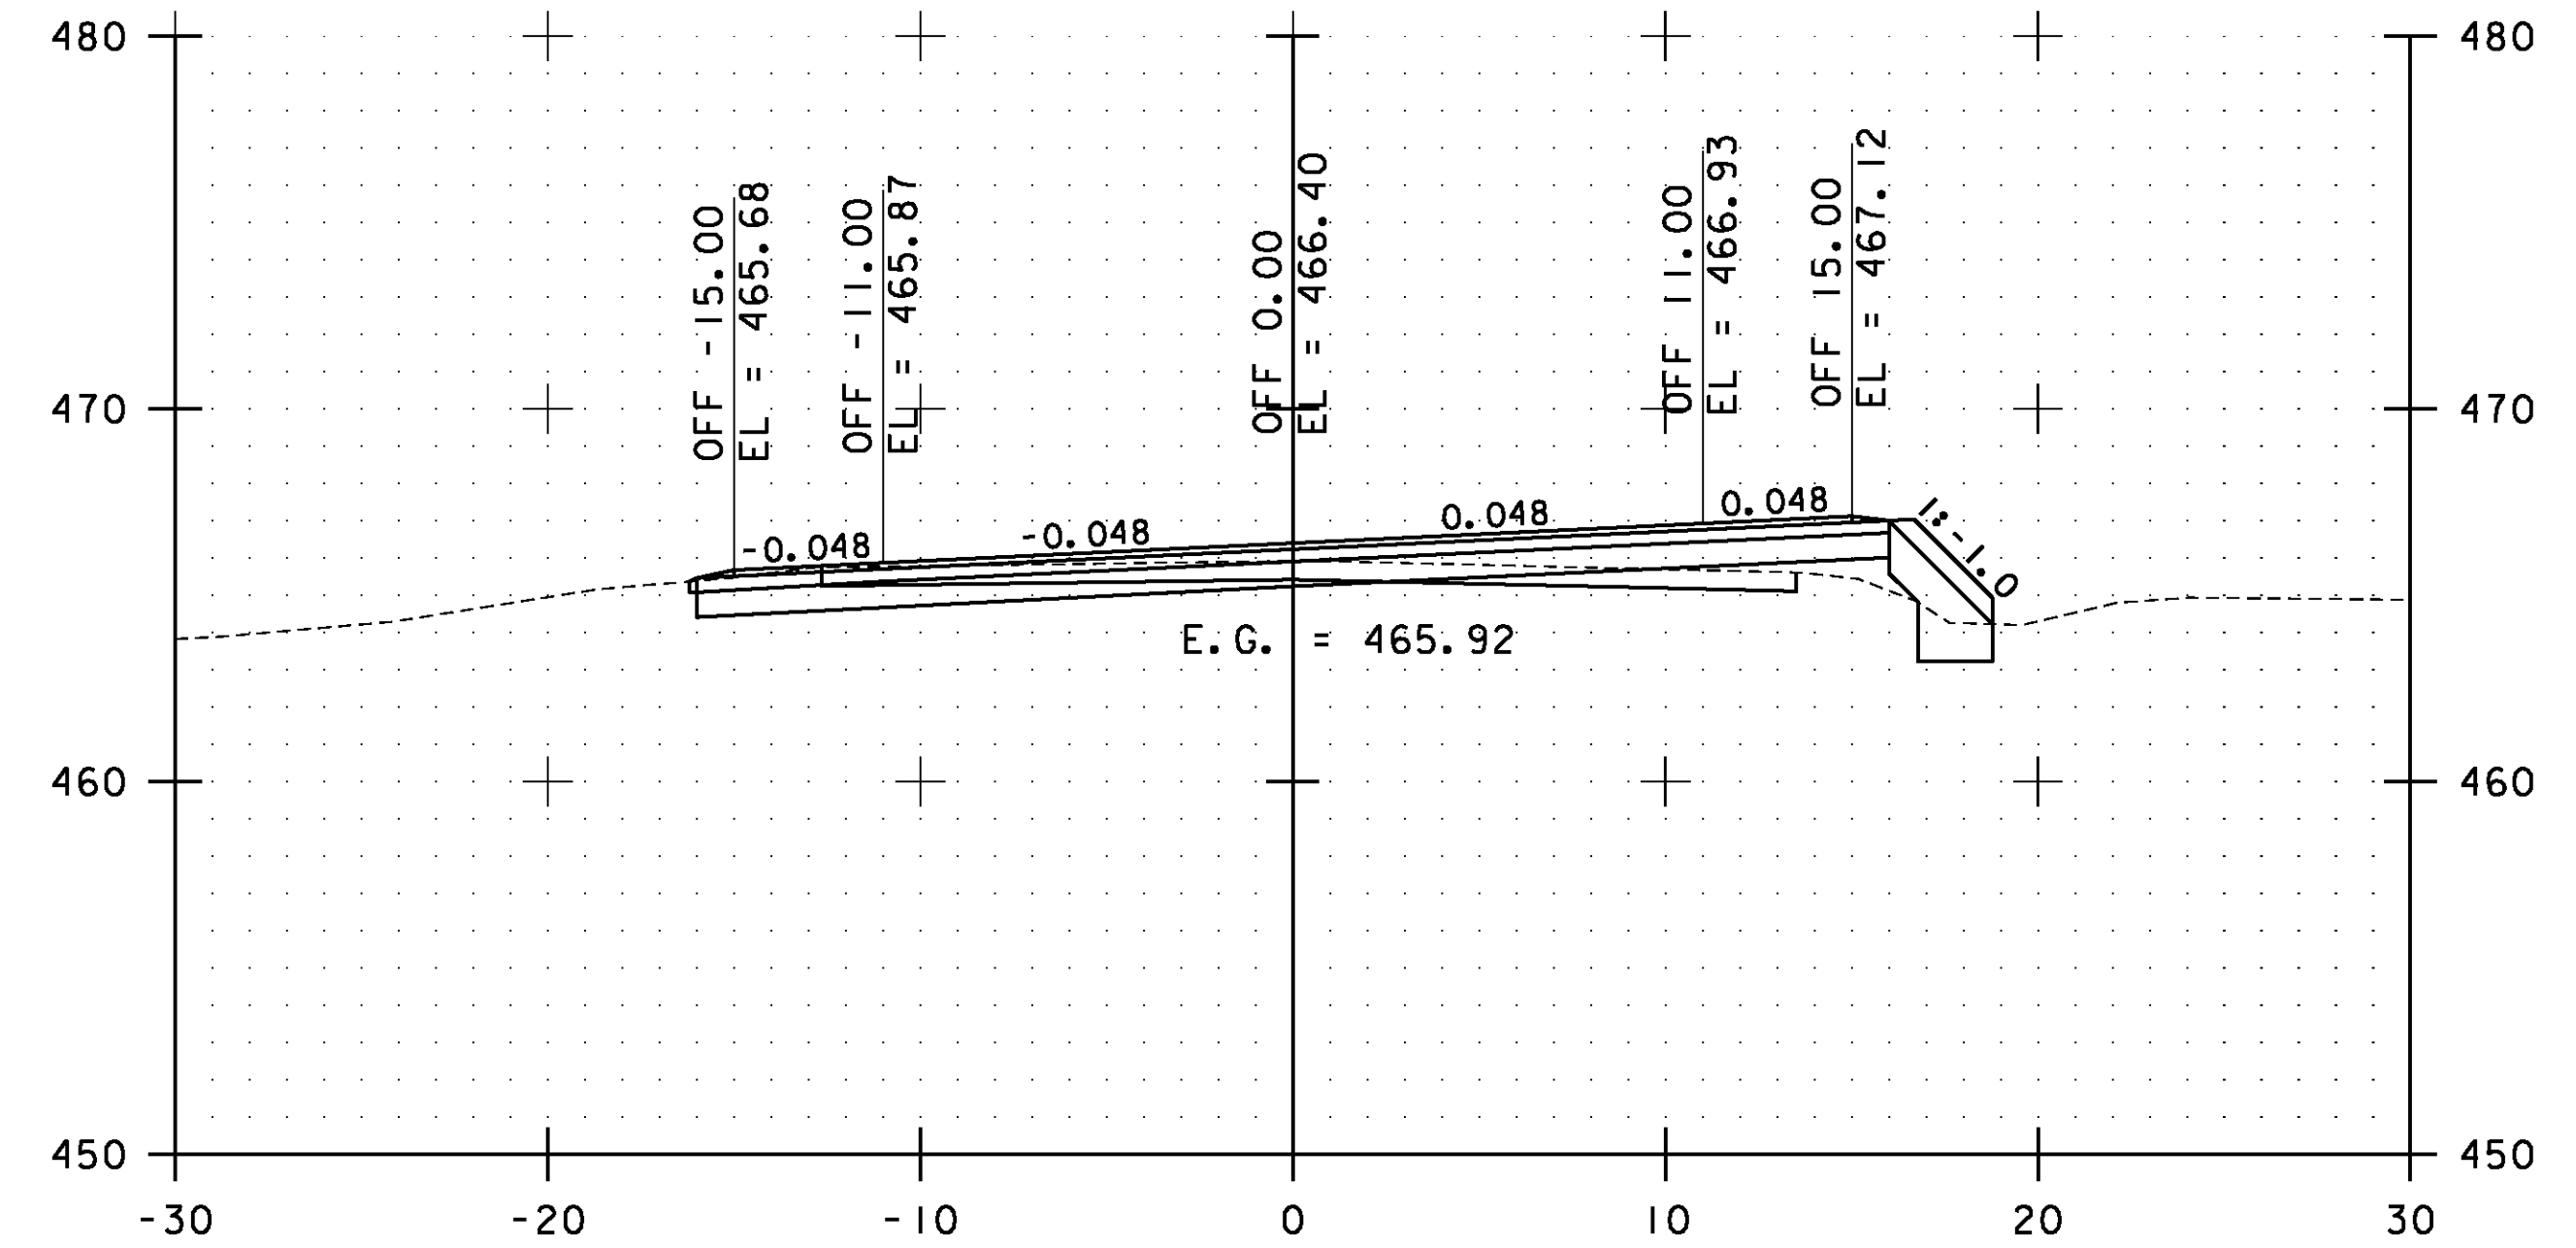

178+50.00

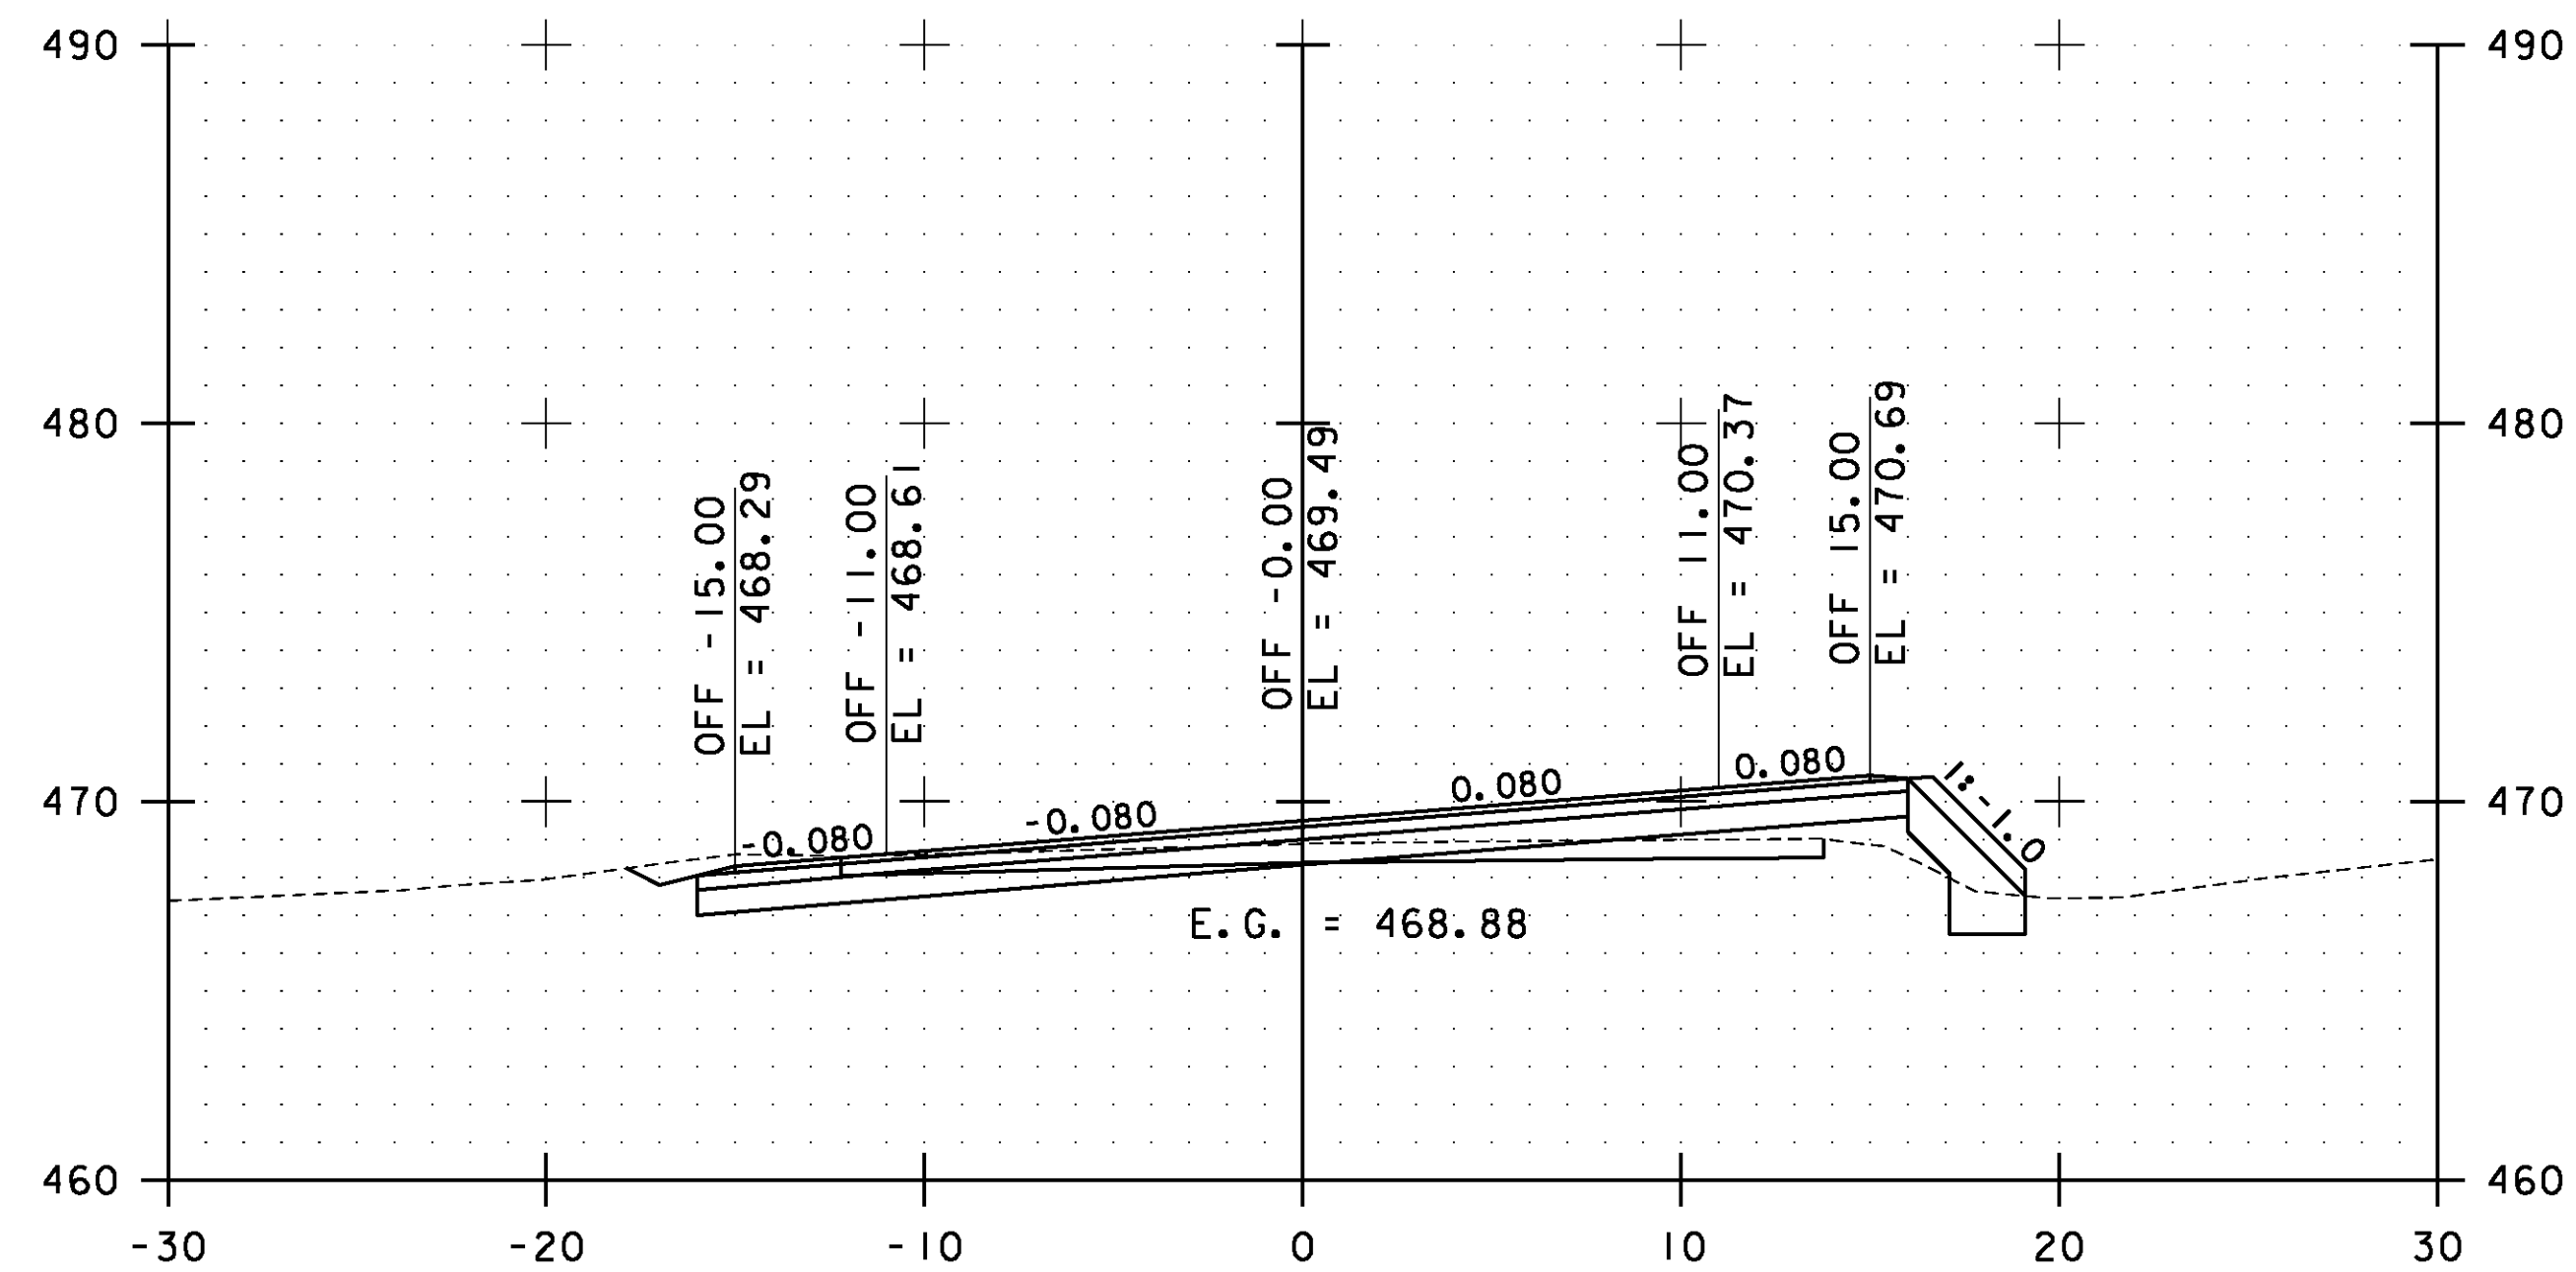


177+00.00

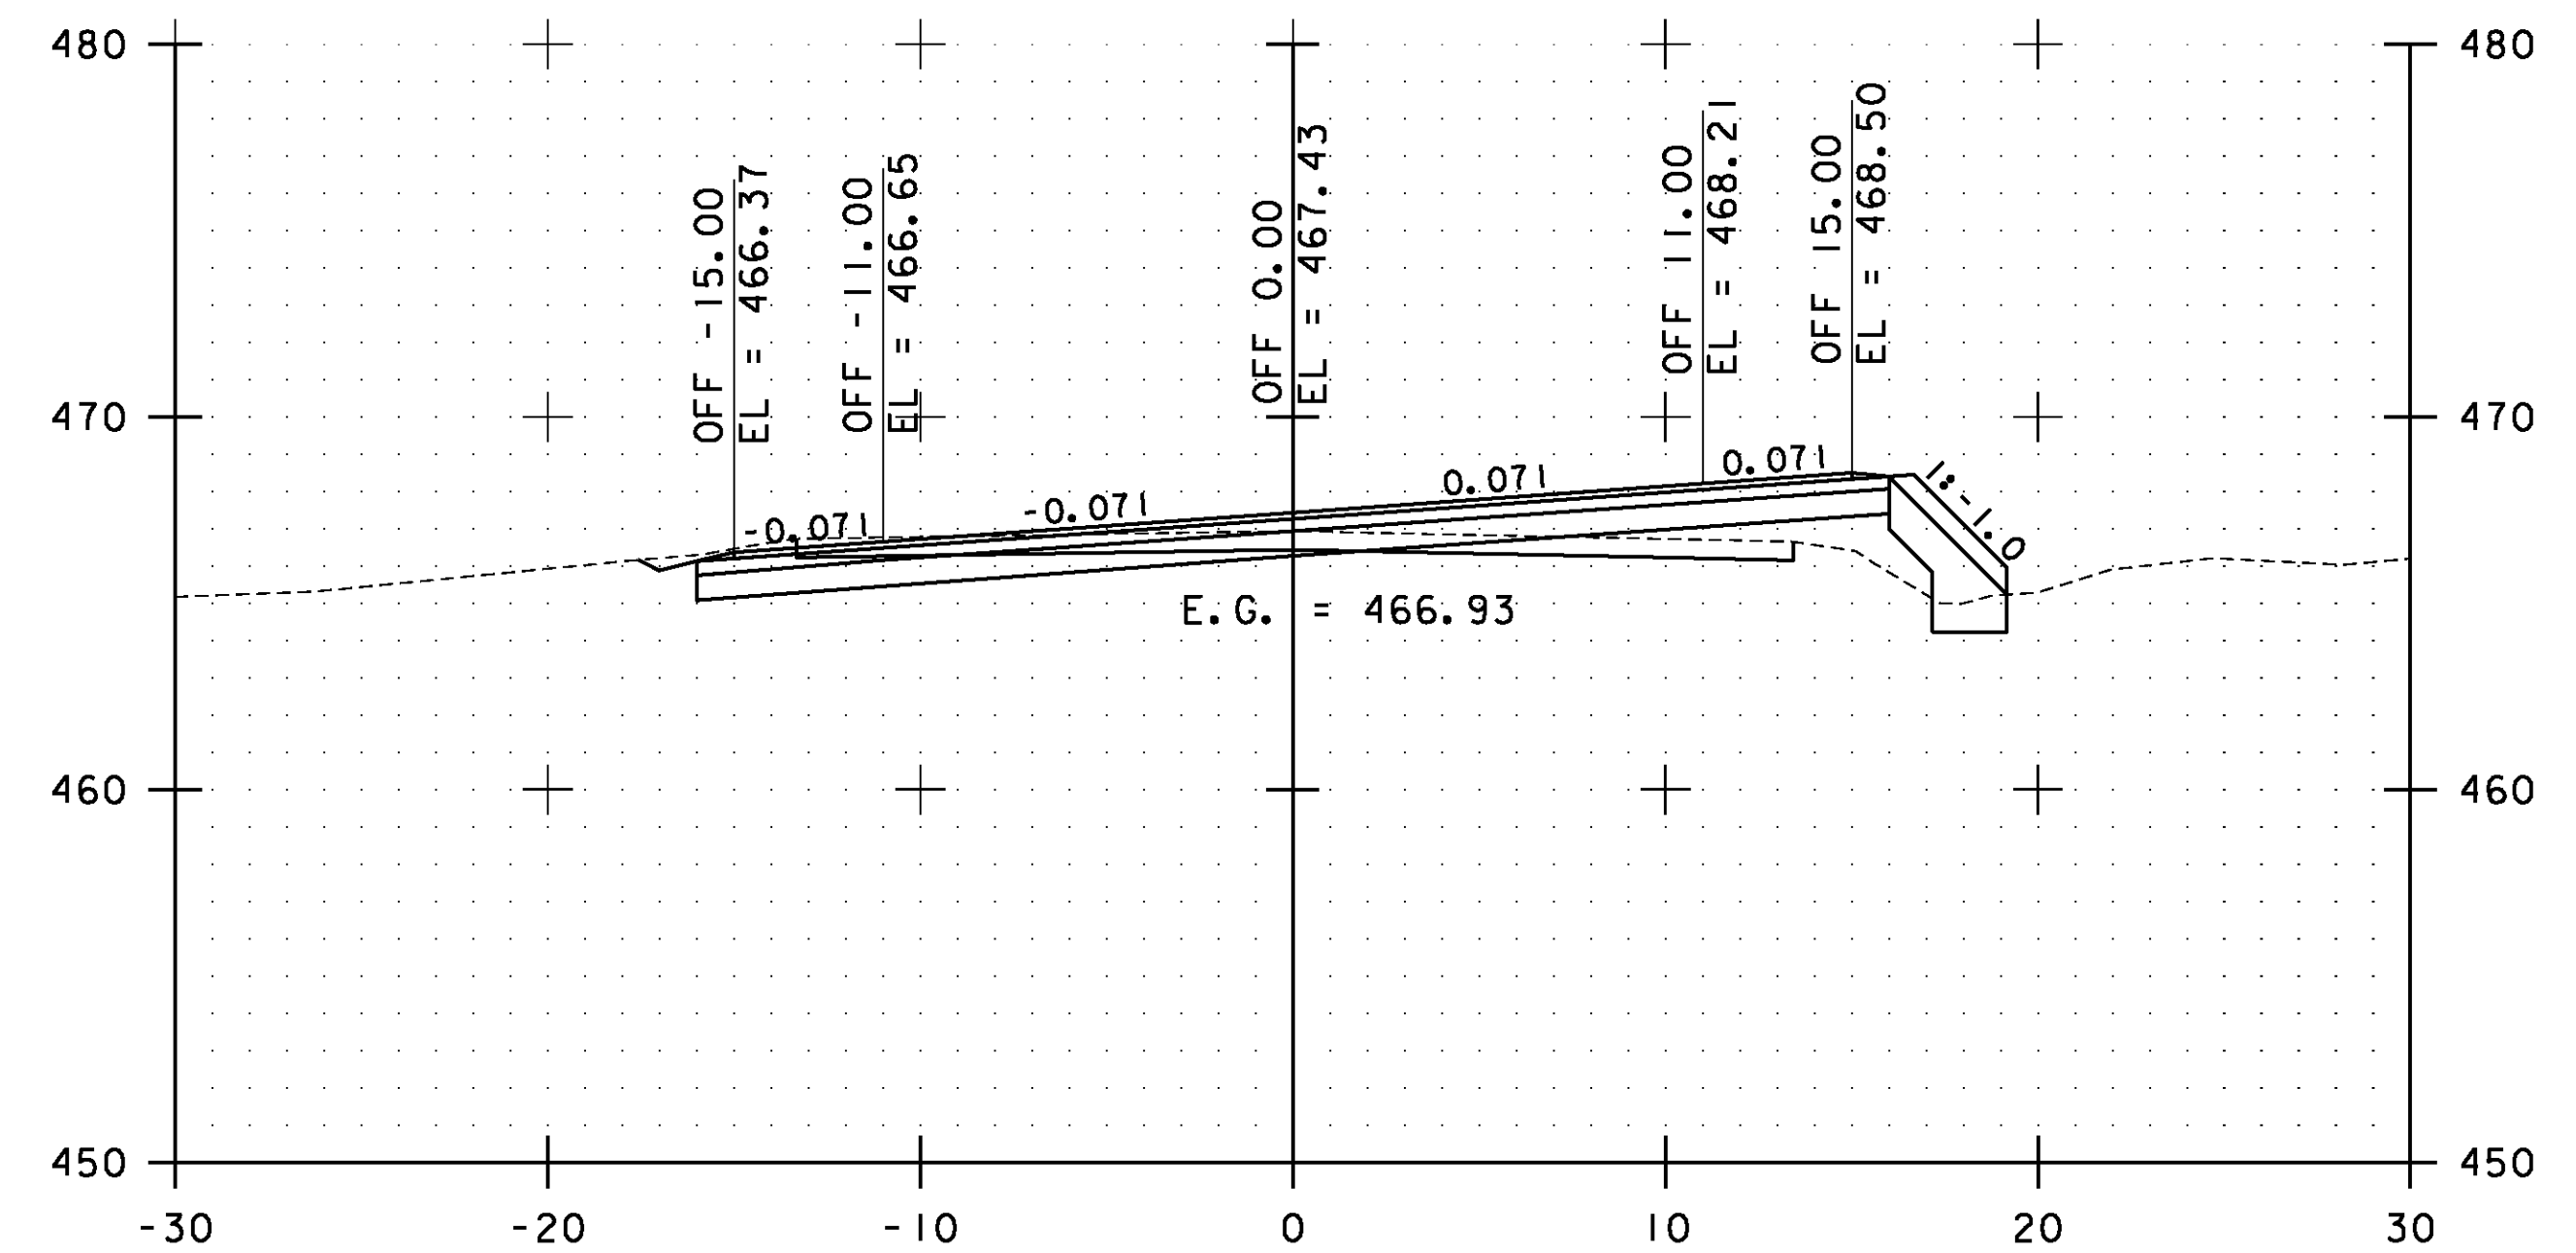

178+00.00

STA. 177+00.00 TO STA. 178+50.00

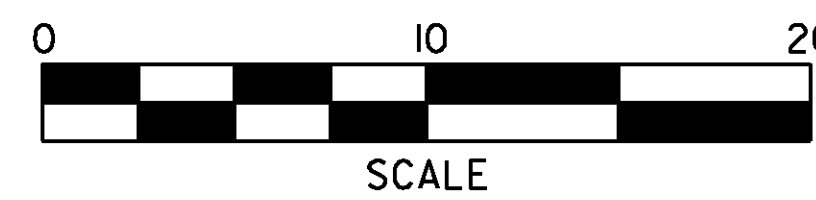

**ESSEX
CROSS
SECTIONS
SHEET #83**

PROJECT NAME: ESSEX-WESTFORD
PROJECT NUMBER: STP 2912(I)

FILE NAME: p10c226.dgn
PROJECT LEADER: JLL
DESIGNED BY: STANTEC
IPARM FILE: p10c226xs083.i

PLOT DATE: 2/20/2013
DRAWN BY: STANTEC
CHECKED BY: STANTEC
SHEET 174 OF 239