




181+50.00

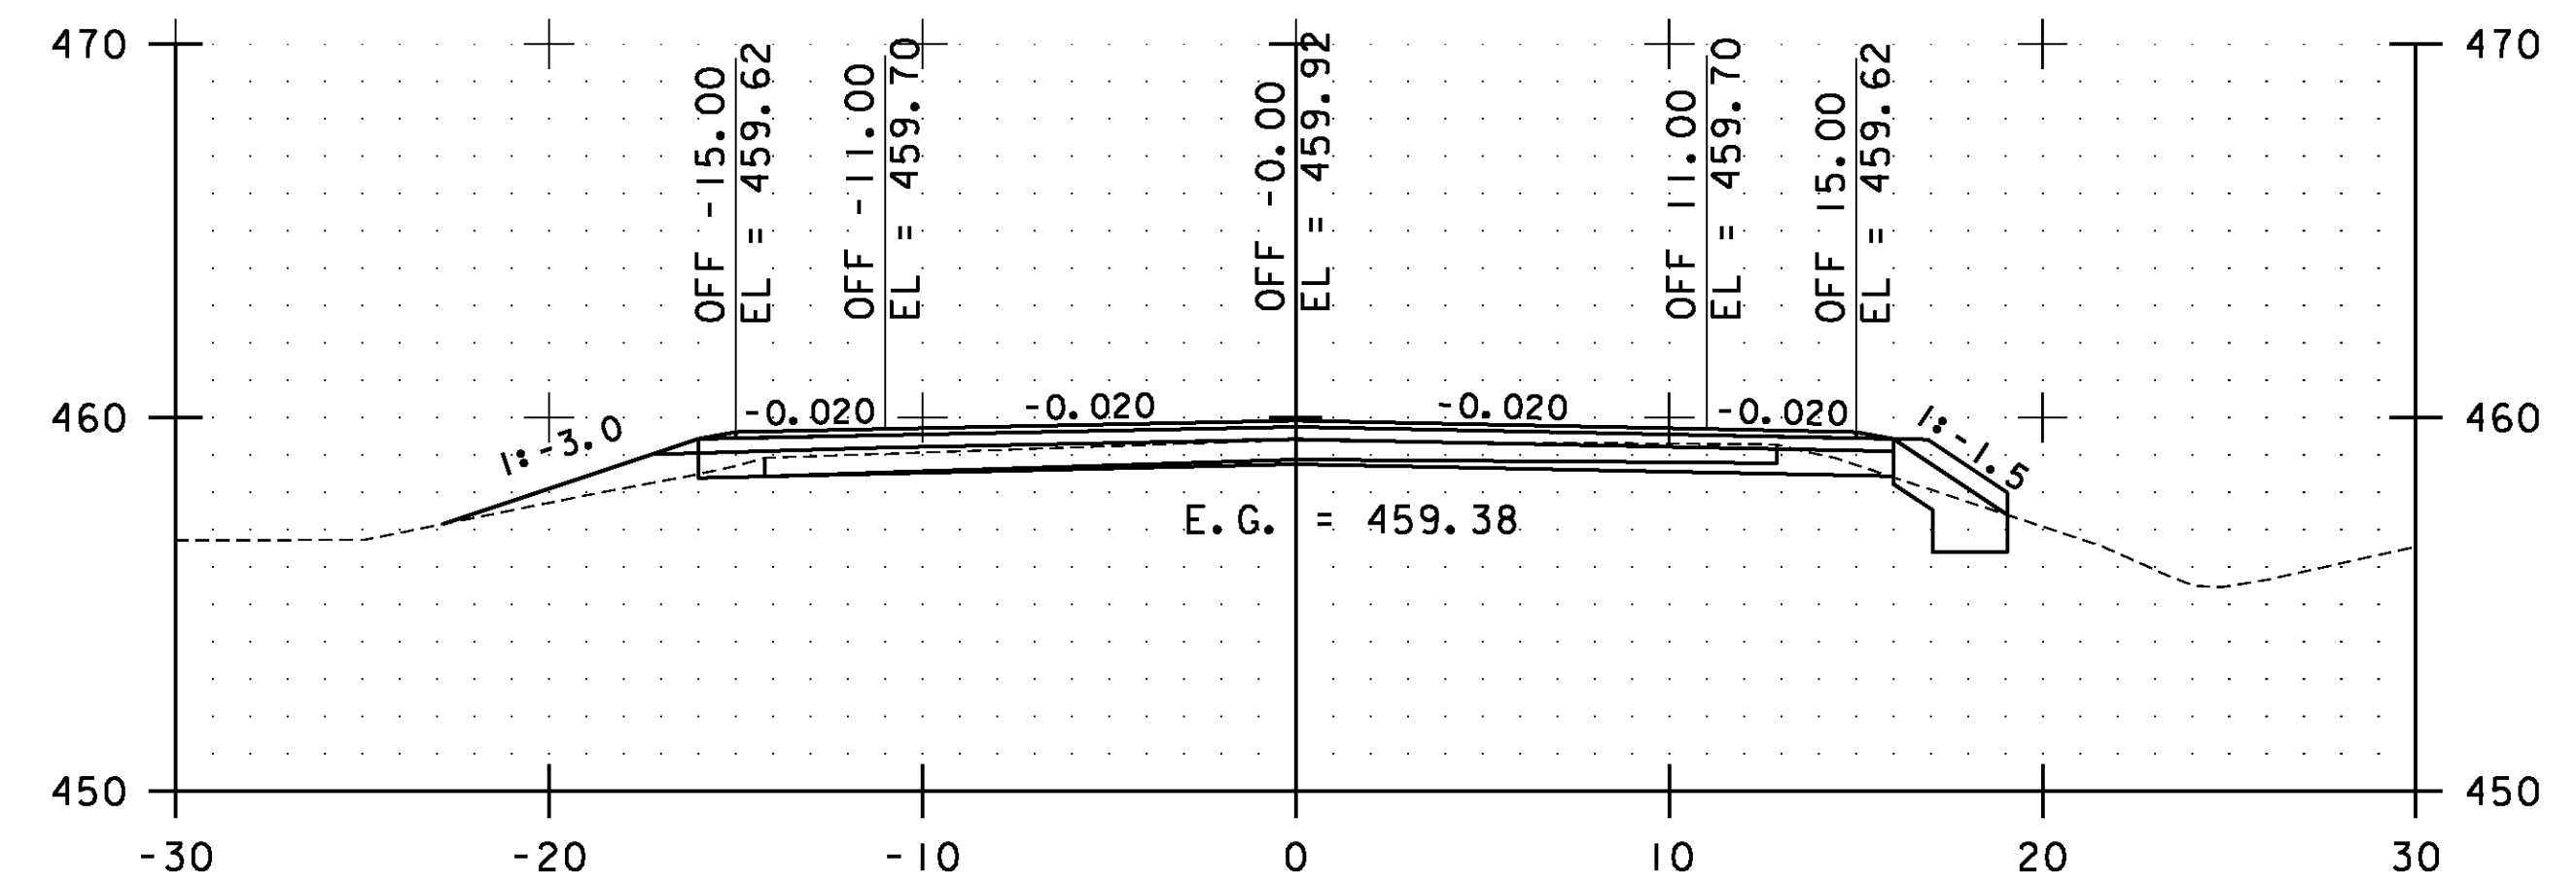

182+50.00

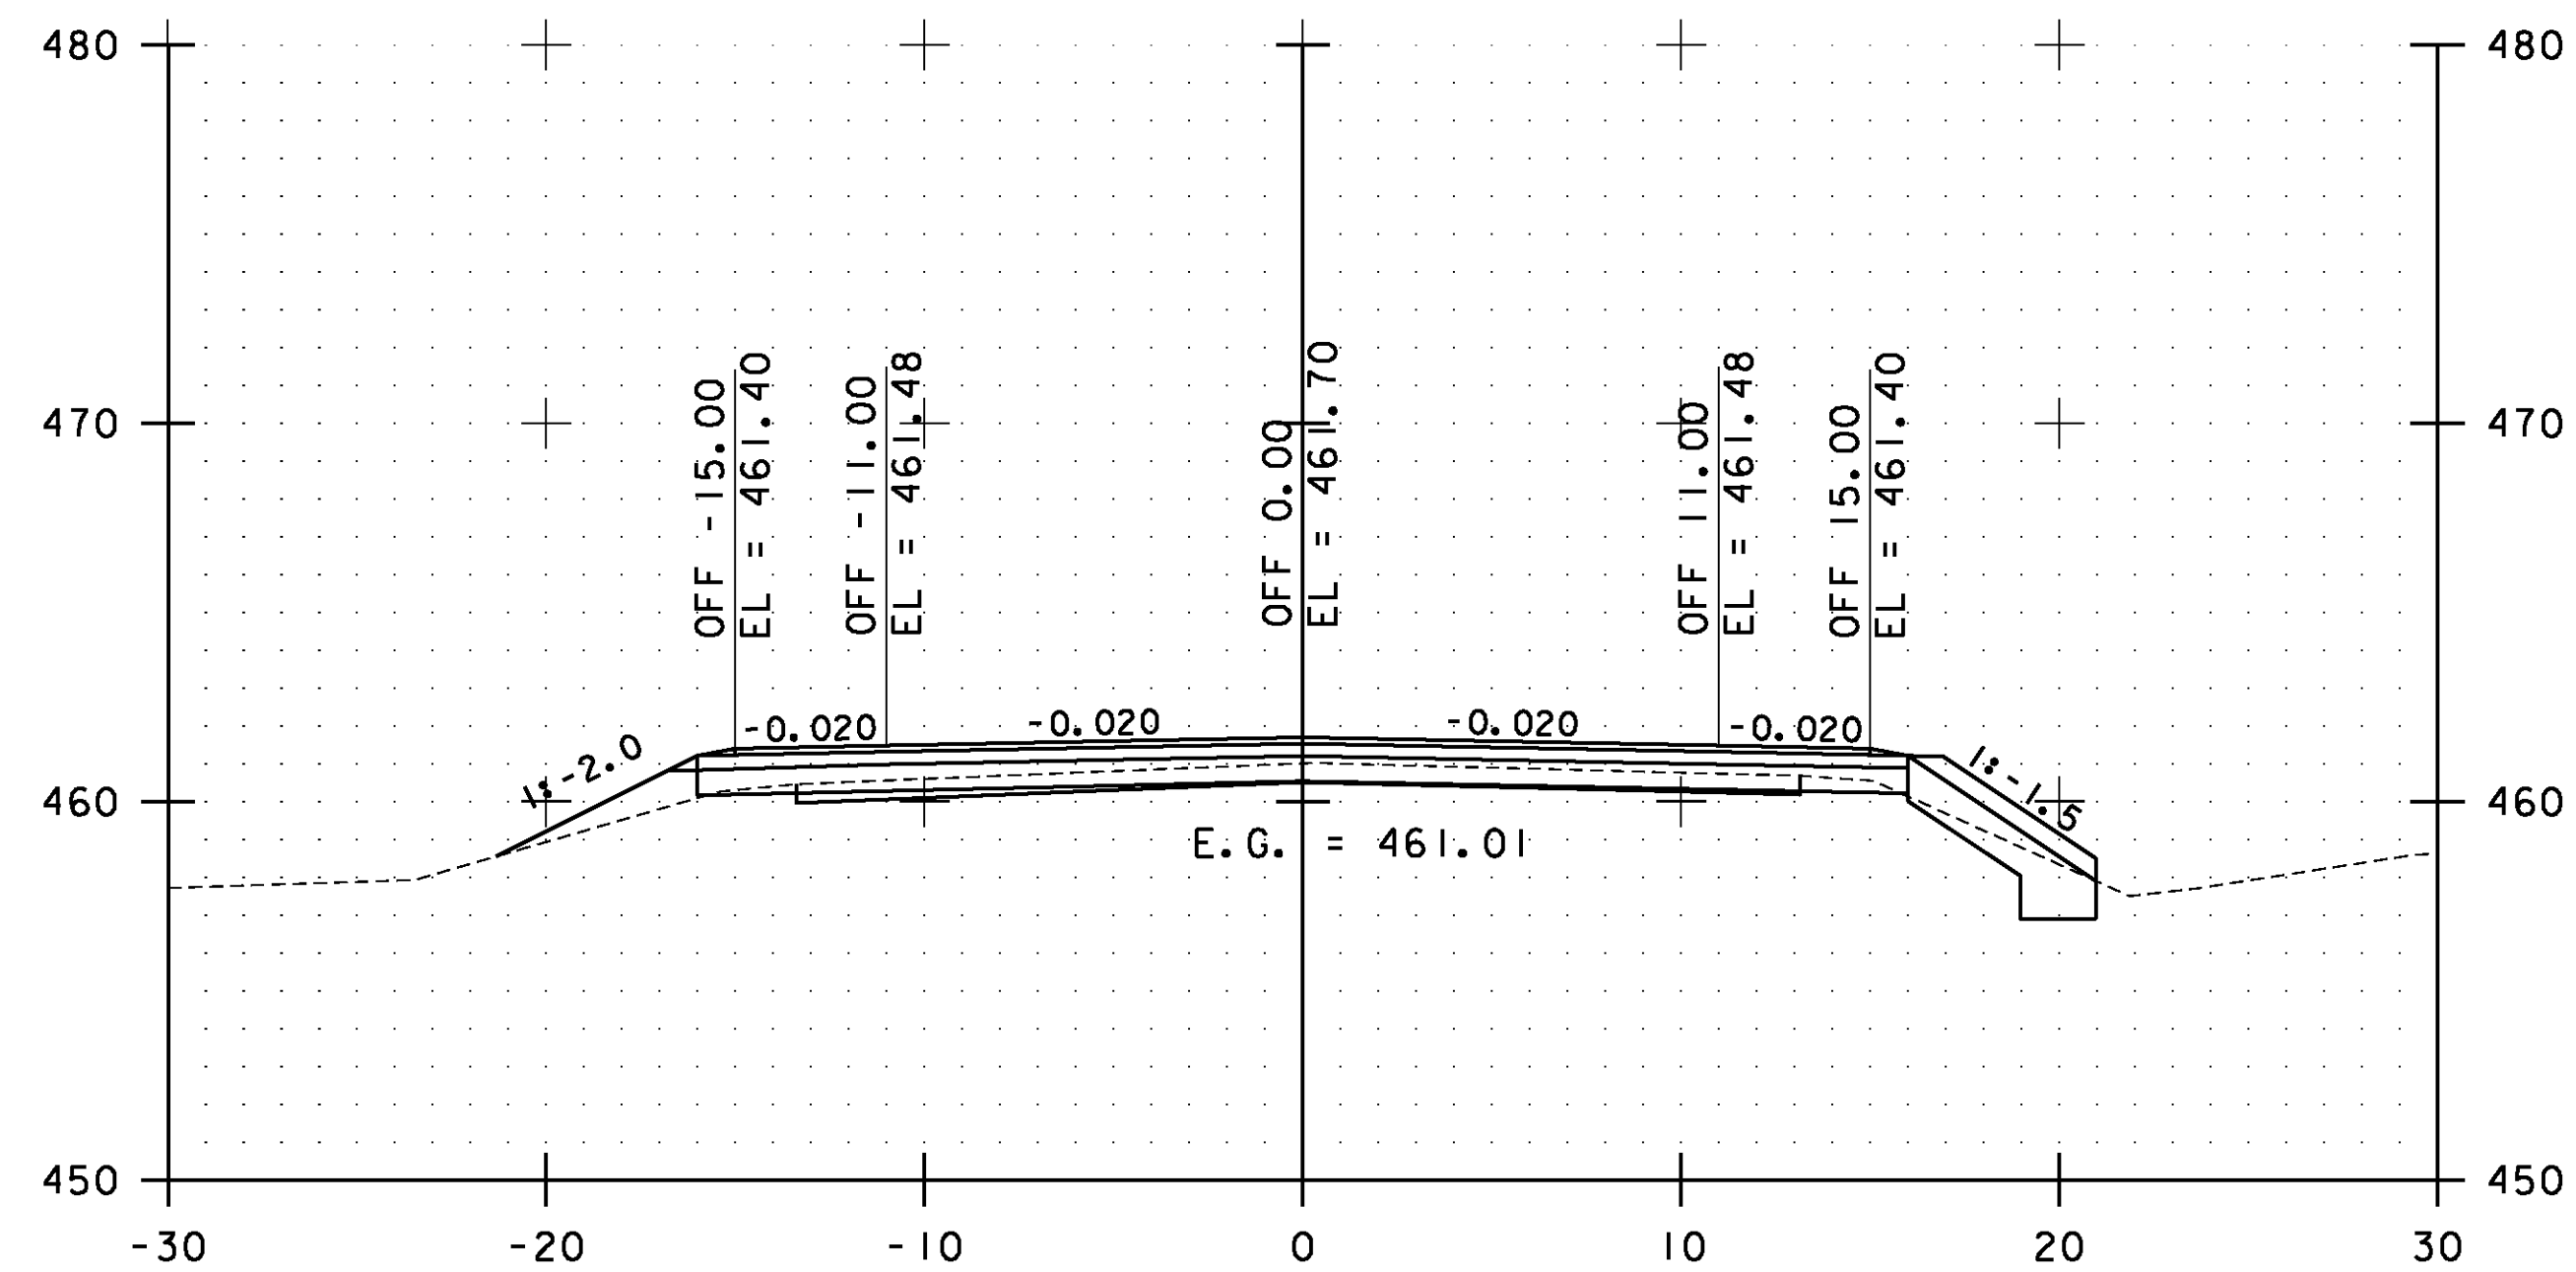


181+00.00

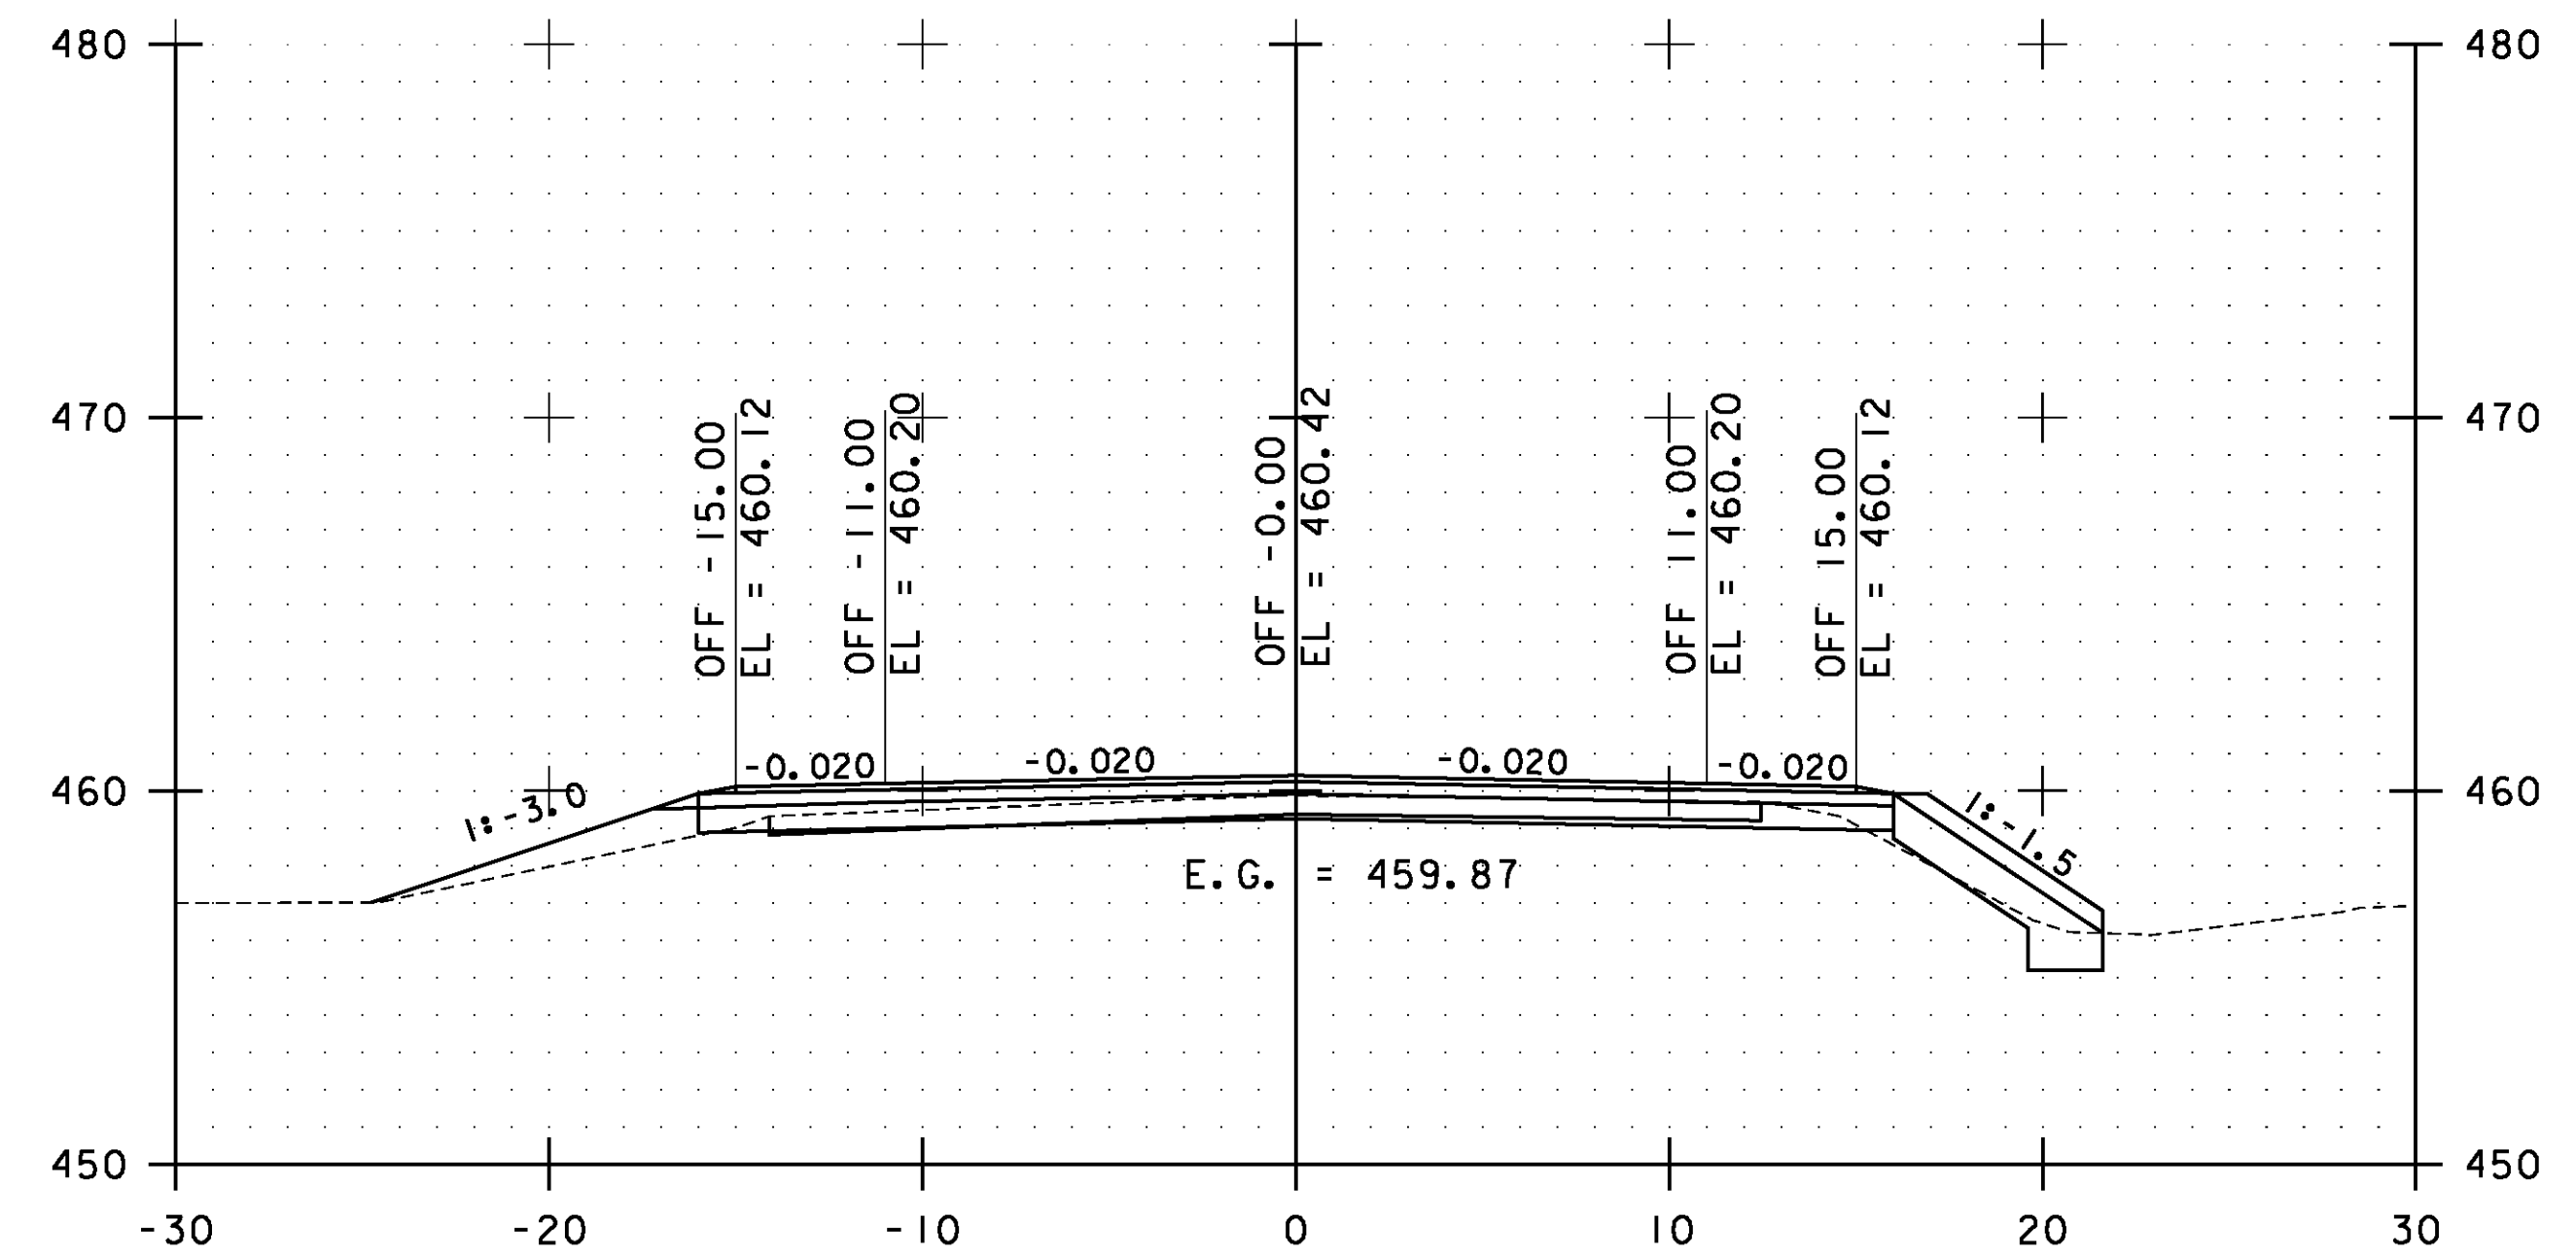

182+00.00

STA. 181+00.00 TO STA. 182+50.00

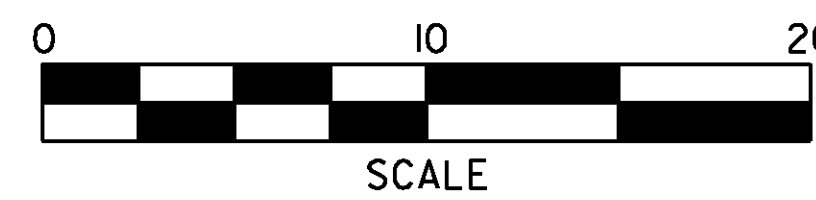

**ESSEX
CROSS
SECTIONS
SHEET #85**

PROJECT NAME: ESSEX-WESTFORD
PROJECT NUMBER: STP 2912(I)

FILE NAME: p10c226.dgn
PROJECT LEADER: JLL
DESIGNED BY: STANTEC
IPARM FILE: p10c226xs085.i

PLOT DATE: 2/20/2013
DRAWN BY: STANTEC
CHECKED BY: STANTEC
SHEET 176 OF 239