




190+00.00

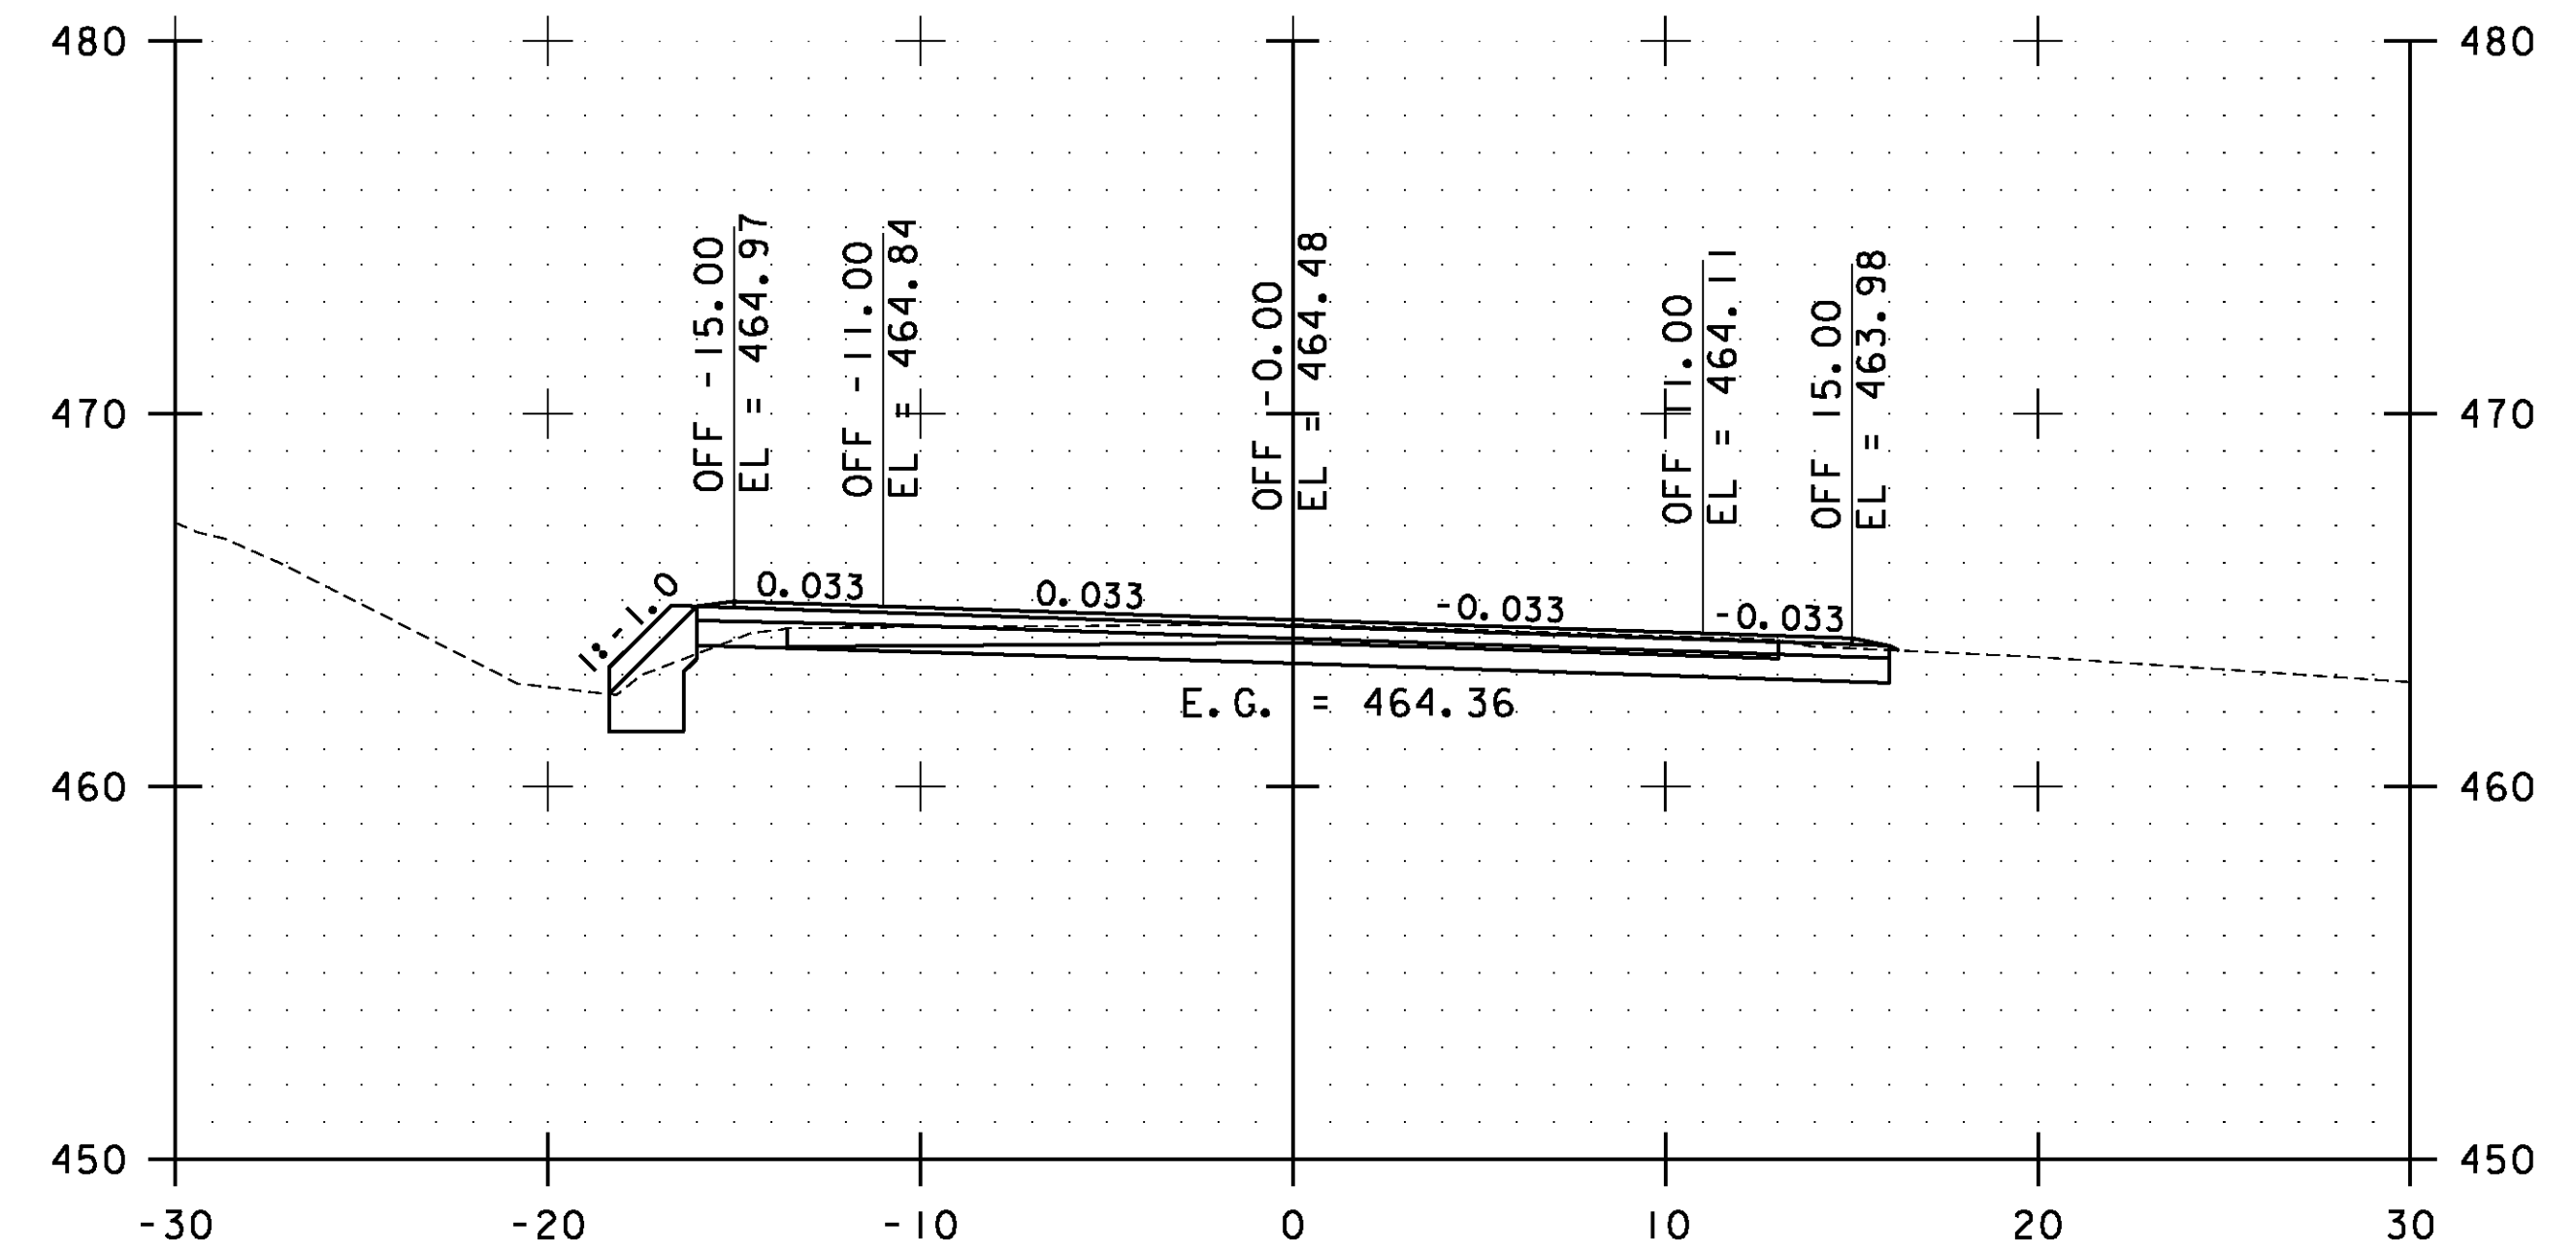

191+00.00

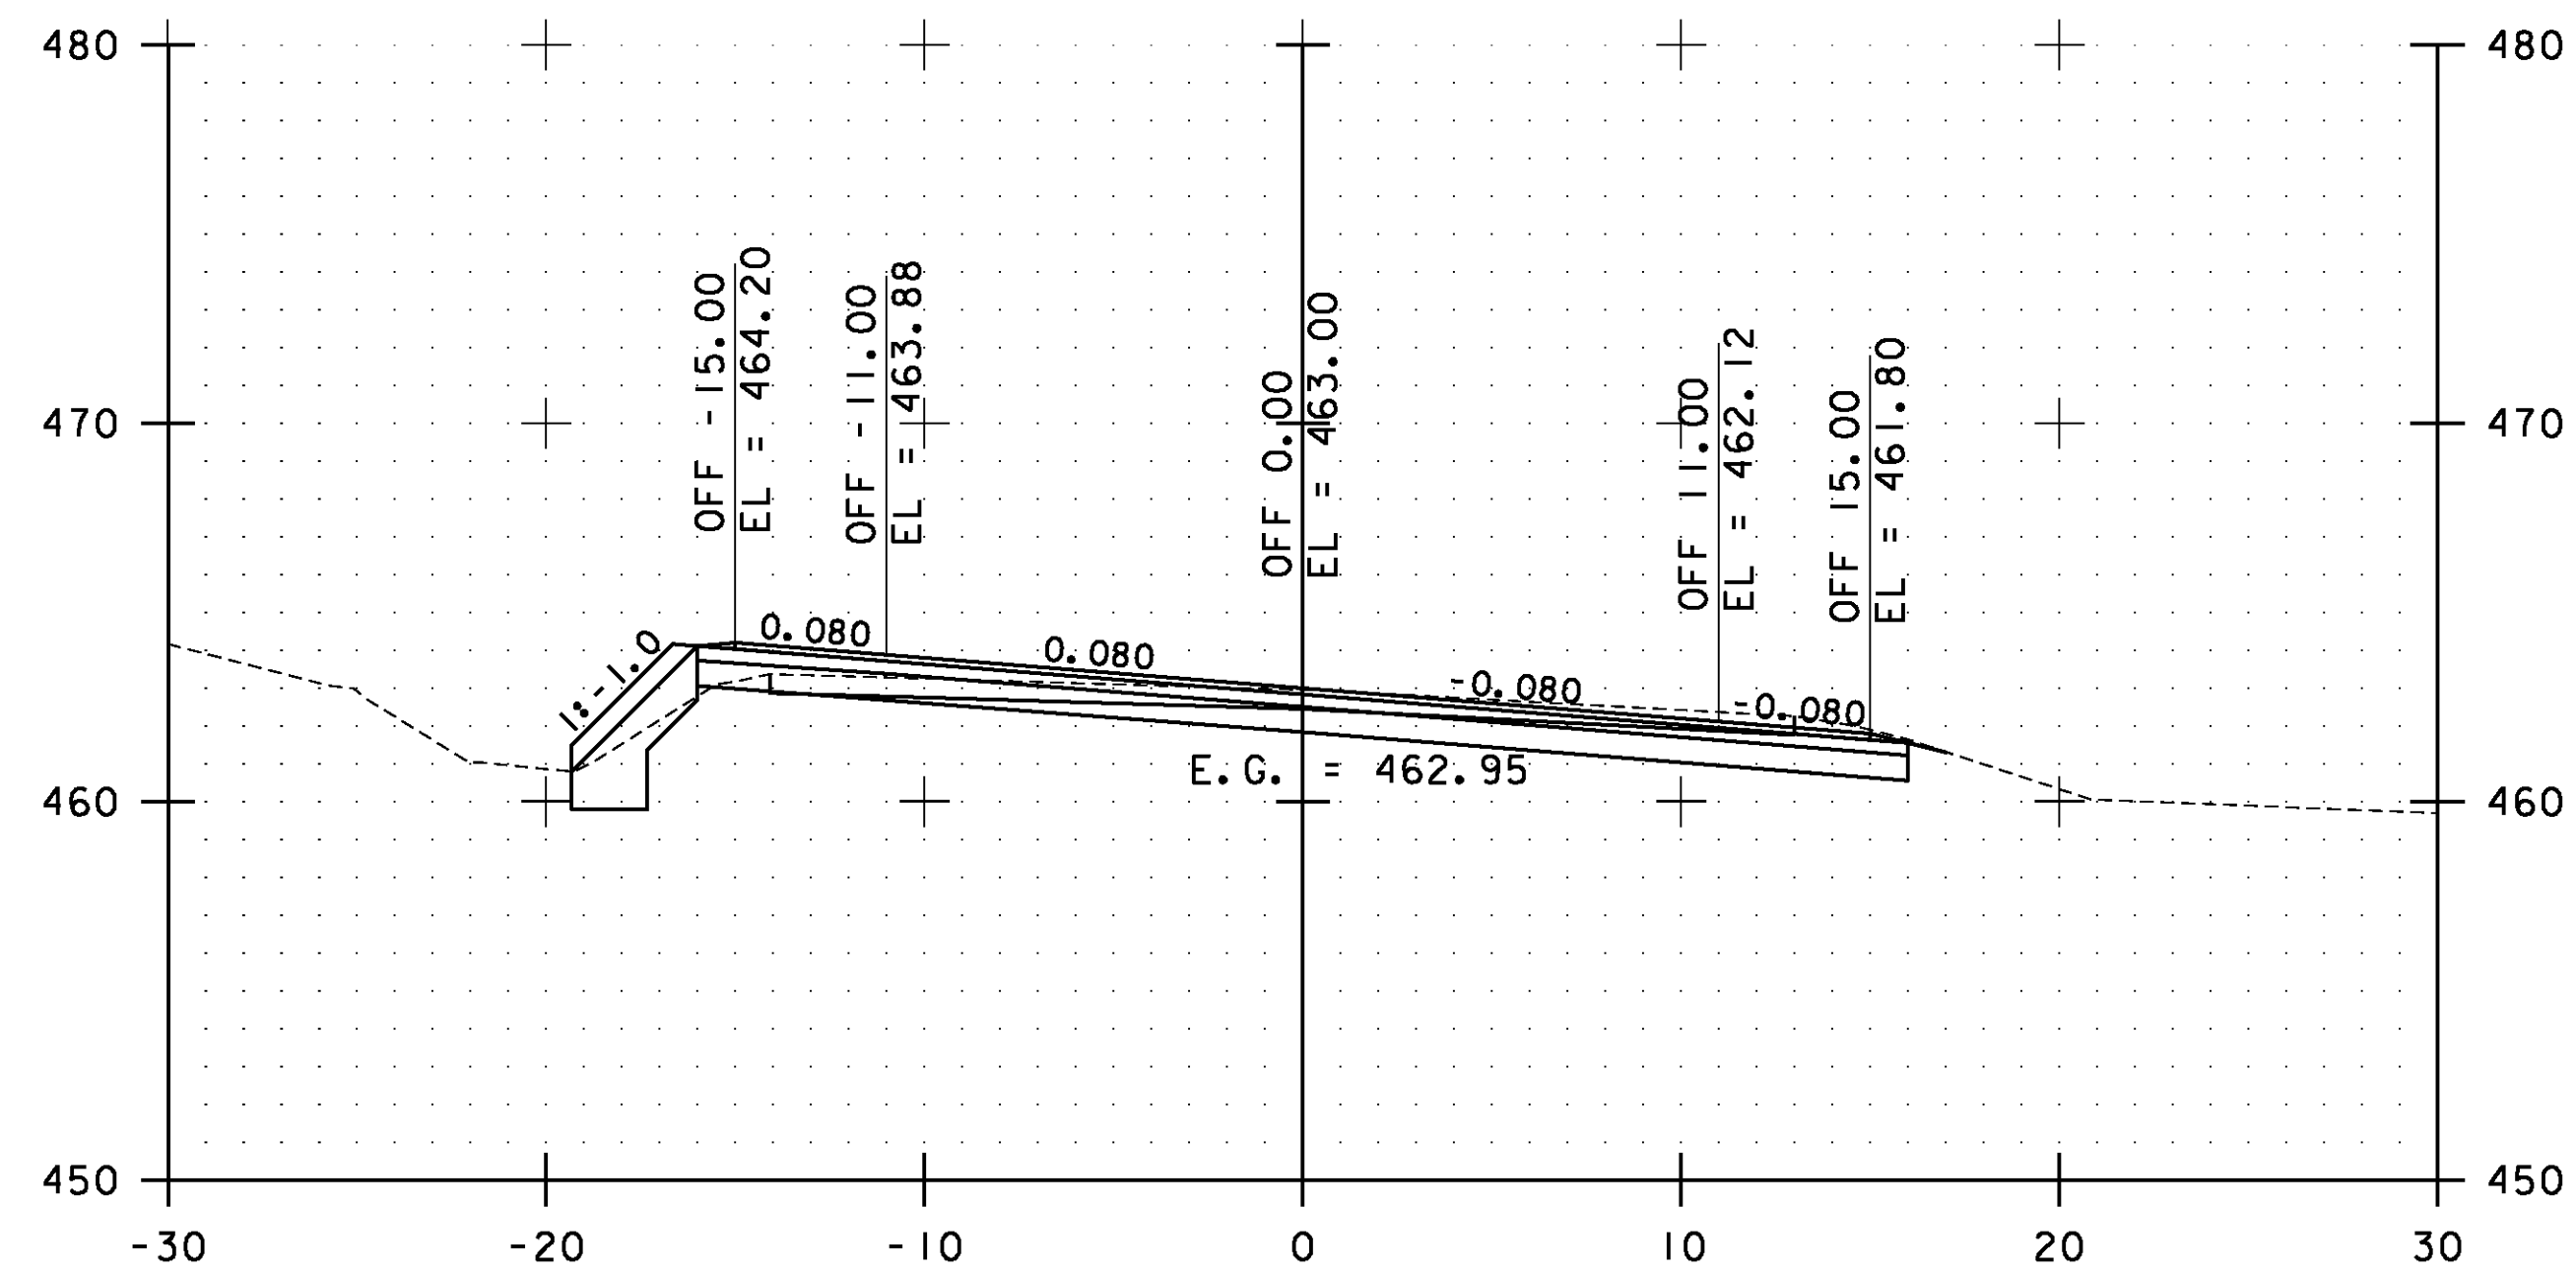


189+50.00

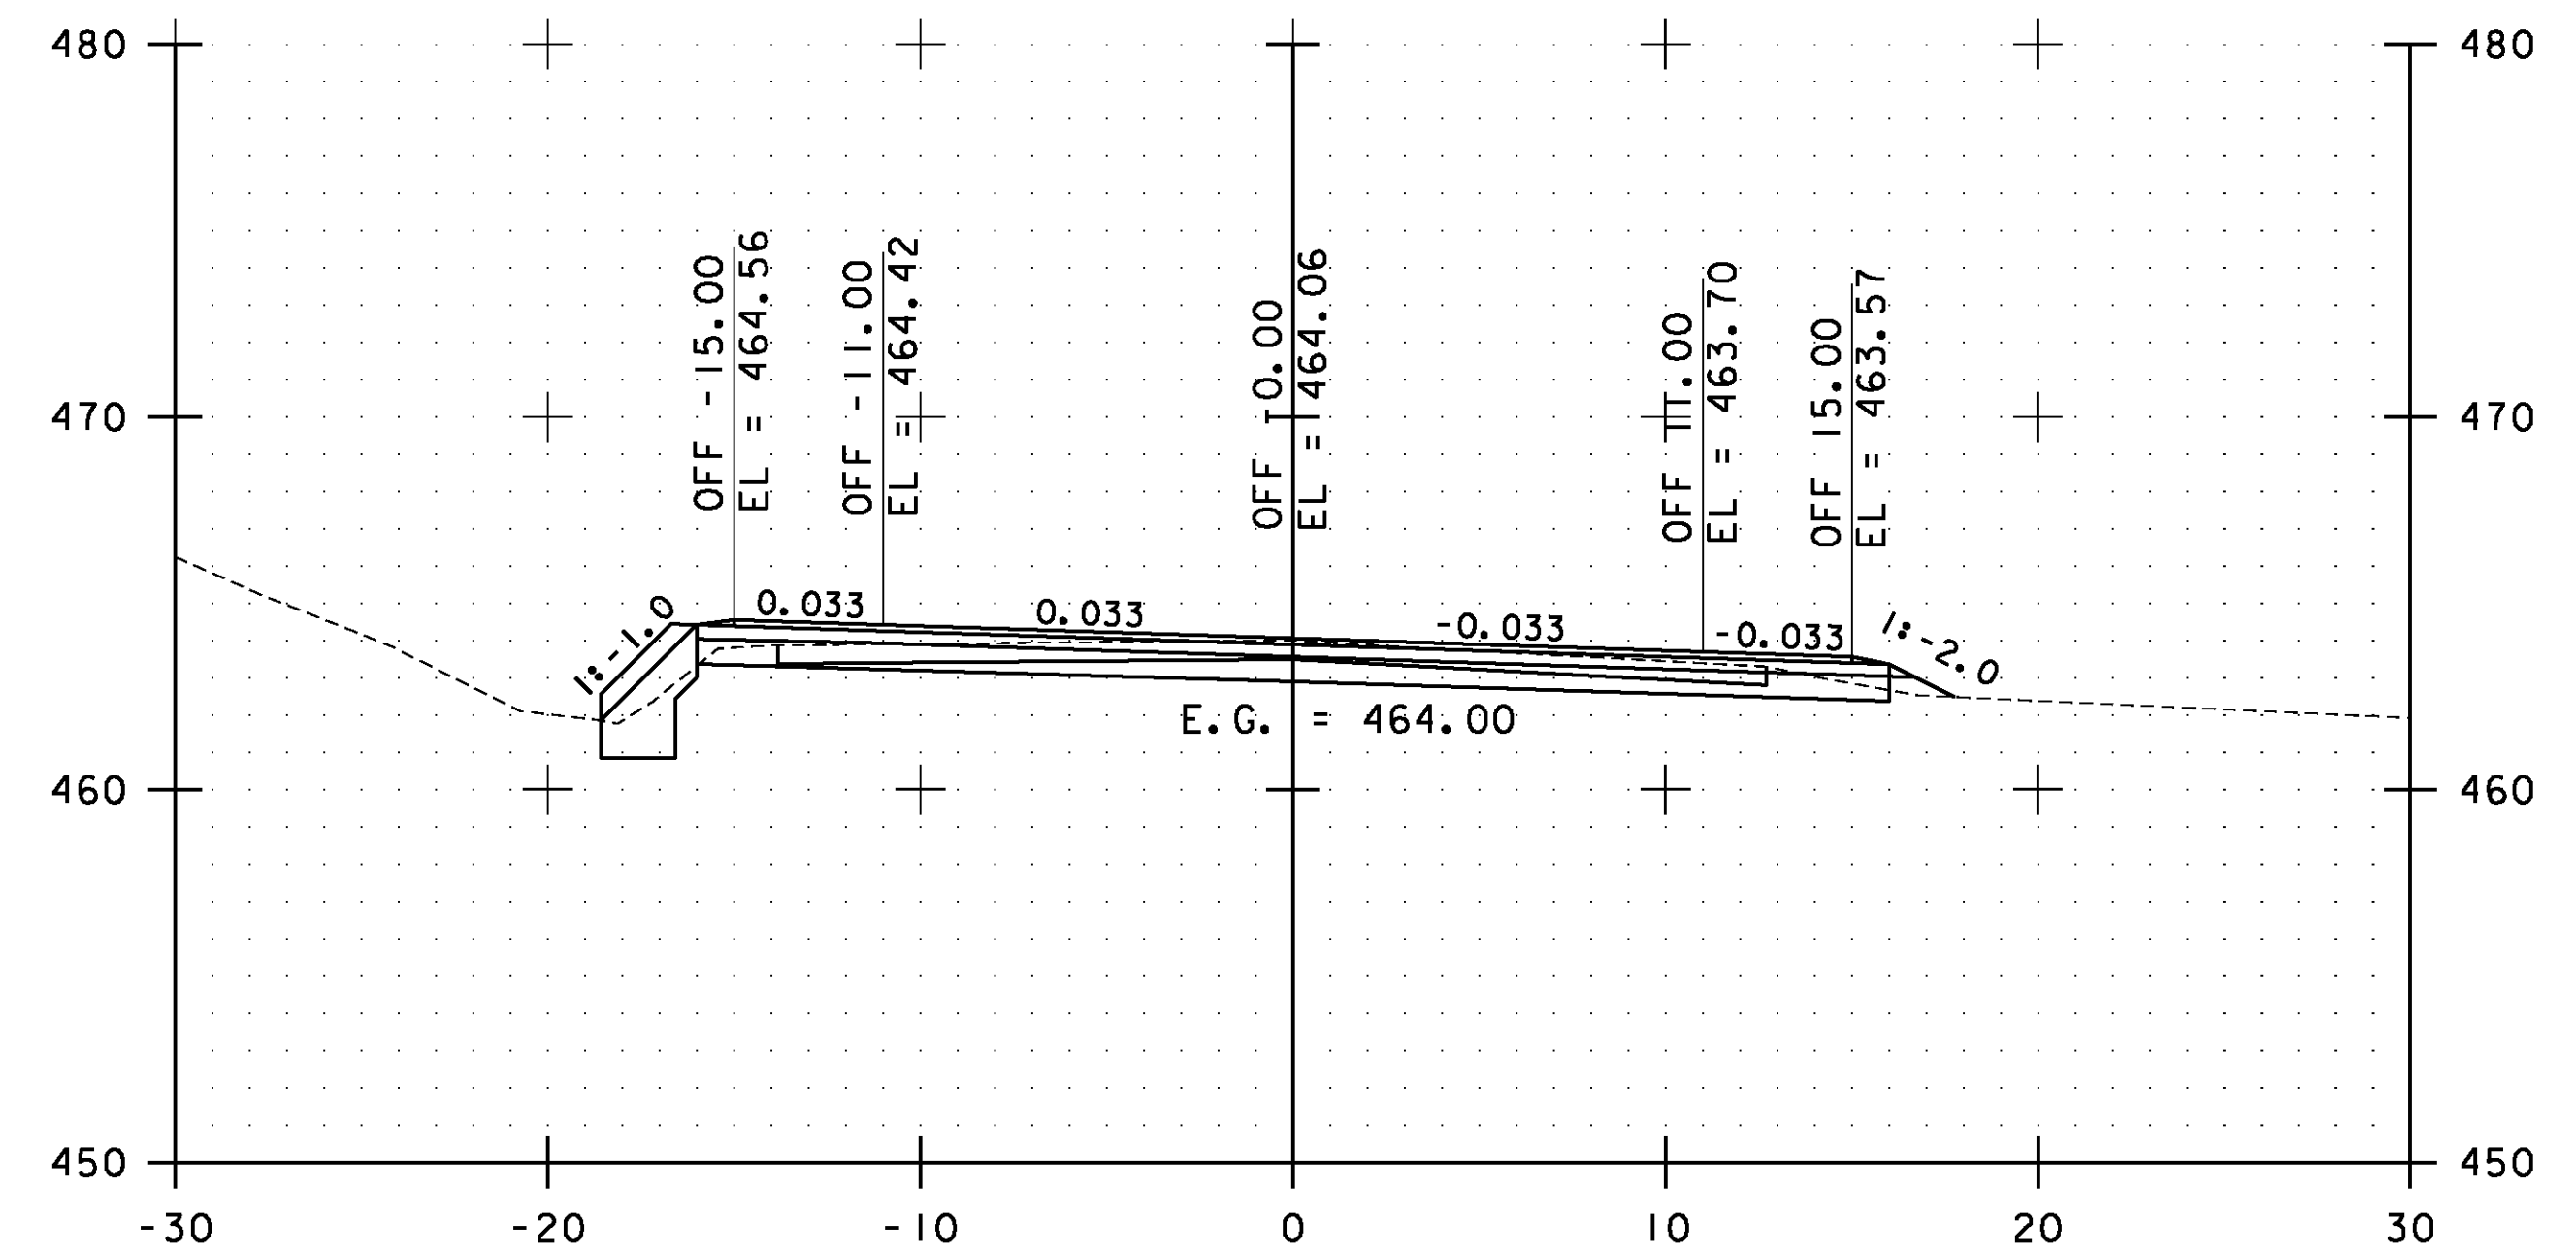

190+50.00

STA. 189+50.00 TO STA. 191+00.00

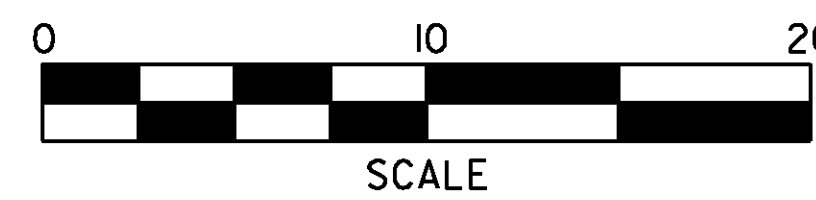

**ESSEX  
CROSS  
SECTIONS  
SHEET #89**

PROJECT NAME: ESSEX-WESTFORD  
PROJECT NUMBER: STP 2912(I)

FILE NAME: p10c226.dgn  
PROJECT LEADER: JLL  
DESIGNED BY: STANTEC  
IPARM FILE: p10c226xs089.i

PLOT DATE: 2/20/2013  
DRAWN BY: STANTEC  
CHECKED BY: STANTEC  
SHEET 180 OF 239