




194+00.00

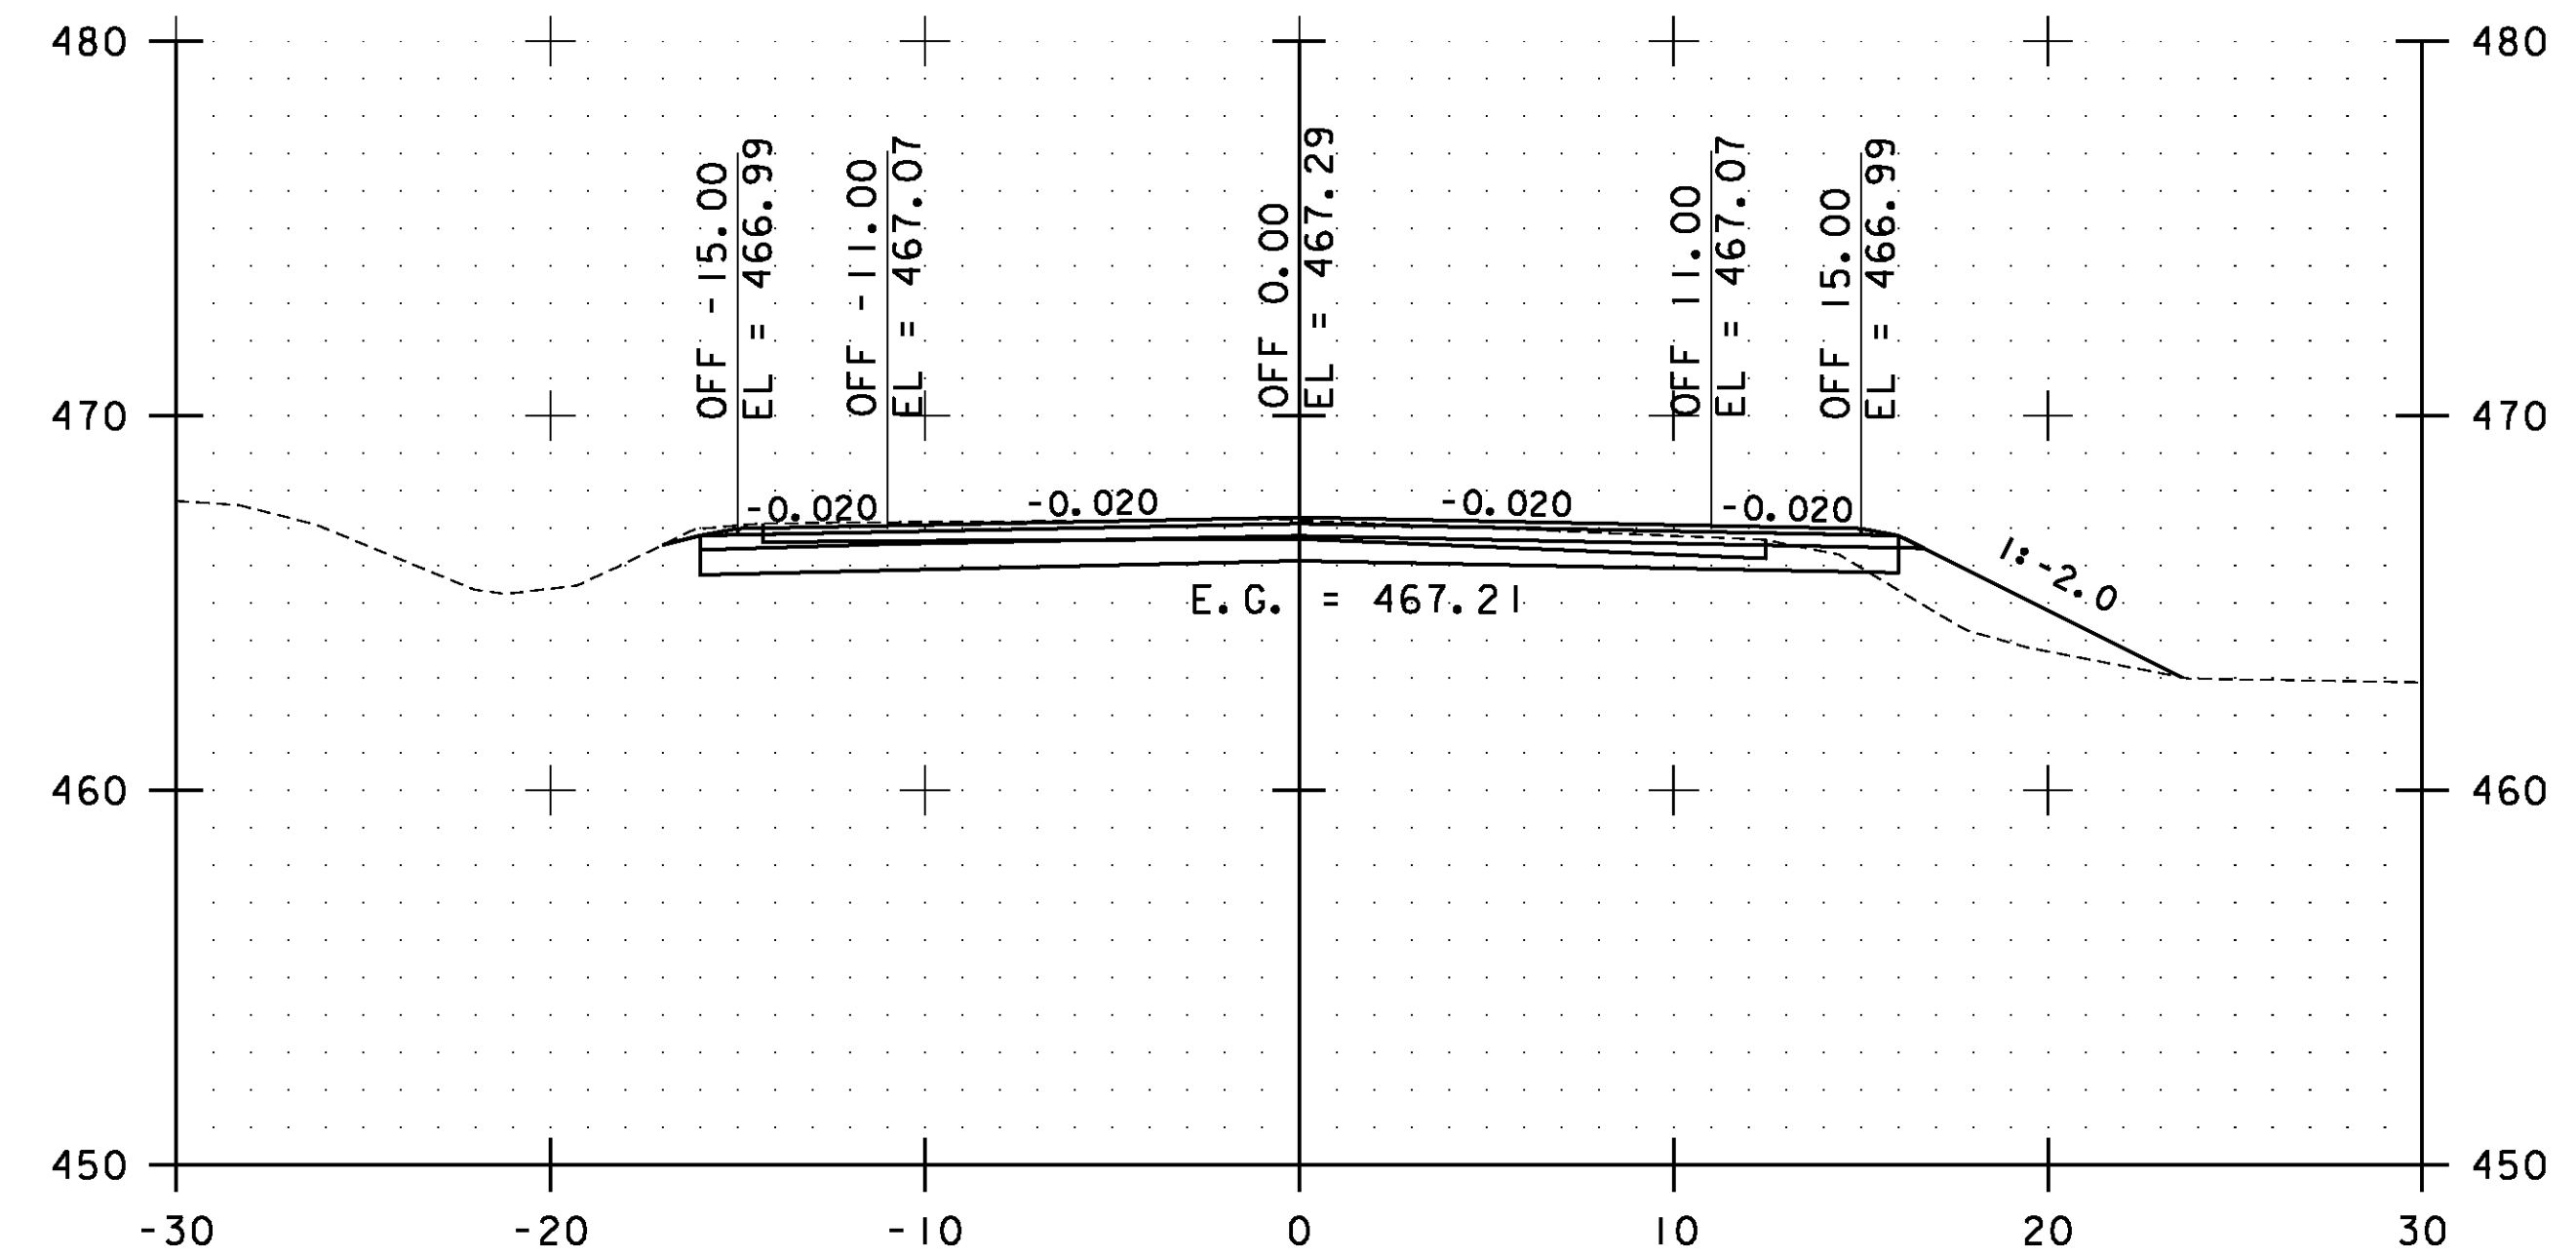

195+00.00

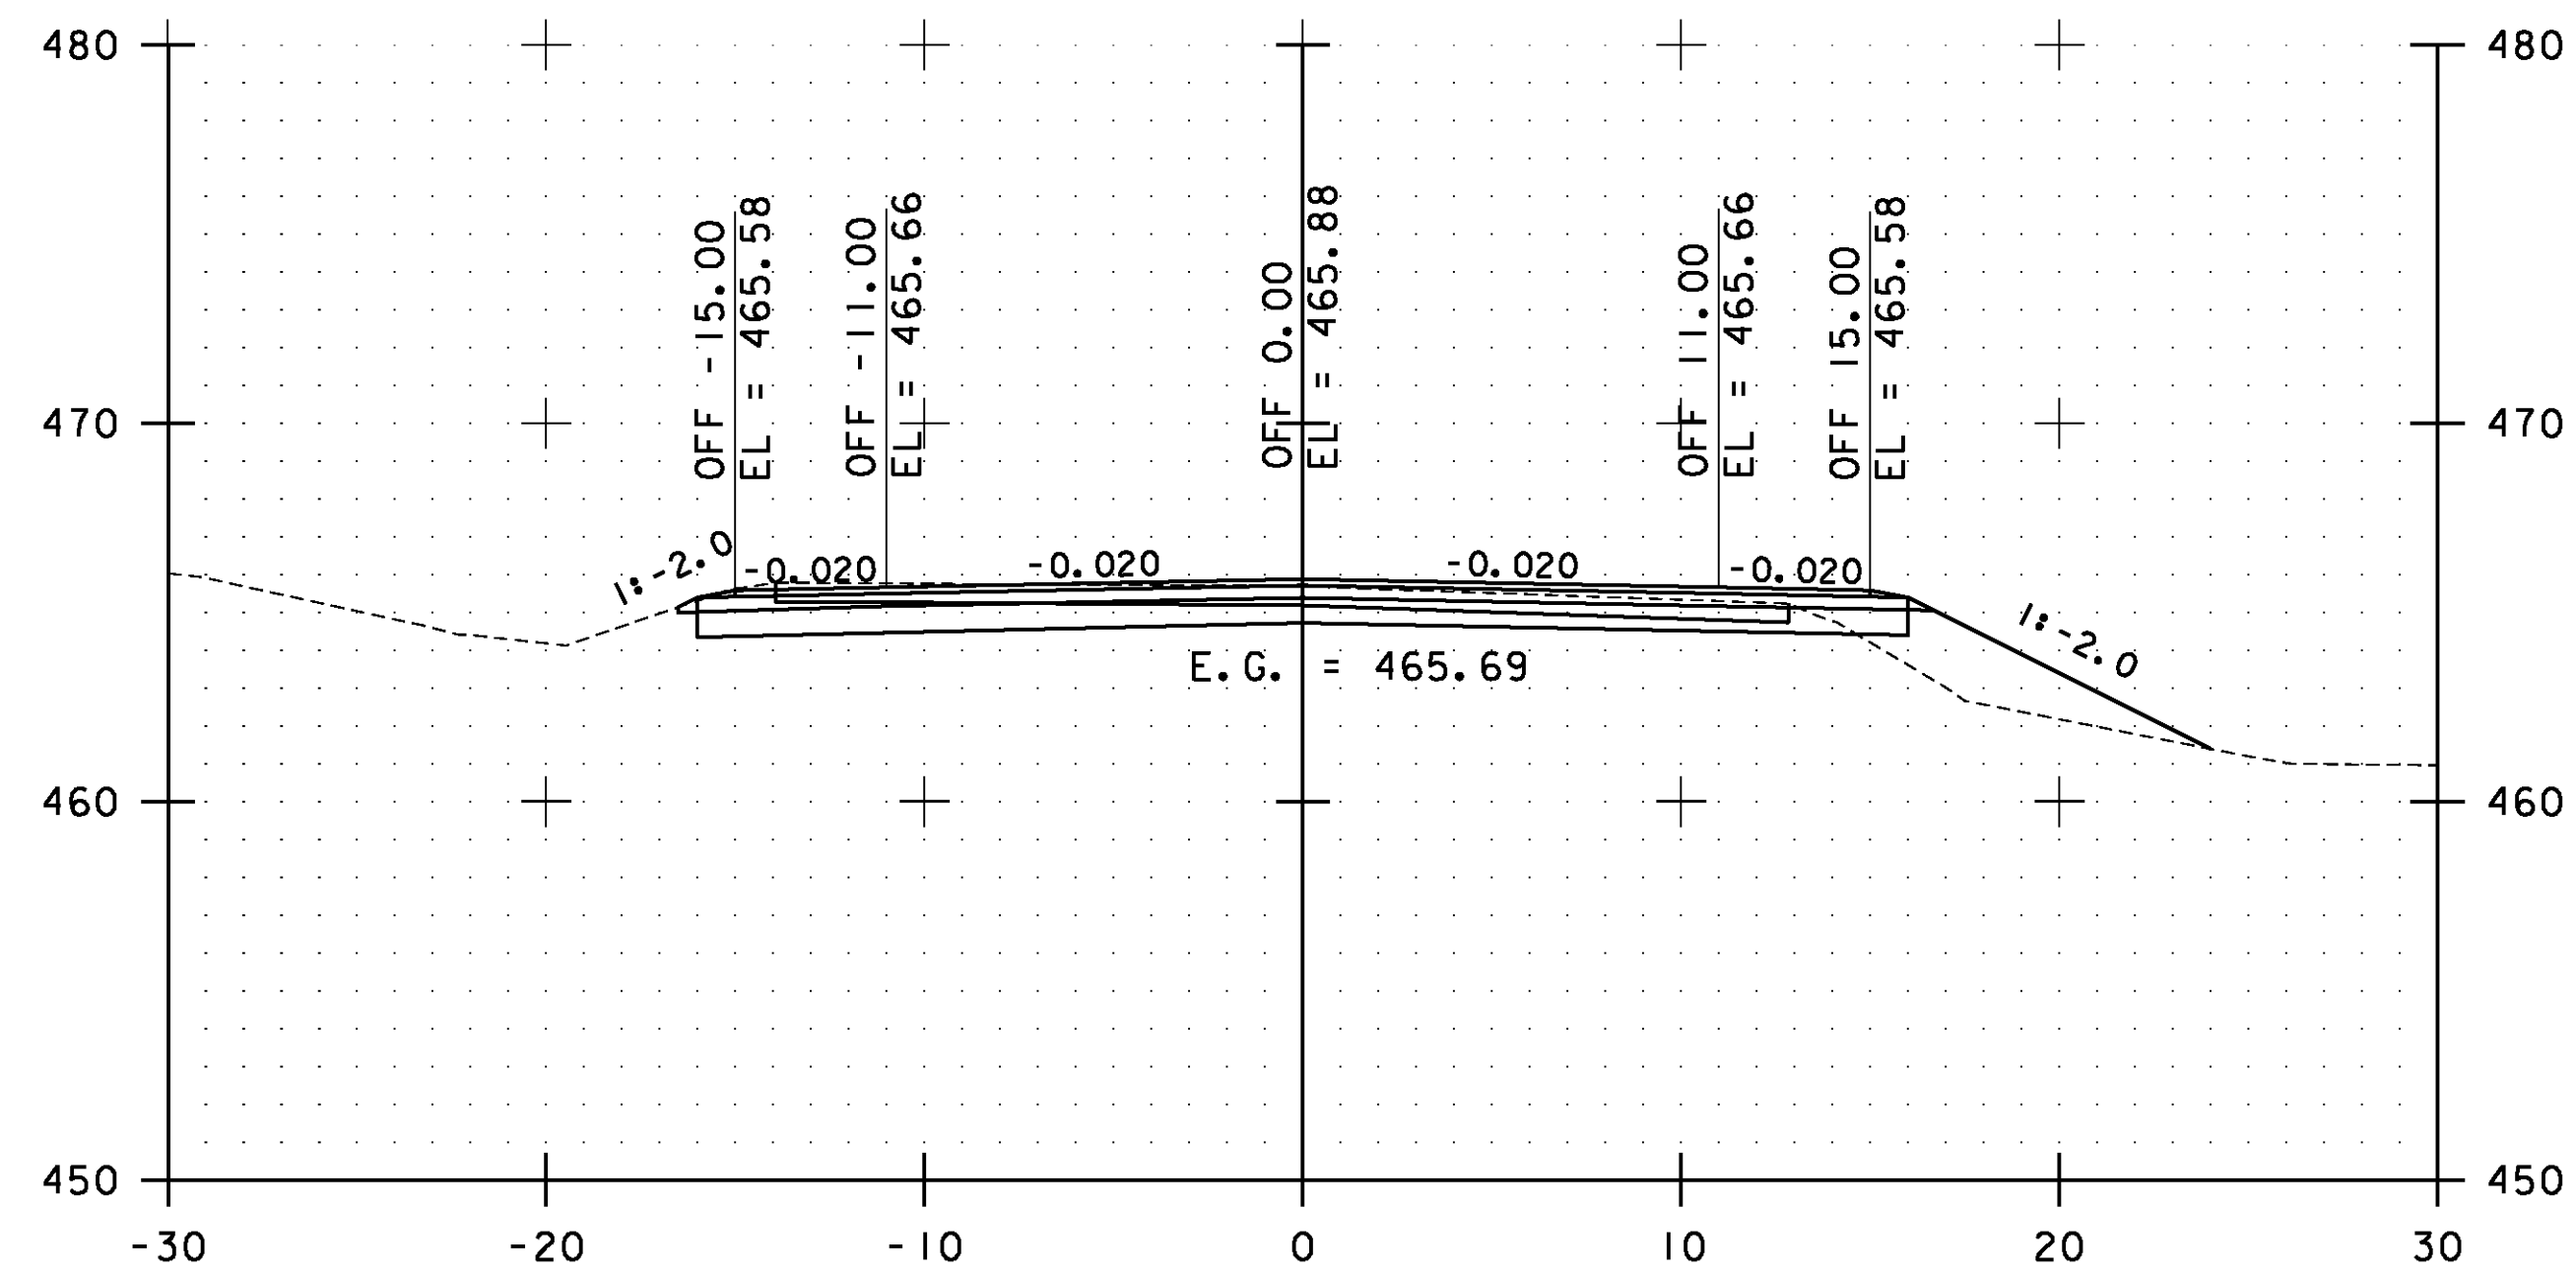


193+50.00

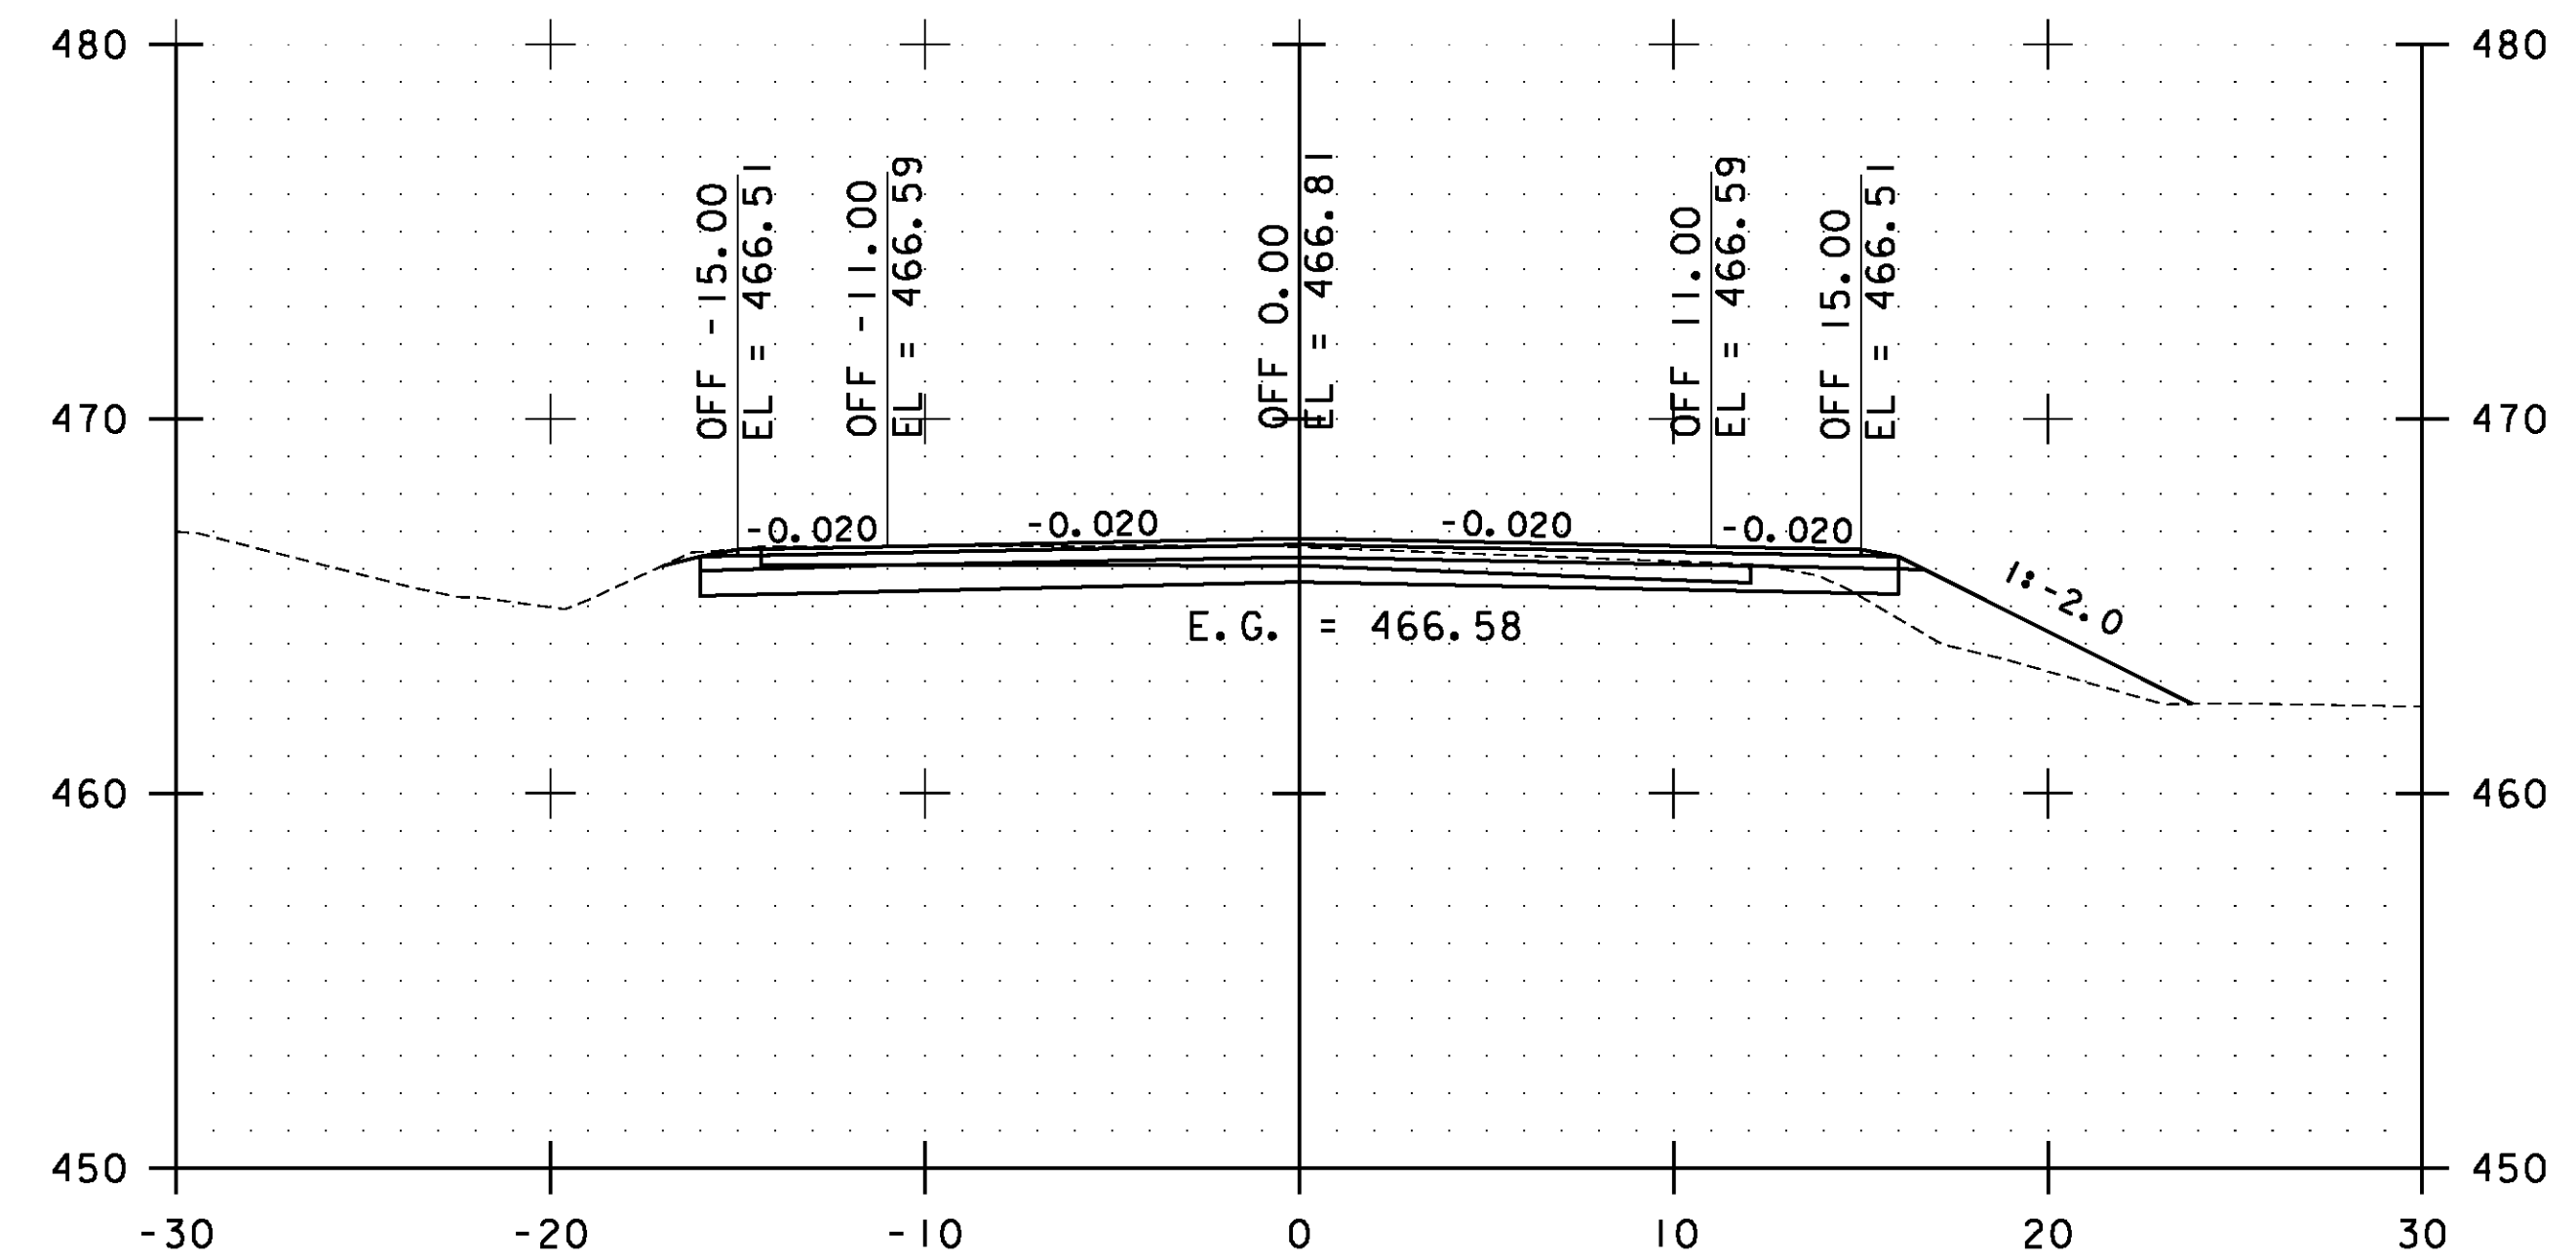

194+50.00

STA. 193+50.00 TO STA. 195+00.00

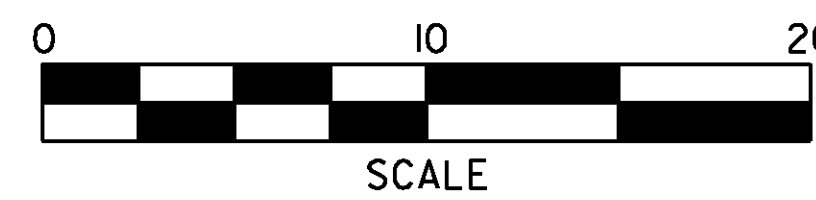

**ESSEX
CROSS
SECTIONS
SHEET #91**

PROJECT NAME: ESSEX-WESTFORD
PROJECT NUMBER: STP 2912(I)

FILE NAME: p10c226.dgn
PROJECT LEADER: JLL
DESIGNED BY: STANTEC
IPARM FILE: p10c226xs091.i

PLOT DATE: 2/20/2013
DRAWN BY: STANTEC
CHECKED BY: STANTEC
SHEET 182 OF 239