




198+00.00

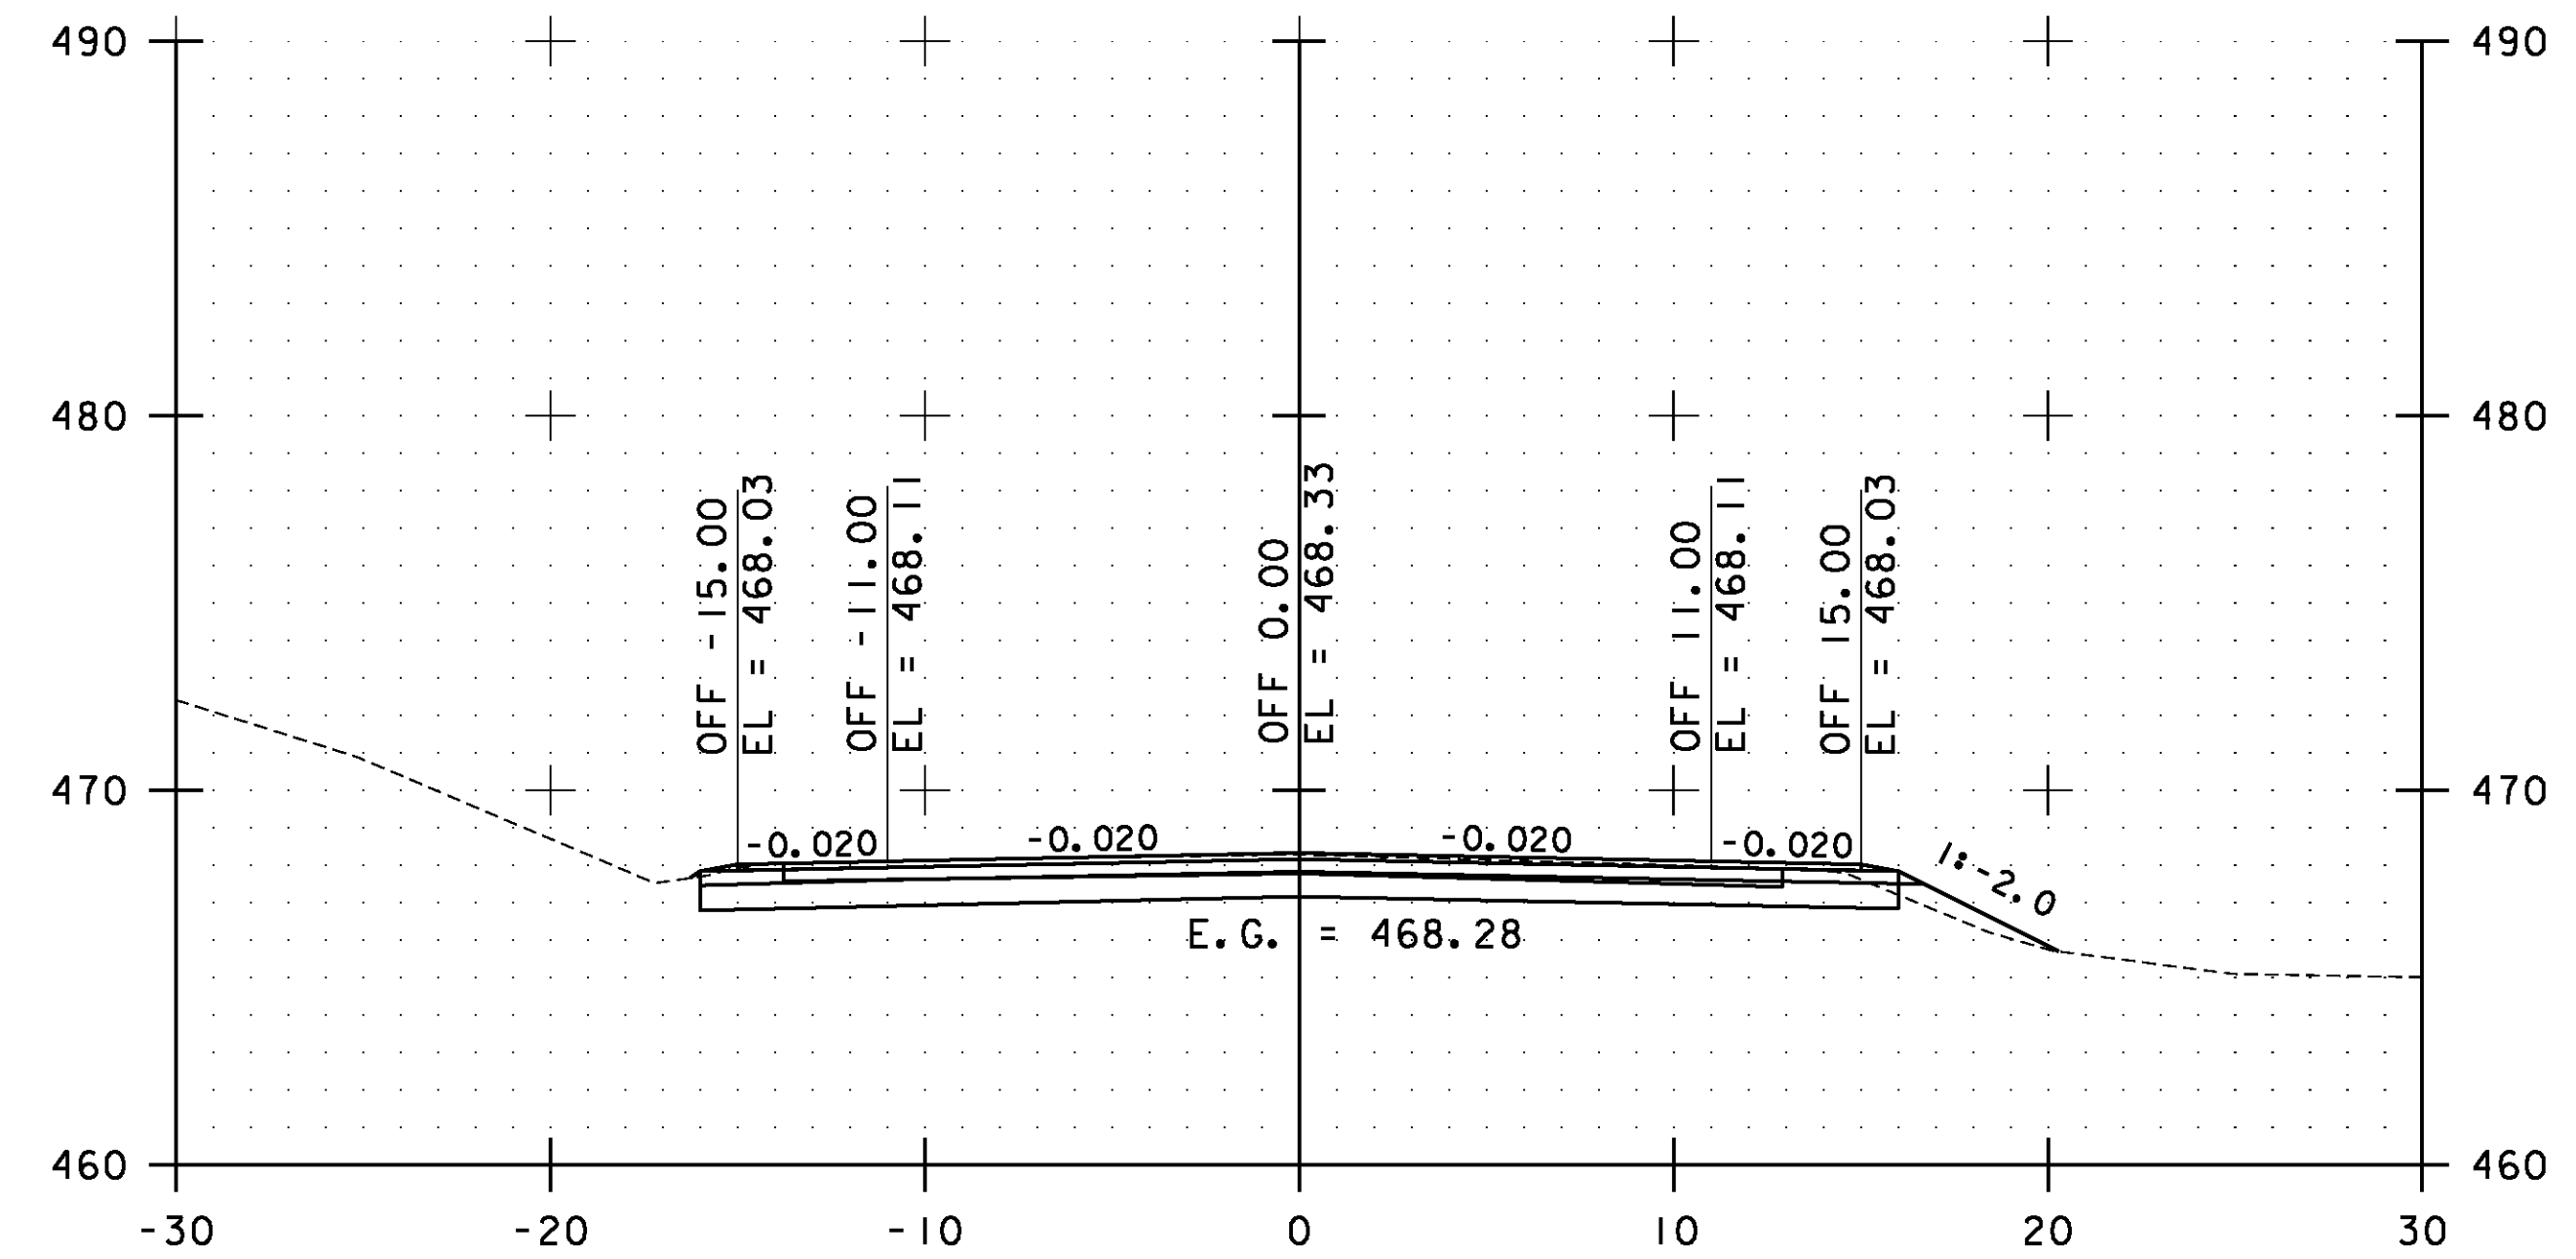

199+00.00

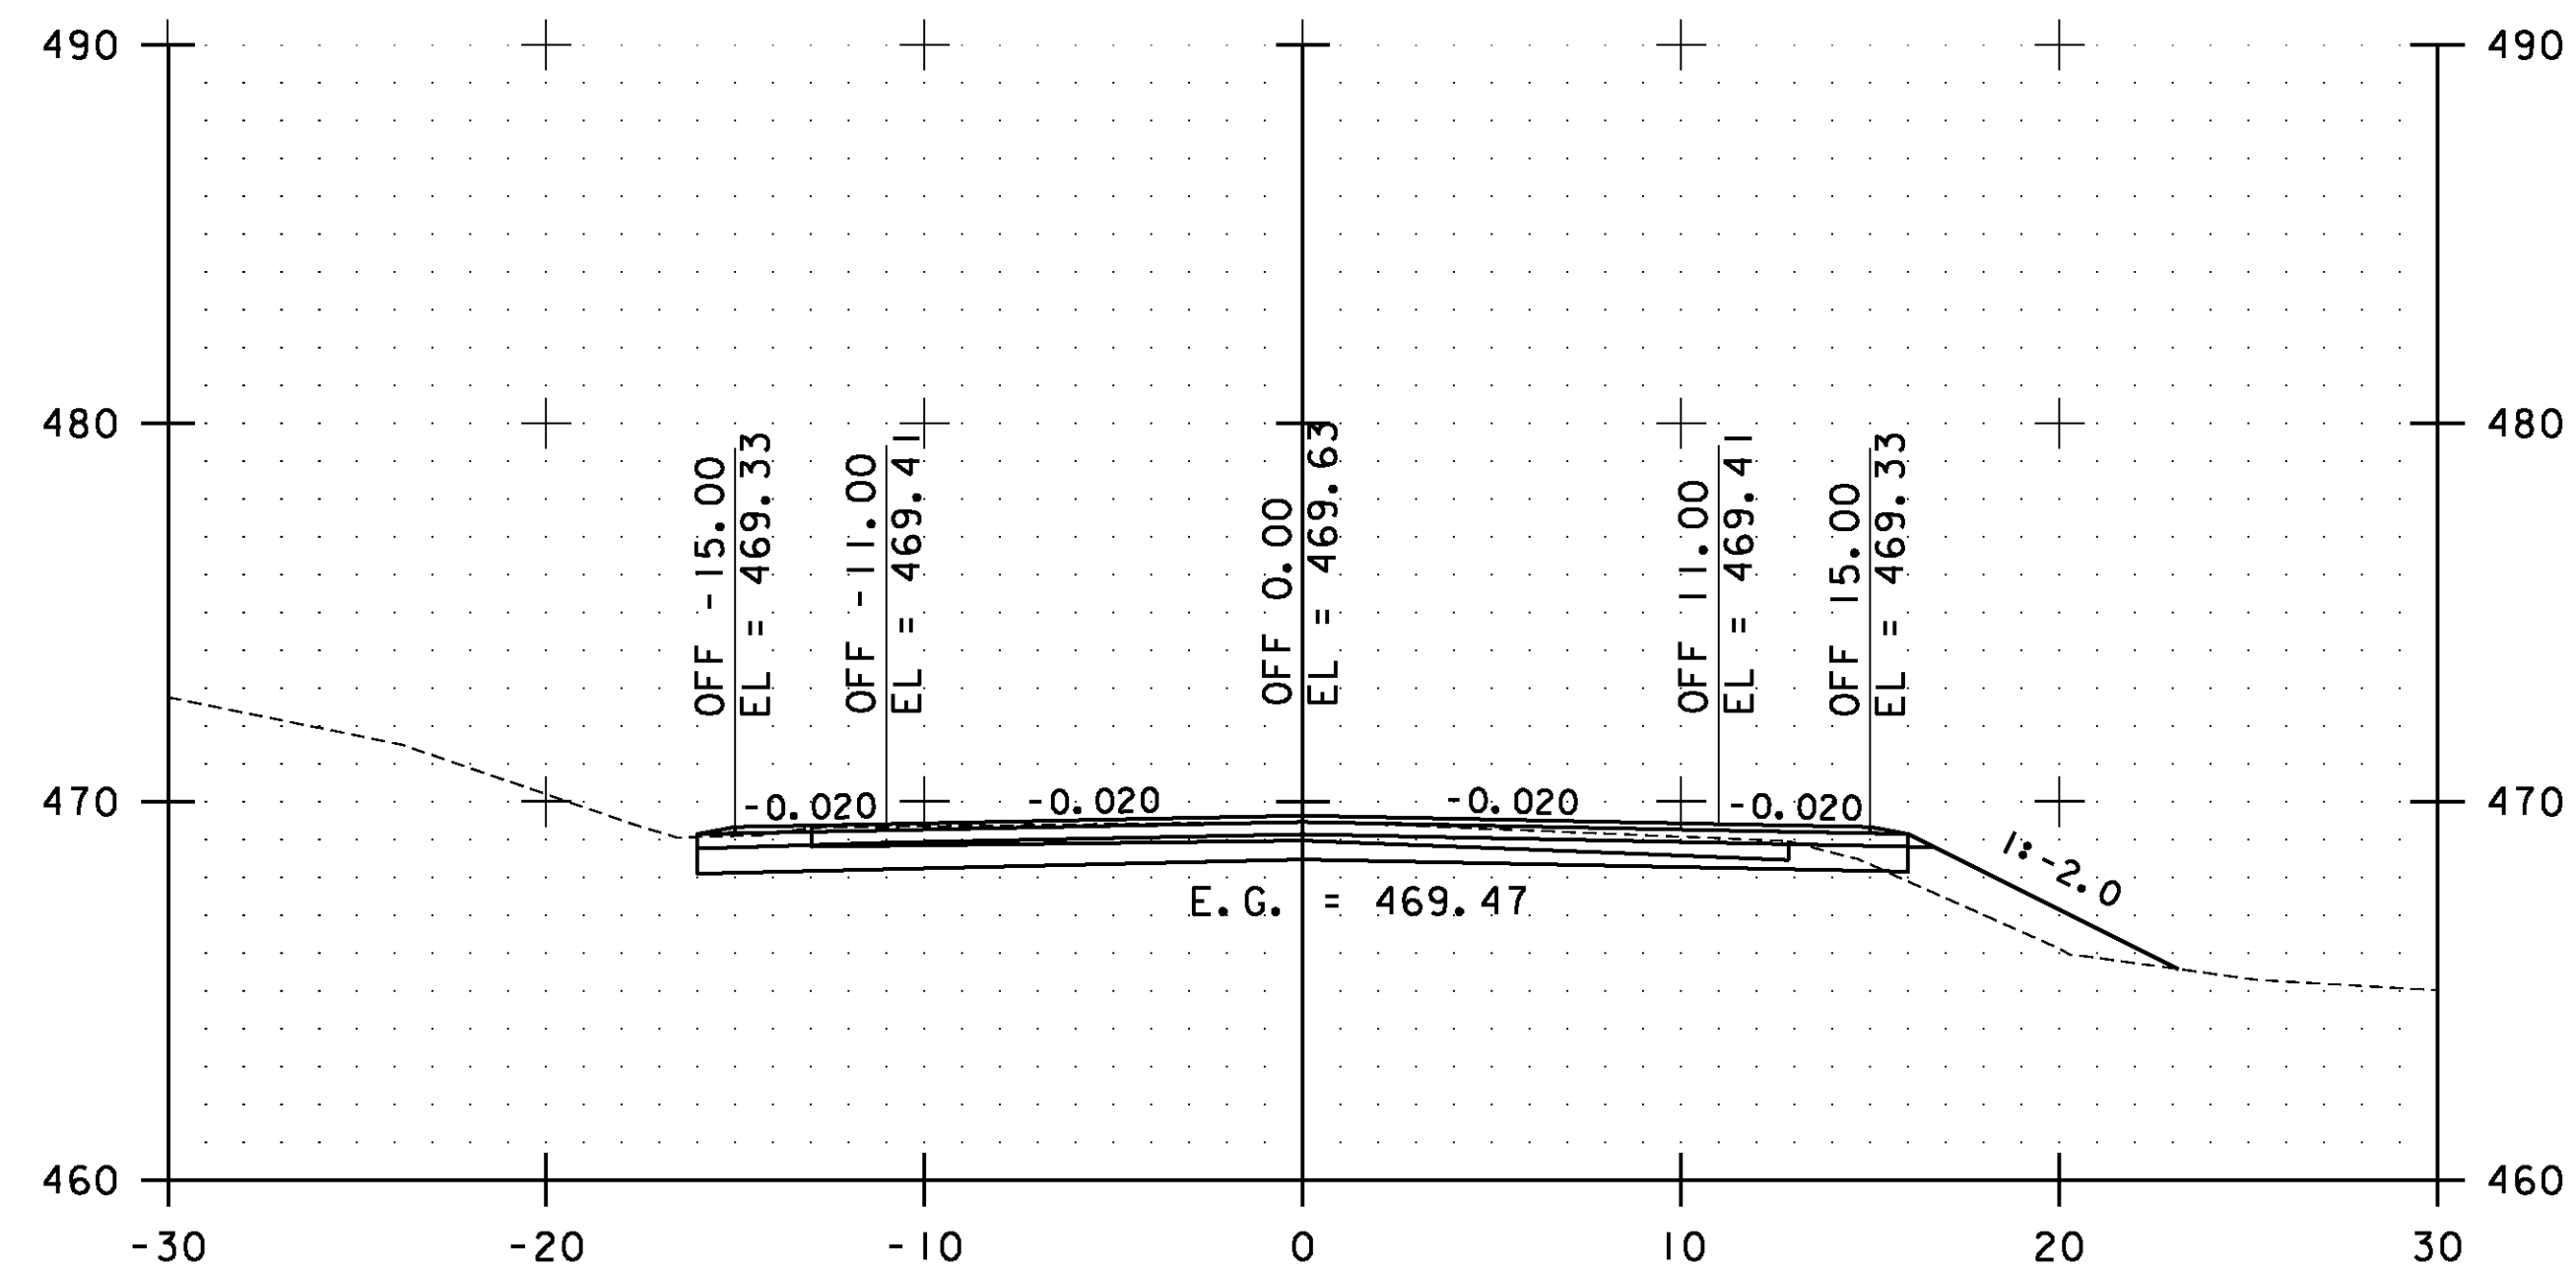


197+50.00

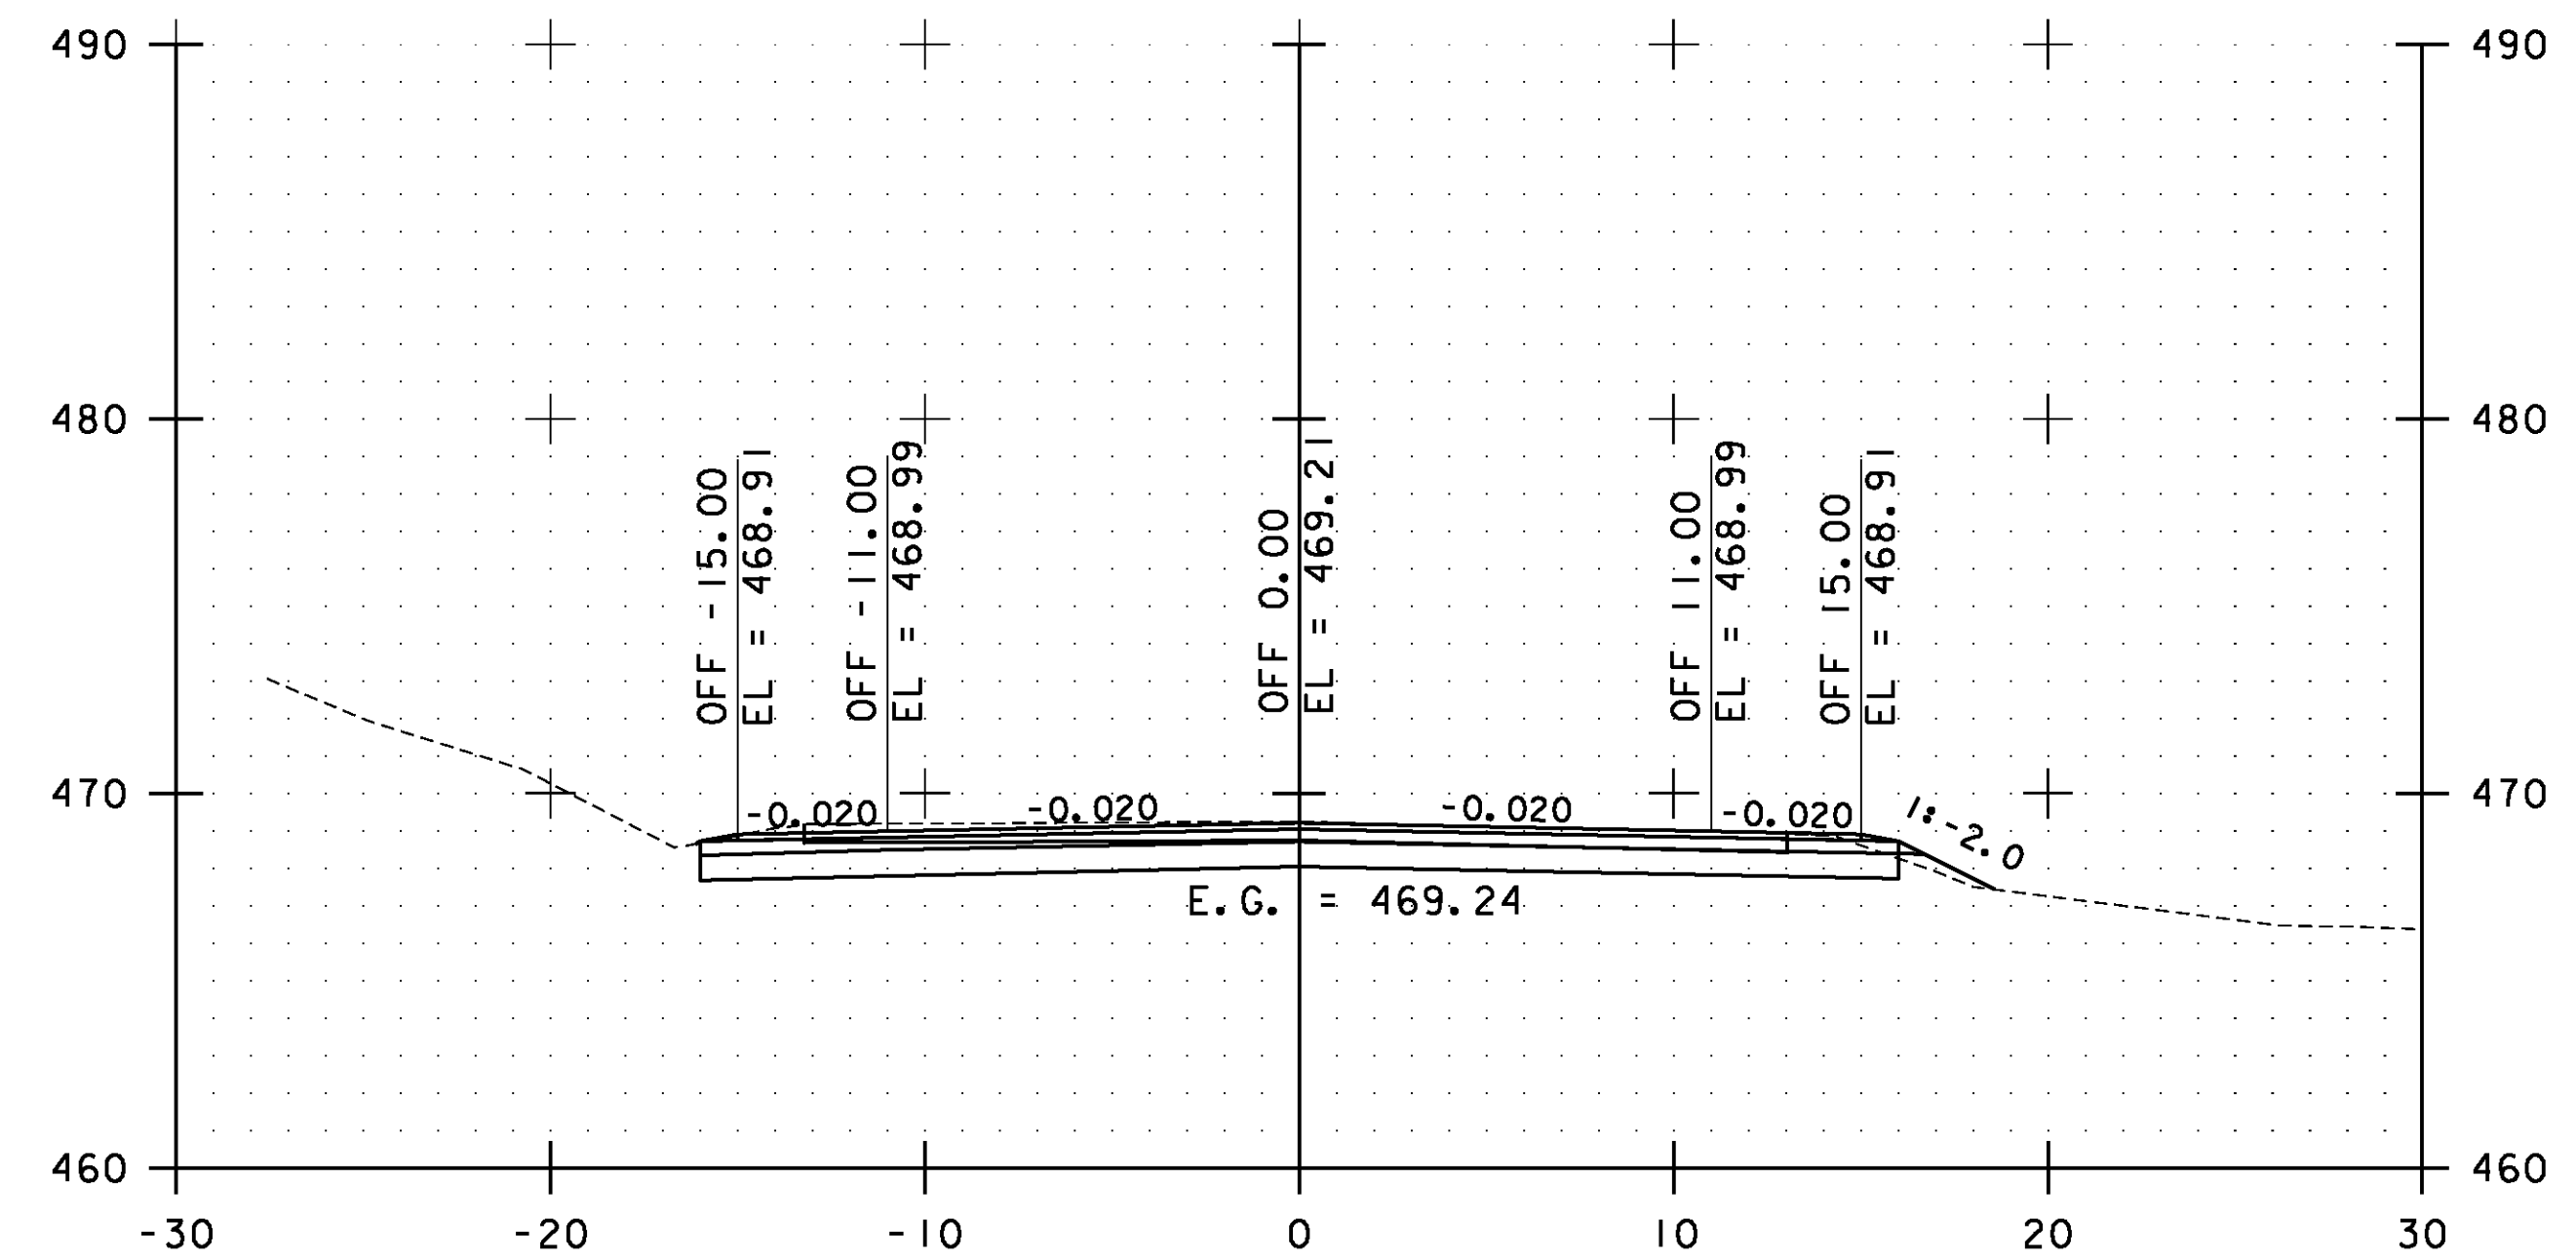

198+50.00

STA. 197+50.00 TO STA. 199+00.00

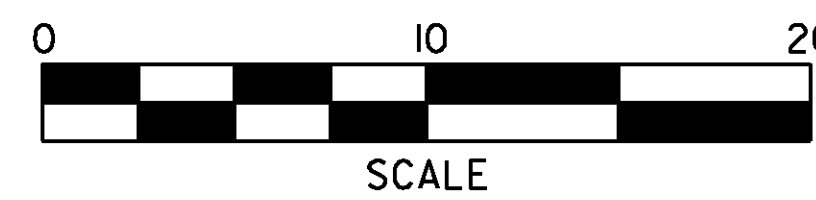

**ESSEX
CROSS
SECTIONS
SHEET #93**

PROJECT NAME: ESSEX-WESTFORD
PROJECT NUMBER: STP 2912(I)

FILE NAME: p10c226.dgn
PROJECT LEADER: JLL
DESIGNED BY: STANTEC
IPARM FILE: p10c226xs093.i

PLOT DATE: 2/20/2013
DRAWN BY: STANTEC
CHECKED BY: STANTEC
SHEET 184 OF 239