




208+50.00

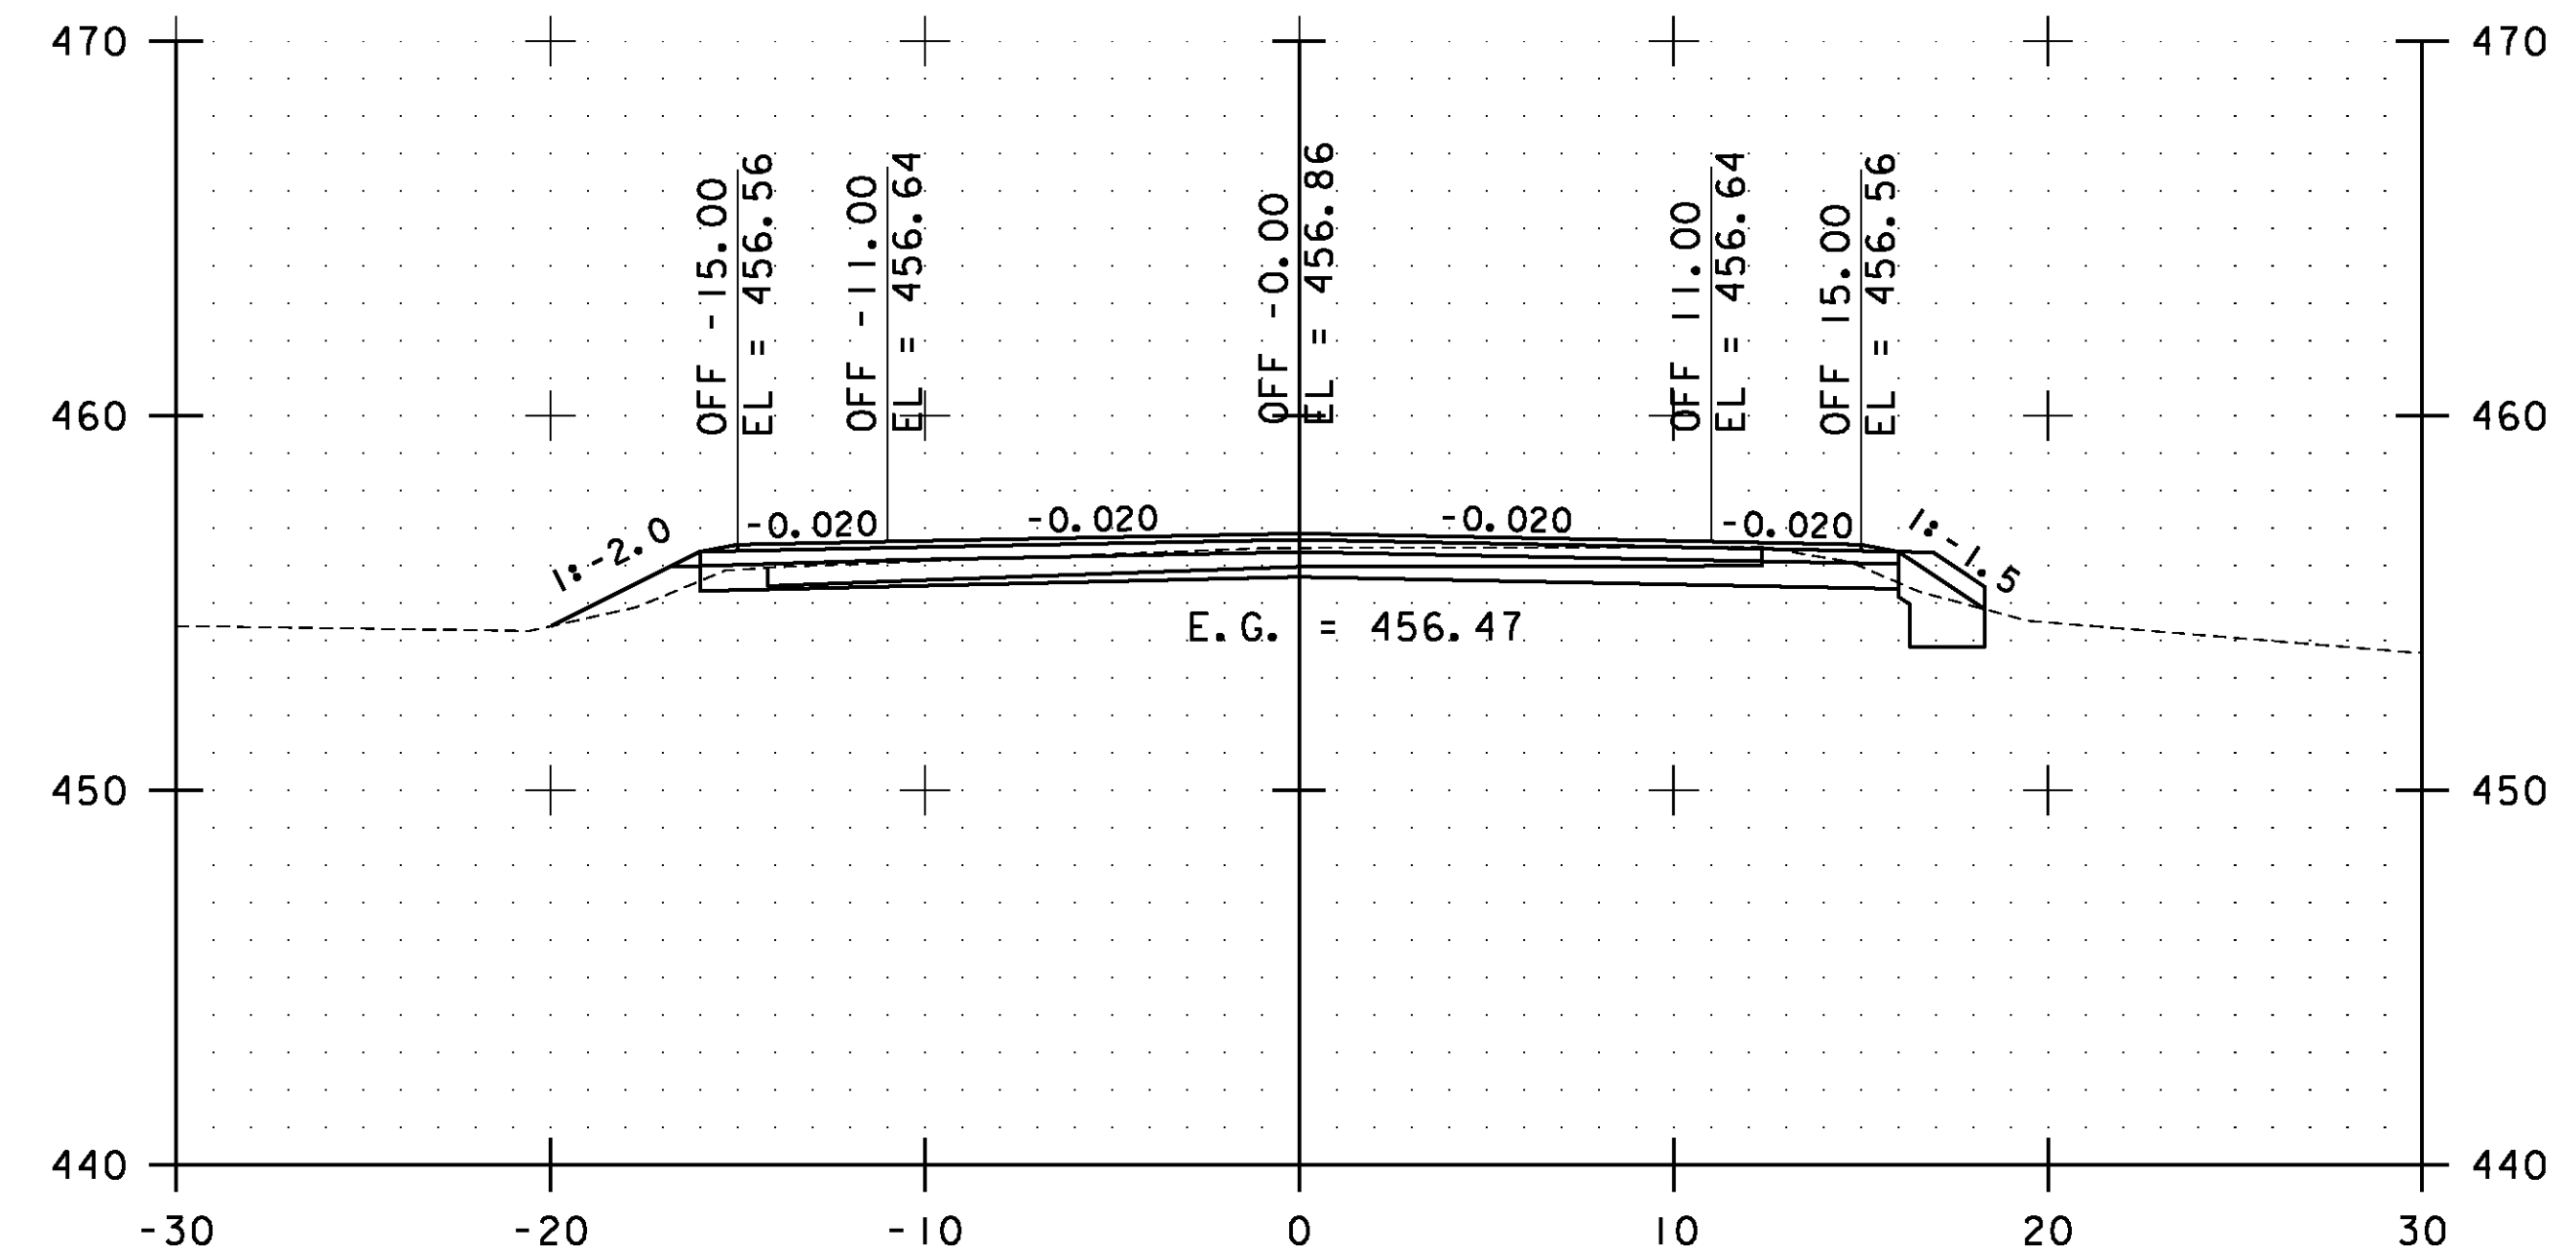

209+50.00

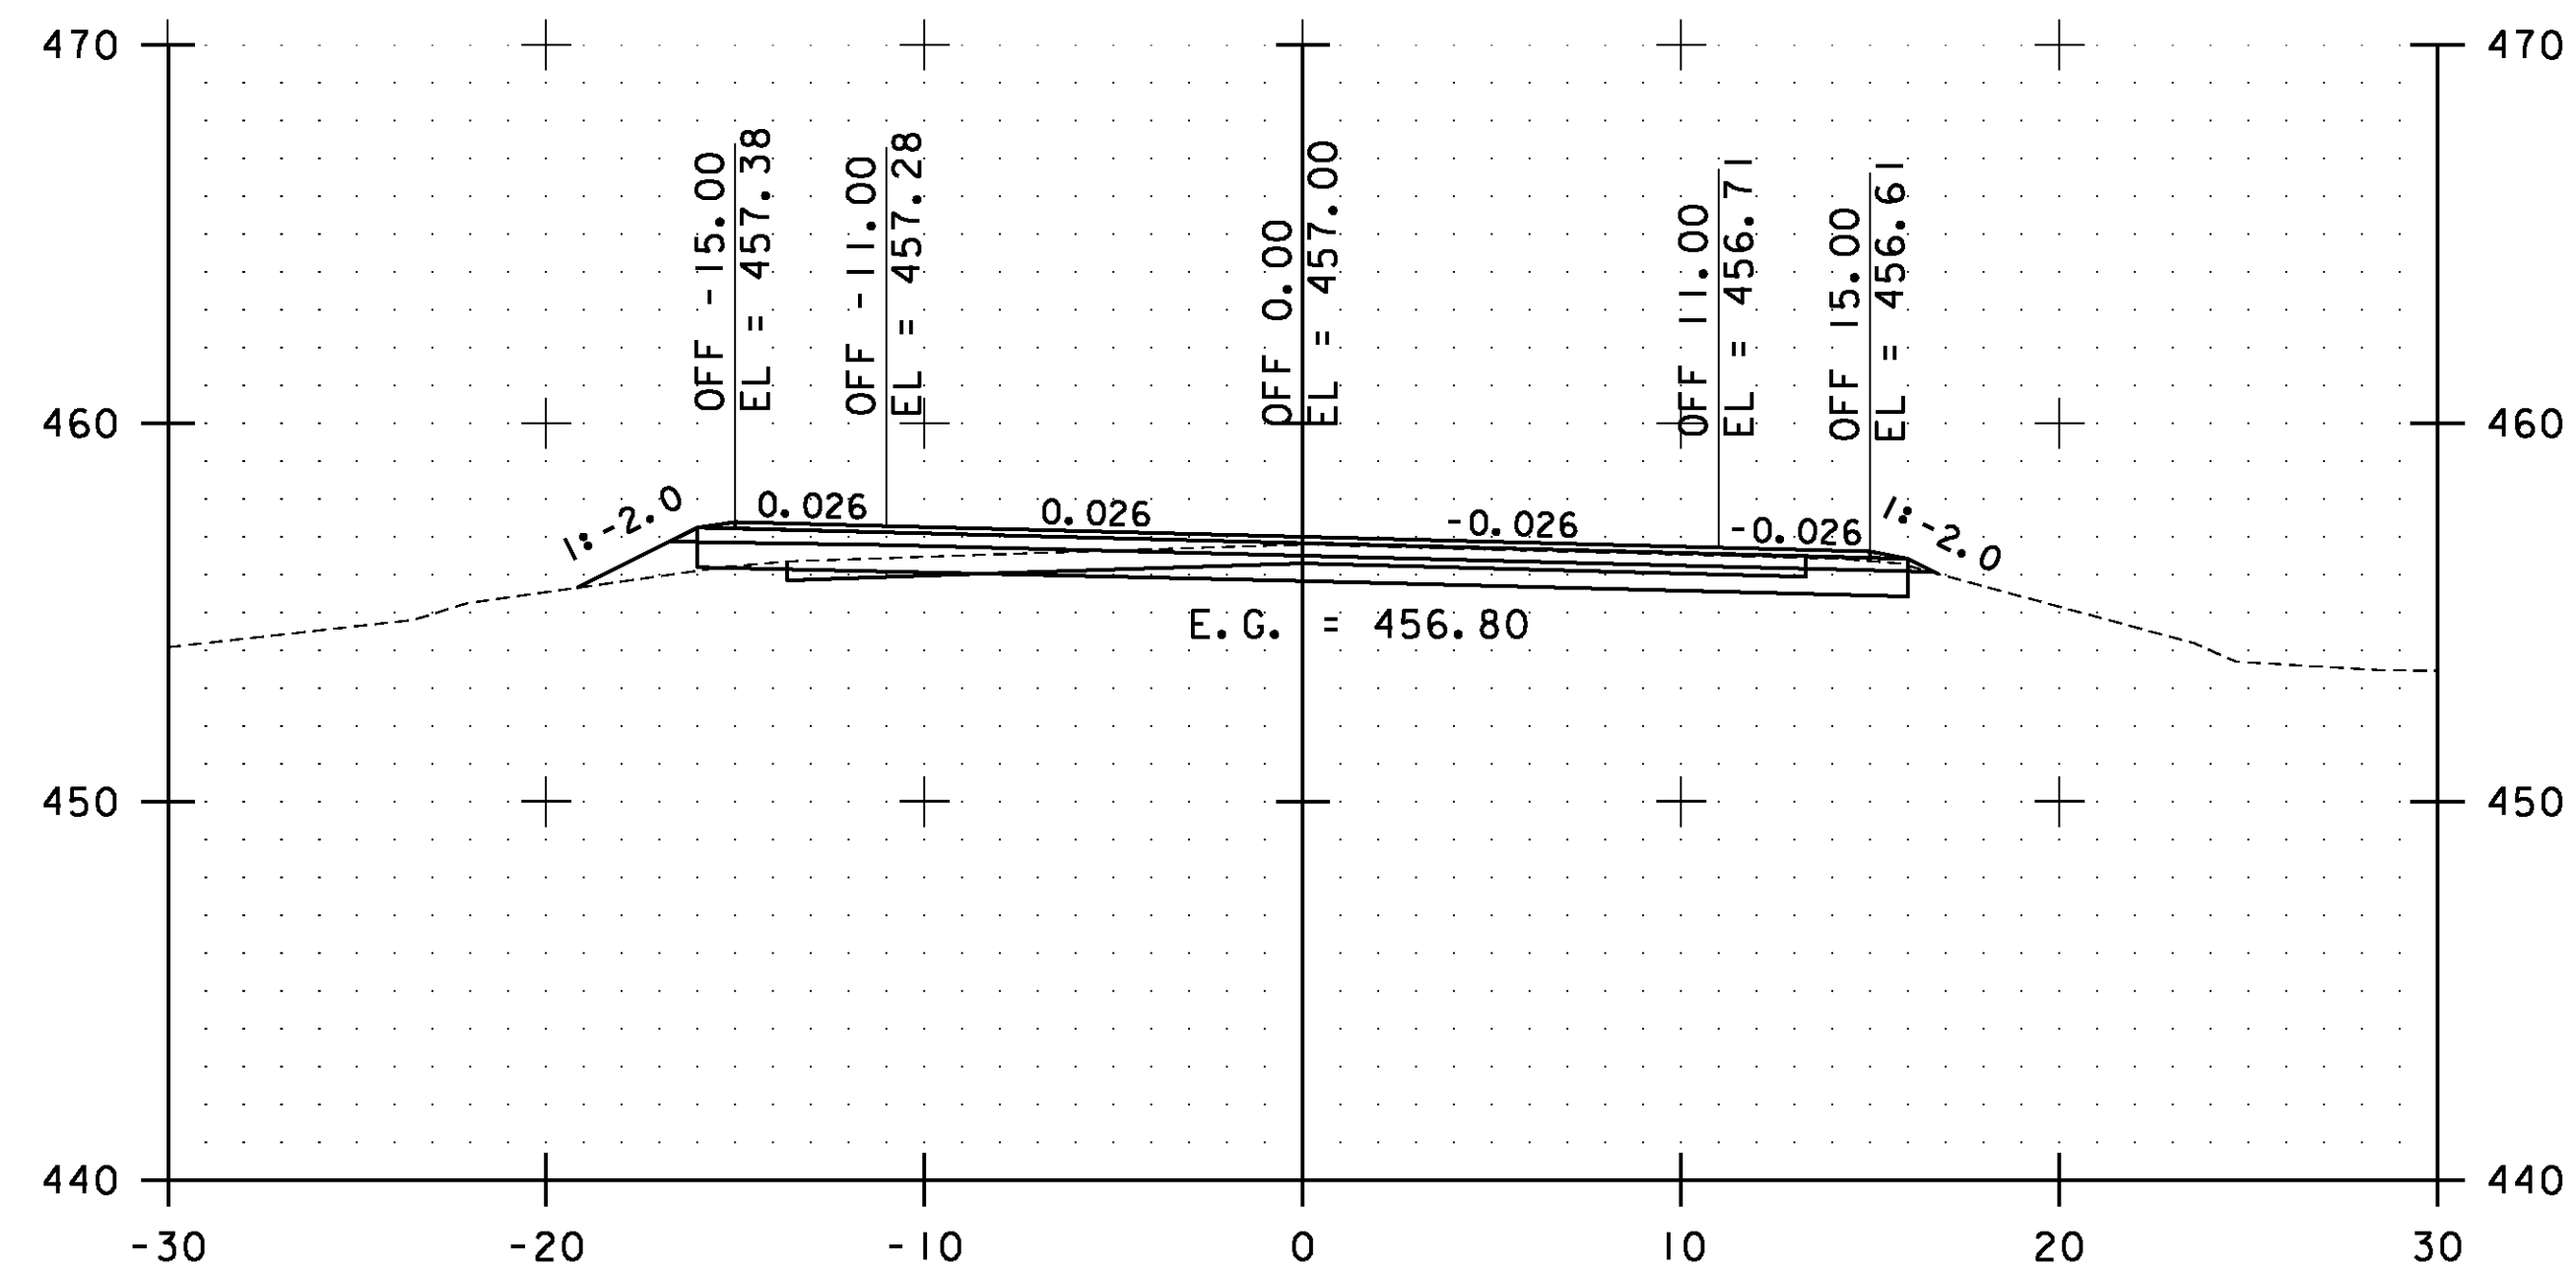

208+00.00

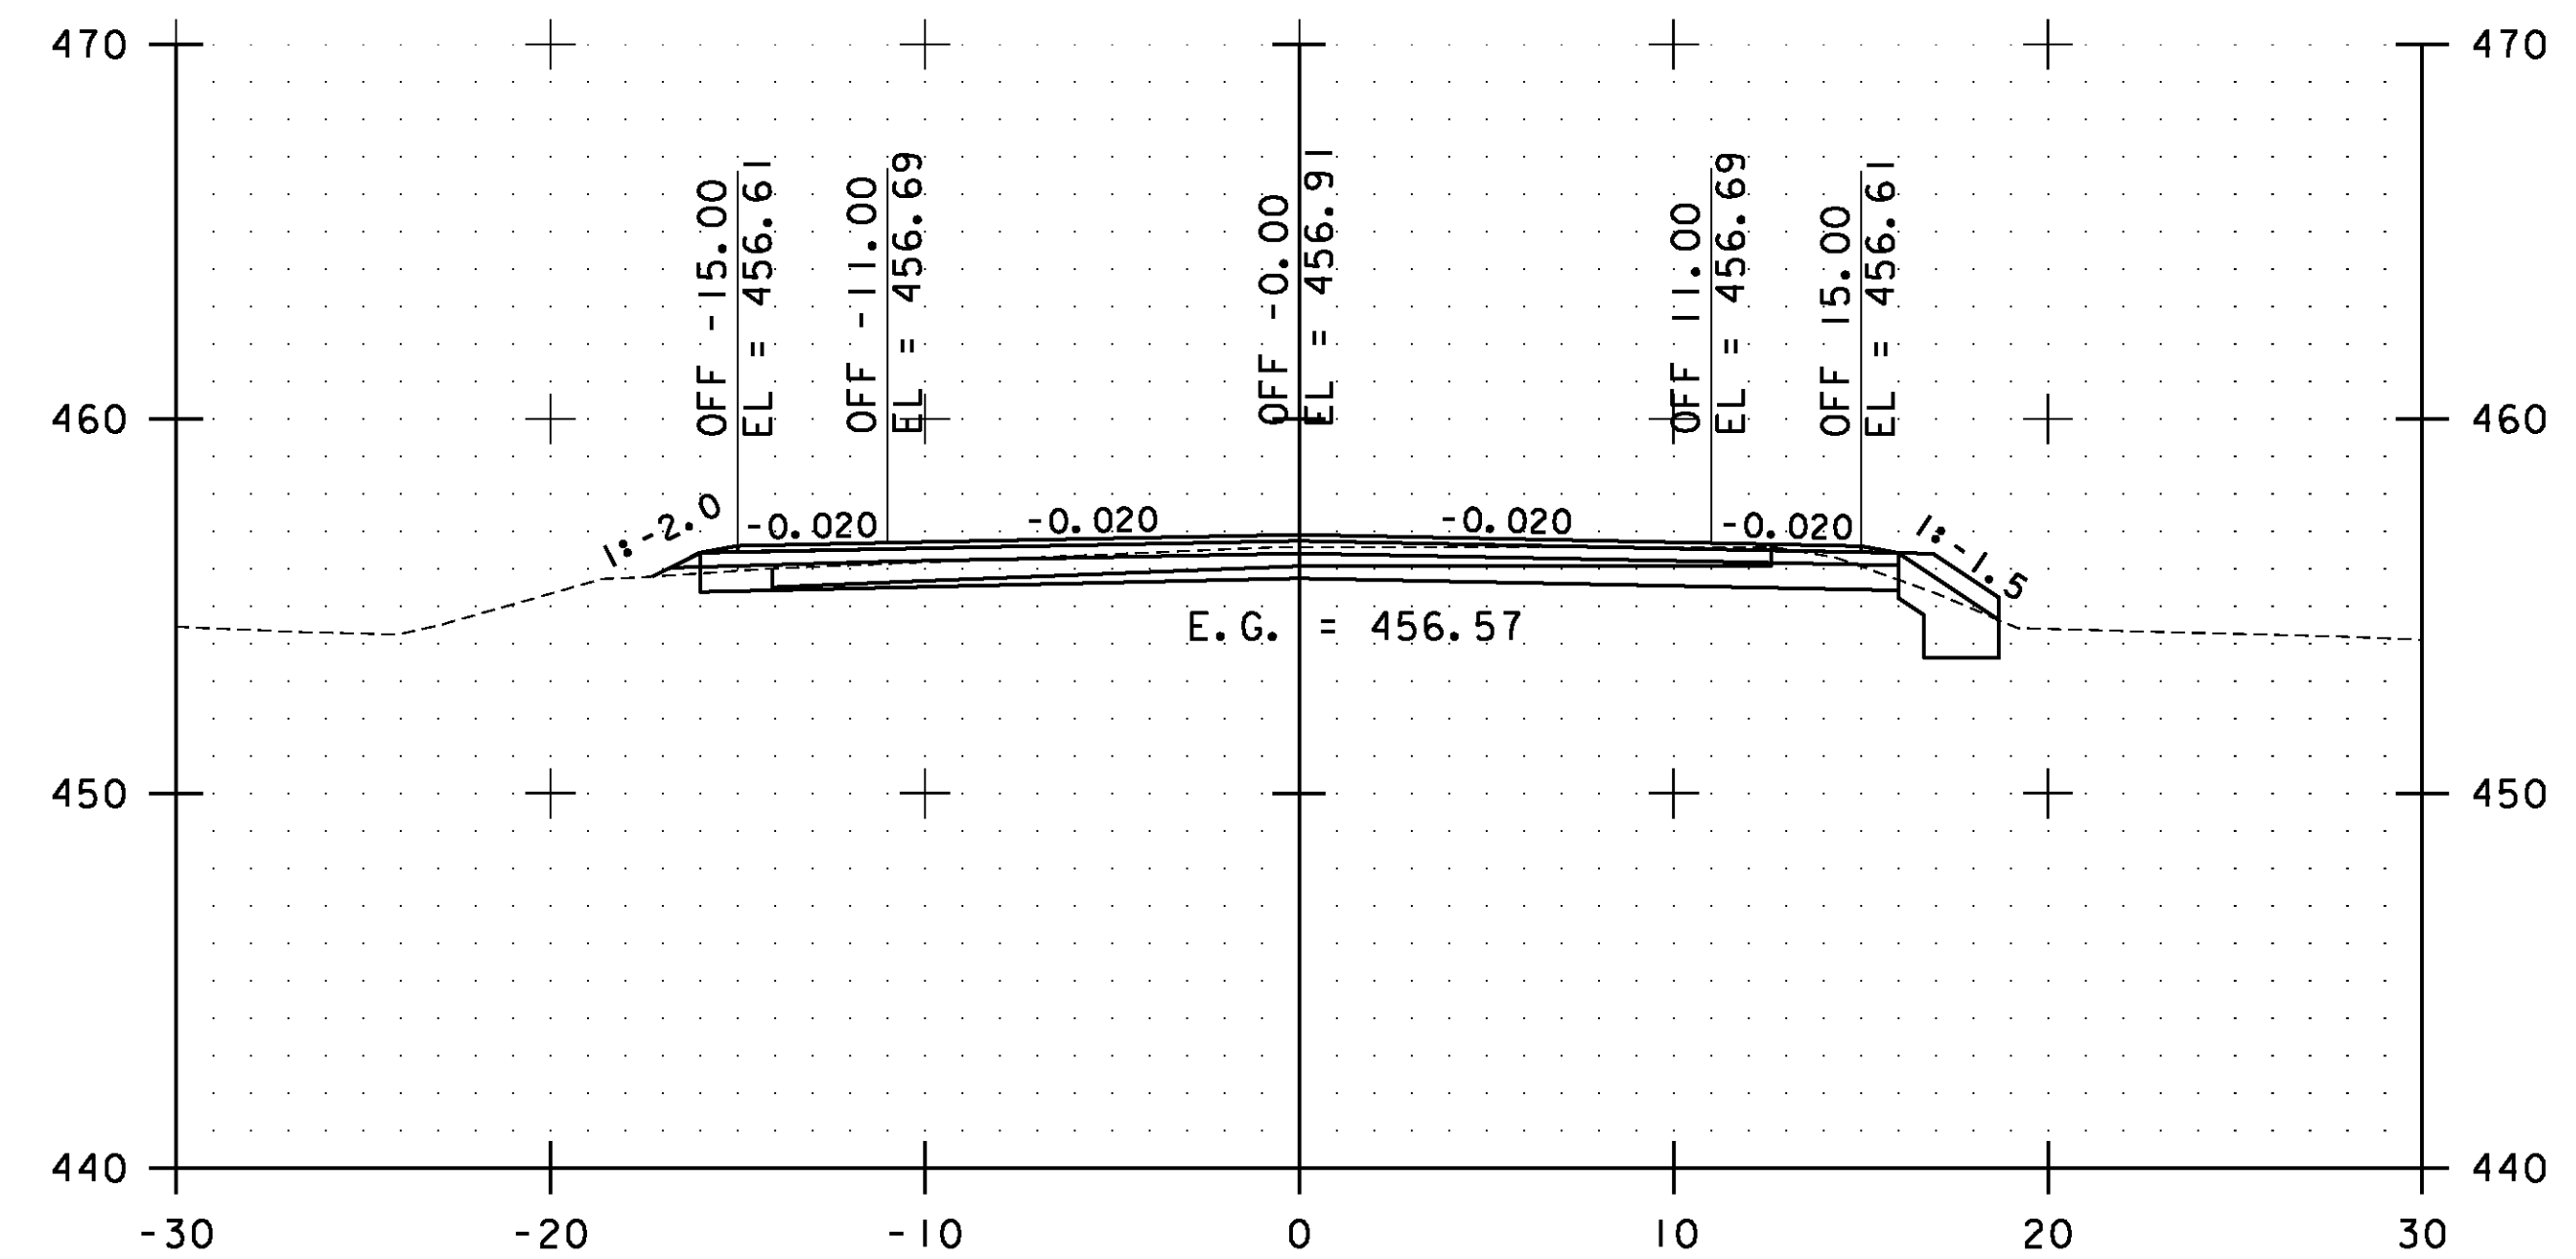

209+00.00

STA. 208+00.00 TO STA. 209+50.00



**ESSEX
CROSS
SECTIONS
SHEET #99**

PROJECT NAME: ESSEX-WESTFORD
PROJECT NUMBER: STP 2912(I)

FILE NAME: p10c226.dgn
PROJECT LEADER: JLL
DESIGNED BY: STANTEC
IPARM FILE: p10c226xs099.i

PLOT DATE: 2/20/2013
DRAWN BY: STANTEC
CHECKED BY: STANTEC
SHEET 190 OF 239