




212+50.00

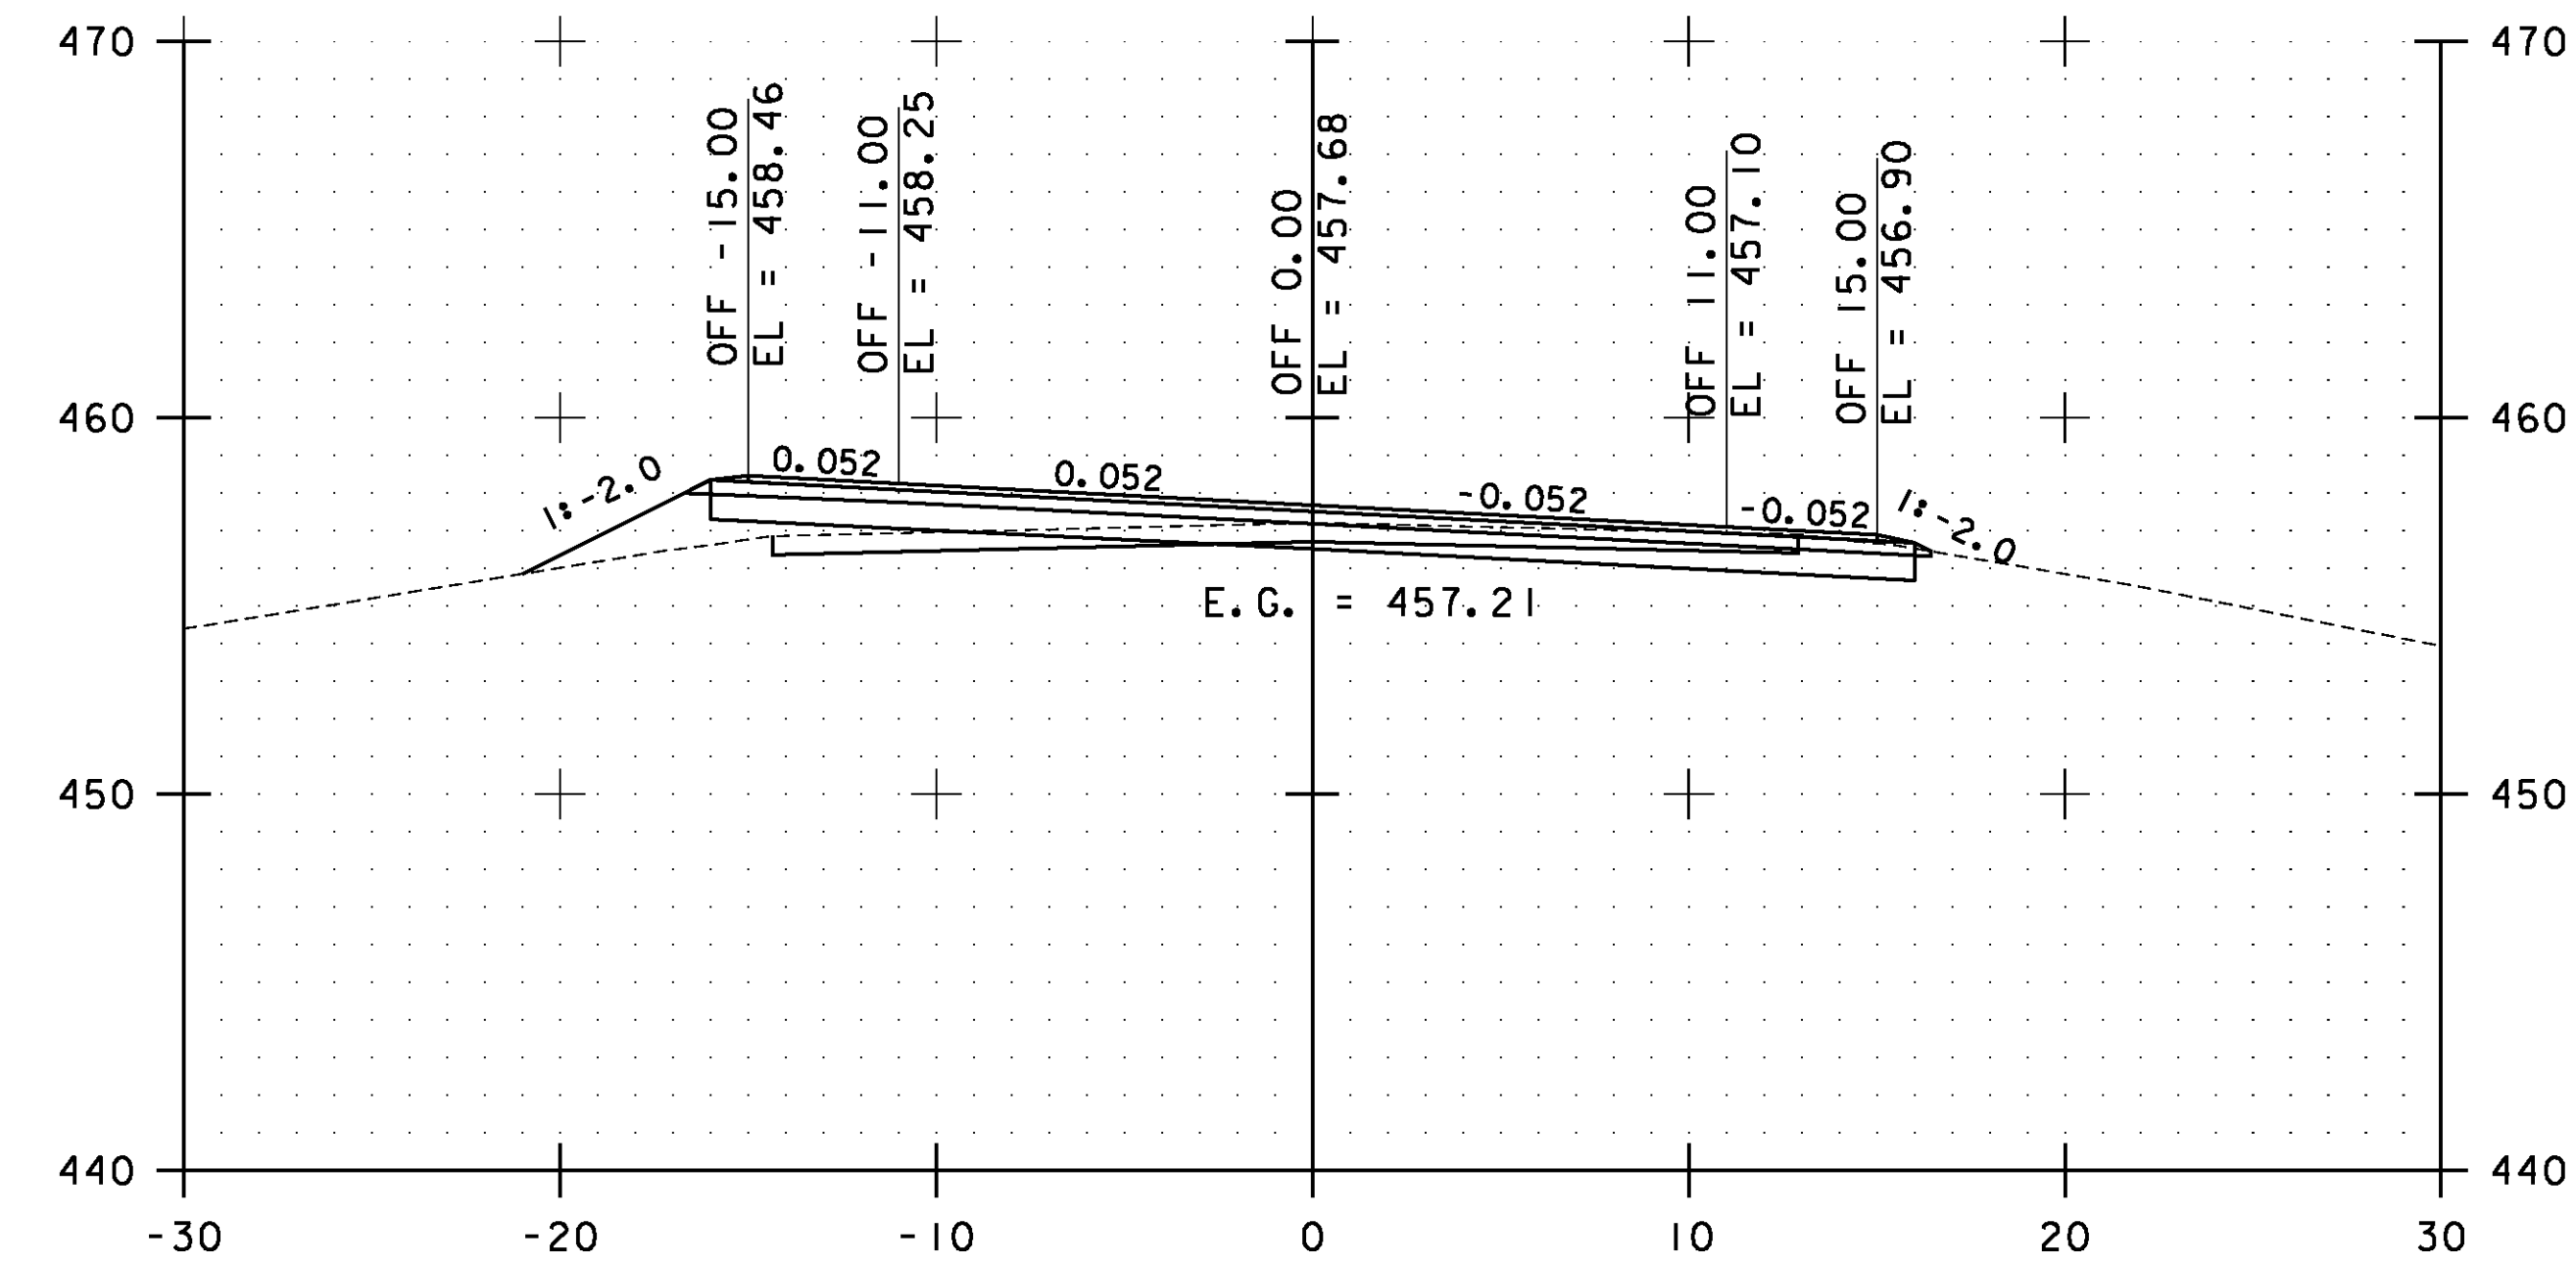

213+50.00

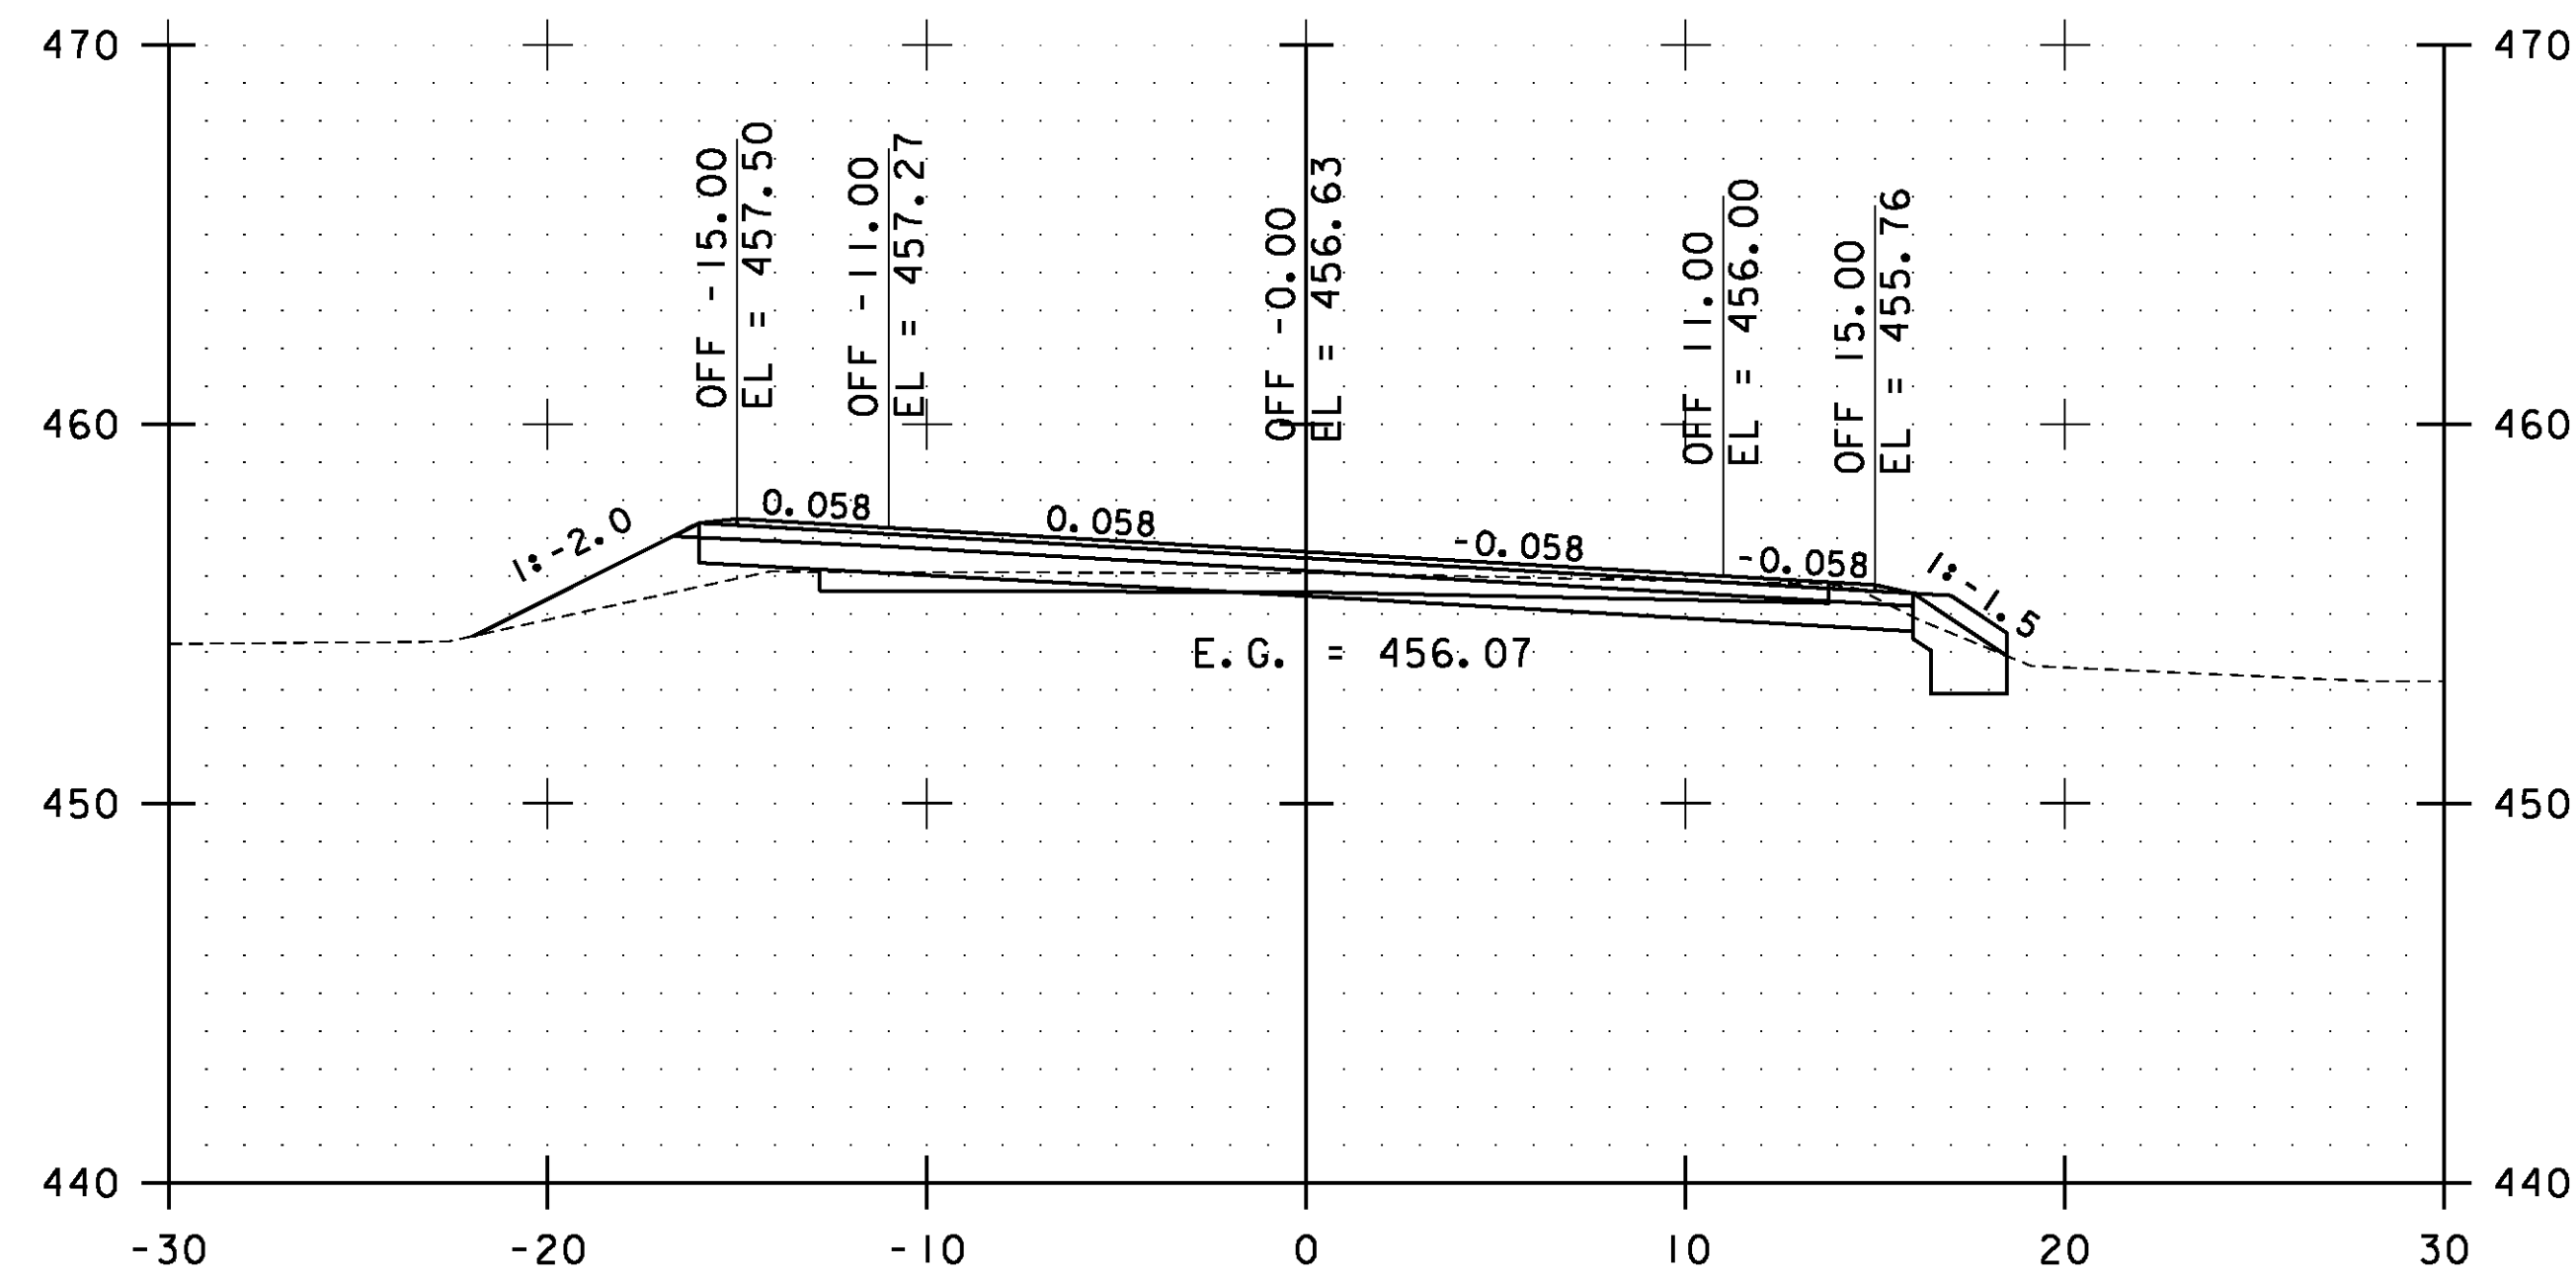


212+00.00

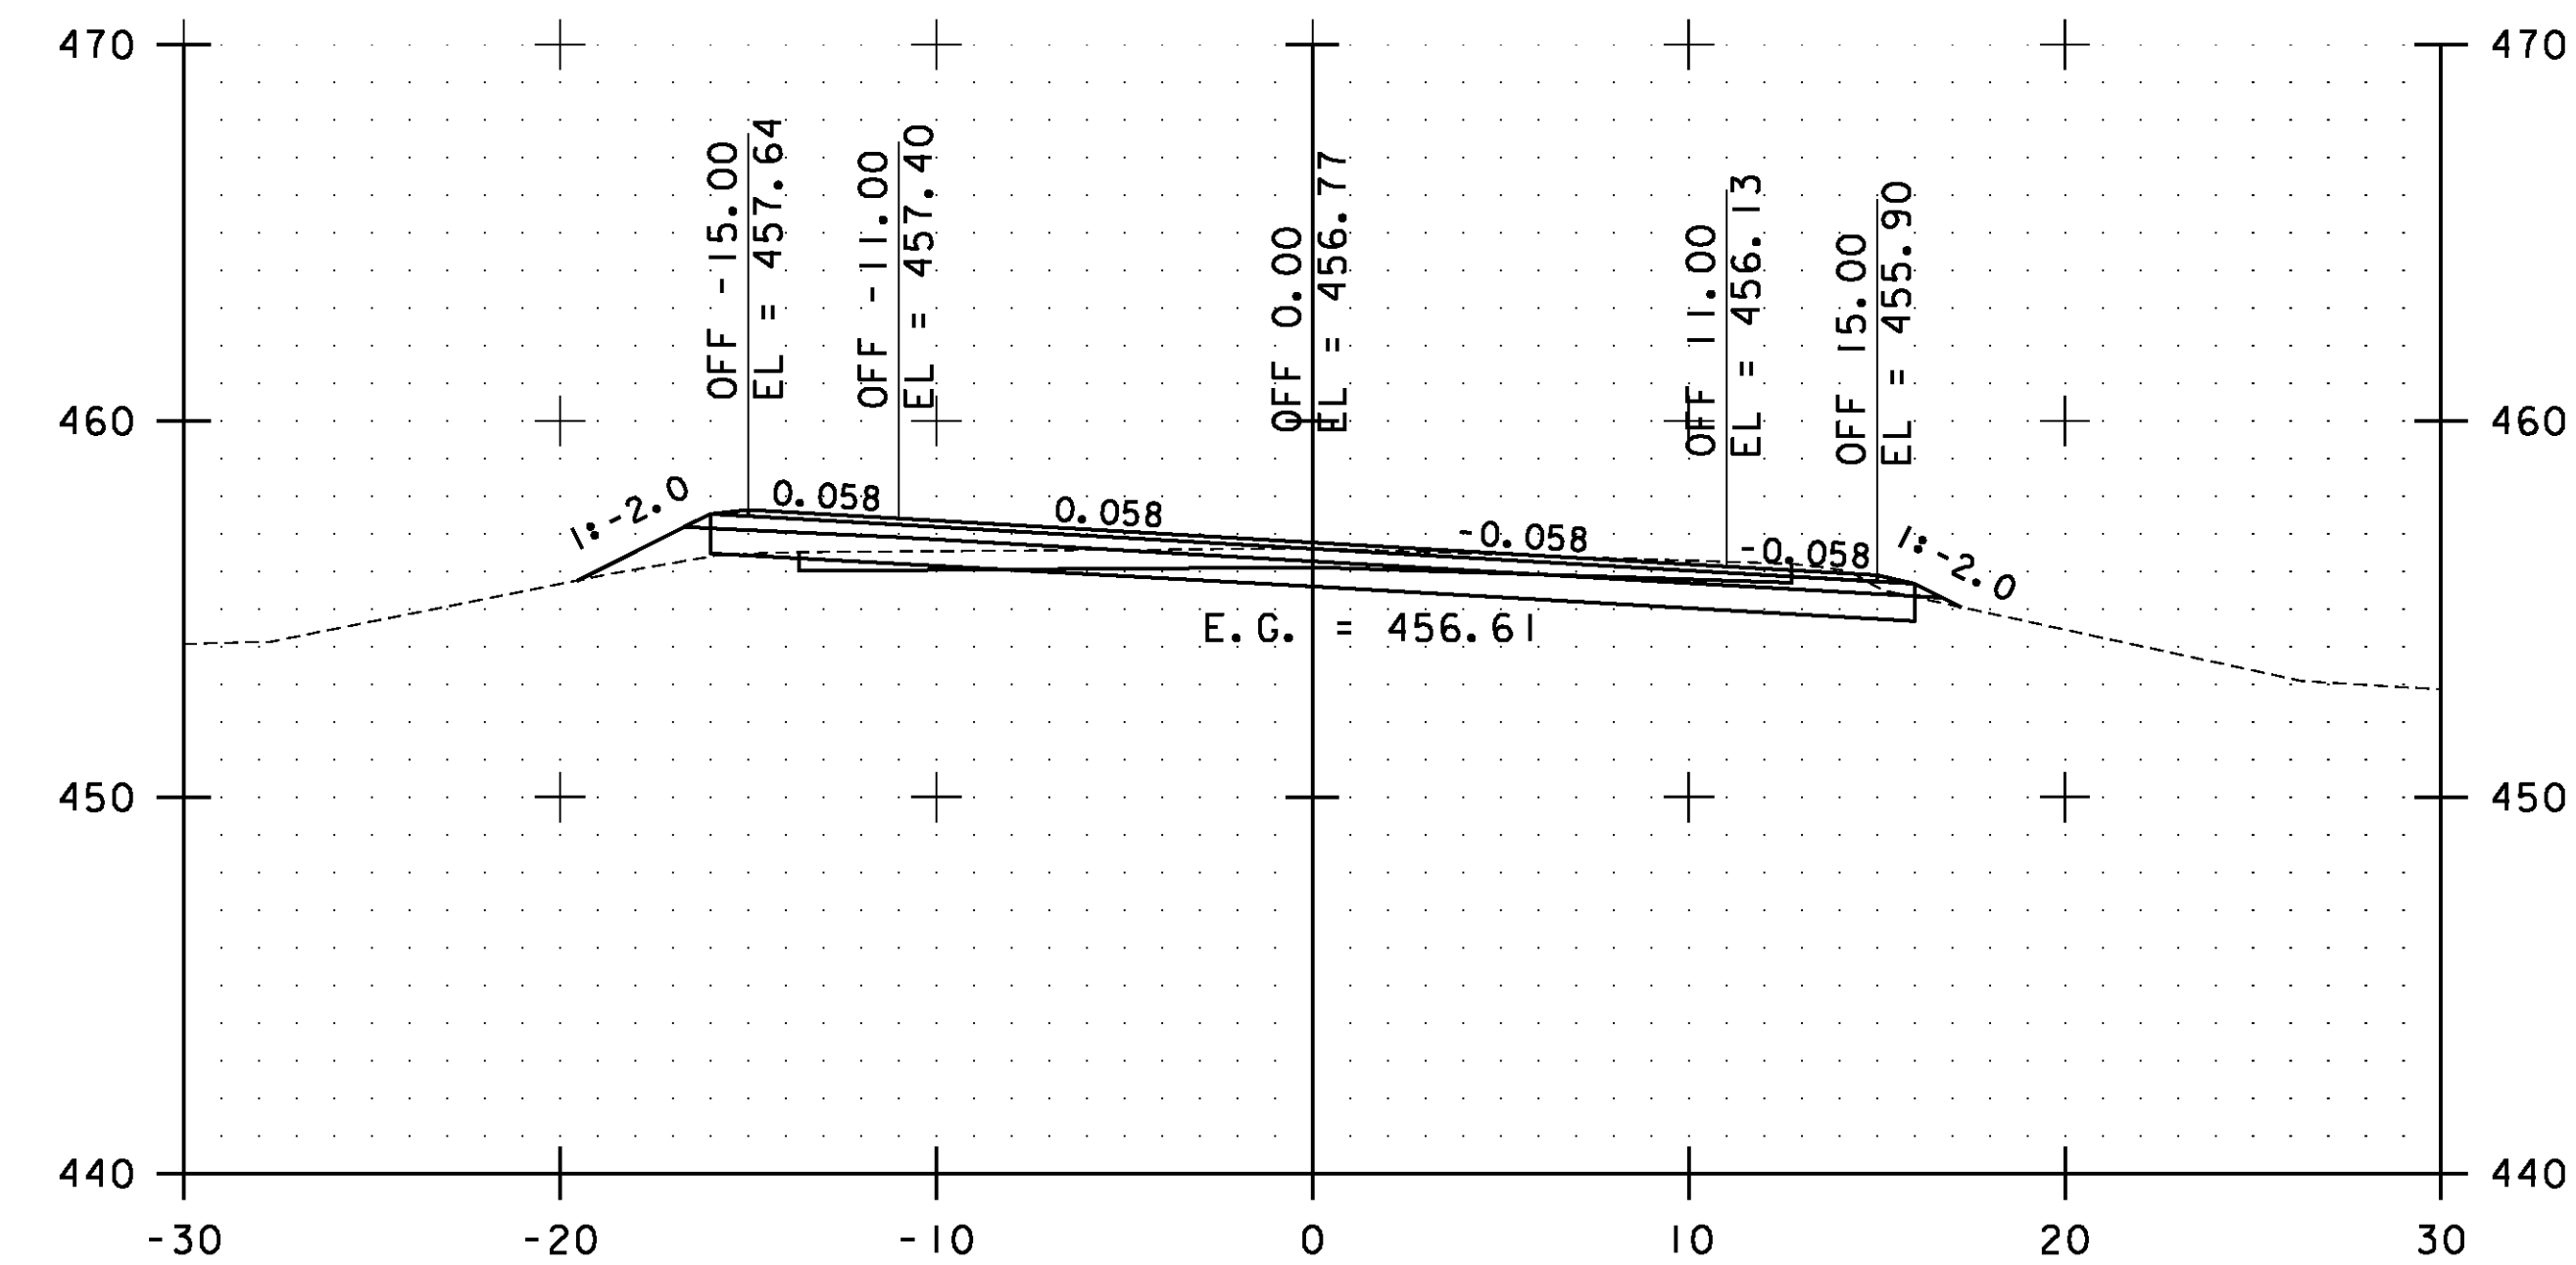

213+00.00

STA. 212+00.00 TO STA. 213+50.00

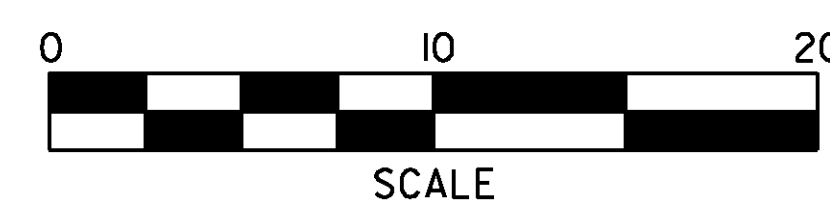

**ESSEX
CROSS
SECTIONS
SHEET #101**

PROJECT NAME: ESSEX-WESTFORD	PLOT DATE: 2/20/2013
PROJECT NUMBER: STP 2912(I)	DRAWN BY: STANTEC
FILE NAME: p10c226.dgn	CHECKED BY: STANTEC
PROJECT LEADER: JLL	SHEET 192 OF 239
DESIGNED BY: STANTEC	
IPARM FILE: p10c226xs101.i	