




220+50.00

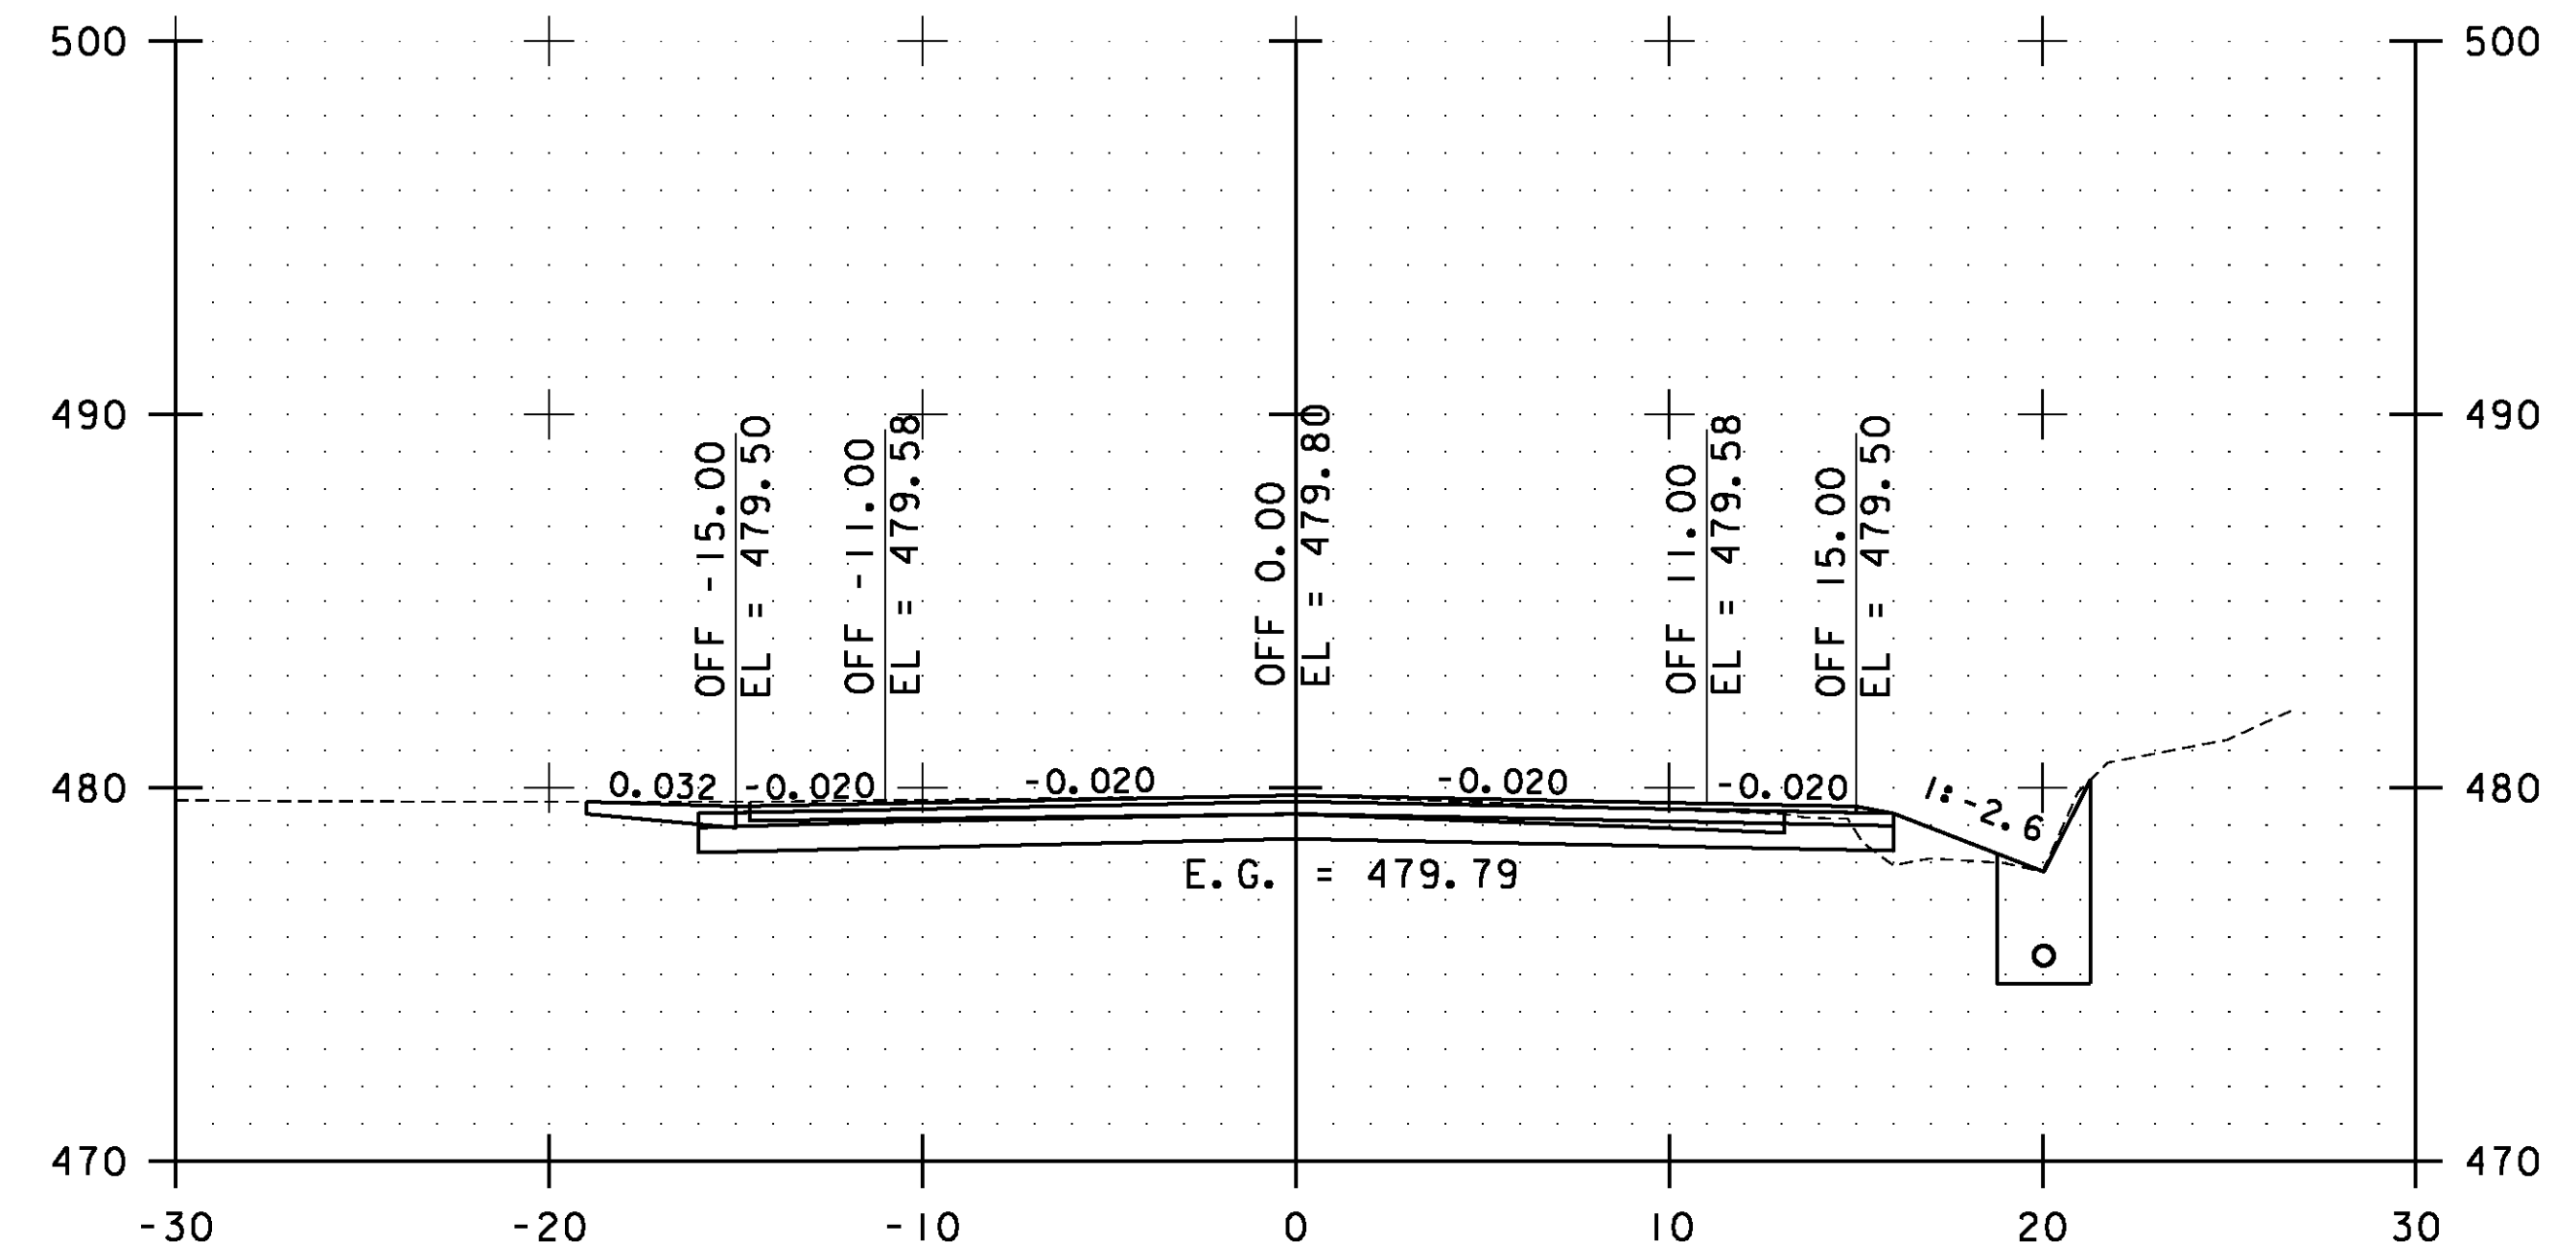

221+50.00

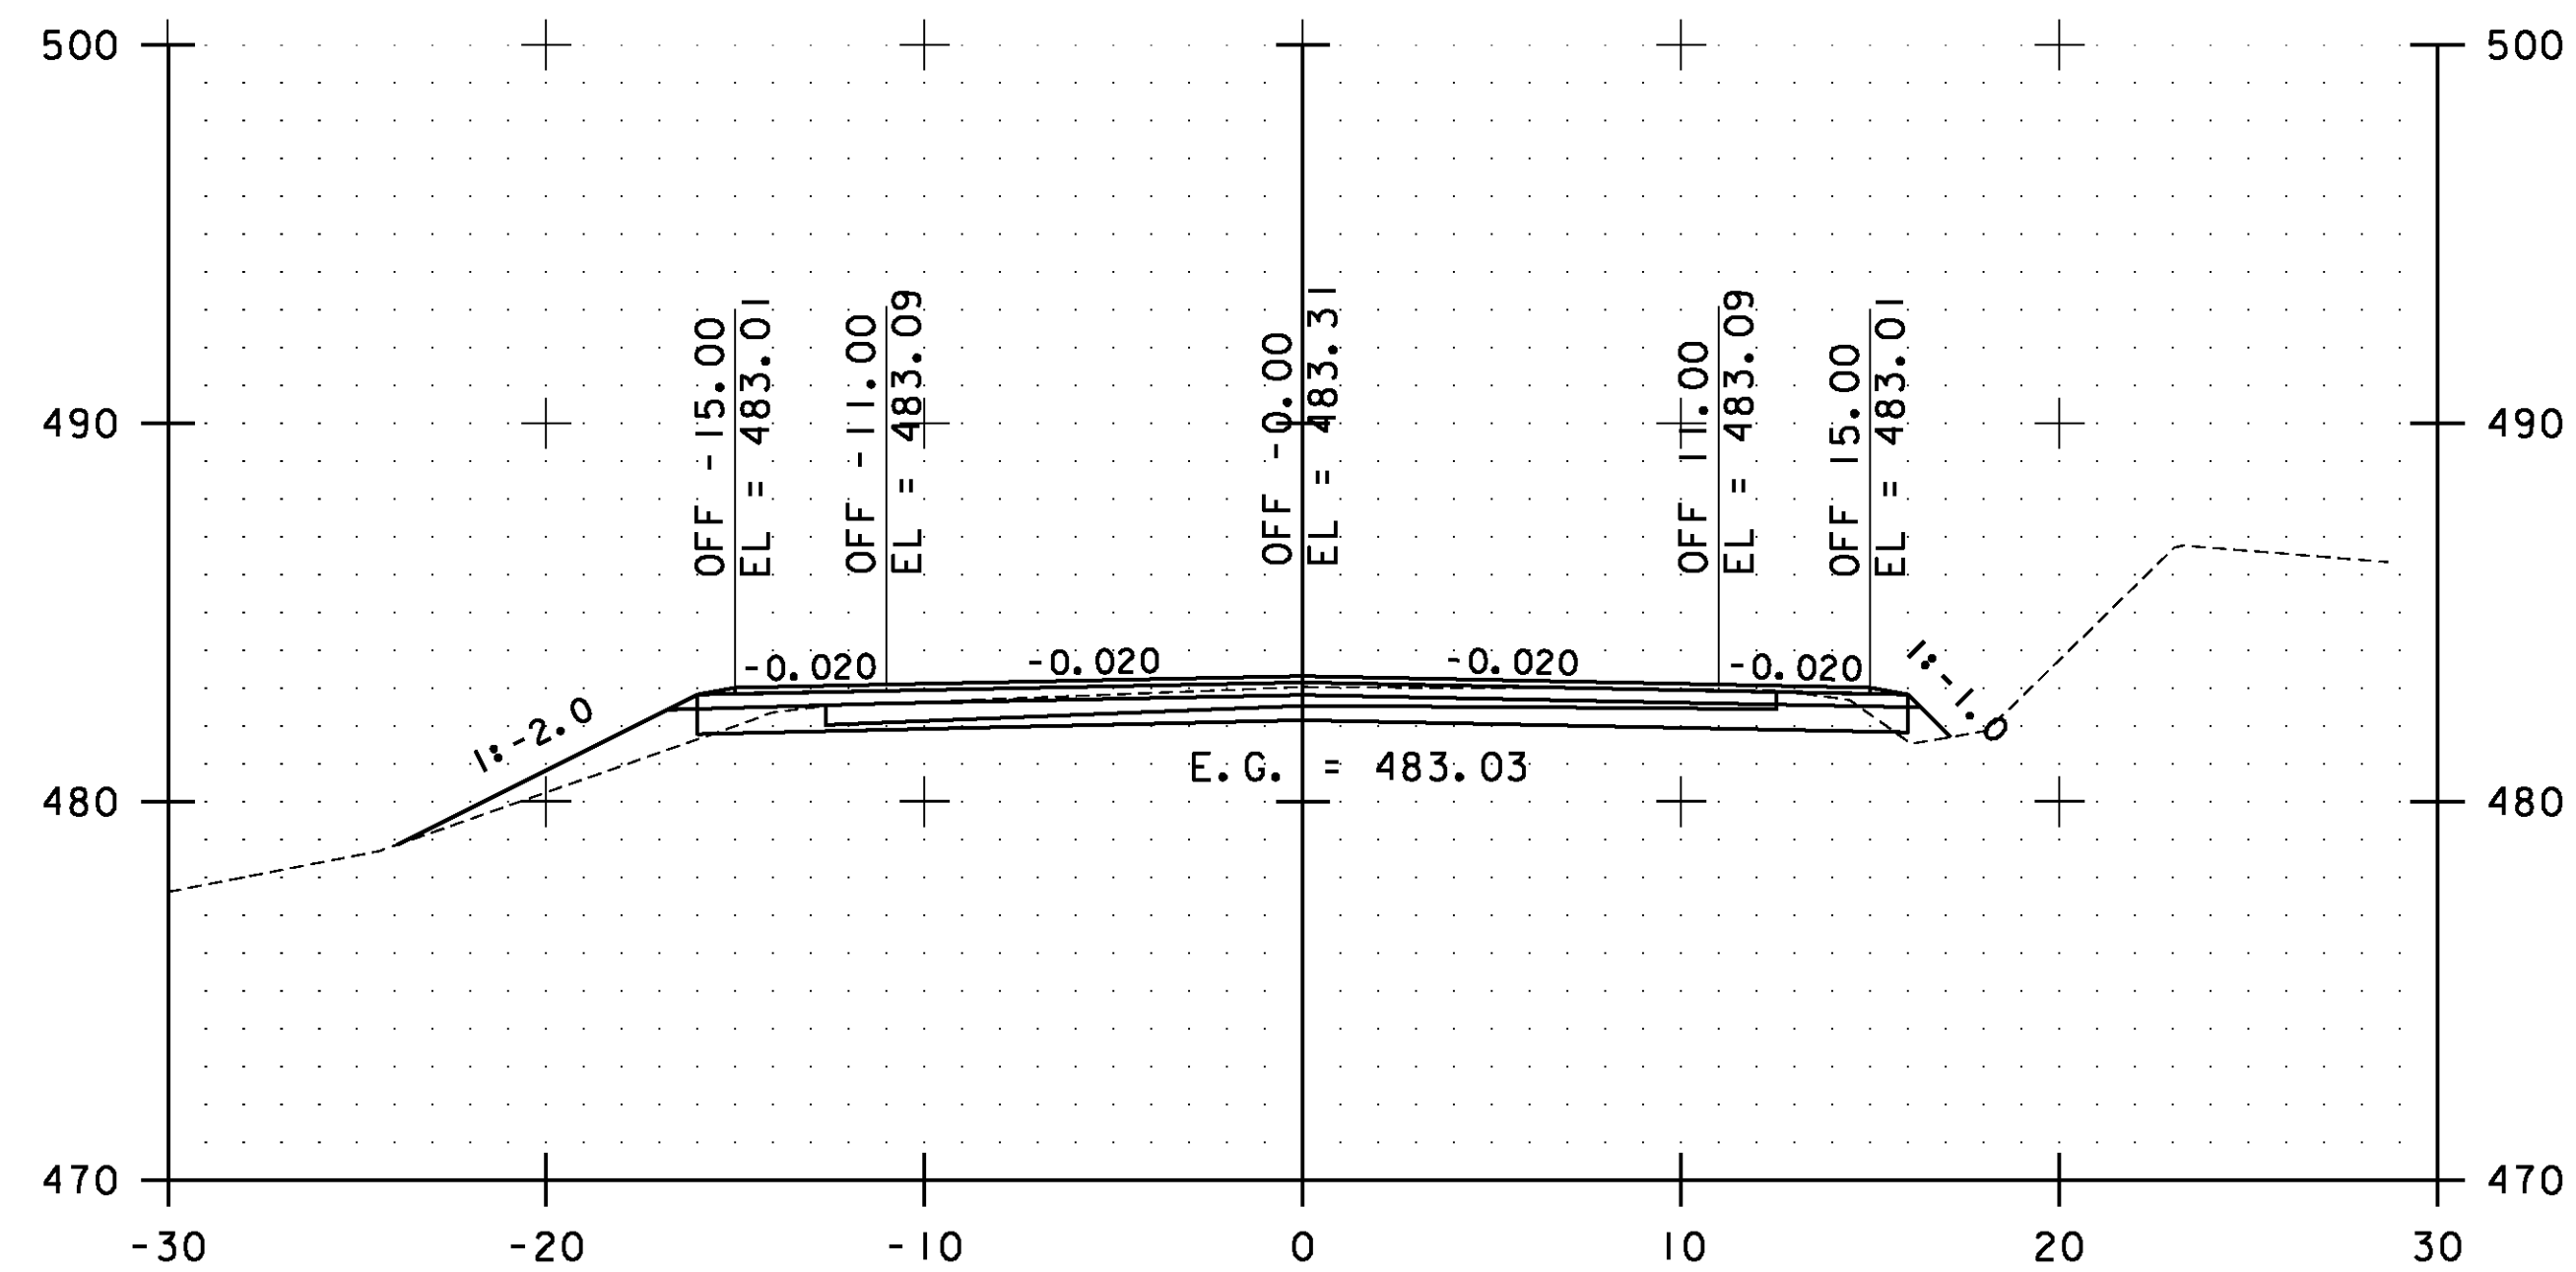

220+00.00

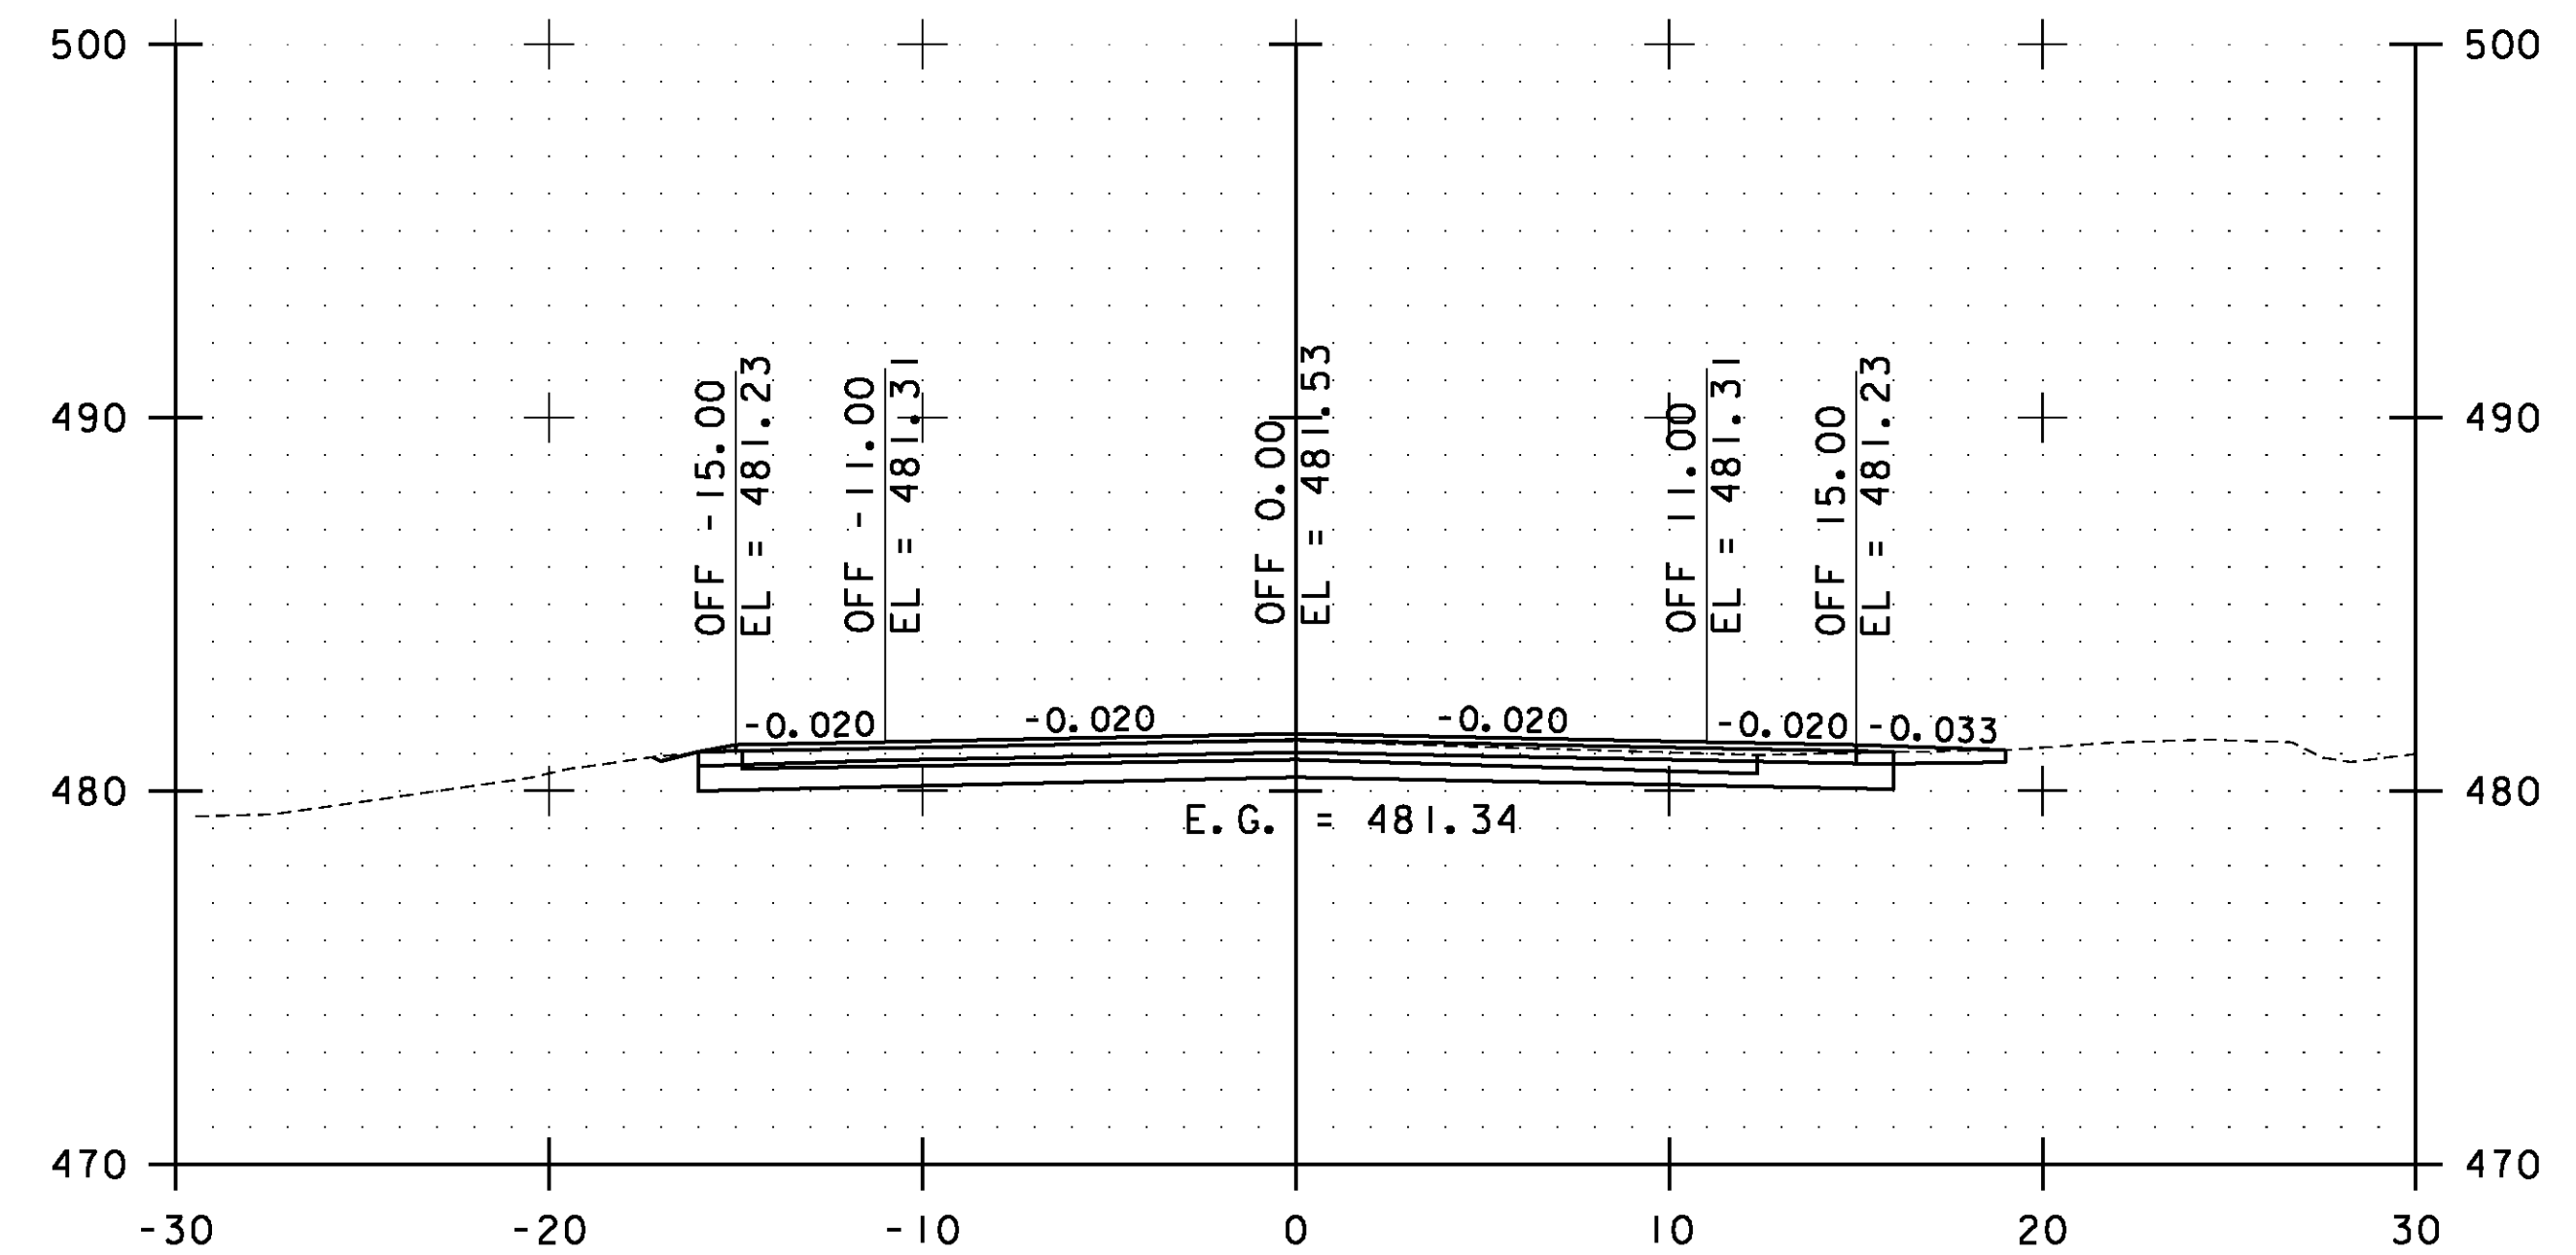

221+00.00

STA. 220+00.00 TO STA. 221+50.00



**ESSEX
CROSS
SECTIONS
SHEET #105**

PROJECT NAME: ESSEX-WESTFORD
PROJECT NUMBER: STP 2912(I)

FILE NAME: p10c226.dgn
PROJECT LEADER: JLL
DESIGNED BY: STANTEC
IPARM FILE: p10c226xs105.i

PLOT DATE: 2/20/2013
DRAWN BY: STANTEC
CHECKED BY: STANTEC
SHEET 196 OF 239