


STA. 1+50.00 TO STA. 3+00.00

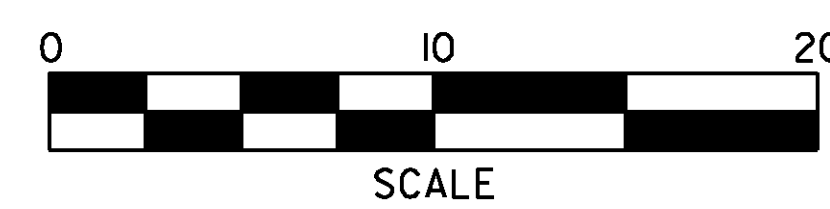

**WESTFORD
CROSS
SECTIONS
SHEET #1**

PROJECT NAME: ESSEX-WESTFORD	PLOT DATE: 2/20/2013
PROJECT NUMBER: STP 2912(I)	DRAWN BY: STANTEC
FILE NAME: p10c226.dgn	CHECKED BY: STANTEC
DESIGNED BY: STANTEC	SHEET 203 OF 239
IPARM FILE: p10c226xs112.i	