


STA. 3+50.00 TO STA. 5+00.00

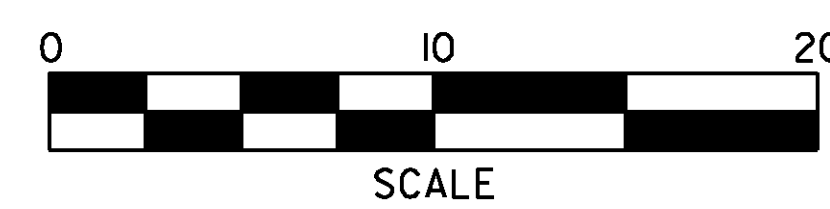

**WESTFORD  
CROSS  
SECTIONS  
SHEET #2**

PROJECT NAME: ESSEX-WESTFORD	PLOT DATE: 2/20/2013
PROJECT NUMBER: STP 2912(I)	DRAWN BY: STANTEC
FILE NAME: p10c226.dgn	CHECKED BY: STANTEC
DESIGNED BY: STANTEC	SHEET 204 OF 239
IPARM FILE: p10c226xs113.i	