




23+50.00

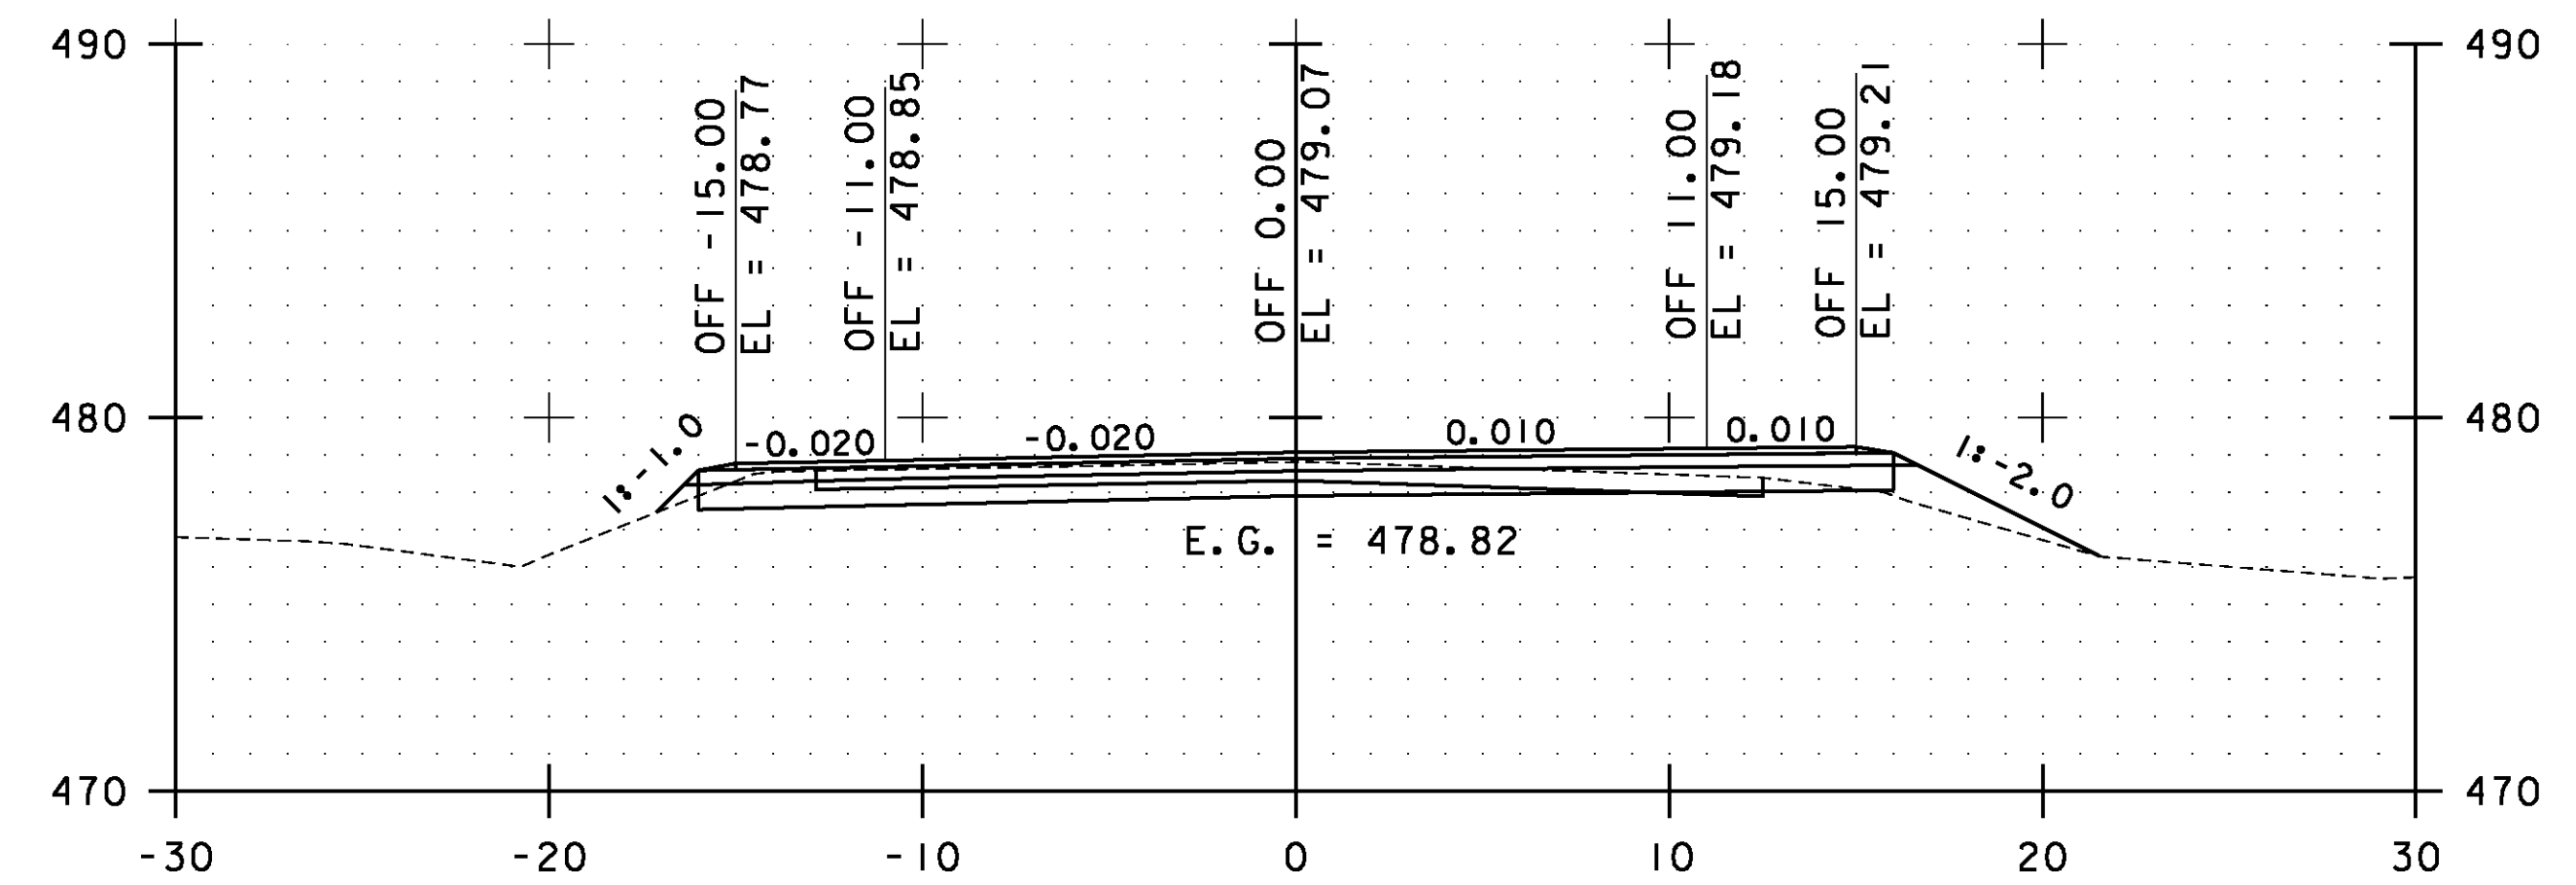

24+50.00

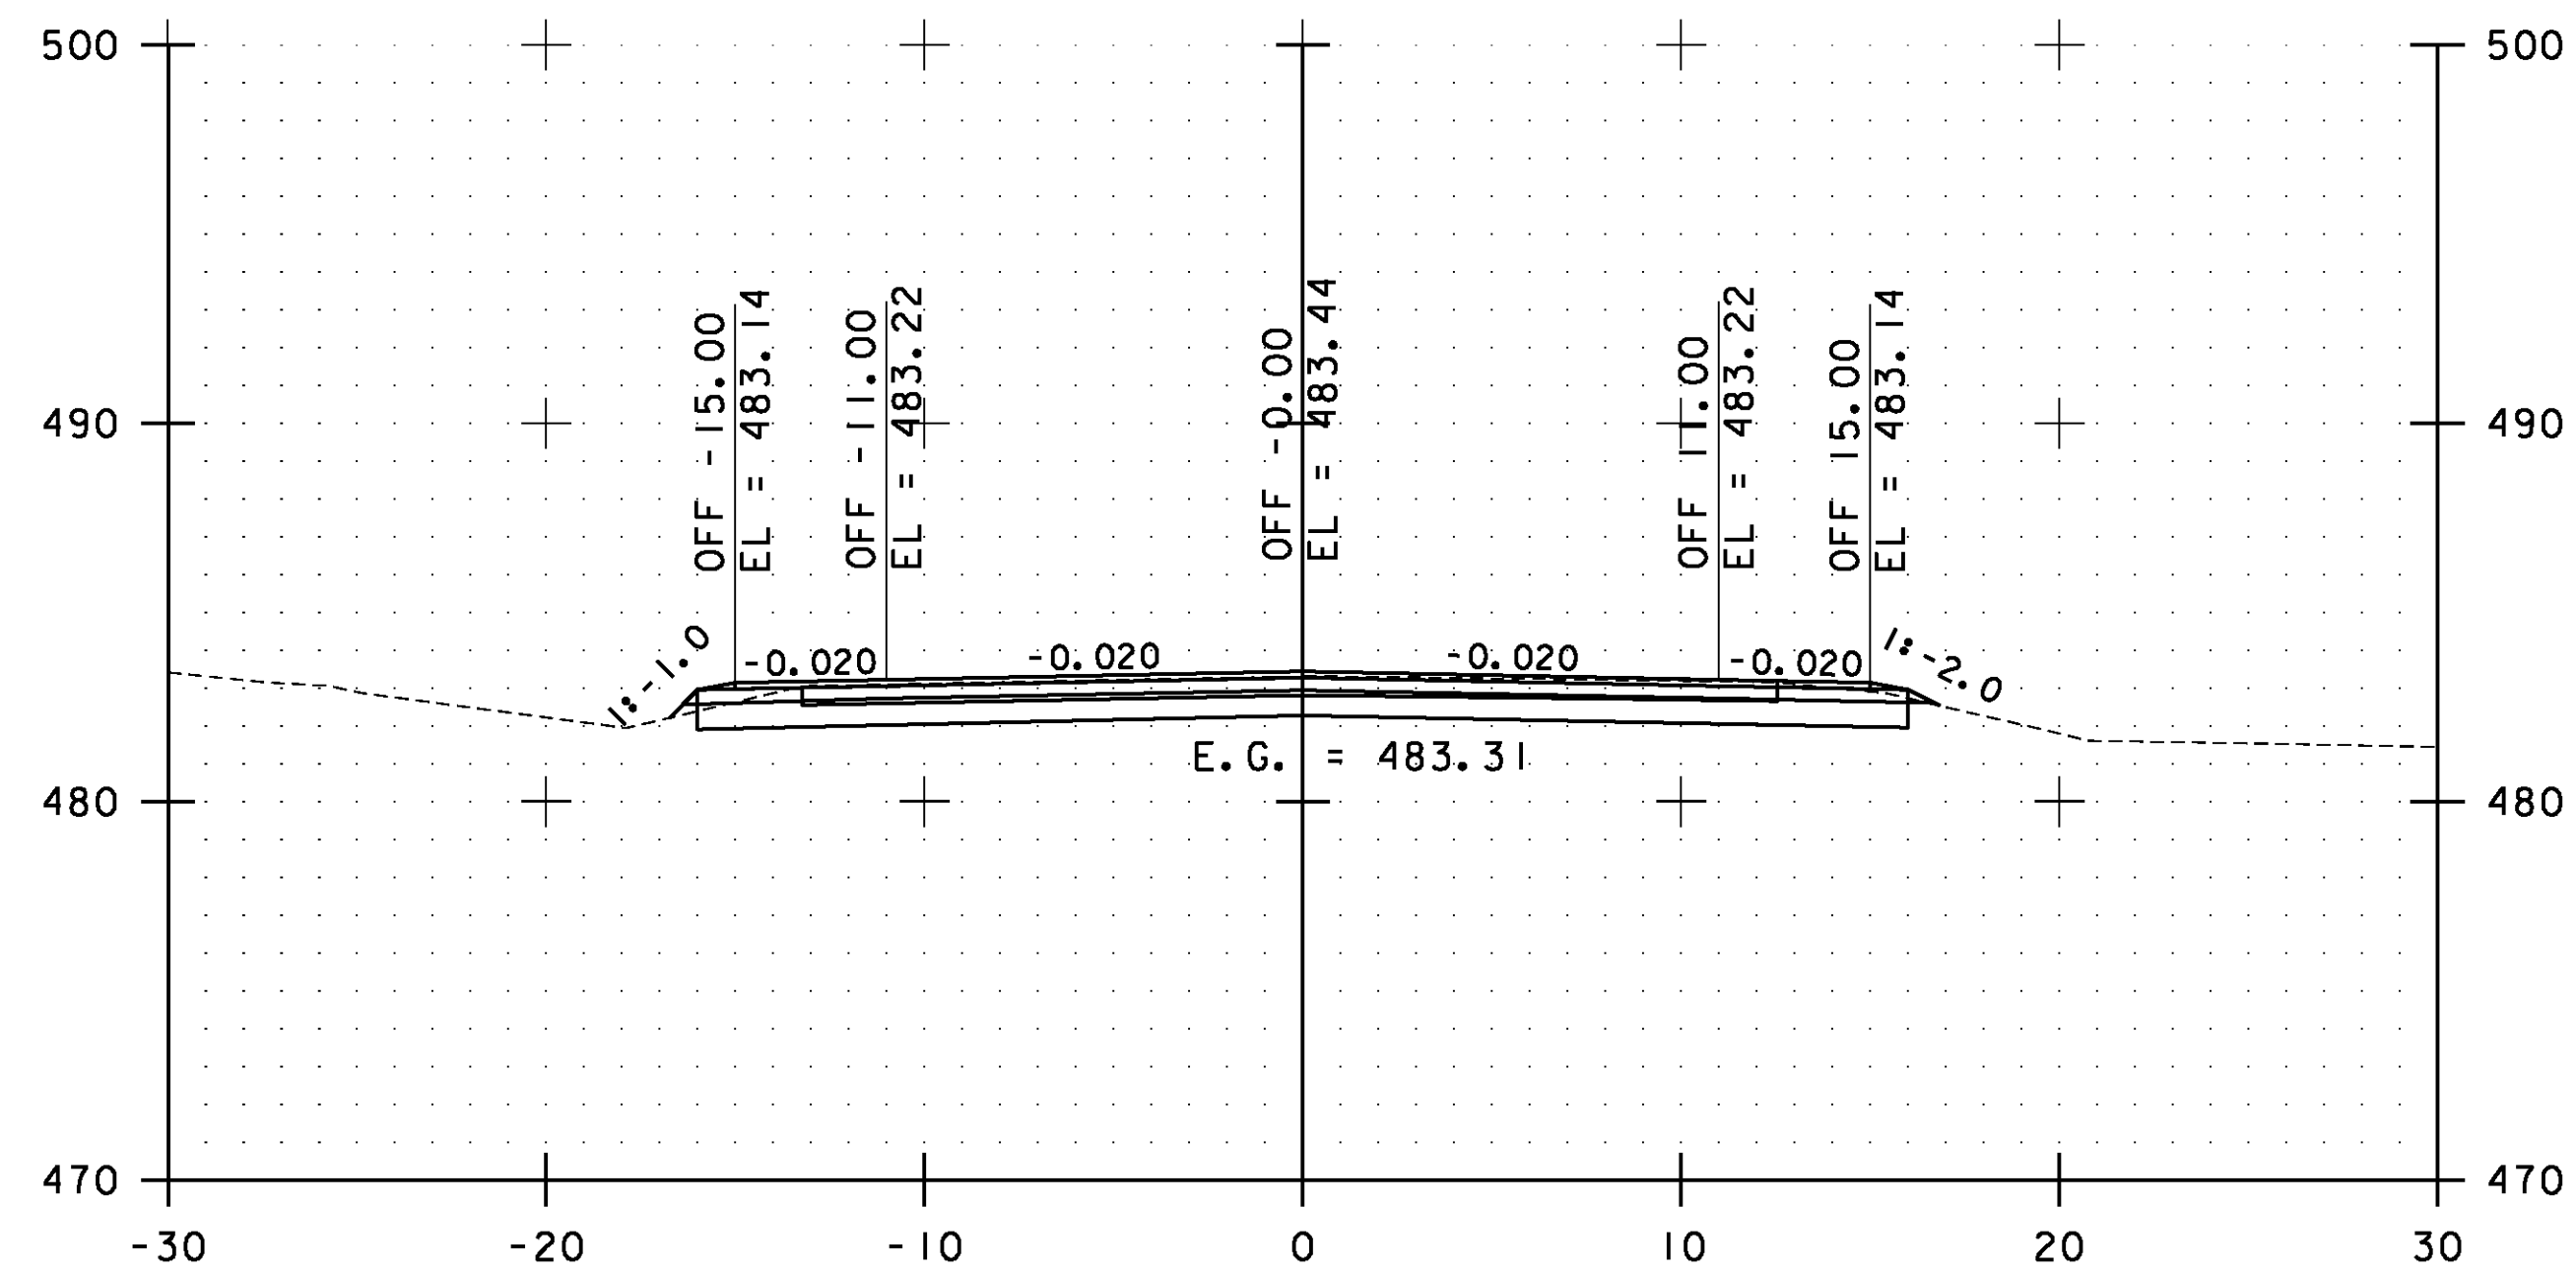


23+00.00

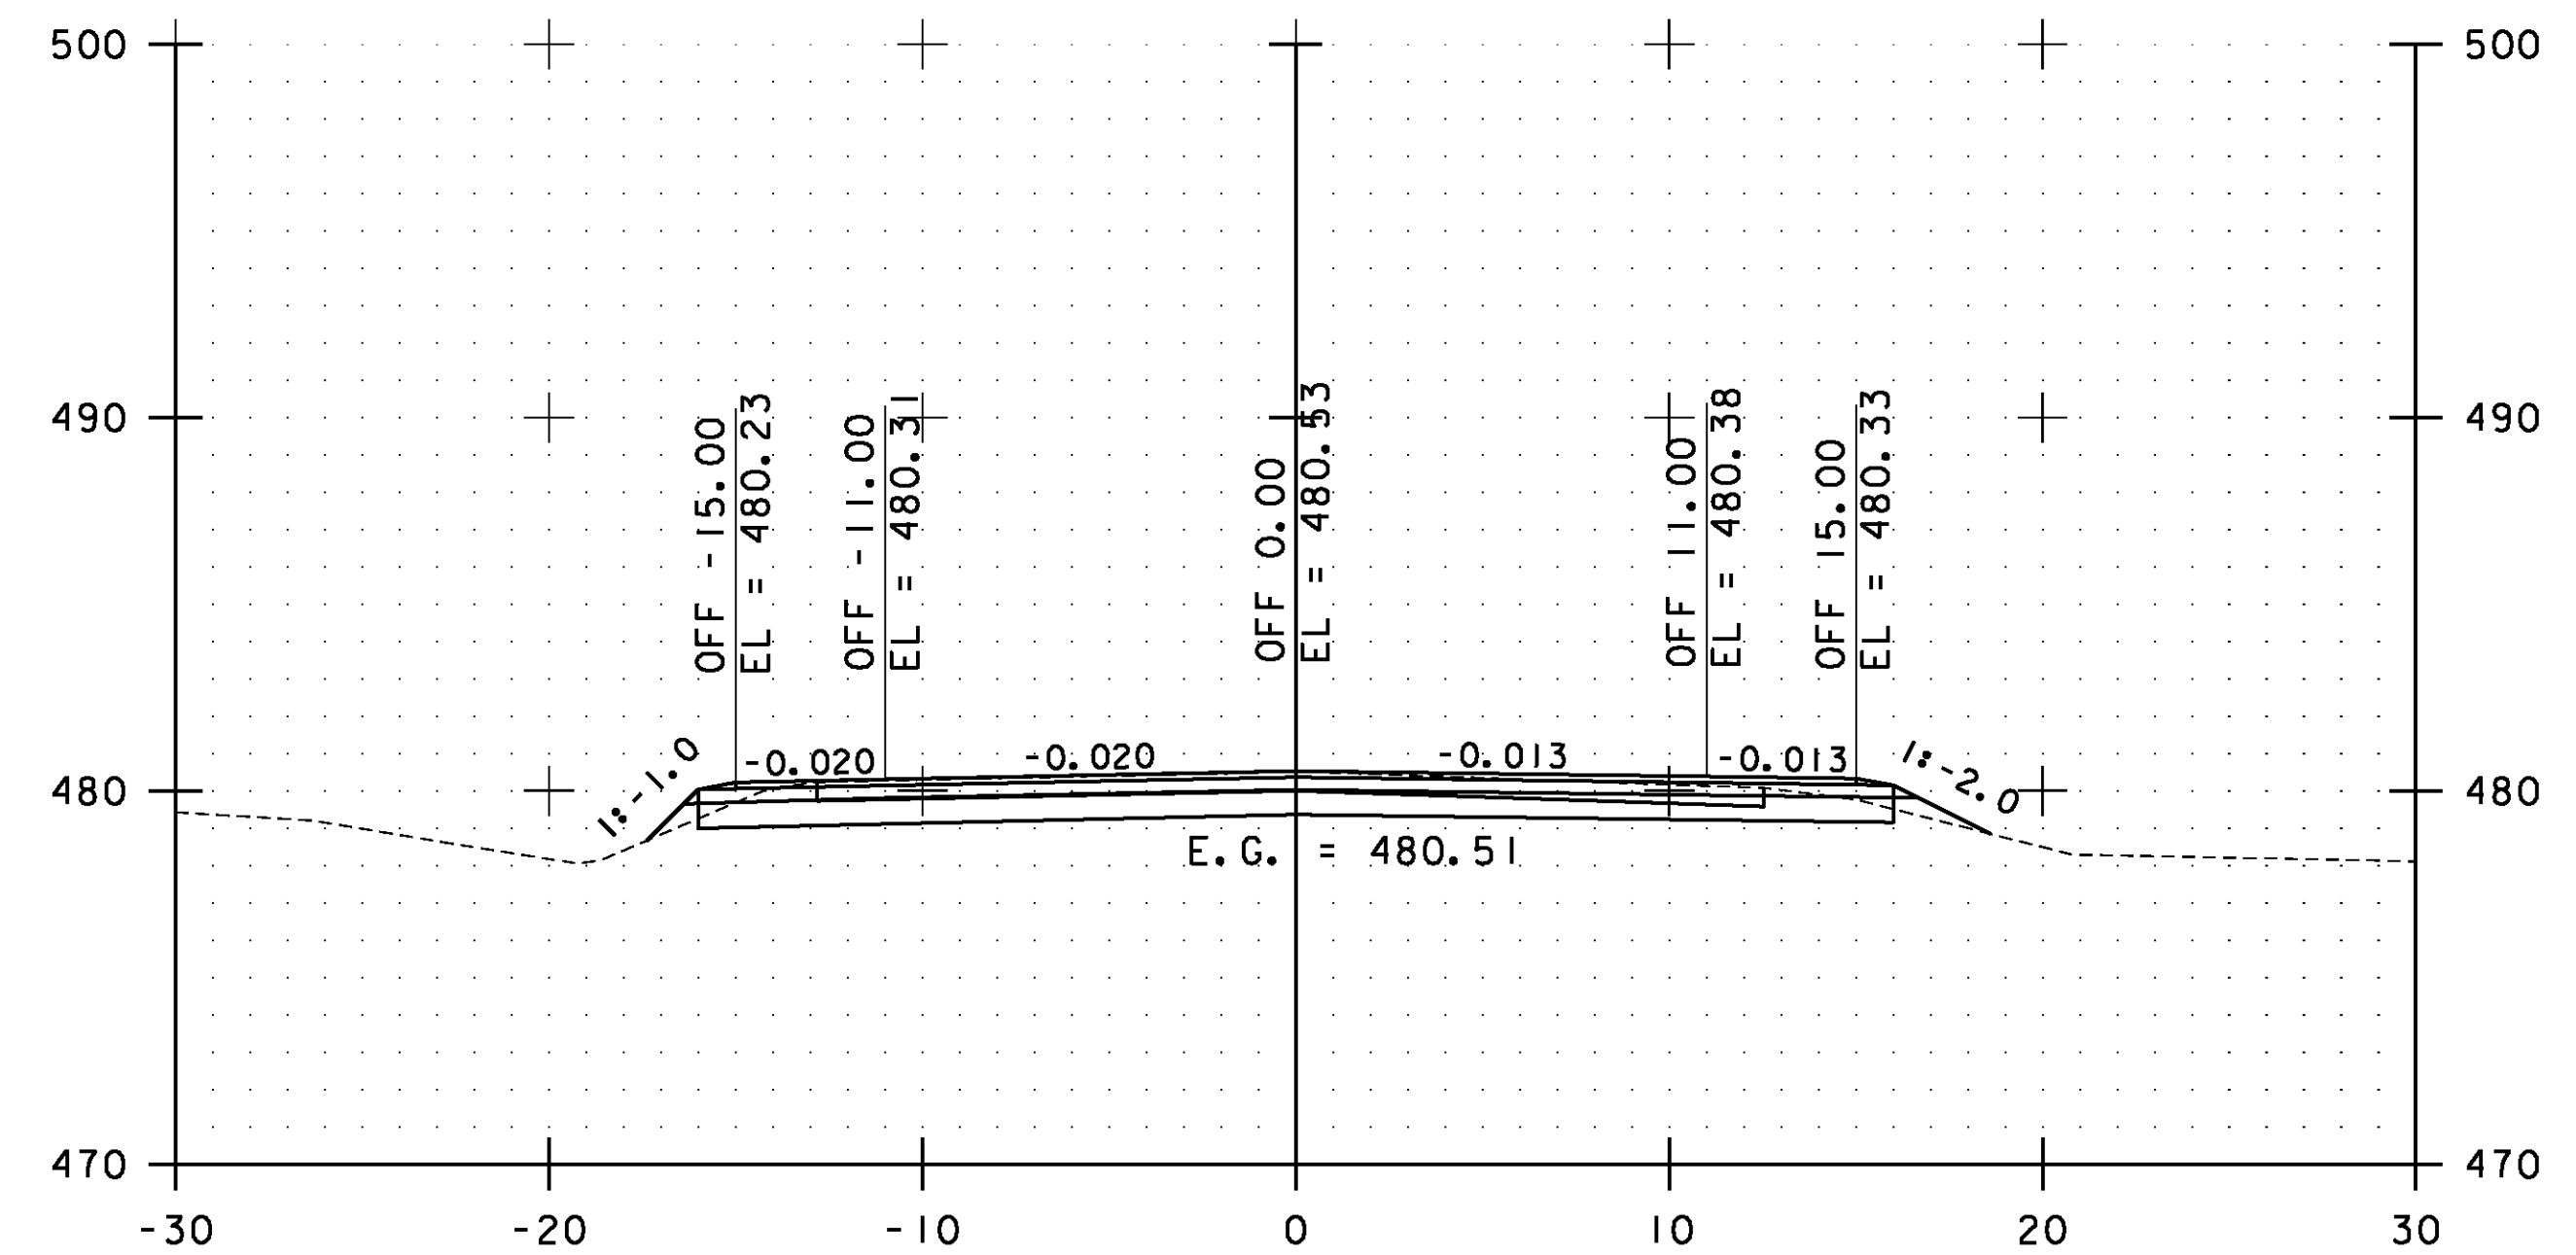

24+00.00

STA. 23+00.00 TO STA. 24+50.00

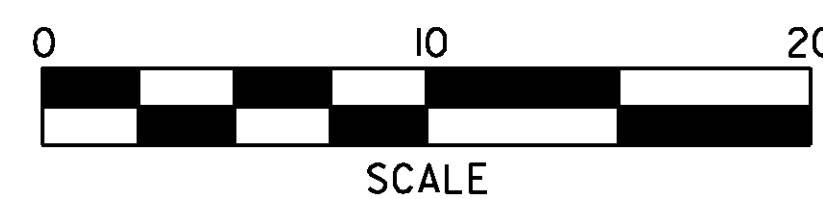

**WESTFORD
CROSS
SECTIONS
SHEET #12**

PROJECT NAME: ESSEX-WESTFORD
PROJECT NUMBER: STP 2912(I)

FILE NAME: p10c226.dgn
PROJECT LEADER: JLL
DESIGNED BY: STANTEC
IPARM FILE: p10c226xs123.i

PLOT DATE: 2/20/2013
DRAWN BY: STANTEC
CHECKED BY: STANTEC
SHEET 214 OF 239