




35+50.00

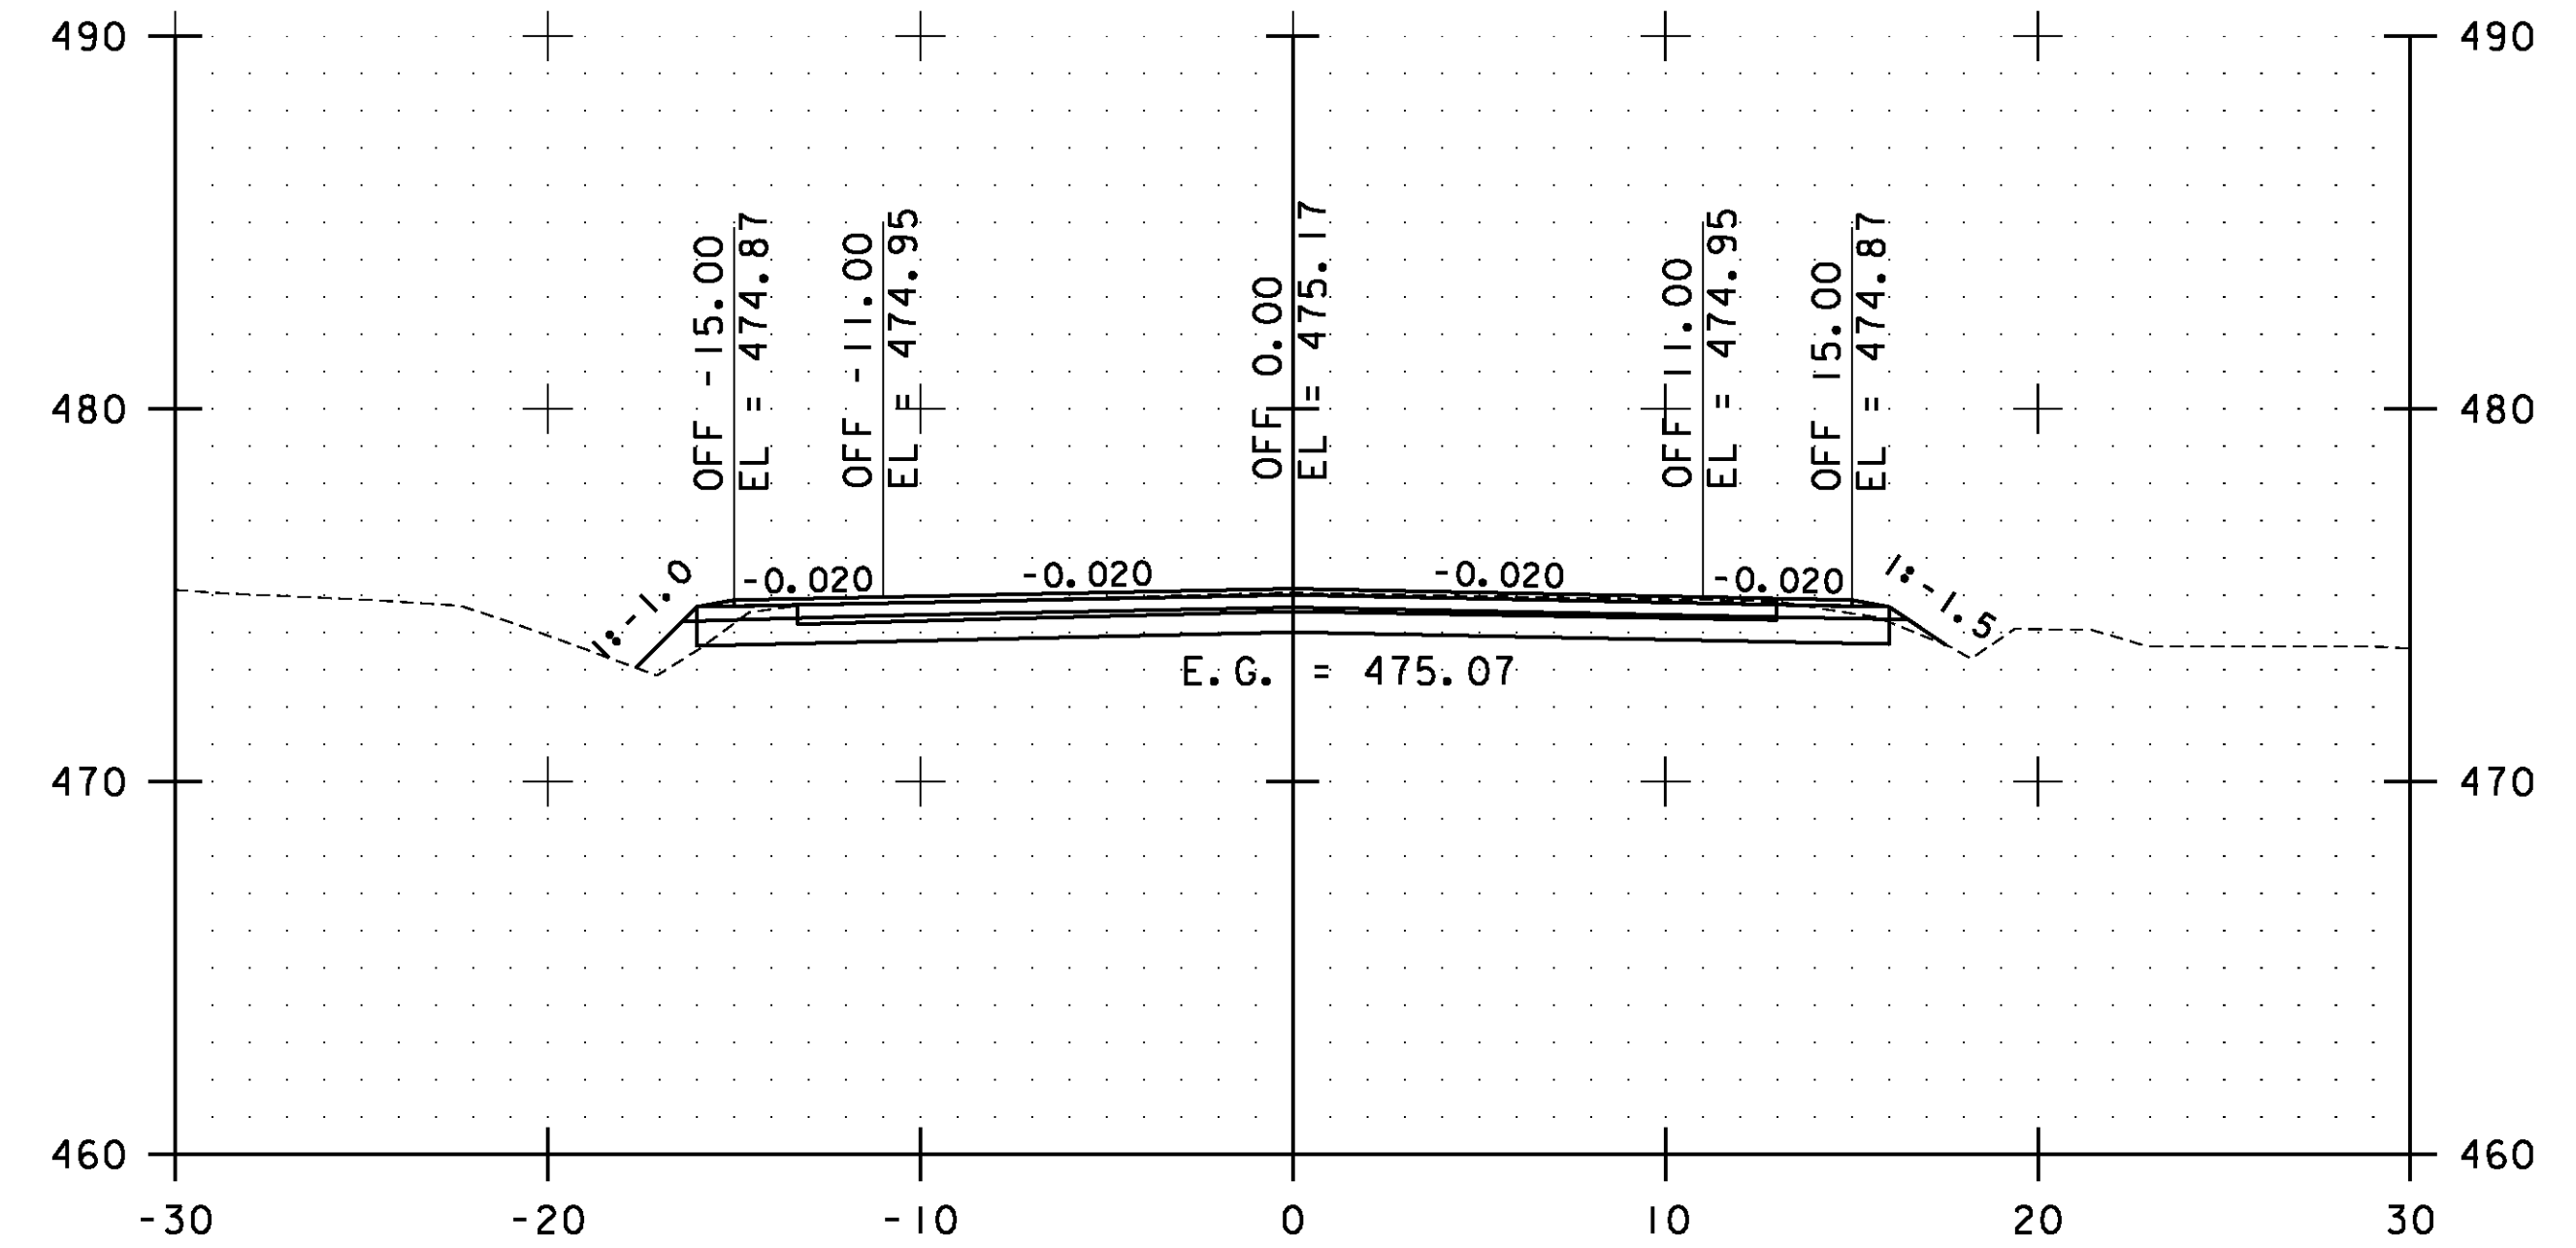

36+50.00

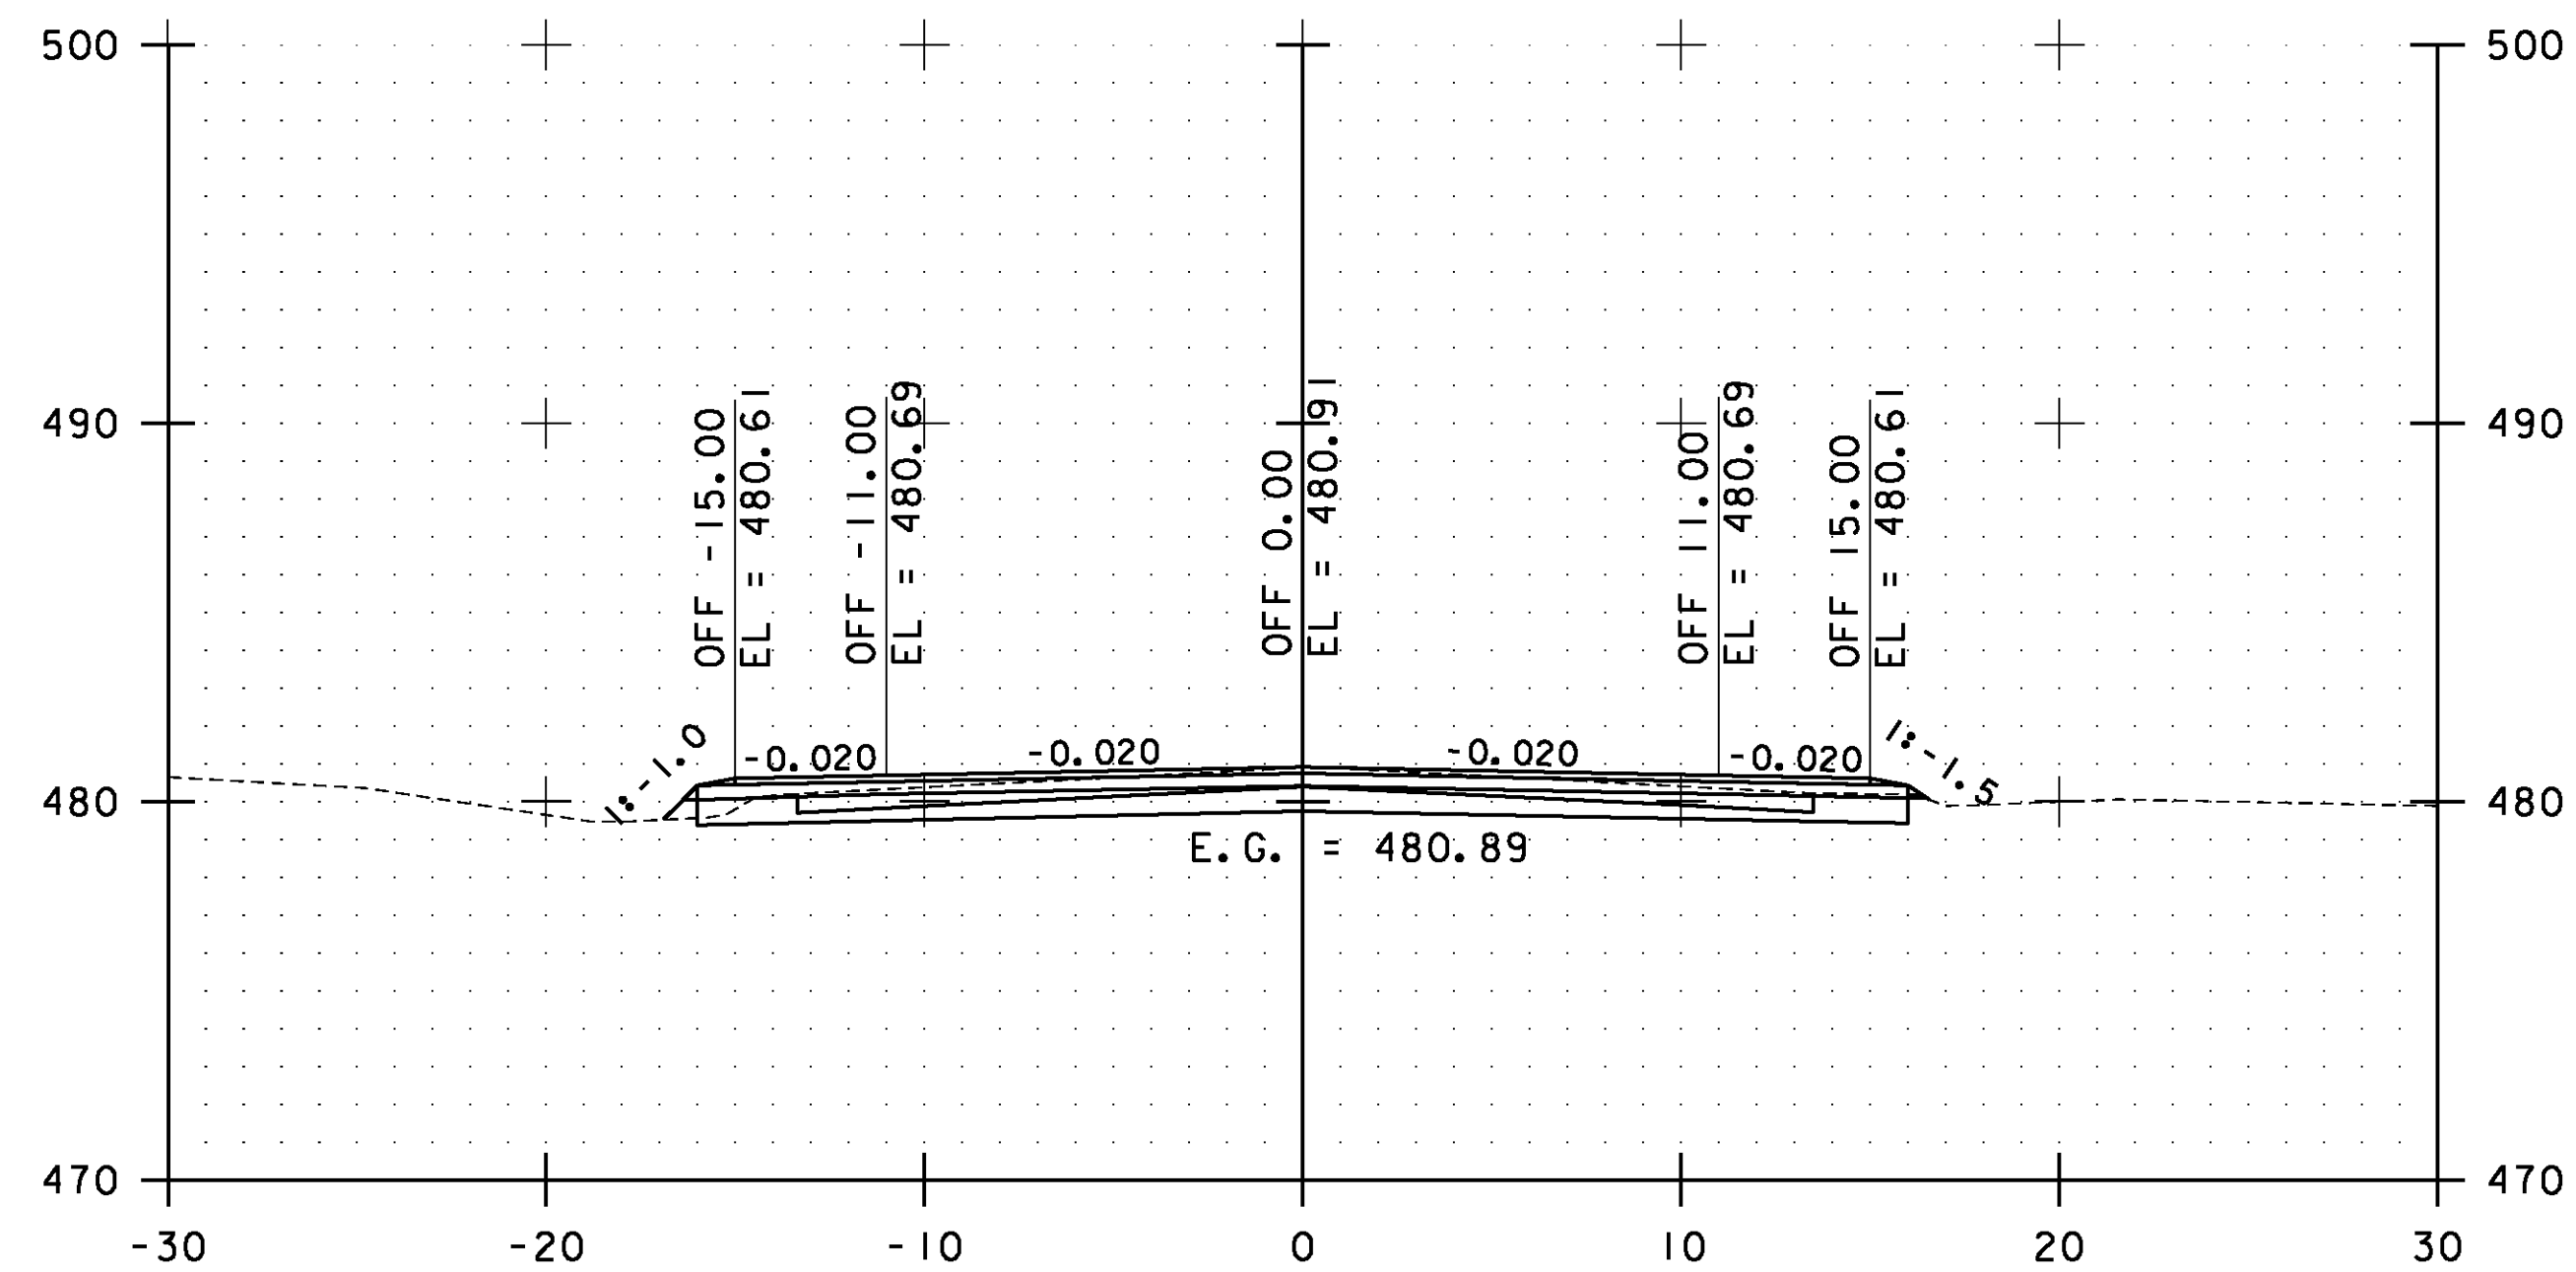

35+00.00

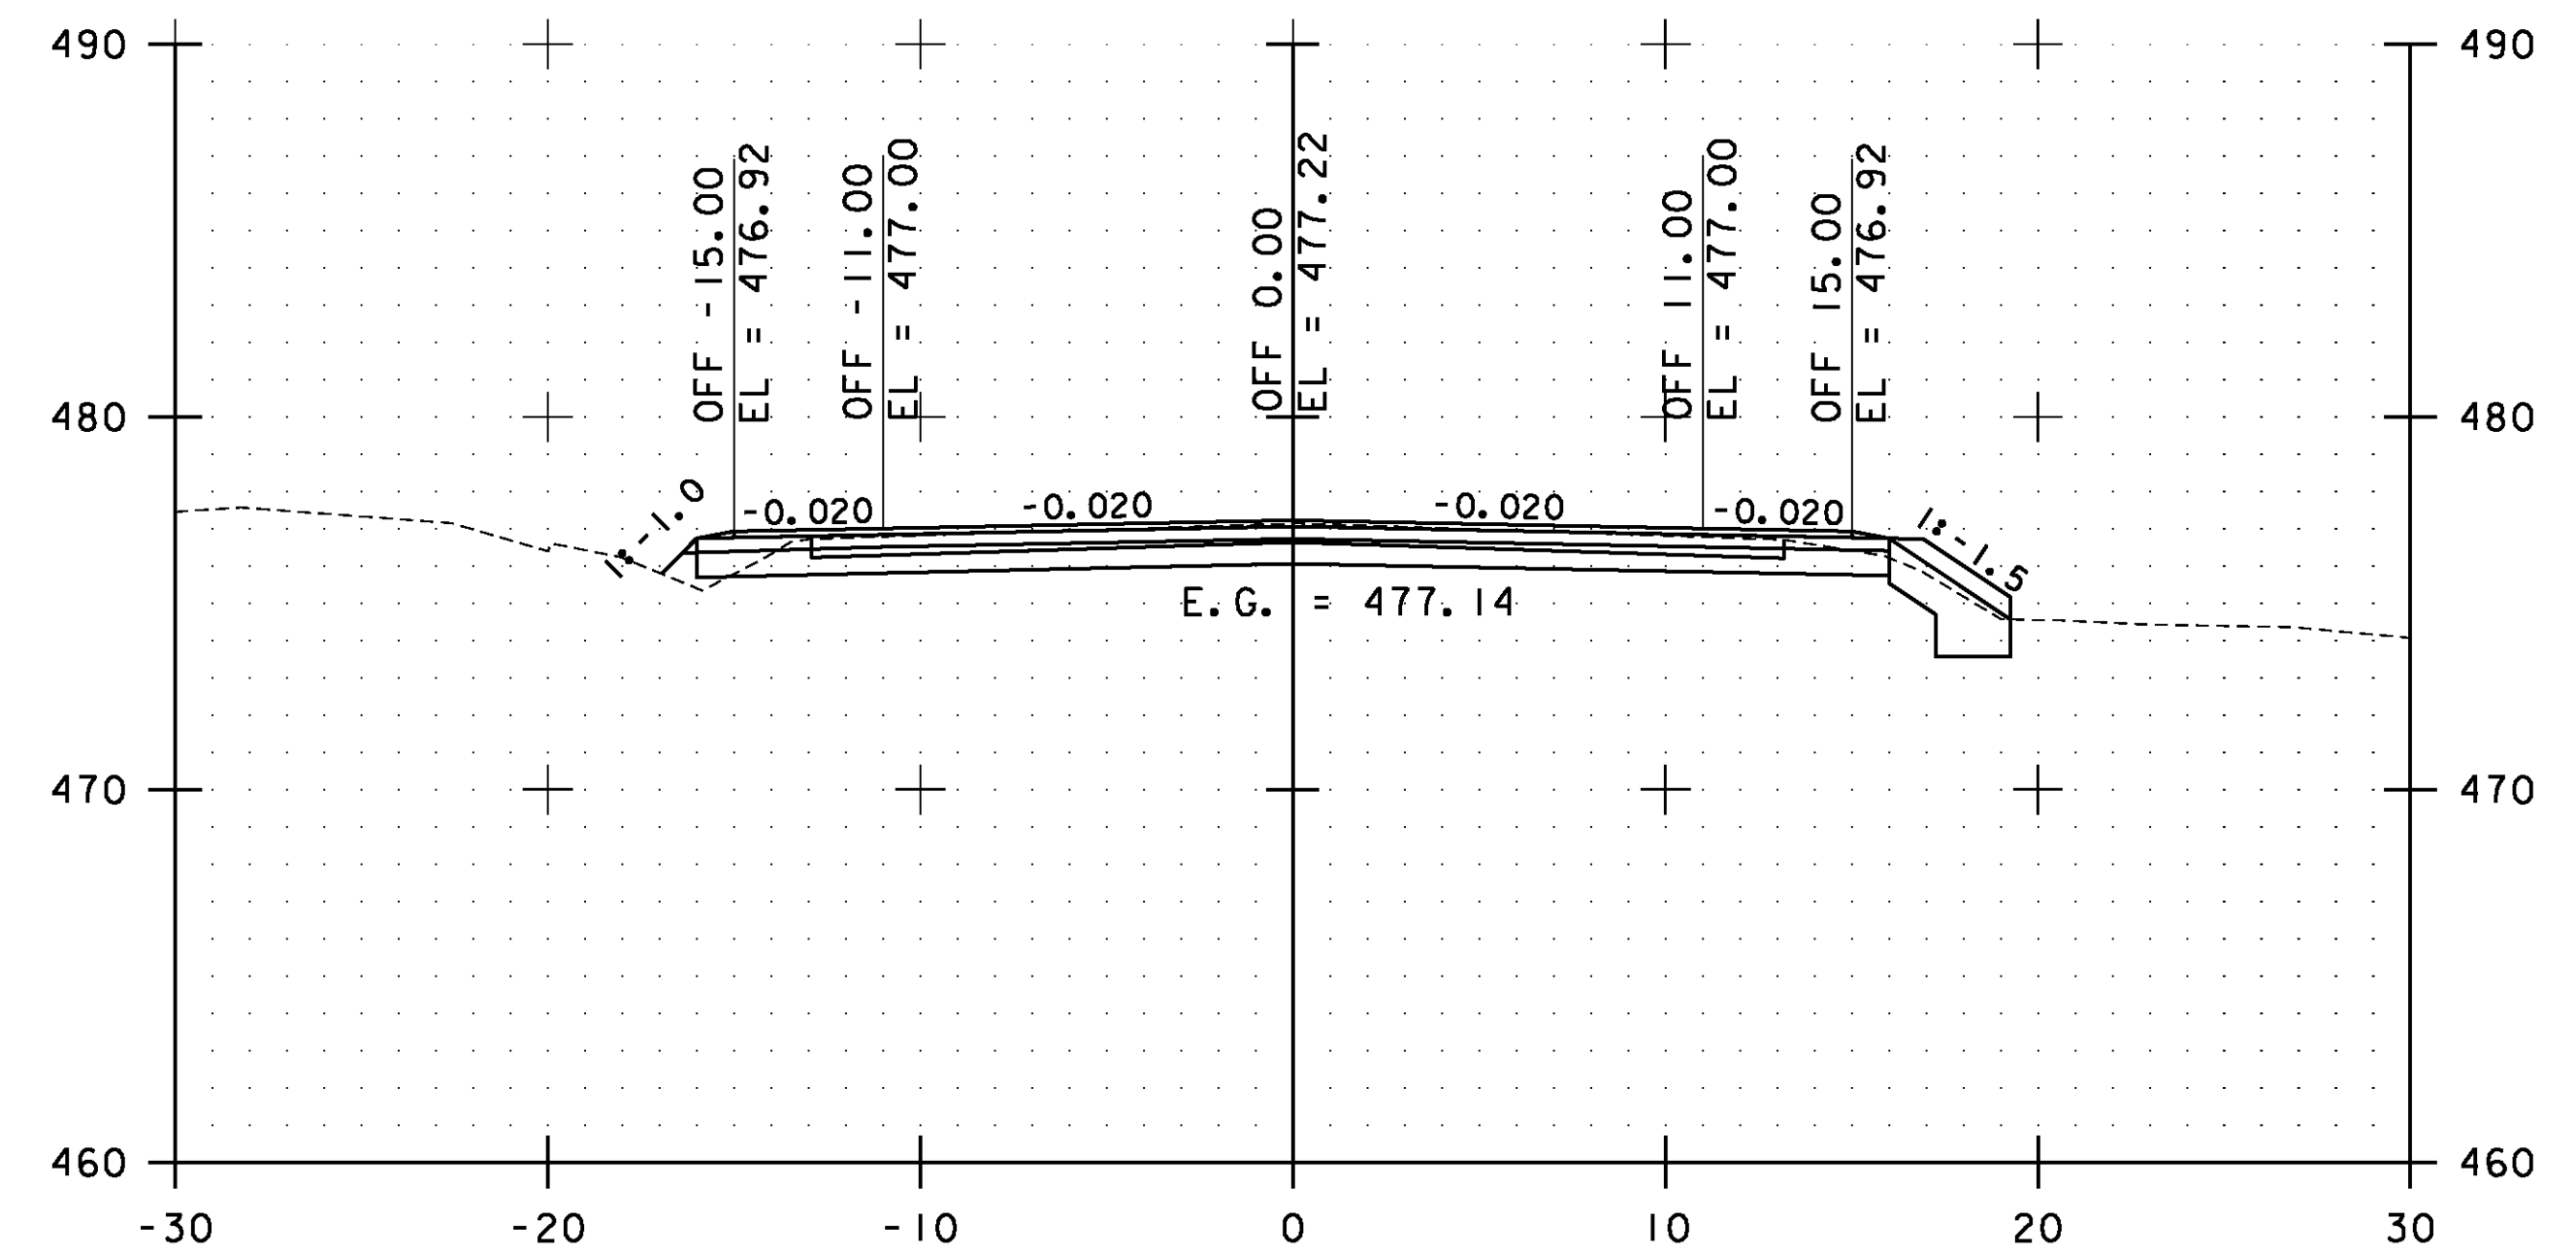

36+00.00

STA. 35+00.00 TO STA. 36+50.00



**WESTFORD
CROSS
SECTIONS
SHEET #18**

PROJECT NAME: ESSEX-WESTFORD
PROJECT NUMBER: STP 2912(I)

FILE NAME: p10c226.dgn
PROJECT LEADER: JLL
DESIGNED BY: STANTEC
IPARM FILE: p10c226xs129.i

PLOT DATE: 2/20/2013
DRAWN BY: STANTEC
CHECKED BY: STANTEC
SHEET 220 OF 239