



44+00.00

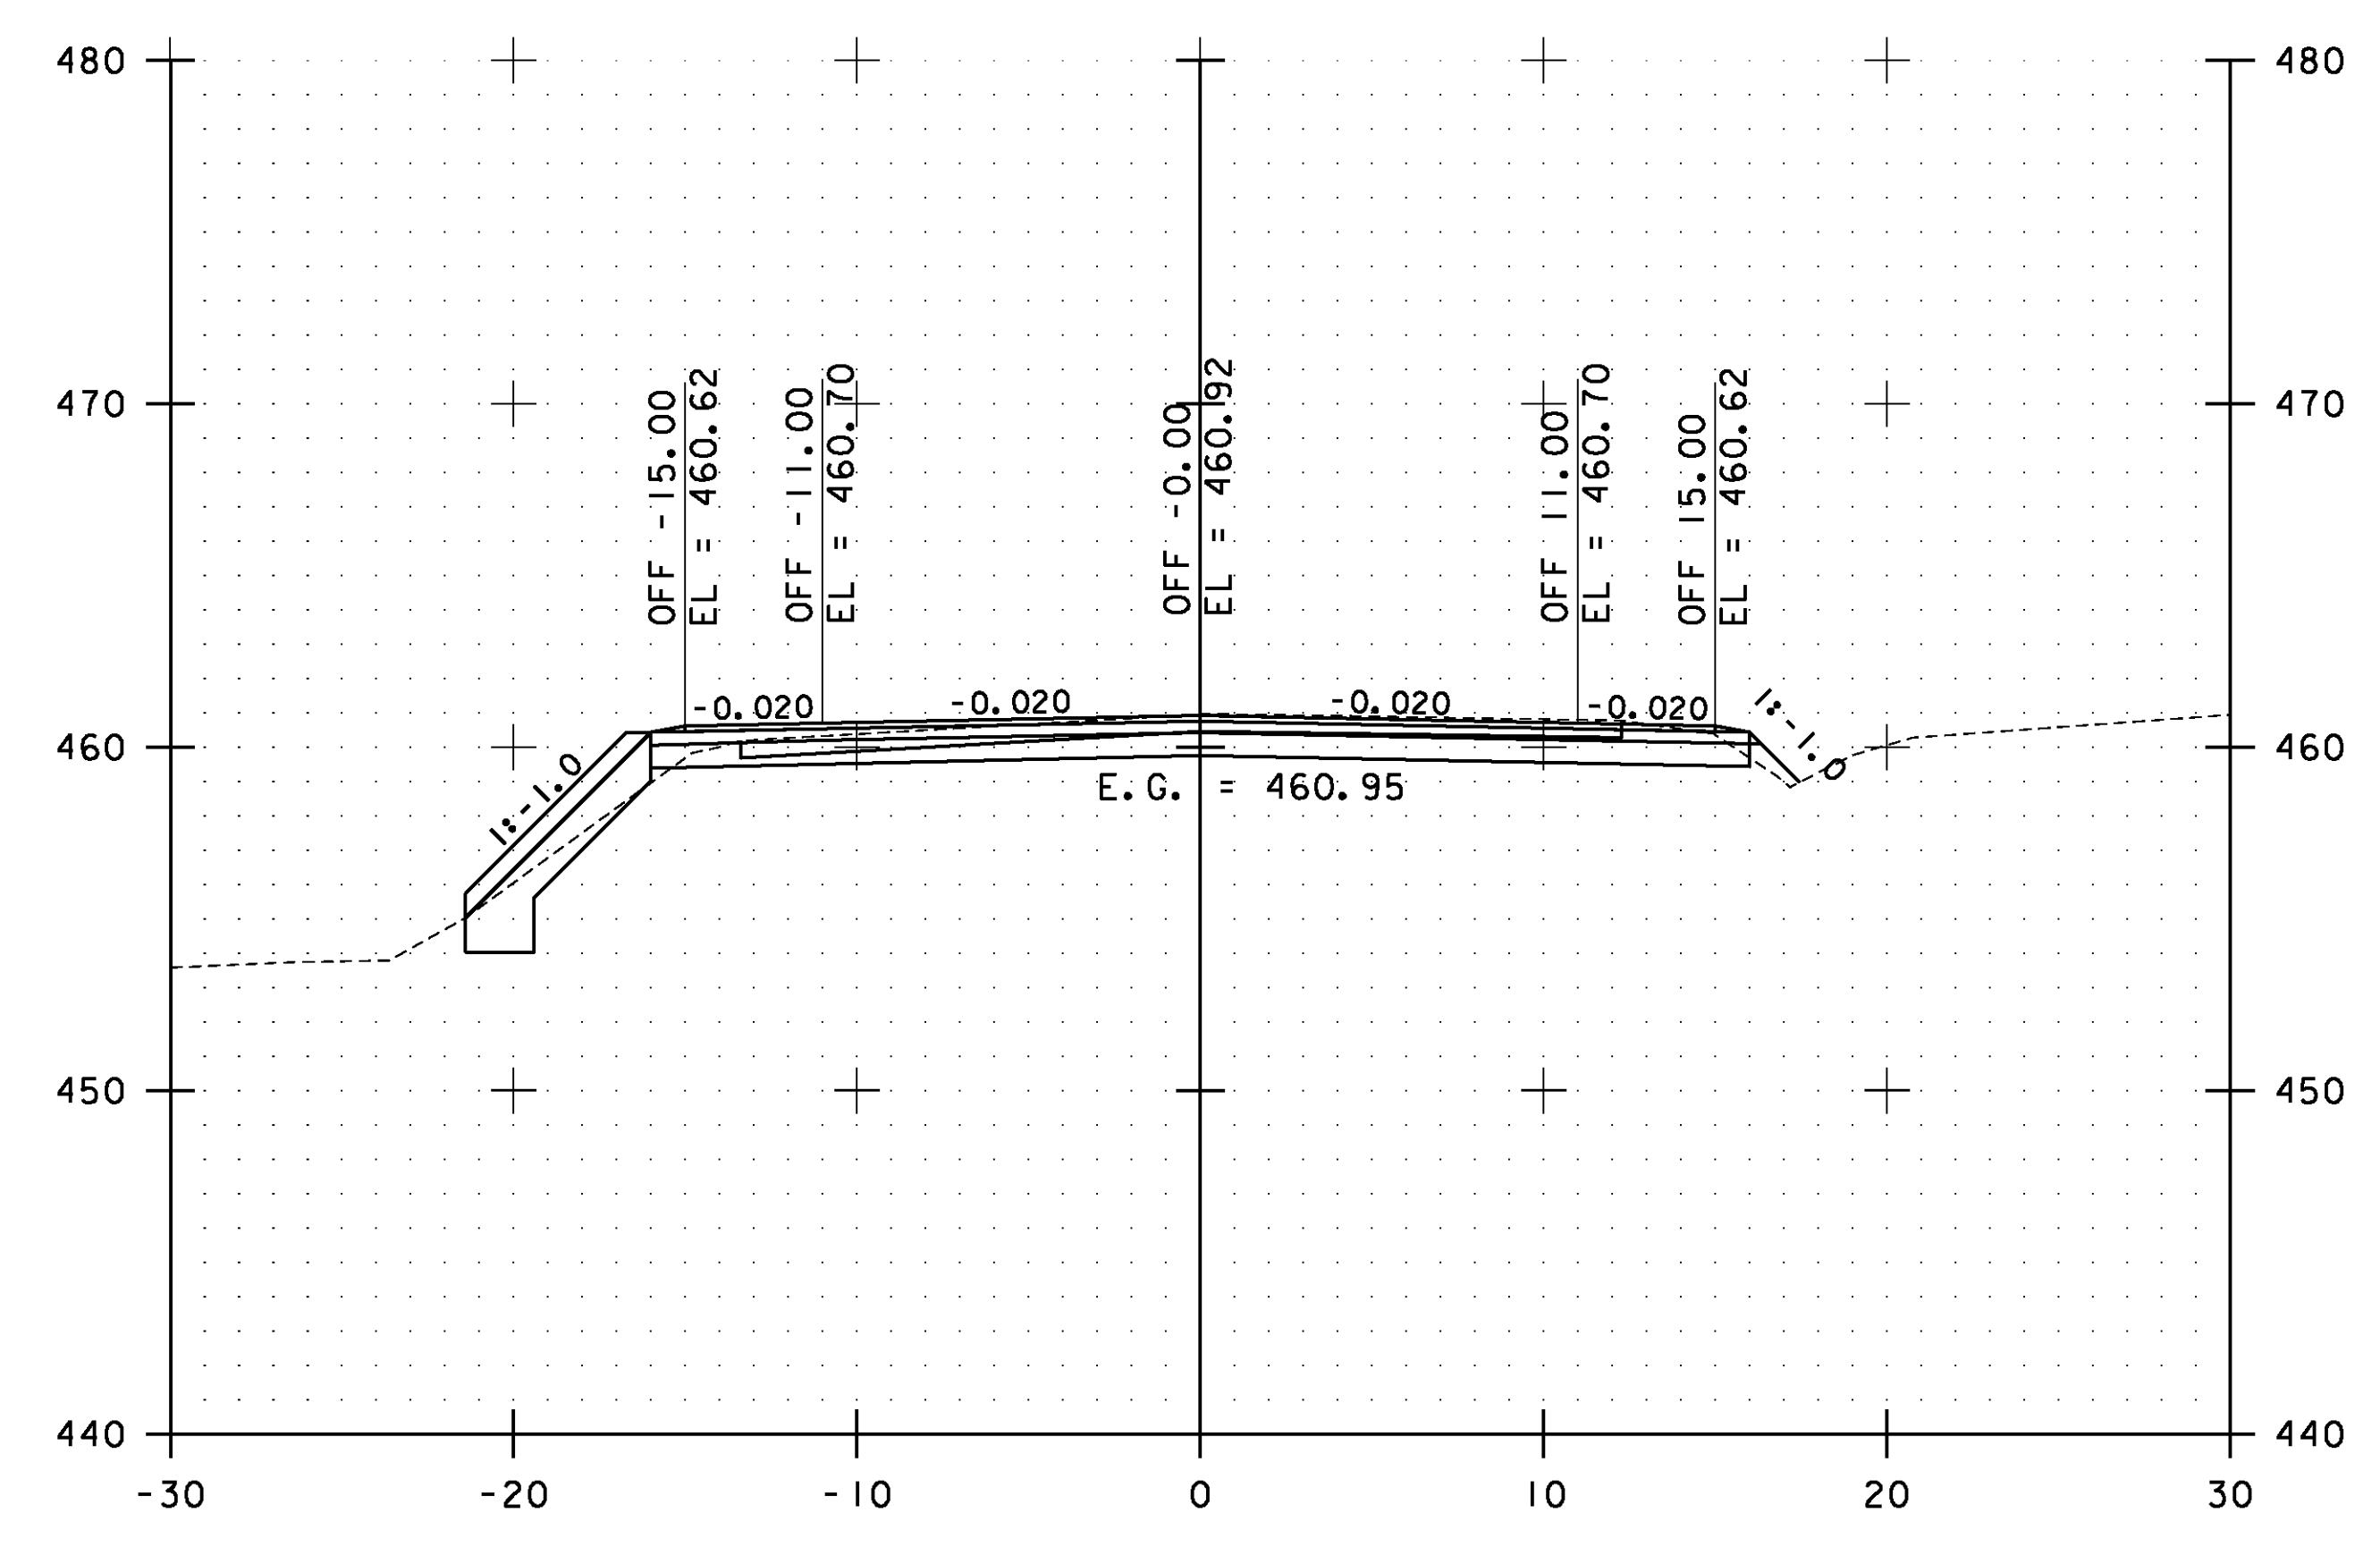


43+00.00

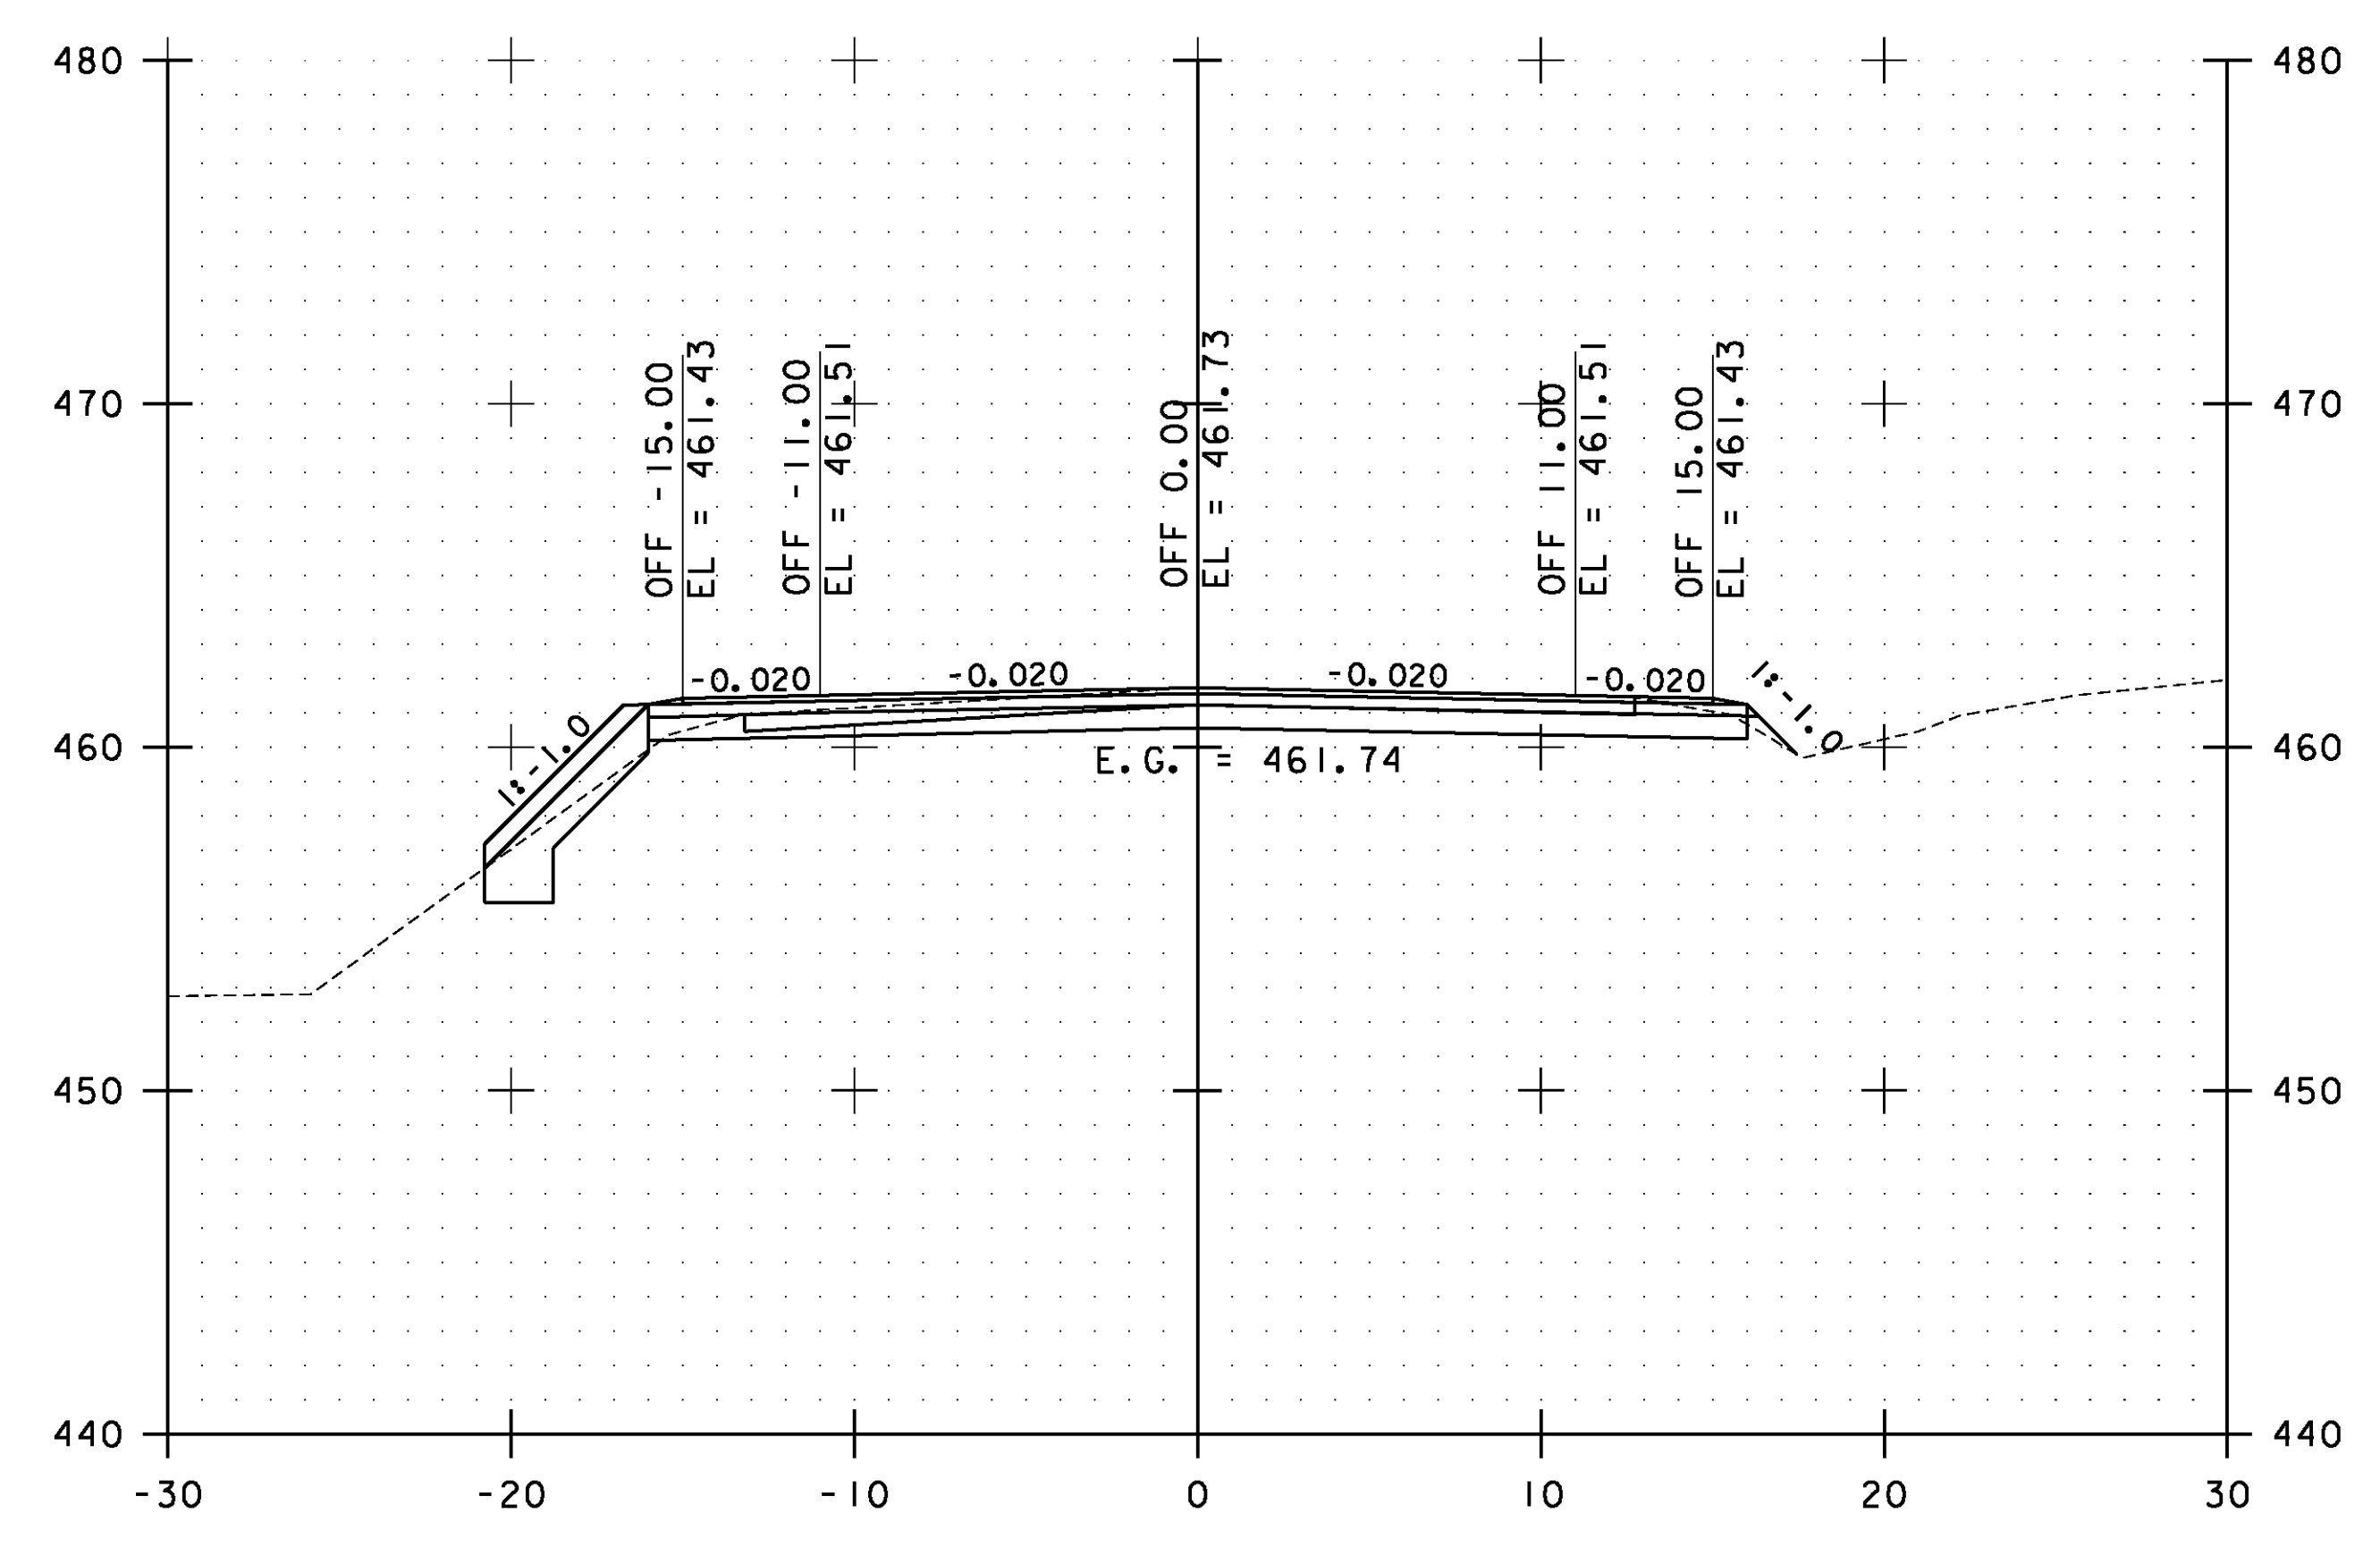

43+50.00

STA. 43+00.00 TO STA. 44+00.00

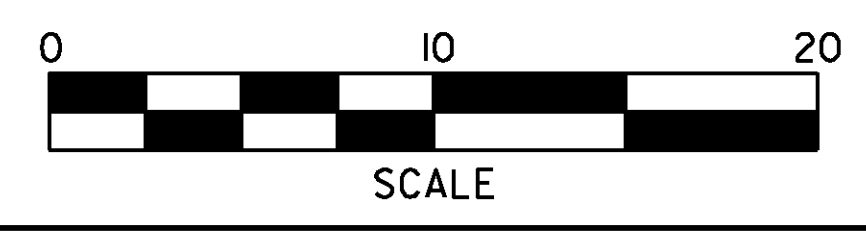

**WESTFORD
CROSS
SECTIONS
SHEET #22**

PROJECT NAME: ESSEX-WESTFORD	PLOT DATE: 2/20/2013
PROJECT NUMBER: STP 2912(I)	DRAWN BY: STANTEC
FILE NAME: p10c226.dgn	CHECKED BY: STANTEC
PROJECT LEADER: JLL	SHEET 224 OF 239
DESIGNED BY: STANTEC	
IPARM FILE: p10c226xs133.i	