




45+00.00

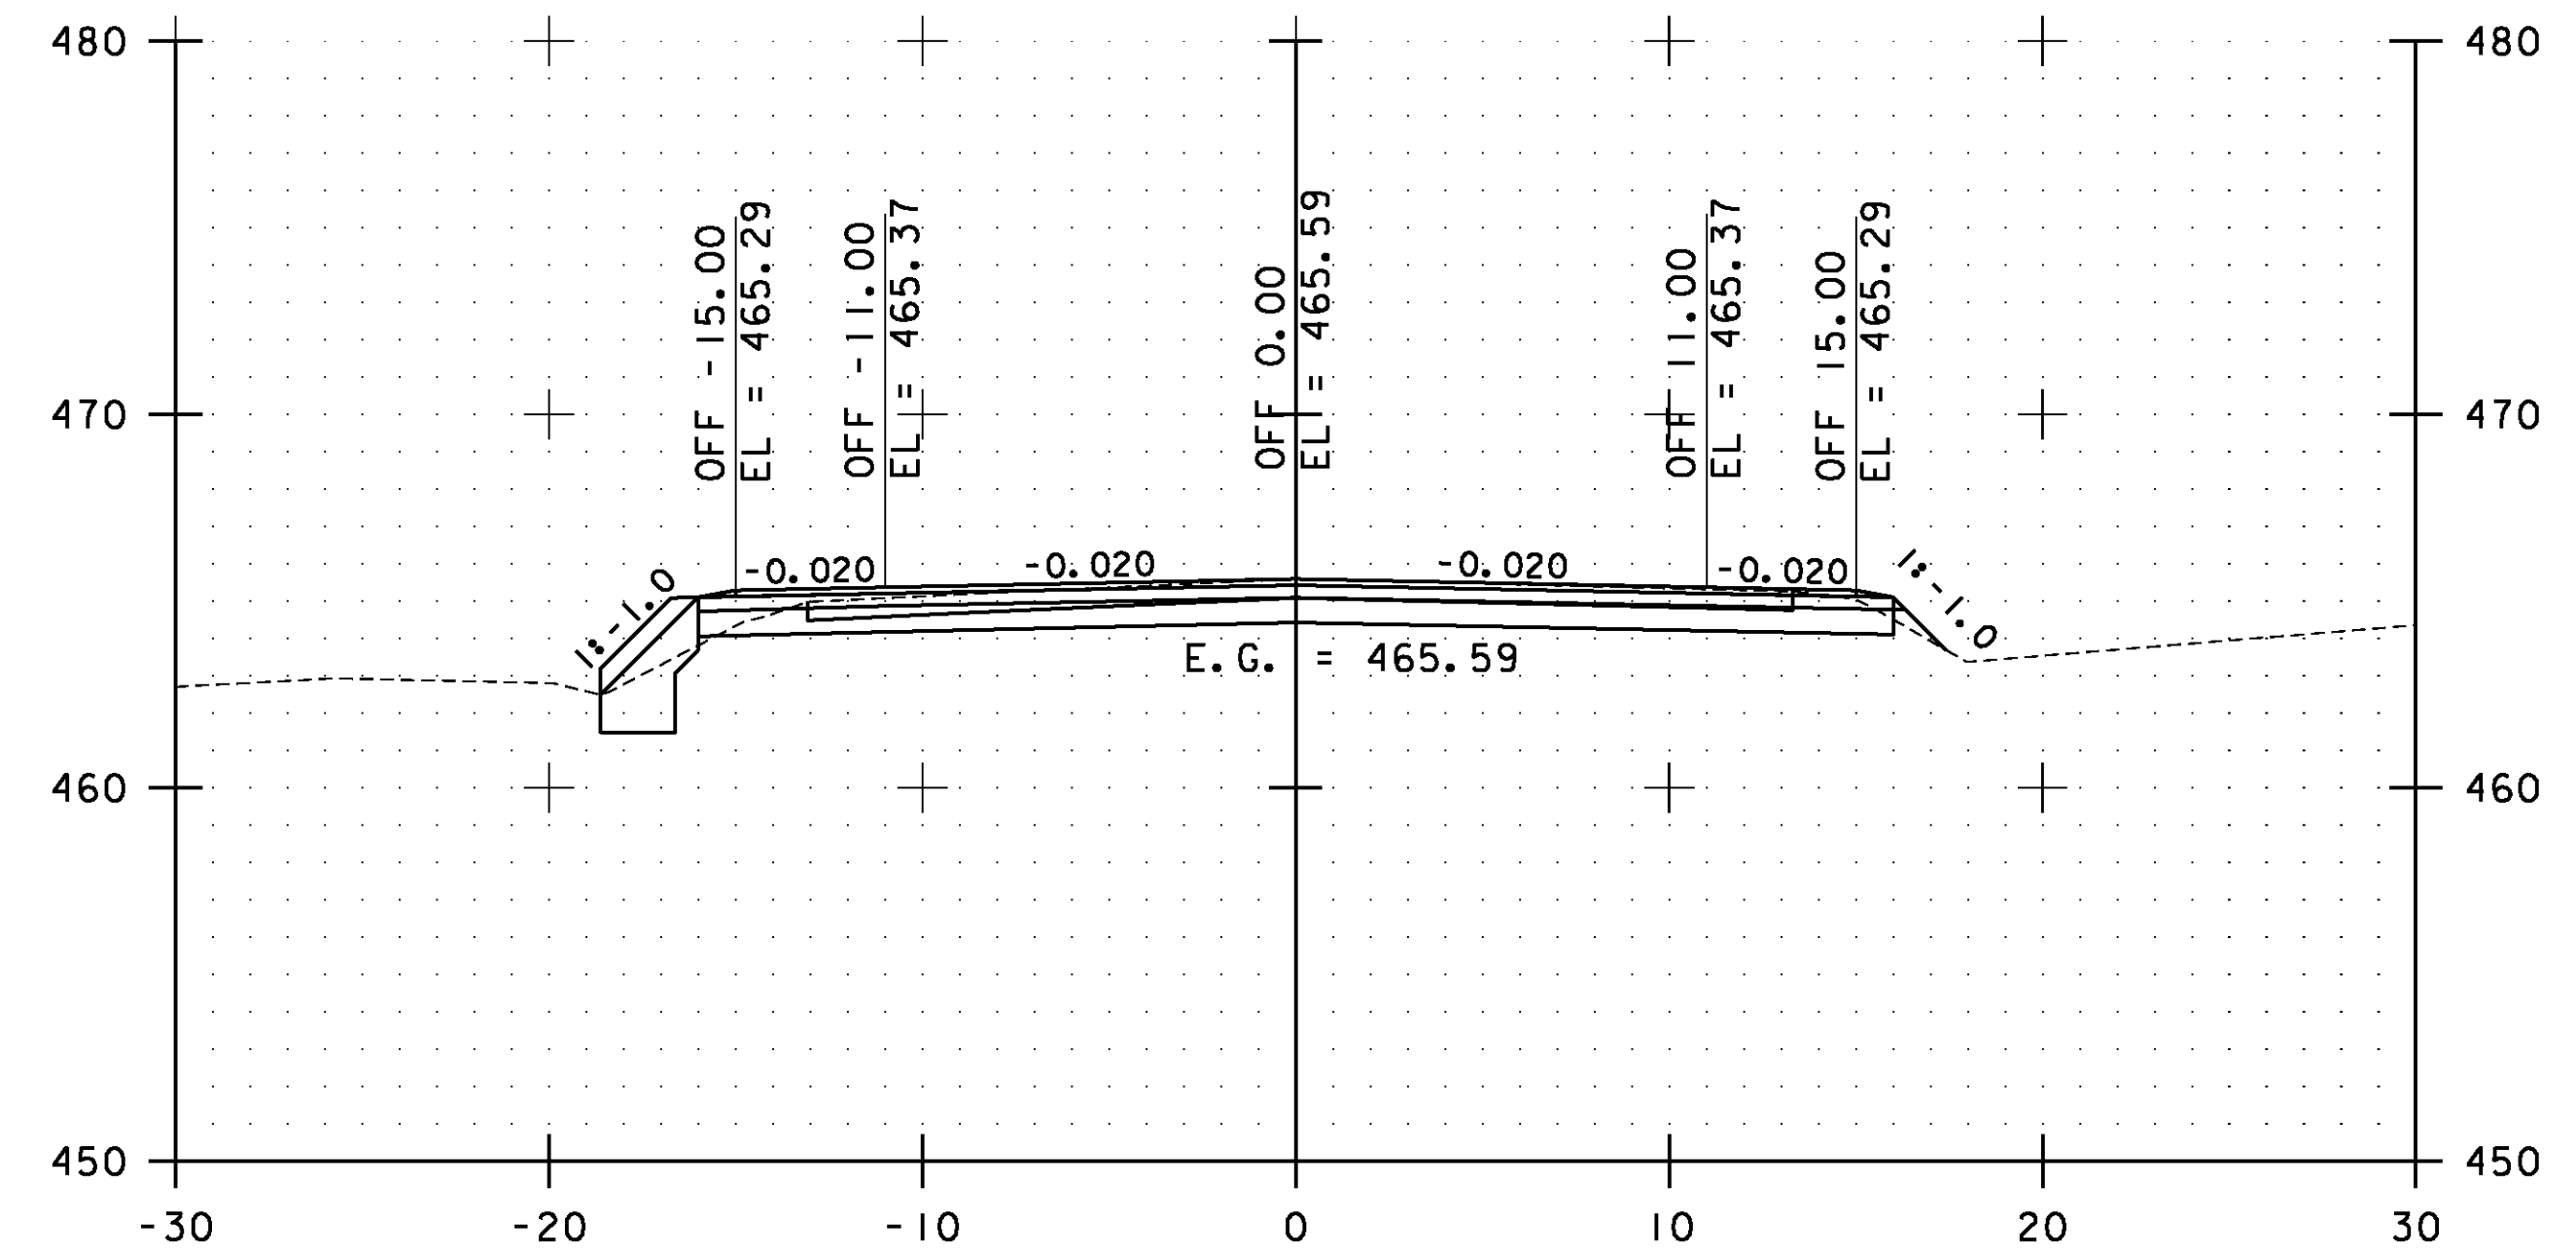

46+00.00

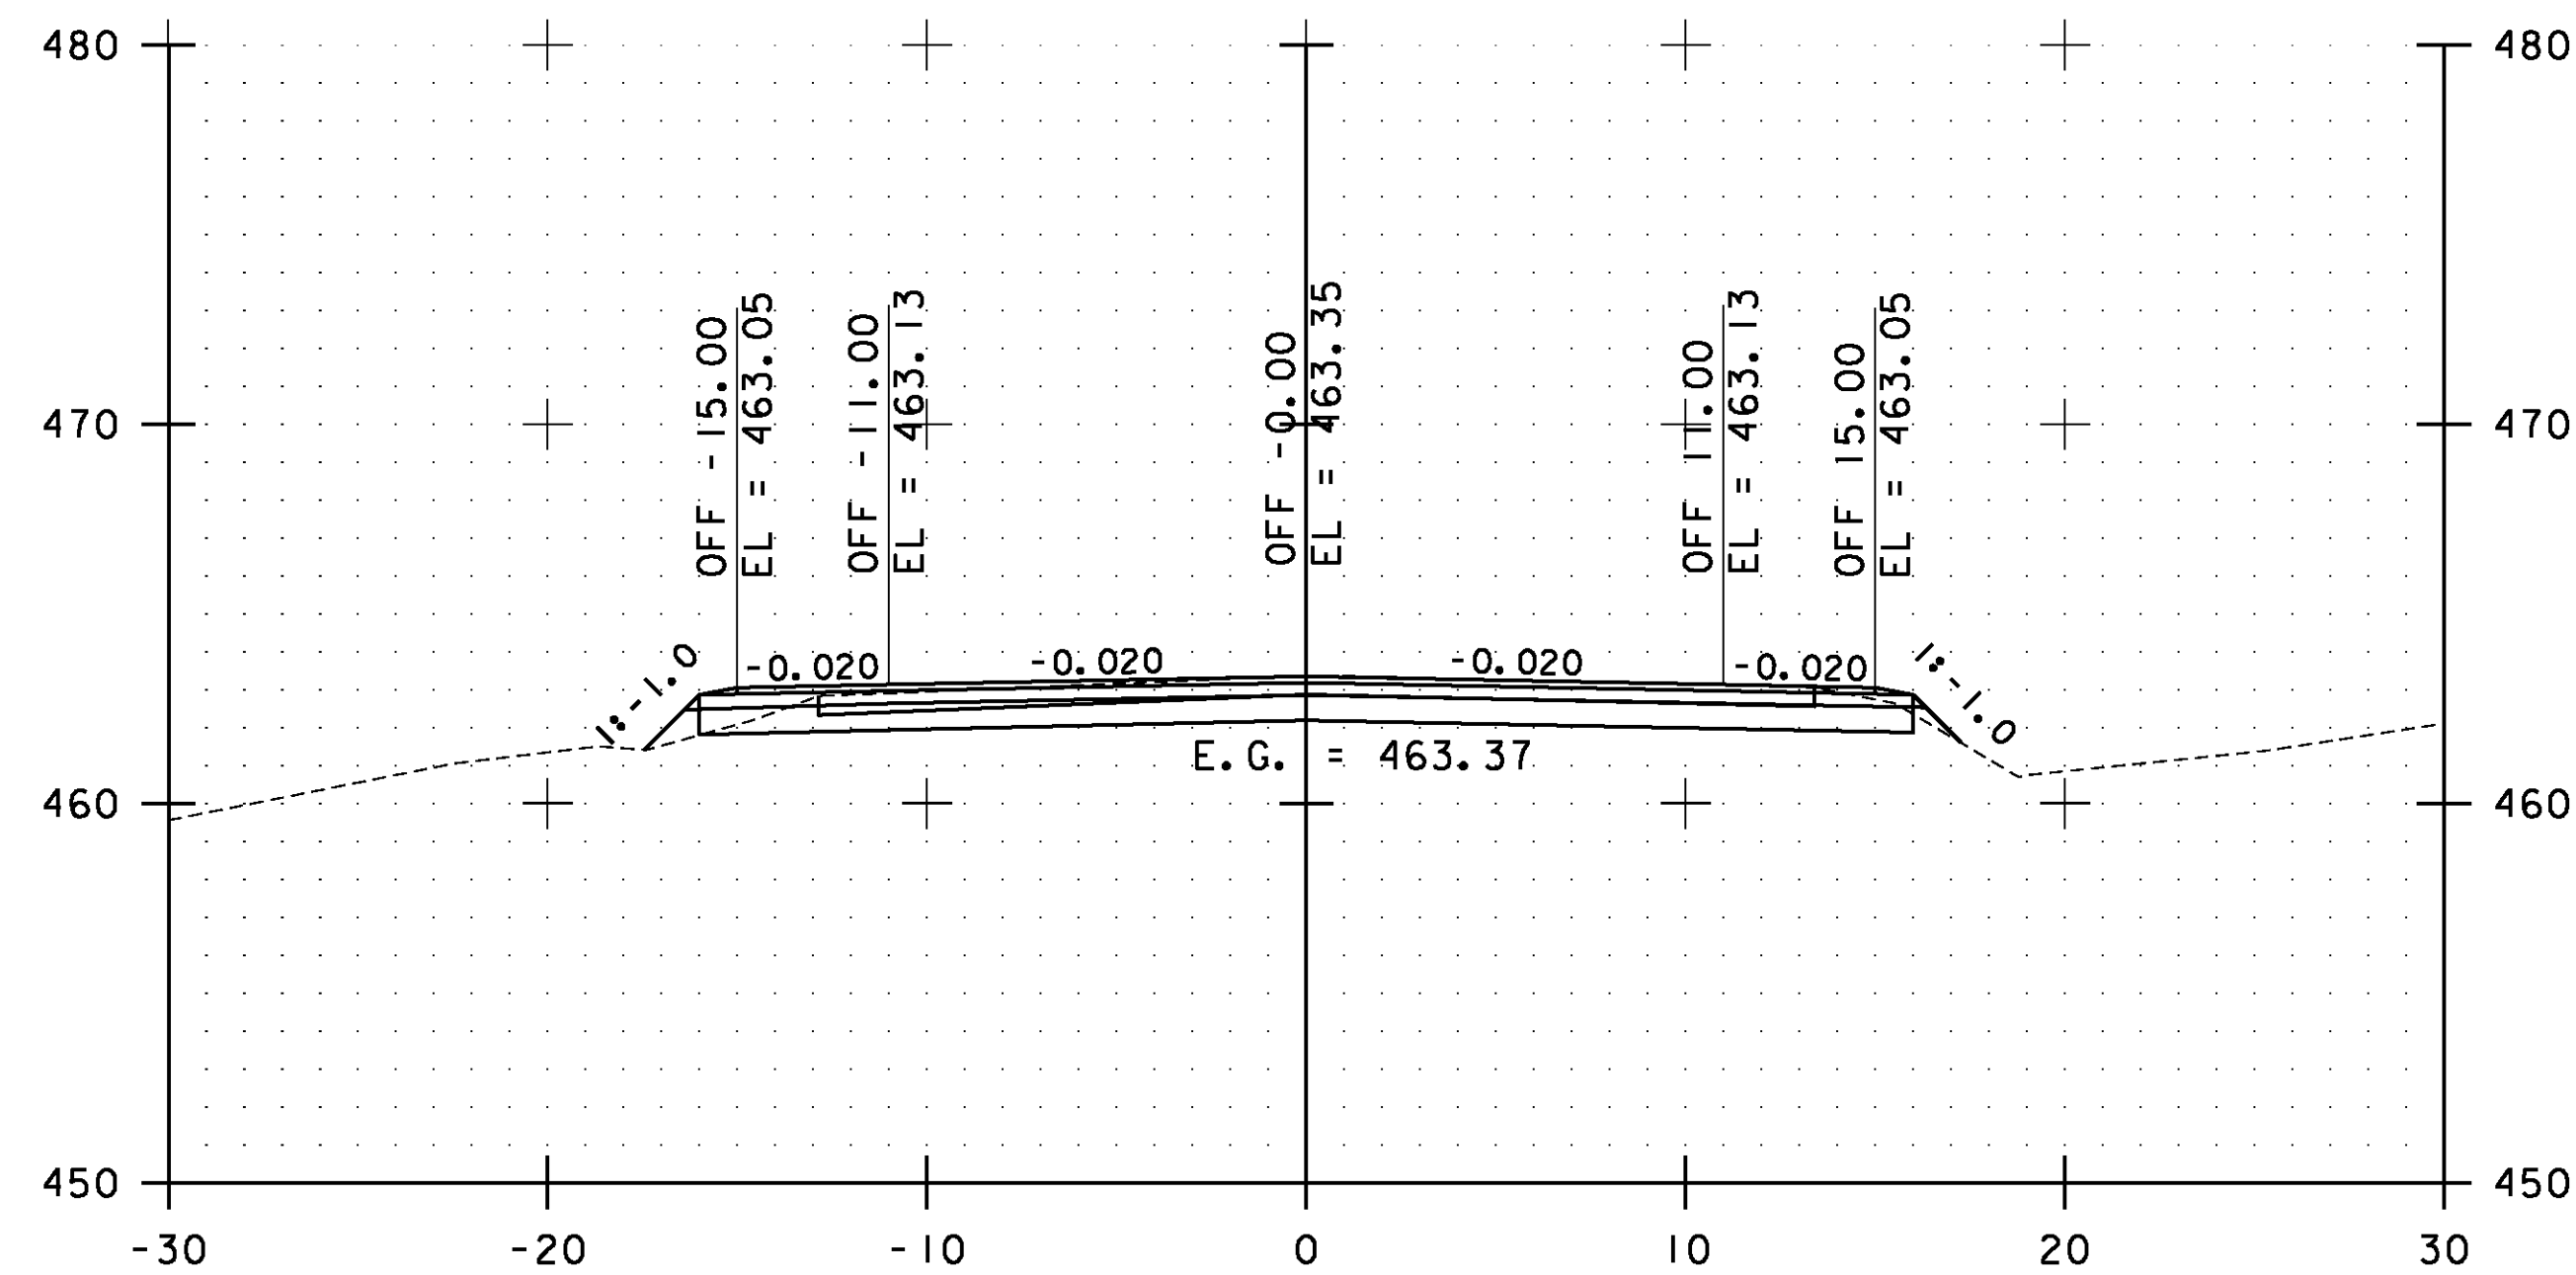


44+50.00

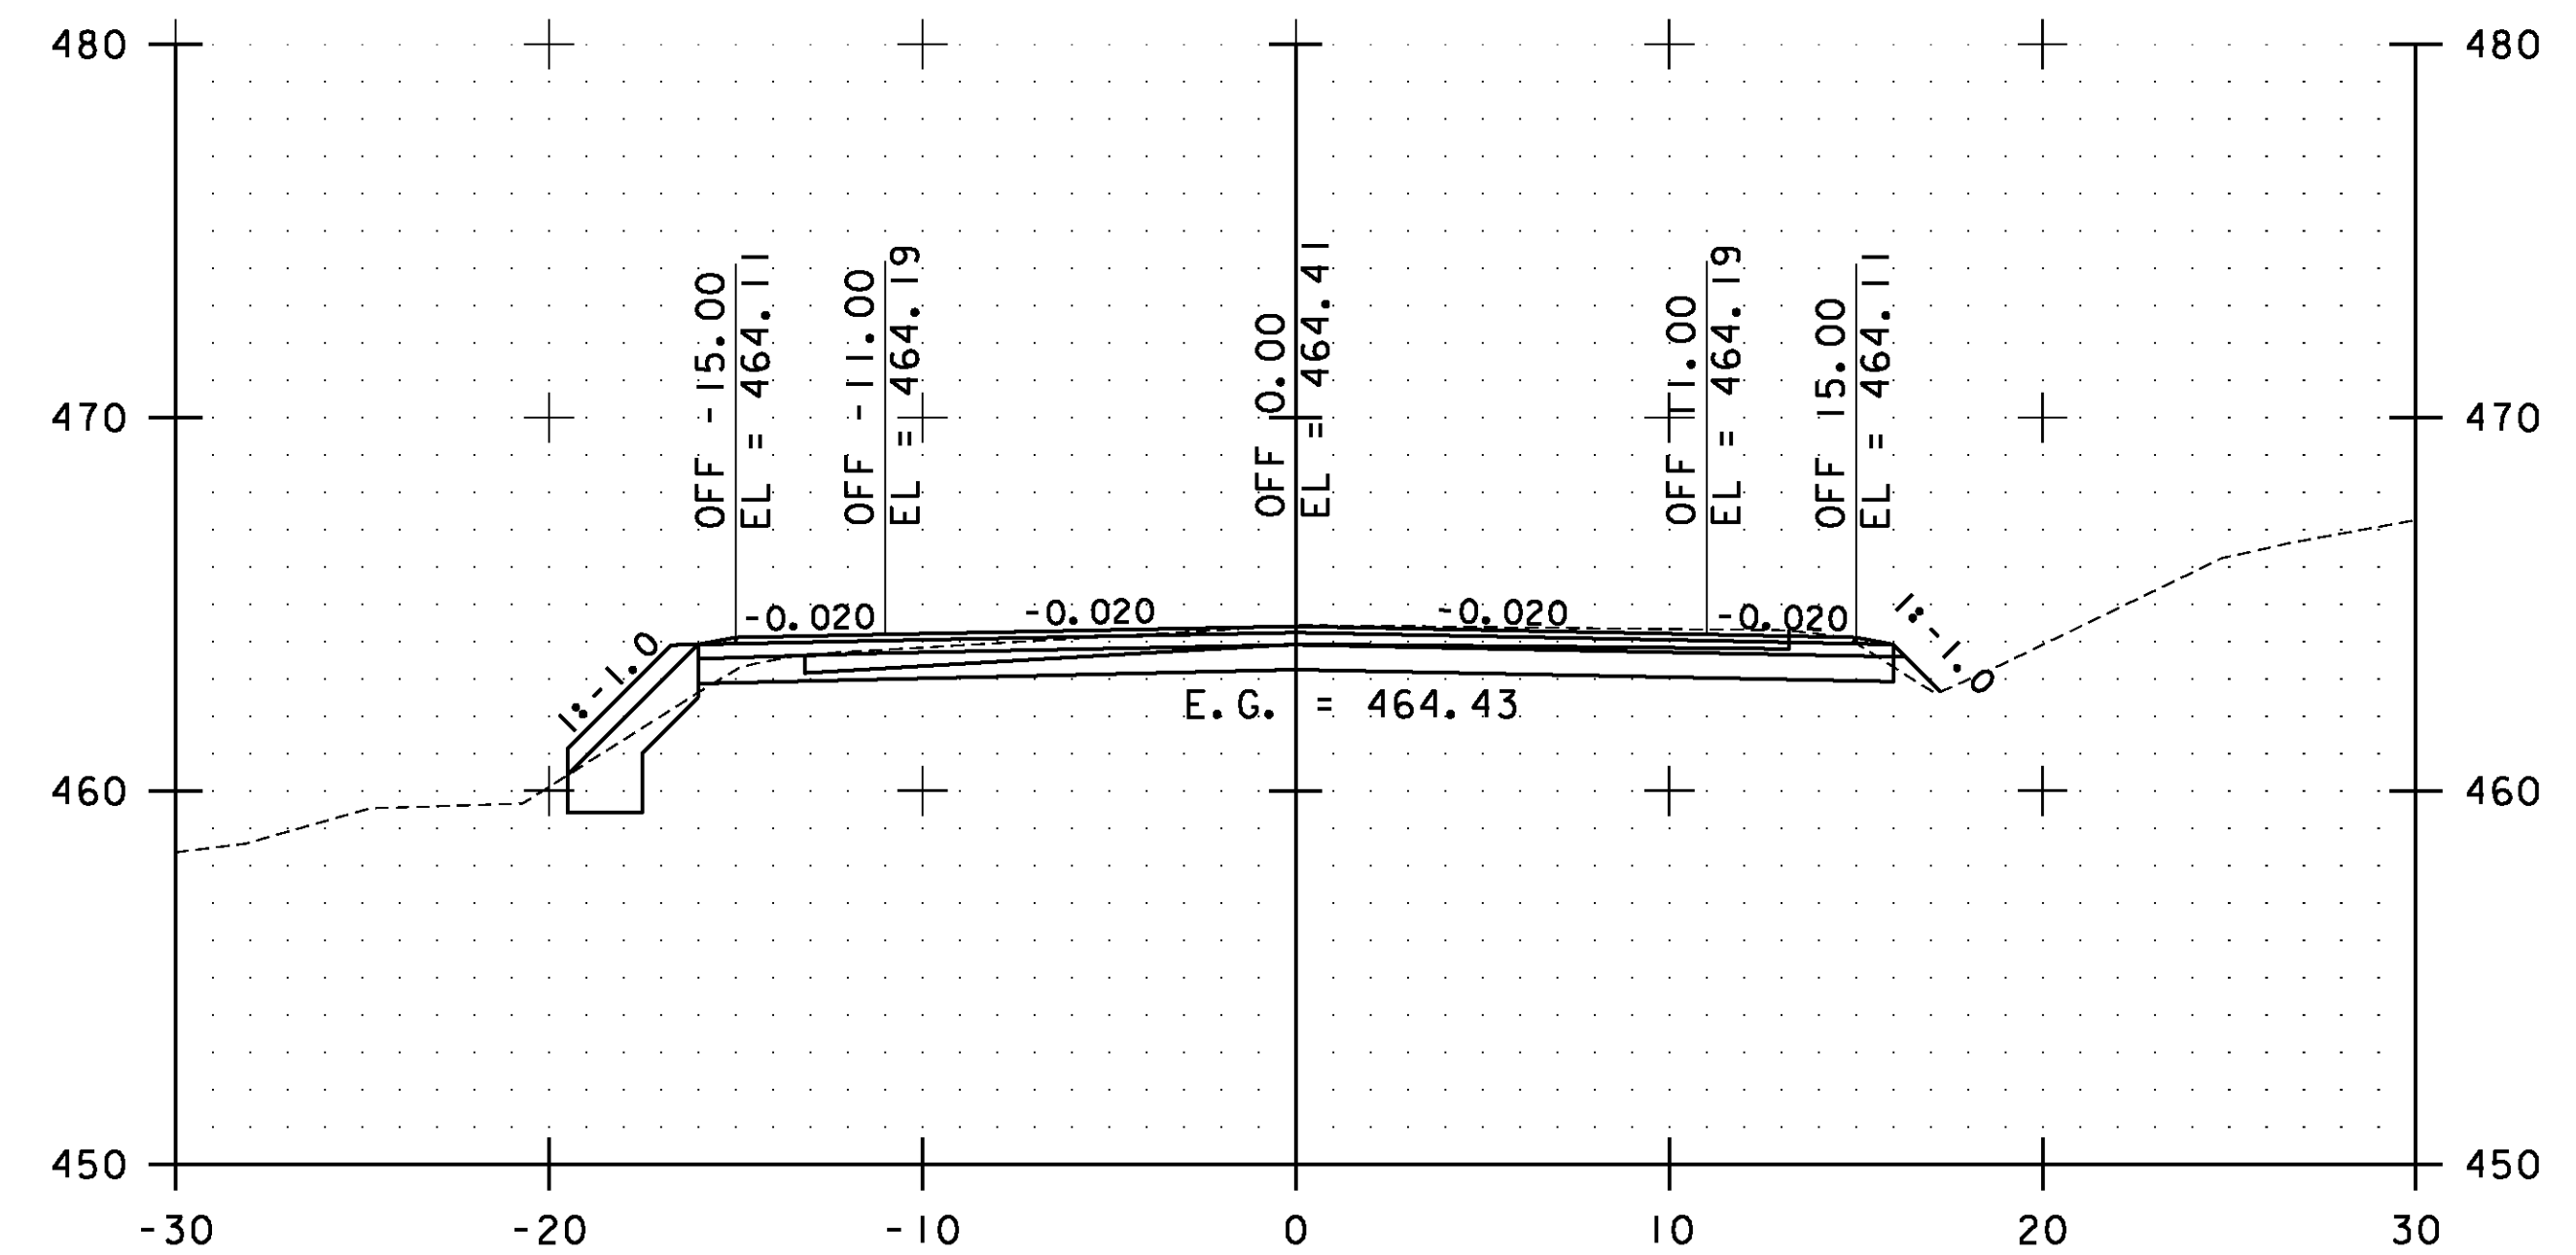

45+50.00

STA. 44+50.00 TO STA. 46+00.00

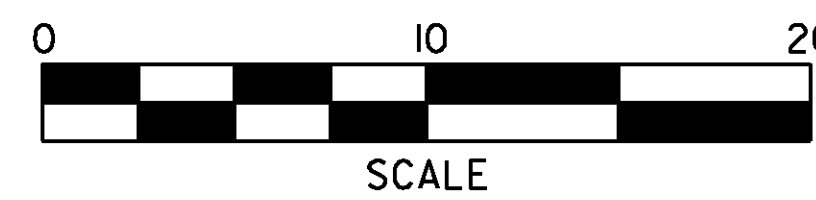

**WESTFORD  
CROSS  
SECTIONS  
SHEET #23**

PROJECT NAME: ESSEX-WESTFORD  
PROJECT NUMBER: STP 2912(I)

FILE NAME: p10c226.dgn  
PROJECT LEADER: JLL  
DESIGNED BY: STANTEC  
IPARM FILE: p10c226xs134.i

PLOT DATE: 2/20/2013  
DRAWN BY: STANTEC  
CHECKED BY: STANTEC  
SHEET 225 OF 239