




47+00.00

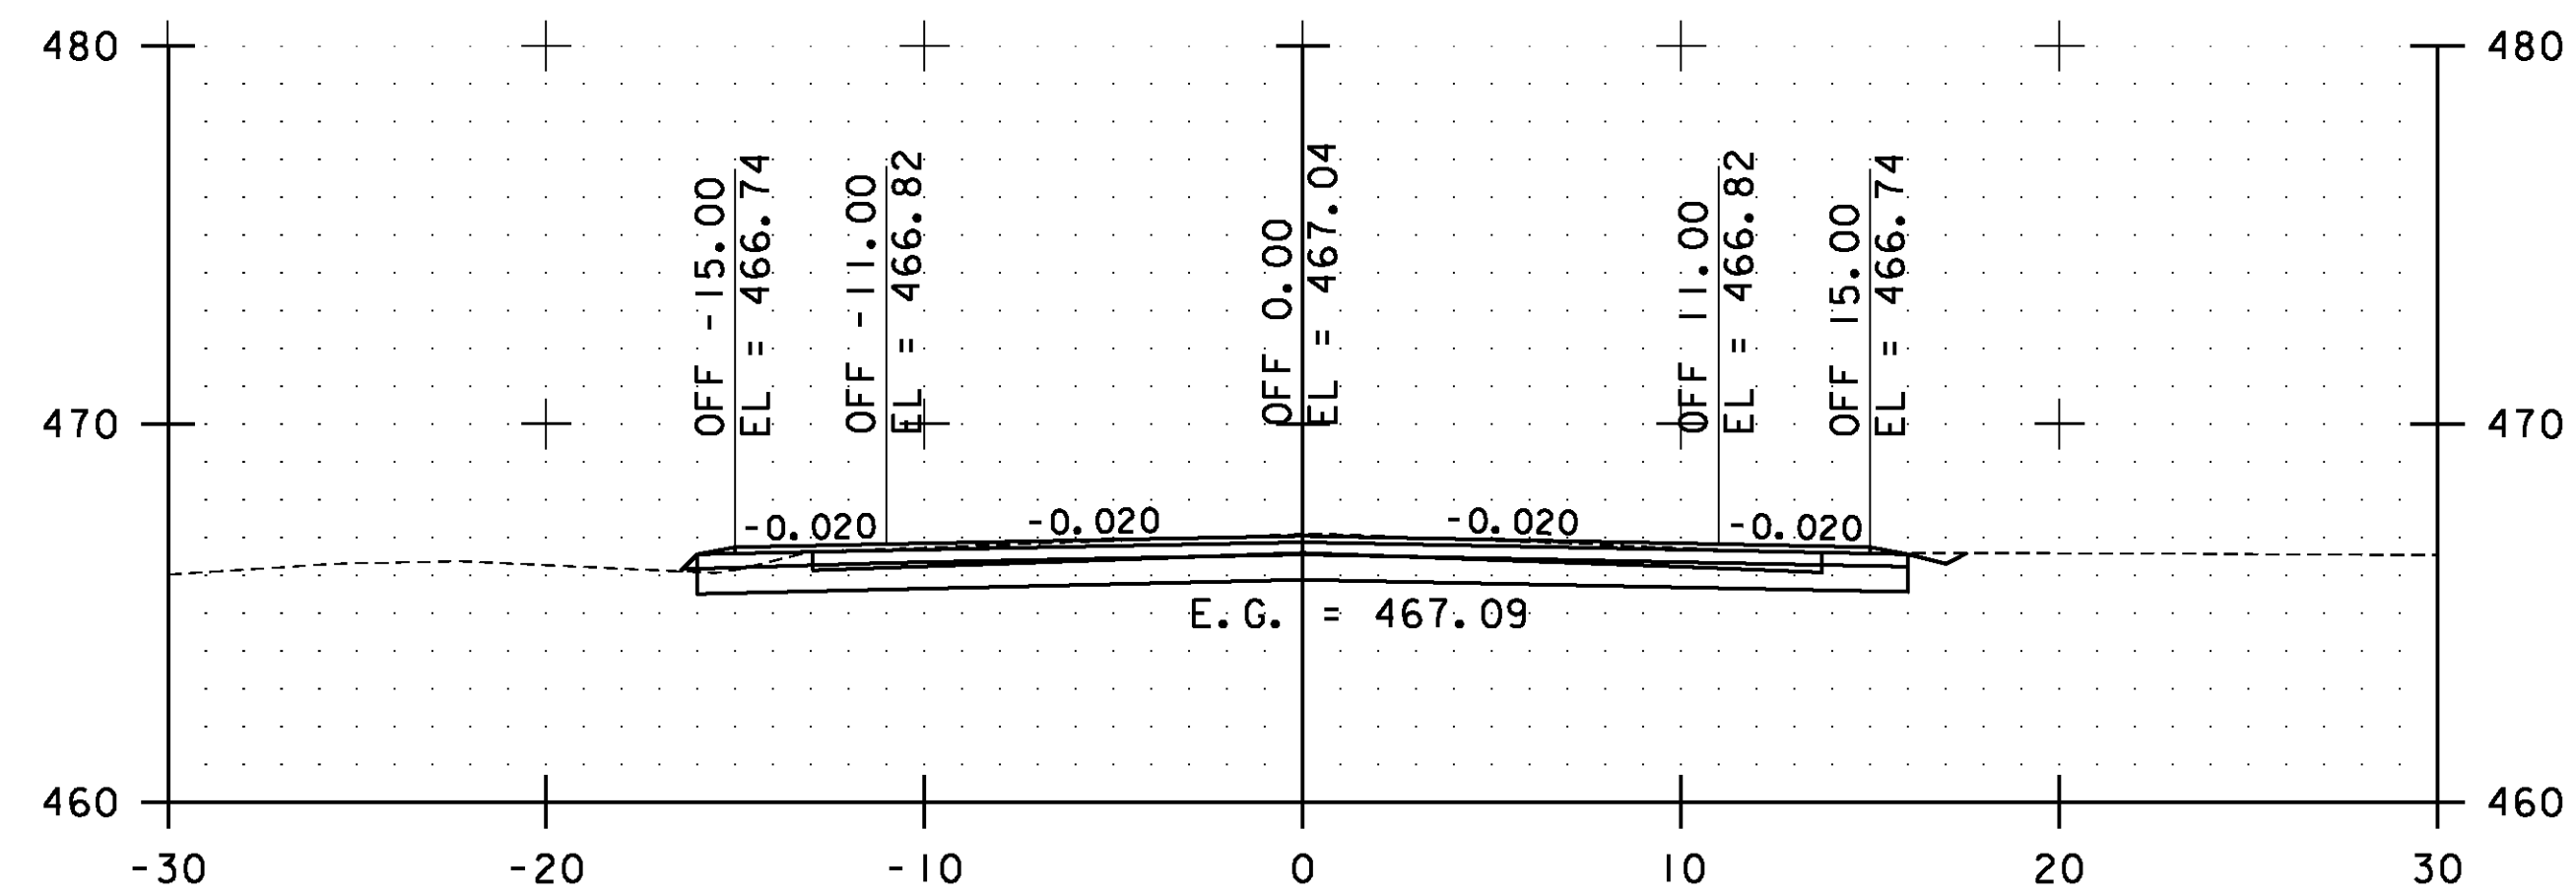

46+50.00

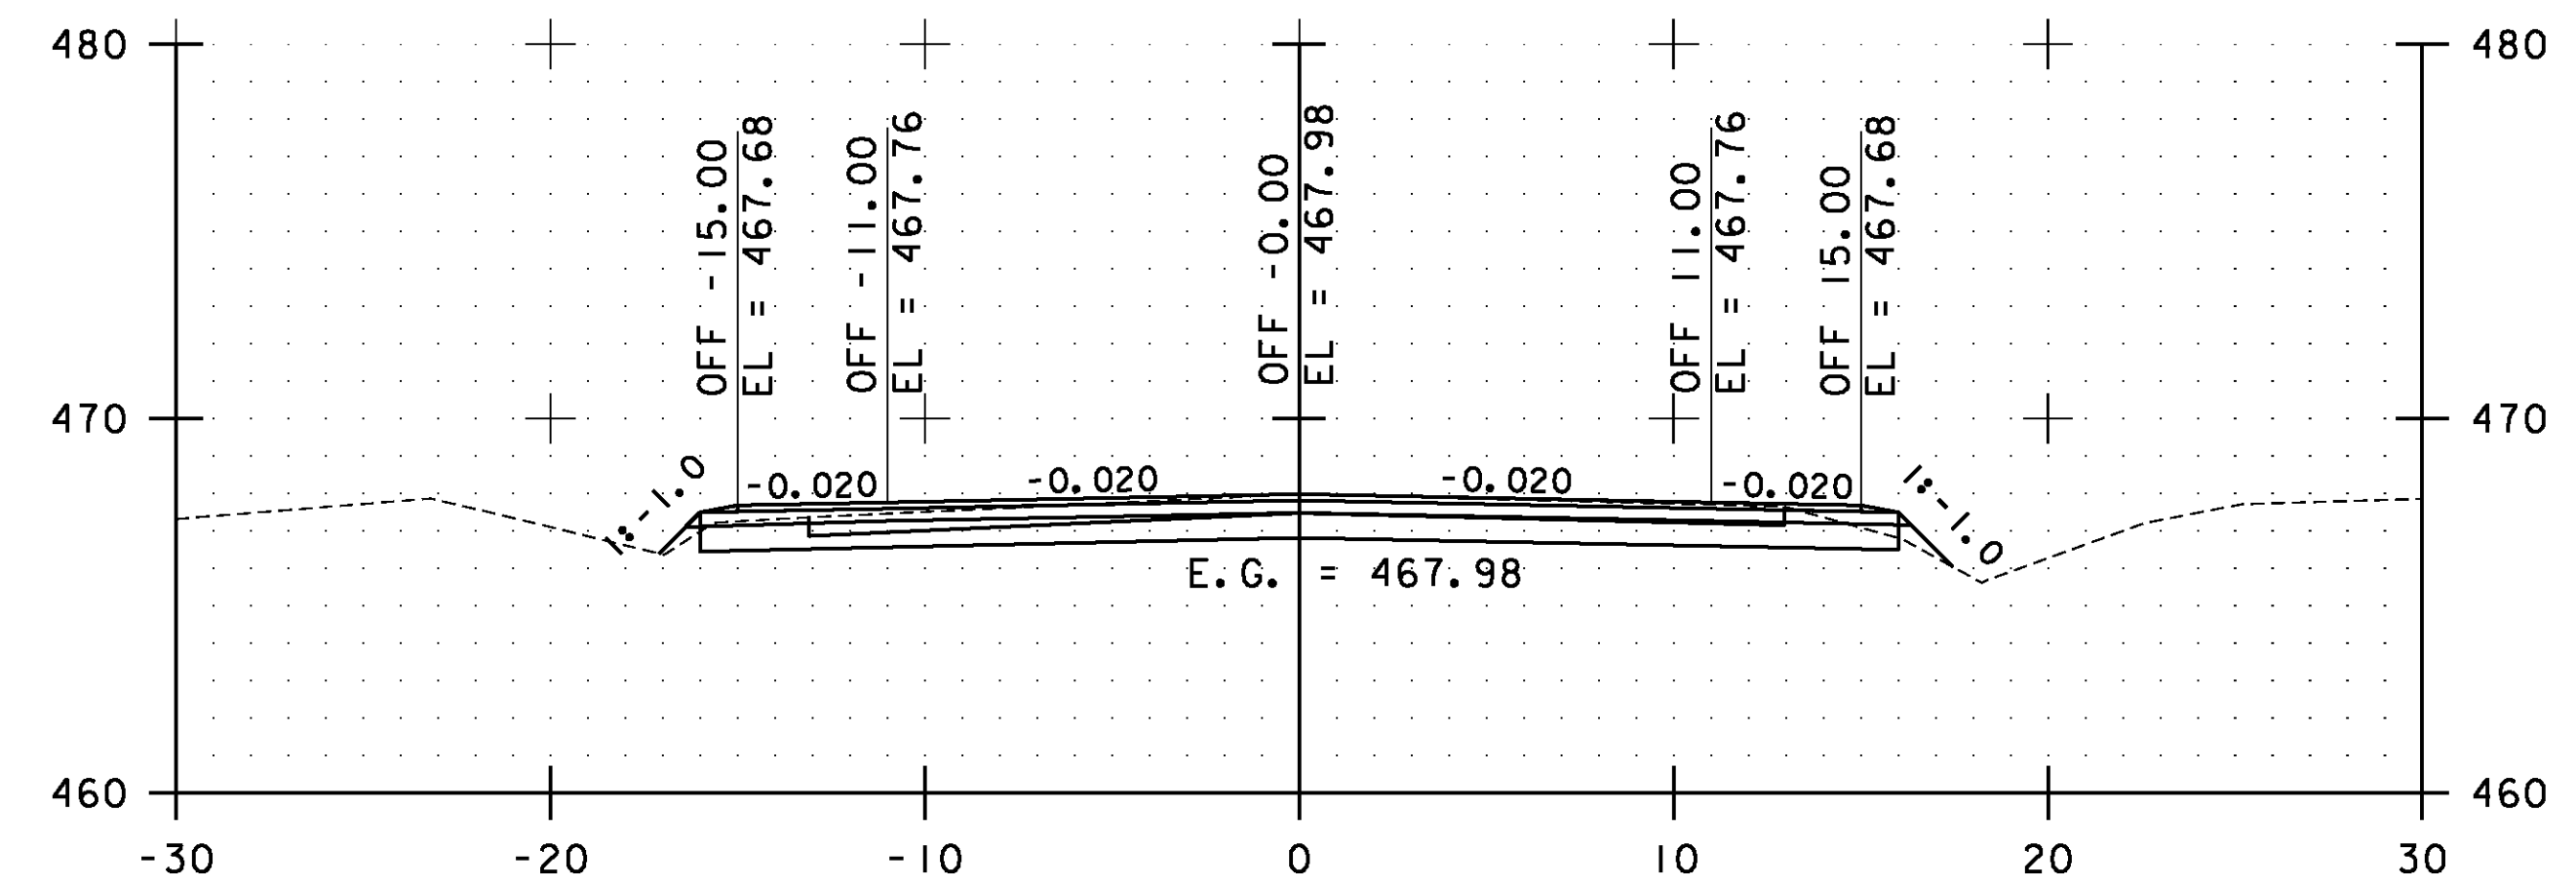


48+00.00

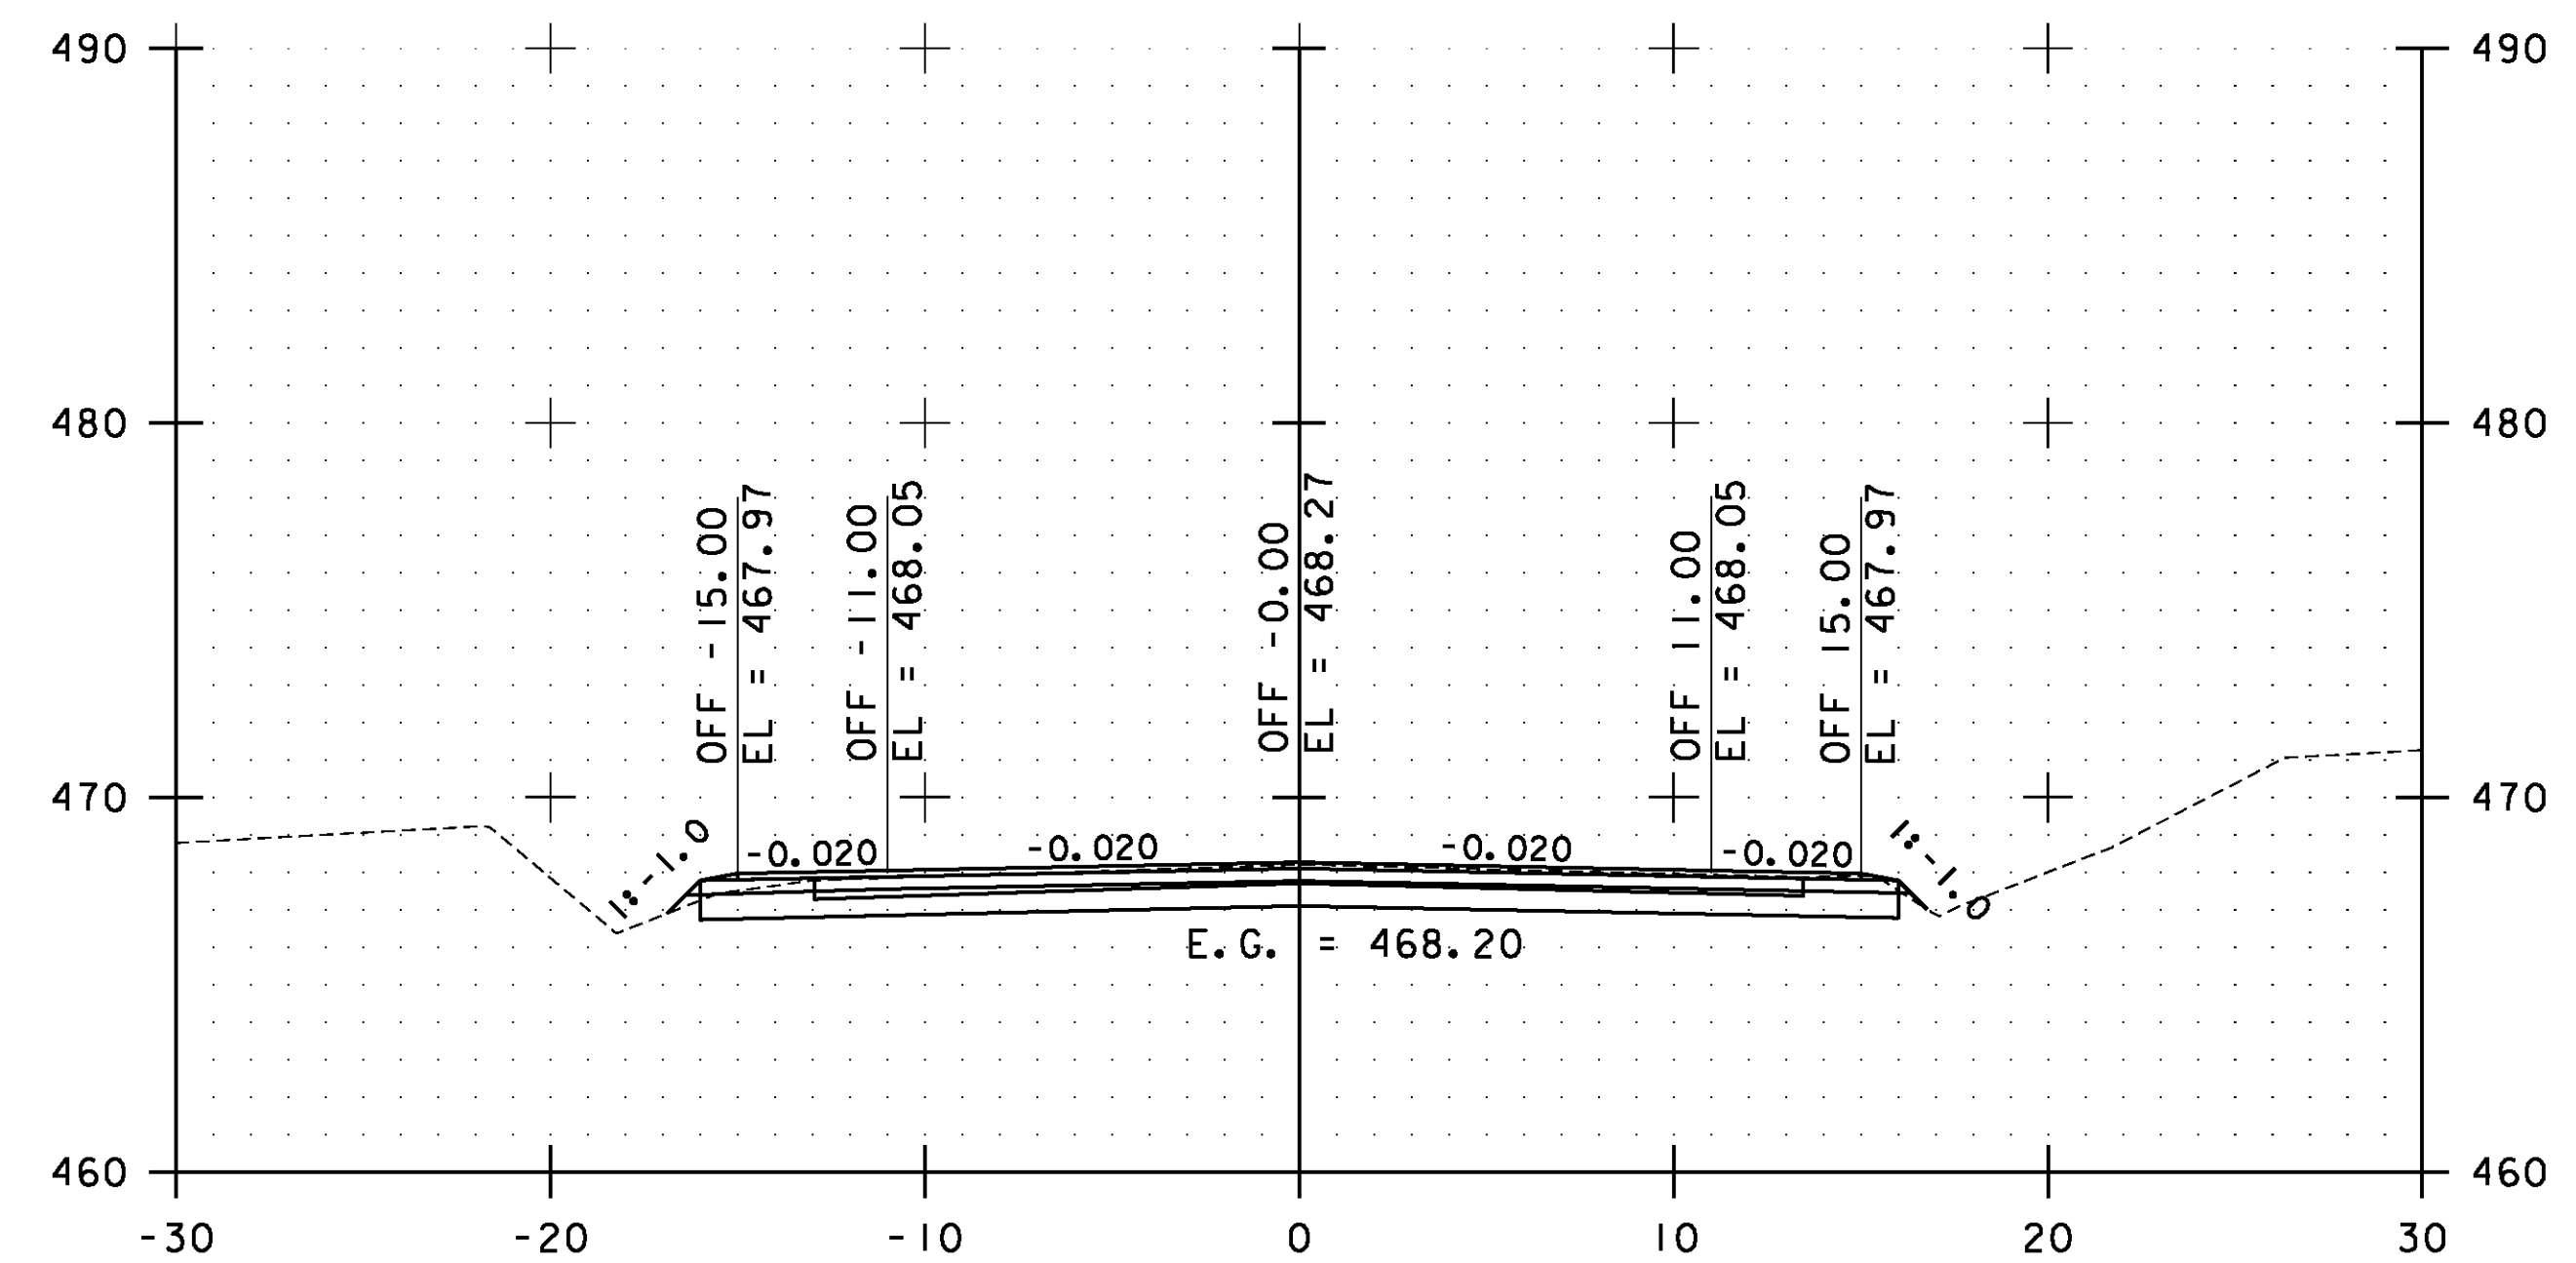

47+50.00

STA. 46+50.00 TO STA. 48+00.00

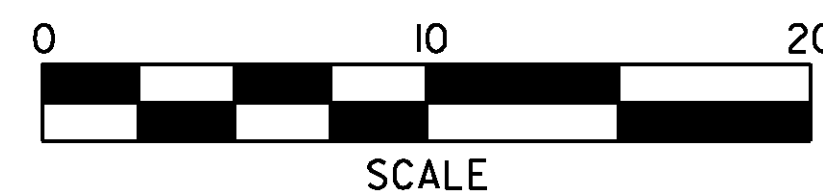

**WESTFORD
CROSS
SECTIONS
SHEET #24**

PROJECT NAME: ESSEX-WESTFORD
PROJECT NUMBER: STP 2912(I)

FILE NAME: p10c226.dgn
PROJECT LEADER: JLL
DESIGNED BY: STANTEC
IPARM FILE: p10c226xs135.i

PLOT DATE: 2/20/2013
DRAWN BY: STANTEC
CHECKED BY: STANTEC
SHEET 226 OF 239