




61+00.00

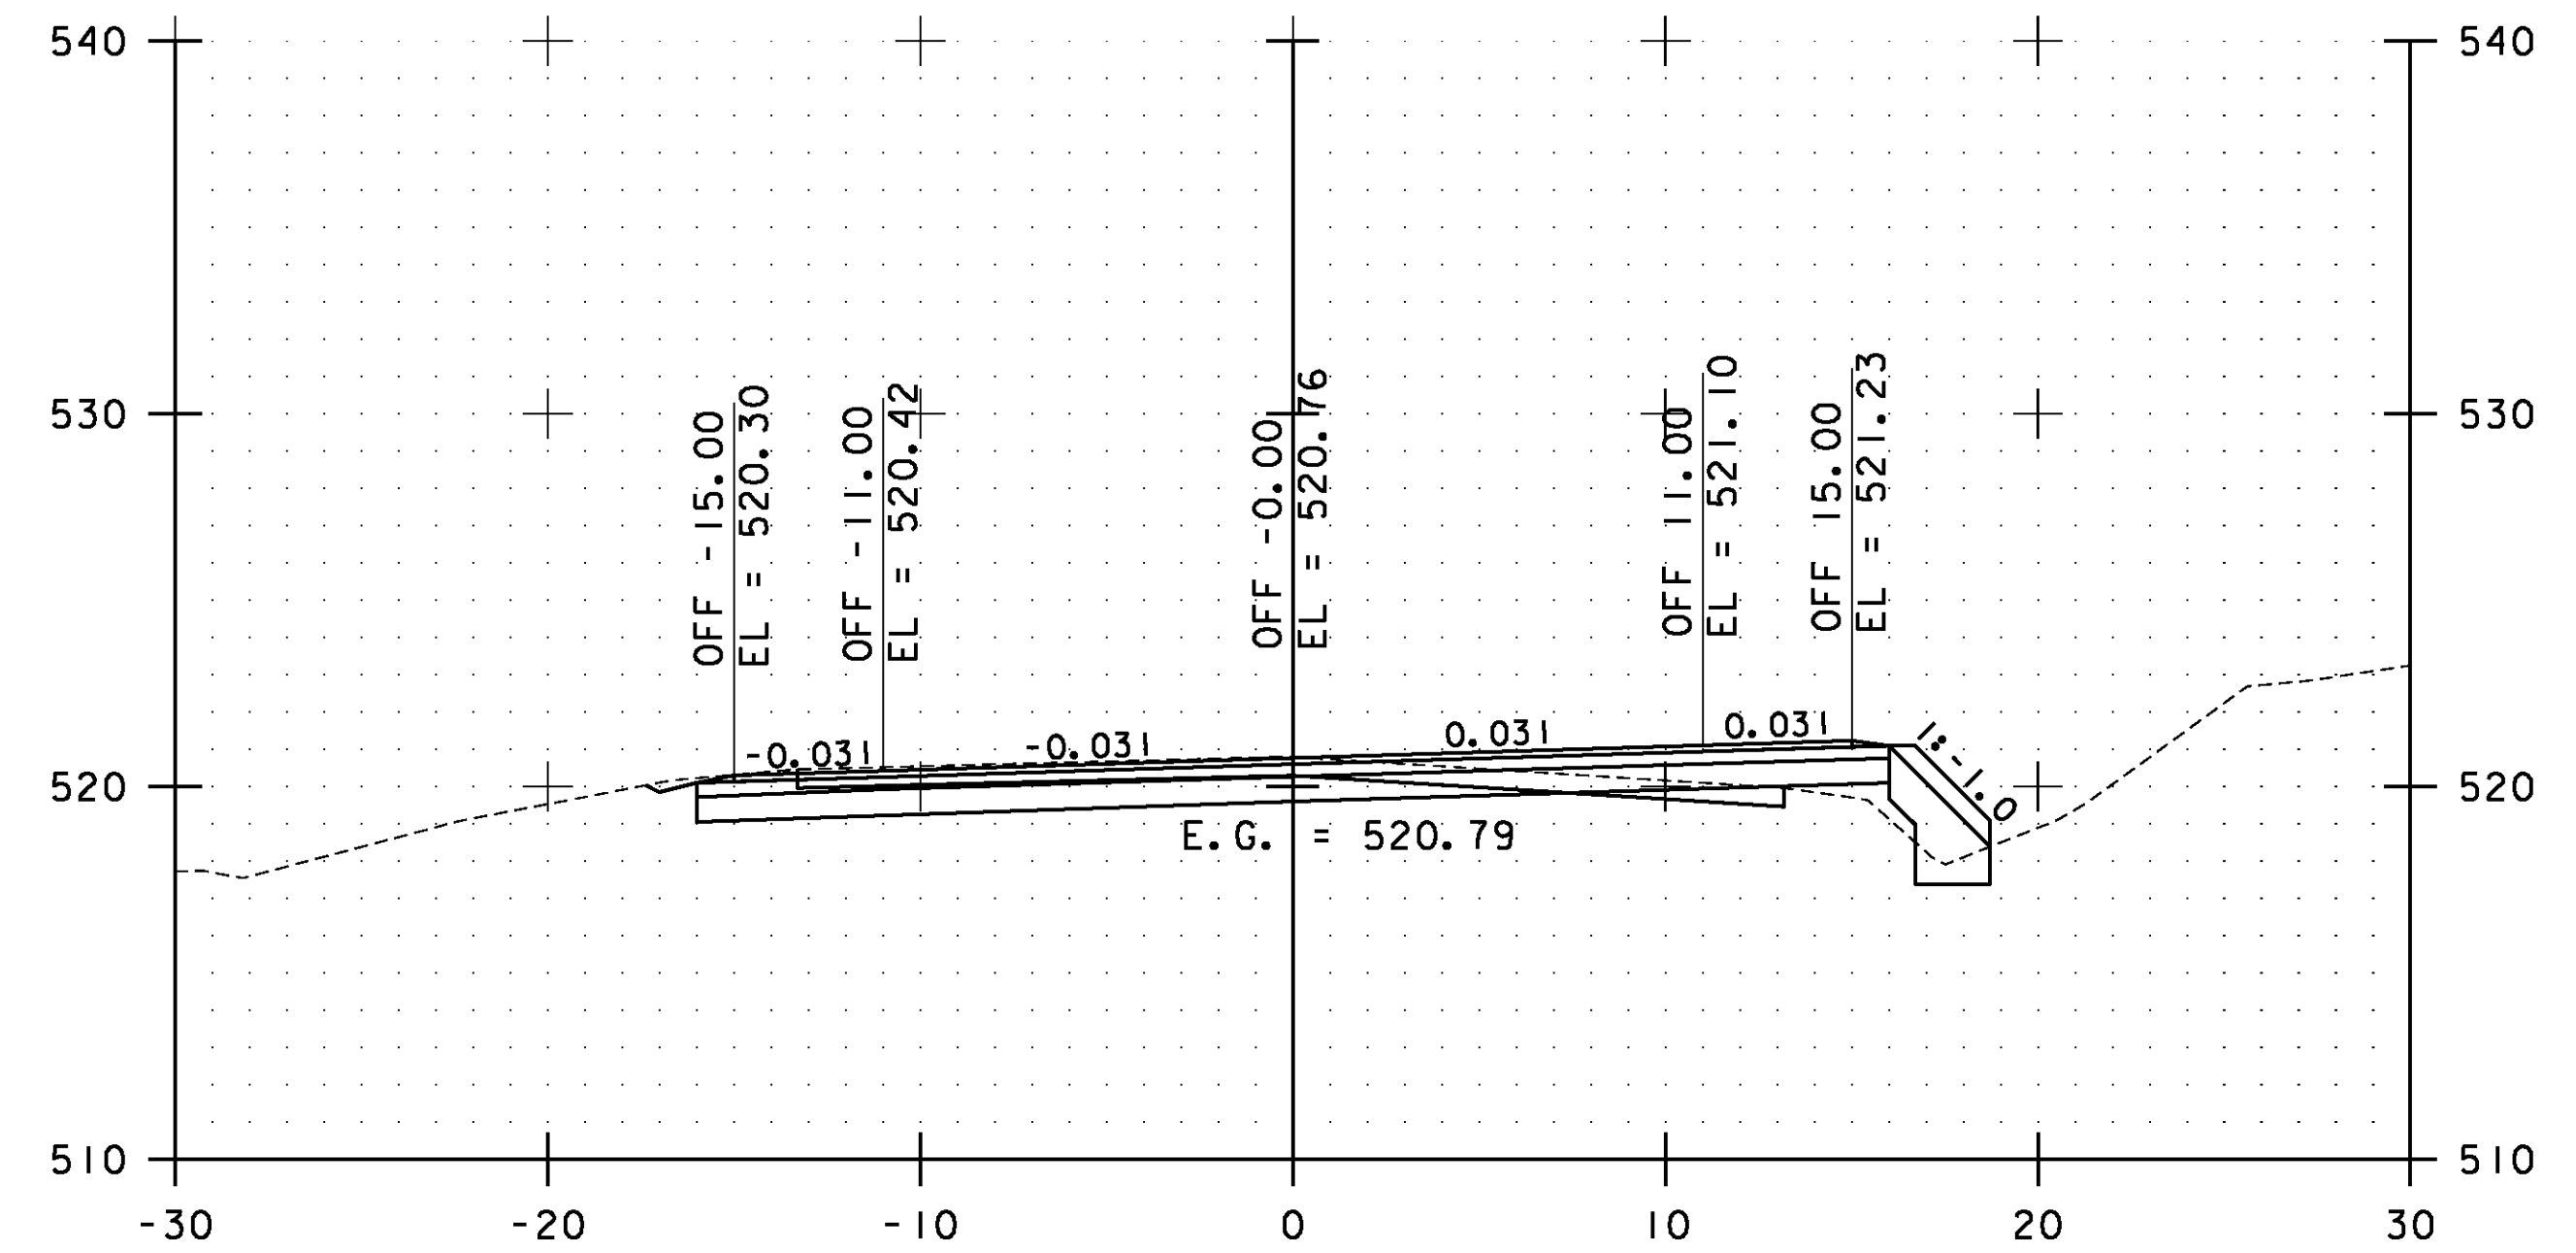

62+00.00

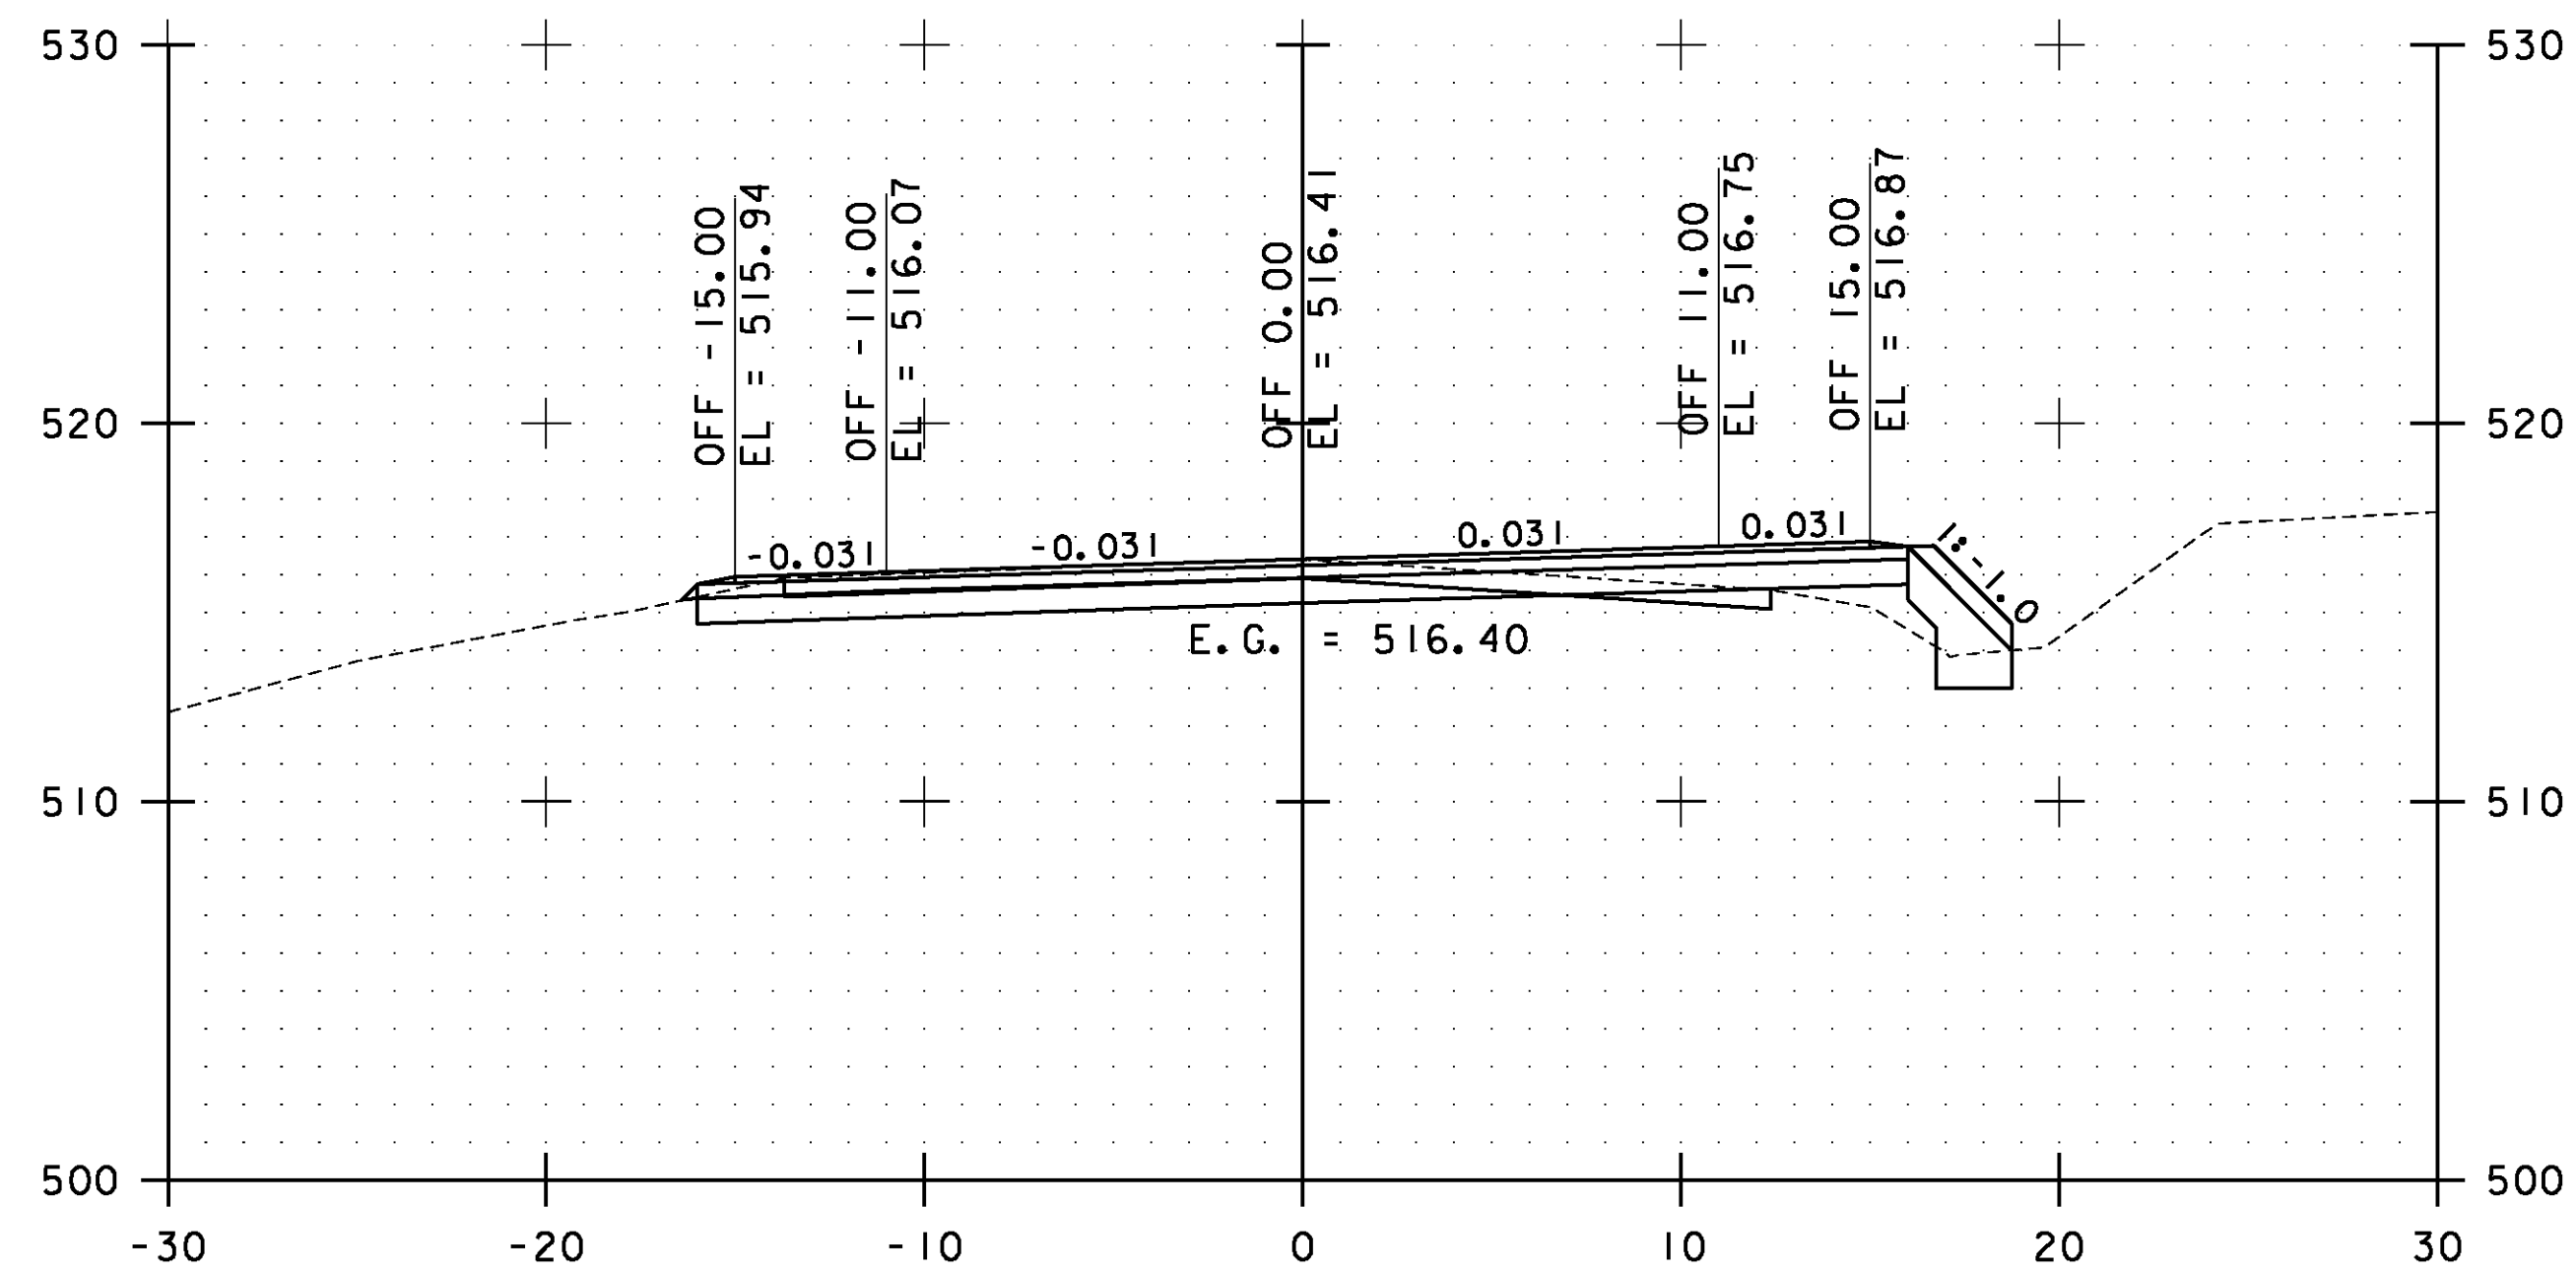


60+50.00

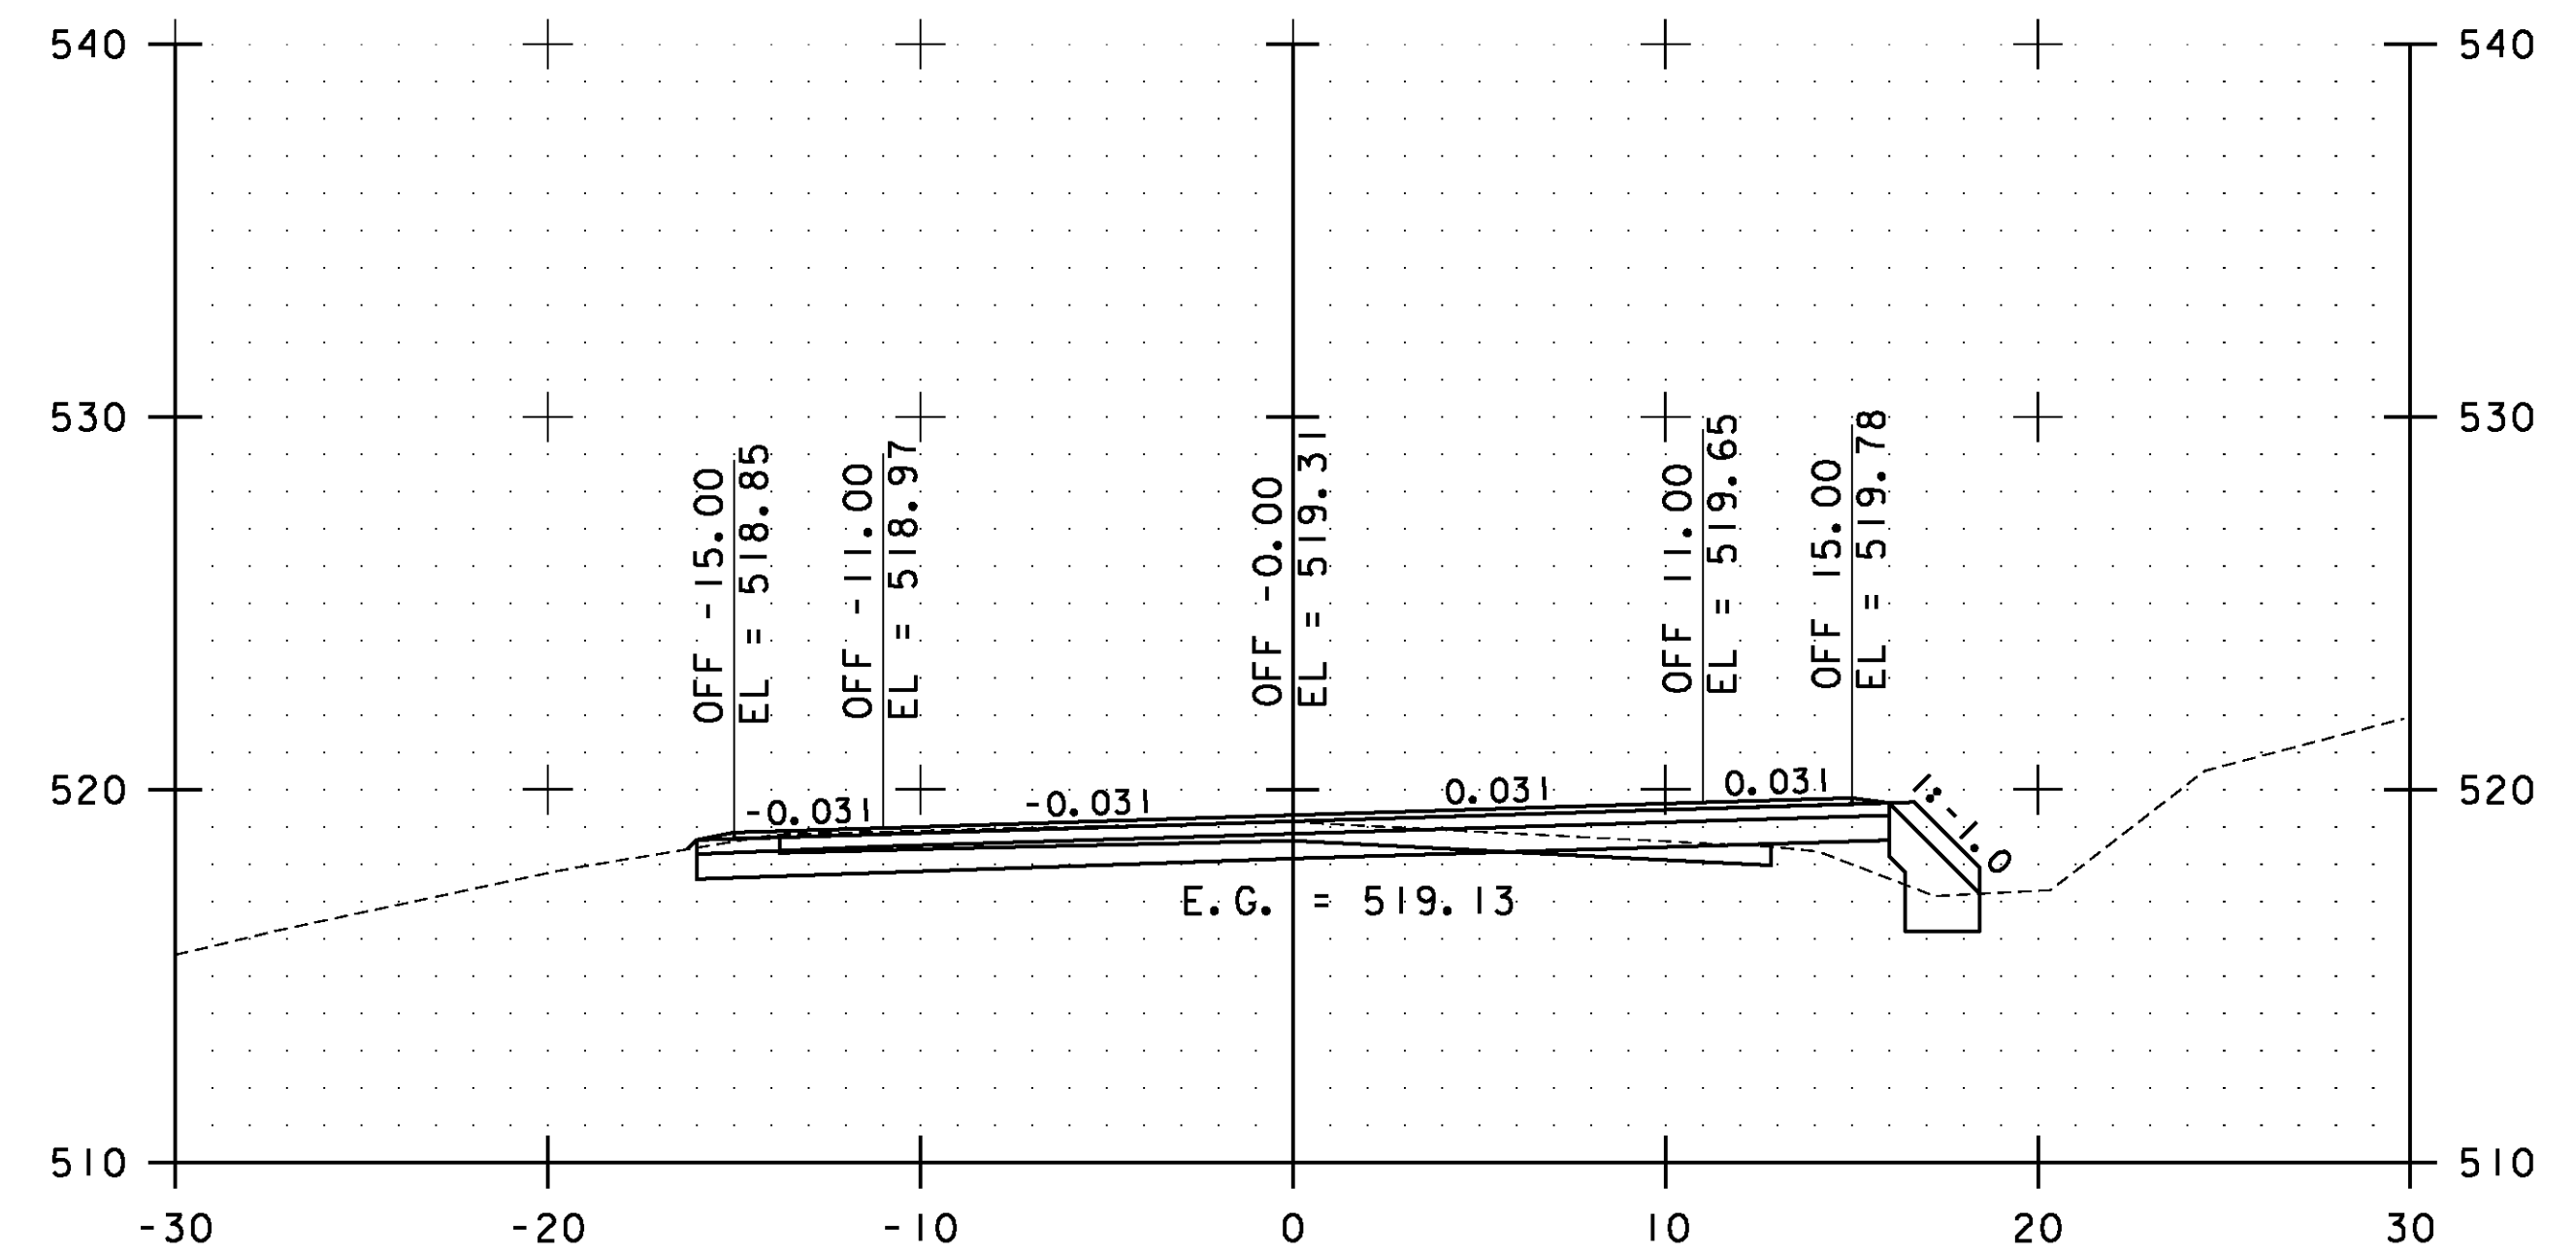

61+50.00

STA. 60+50.00 TO STA. 62+00.00

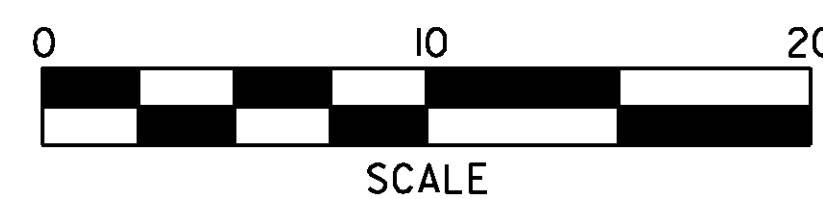

**WESTFORD
CROSS
SECTIONS
SHEET #32**

PROJECT NAME: ESSEX-WESTFORD
PROJECT NUMBER: STP 2912(I)

FILE NAME: p10c226.dgn
PROJECT LEADER: JLL
DESIGNED BY: STANTEC
IPARM FILE: p10c226xs143.i

PLOT DATE: 2/20/2013
DRAWN BY: STANTEC
CHECKED BY: STANTEC
SHEET 234 OF 239