




67+00.00

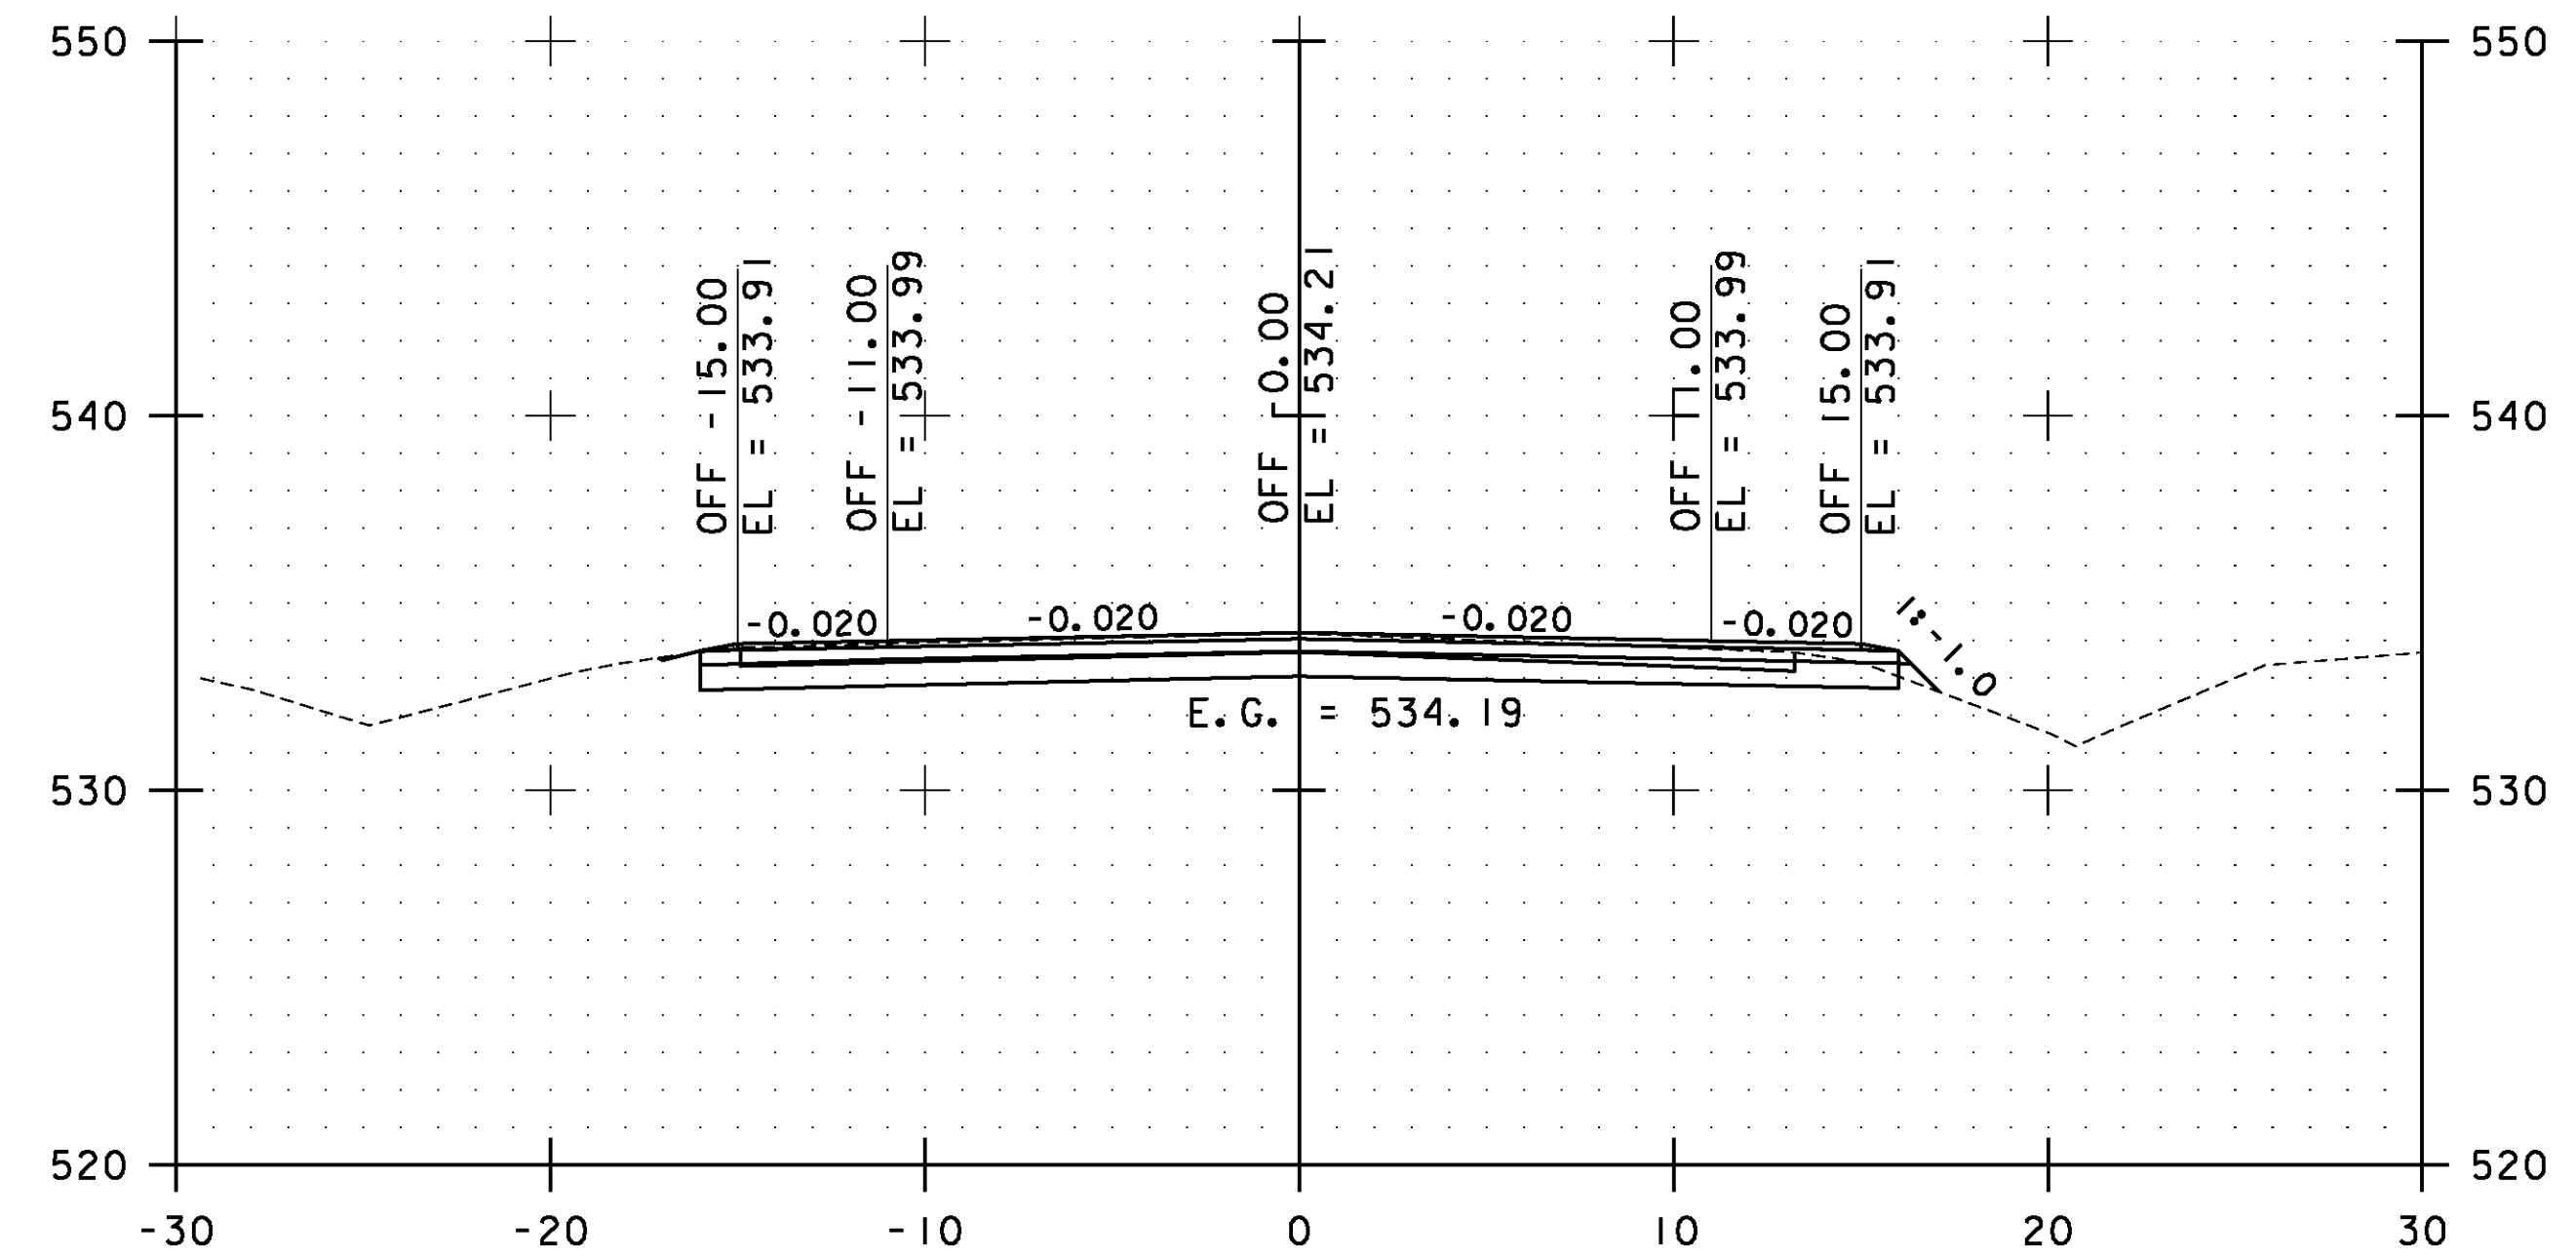

68+00.00

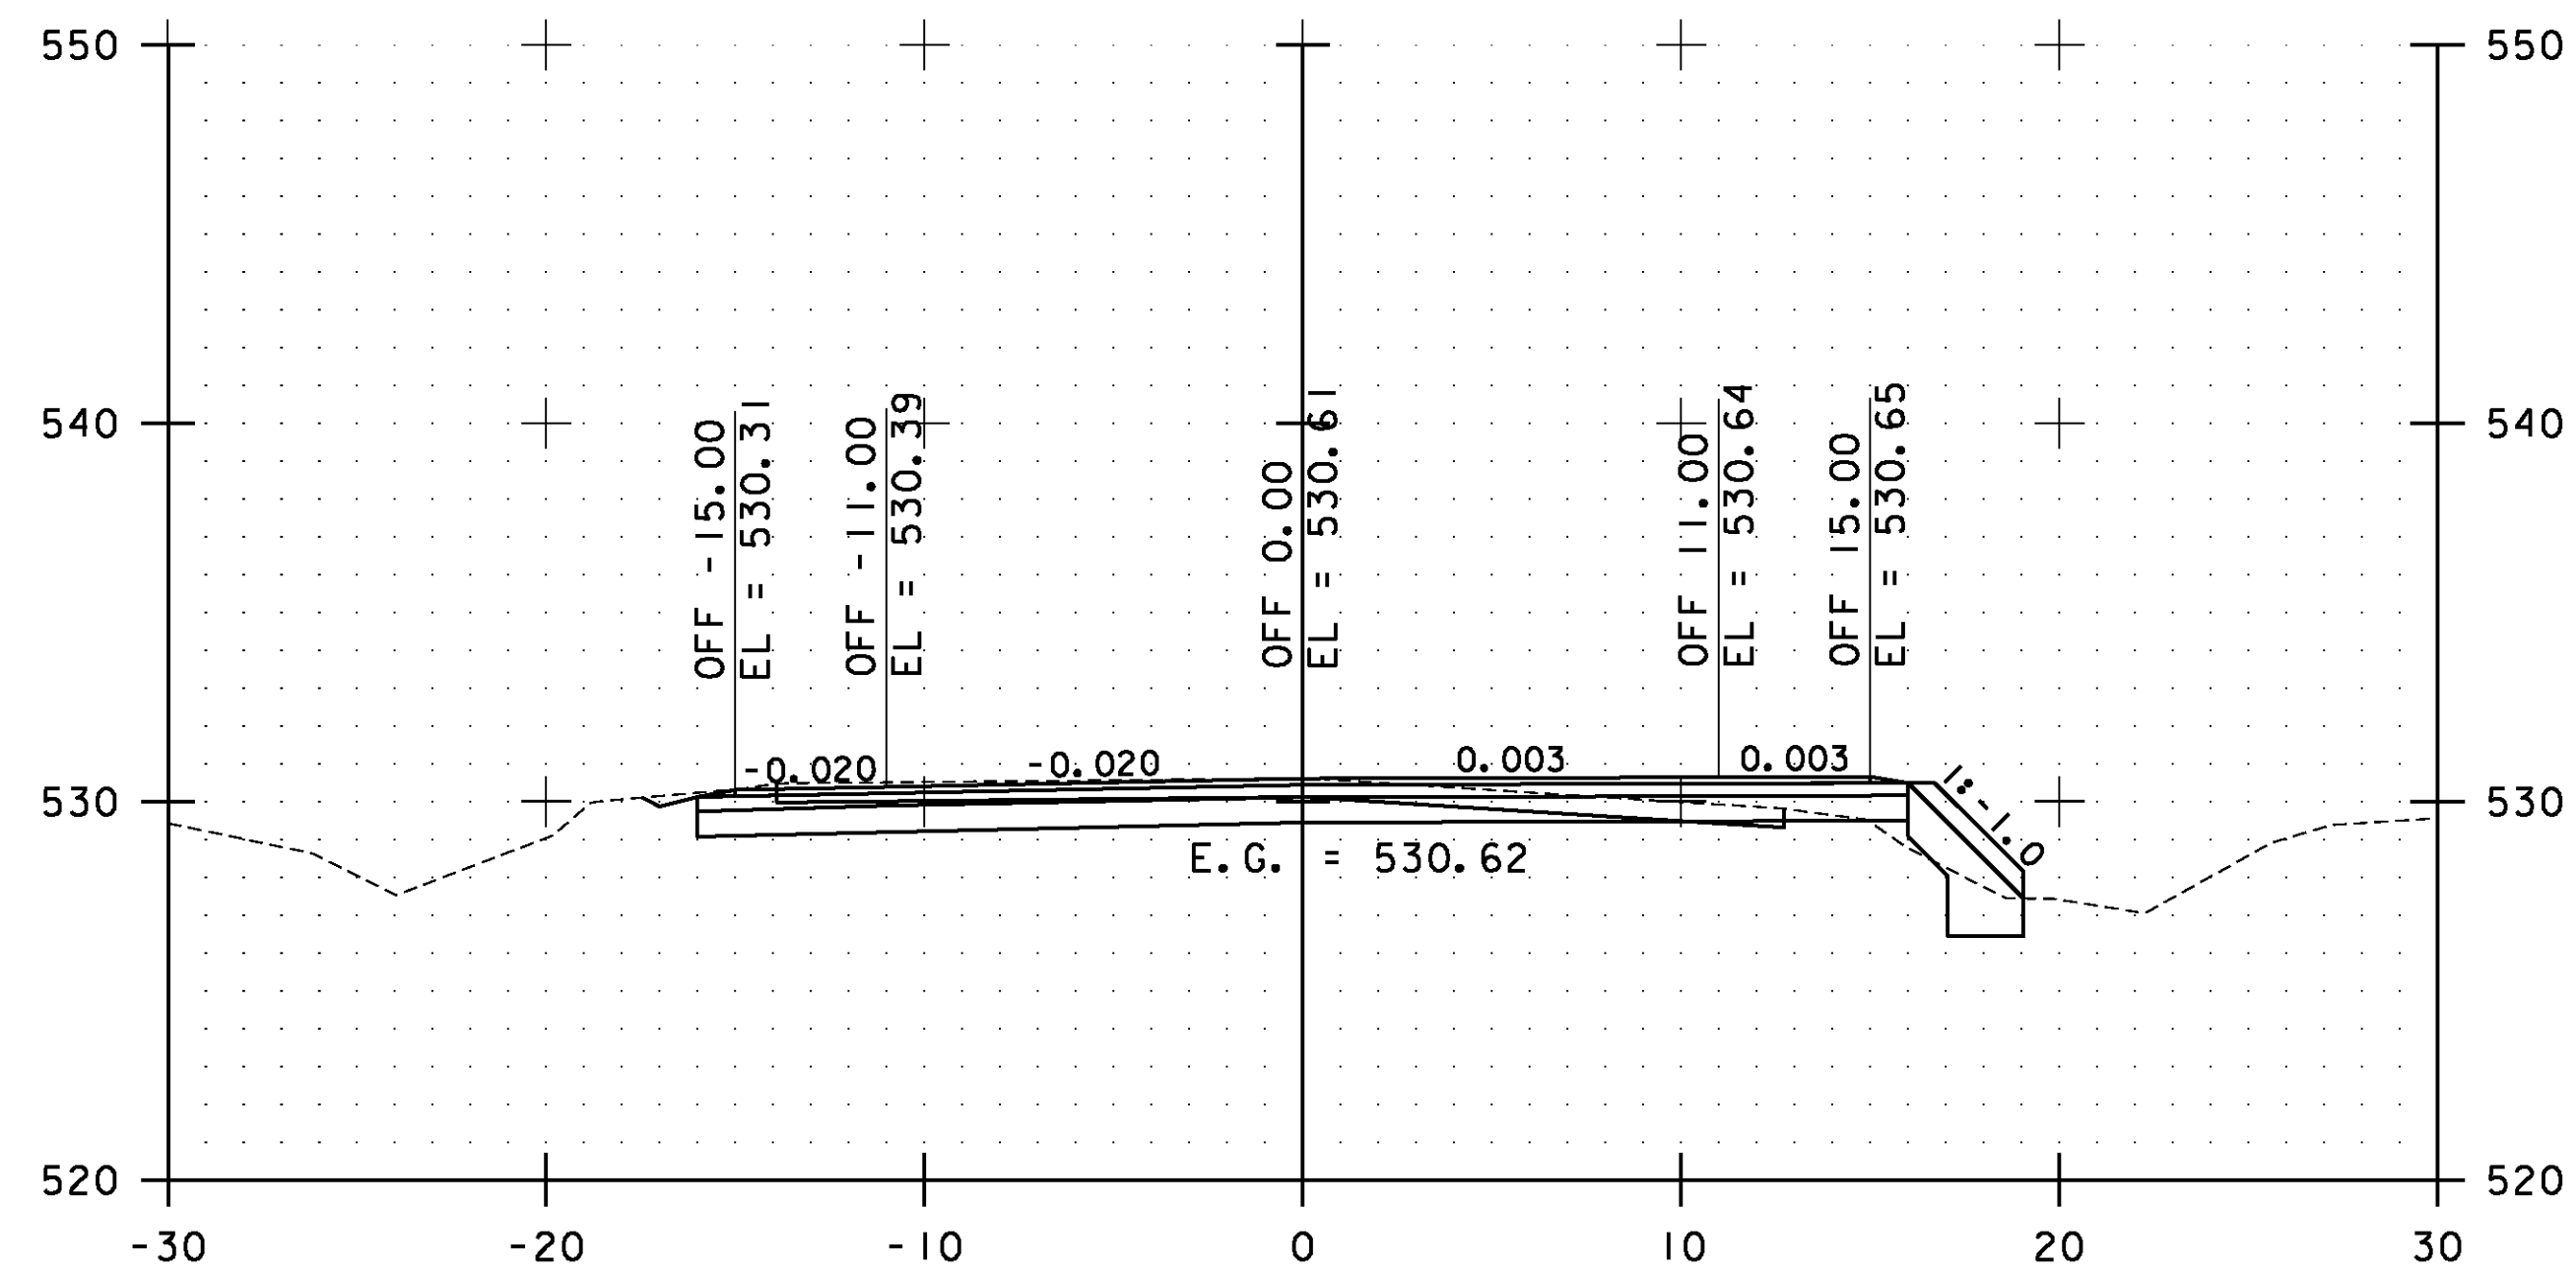


66+50.00

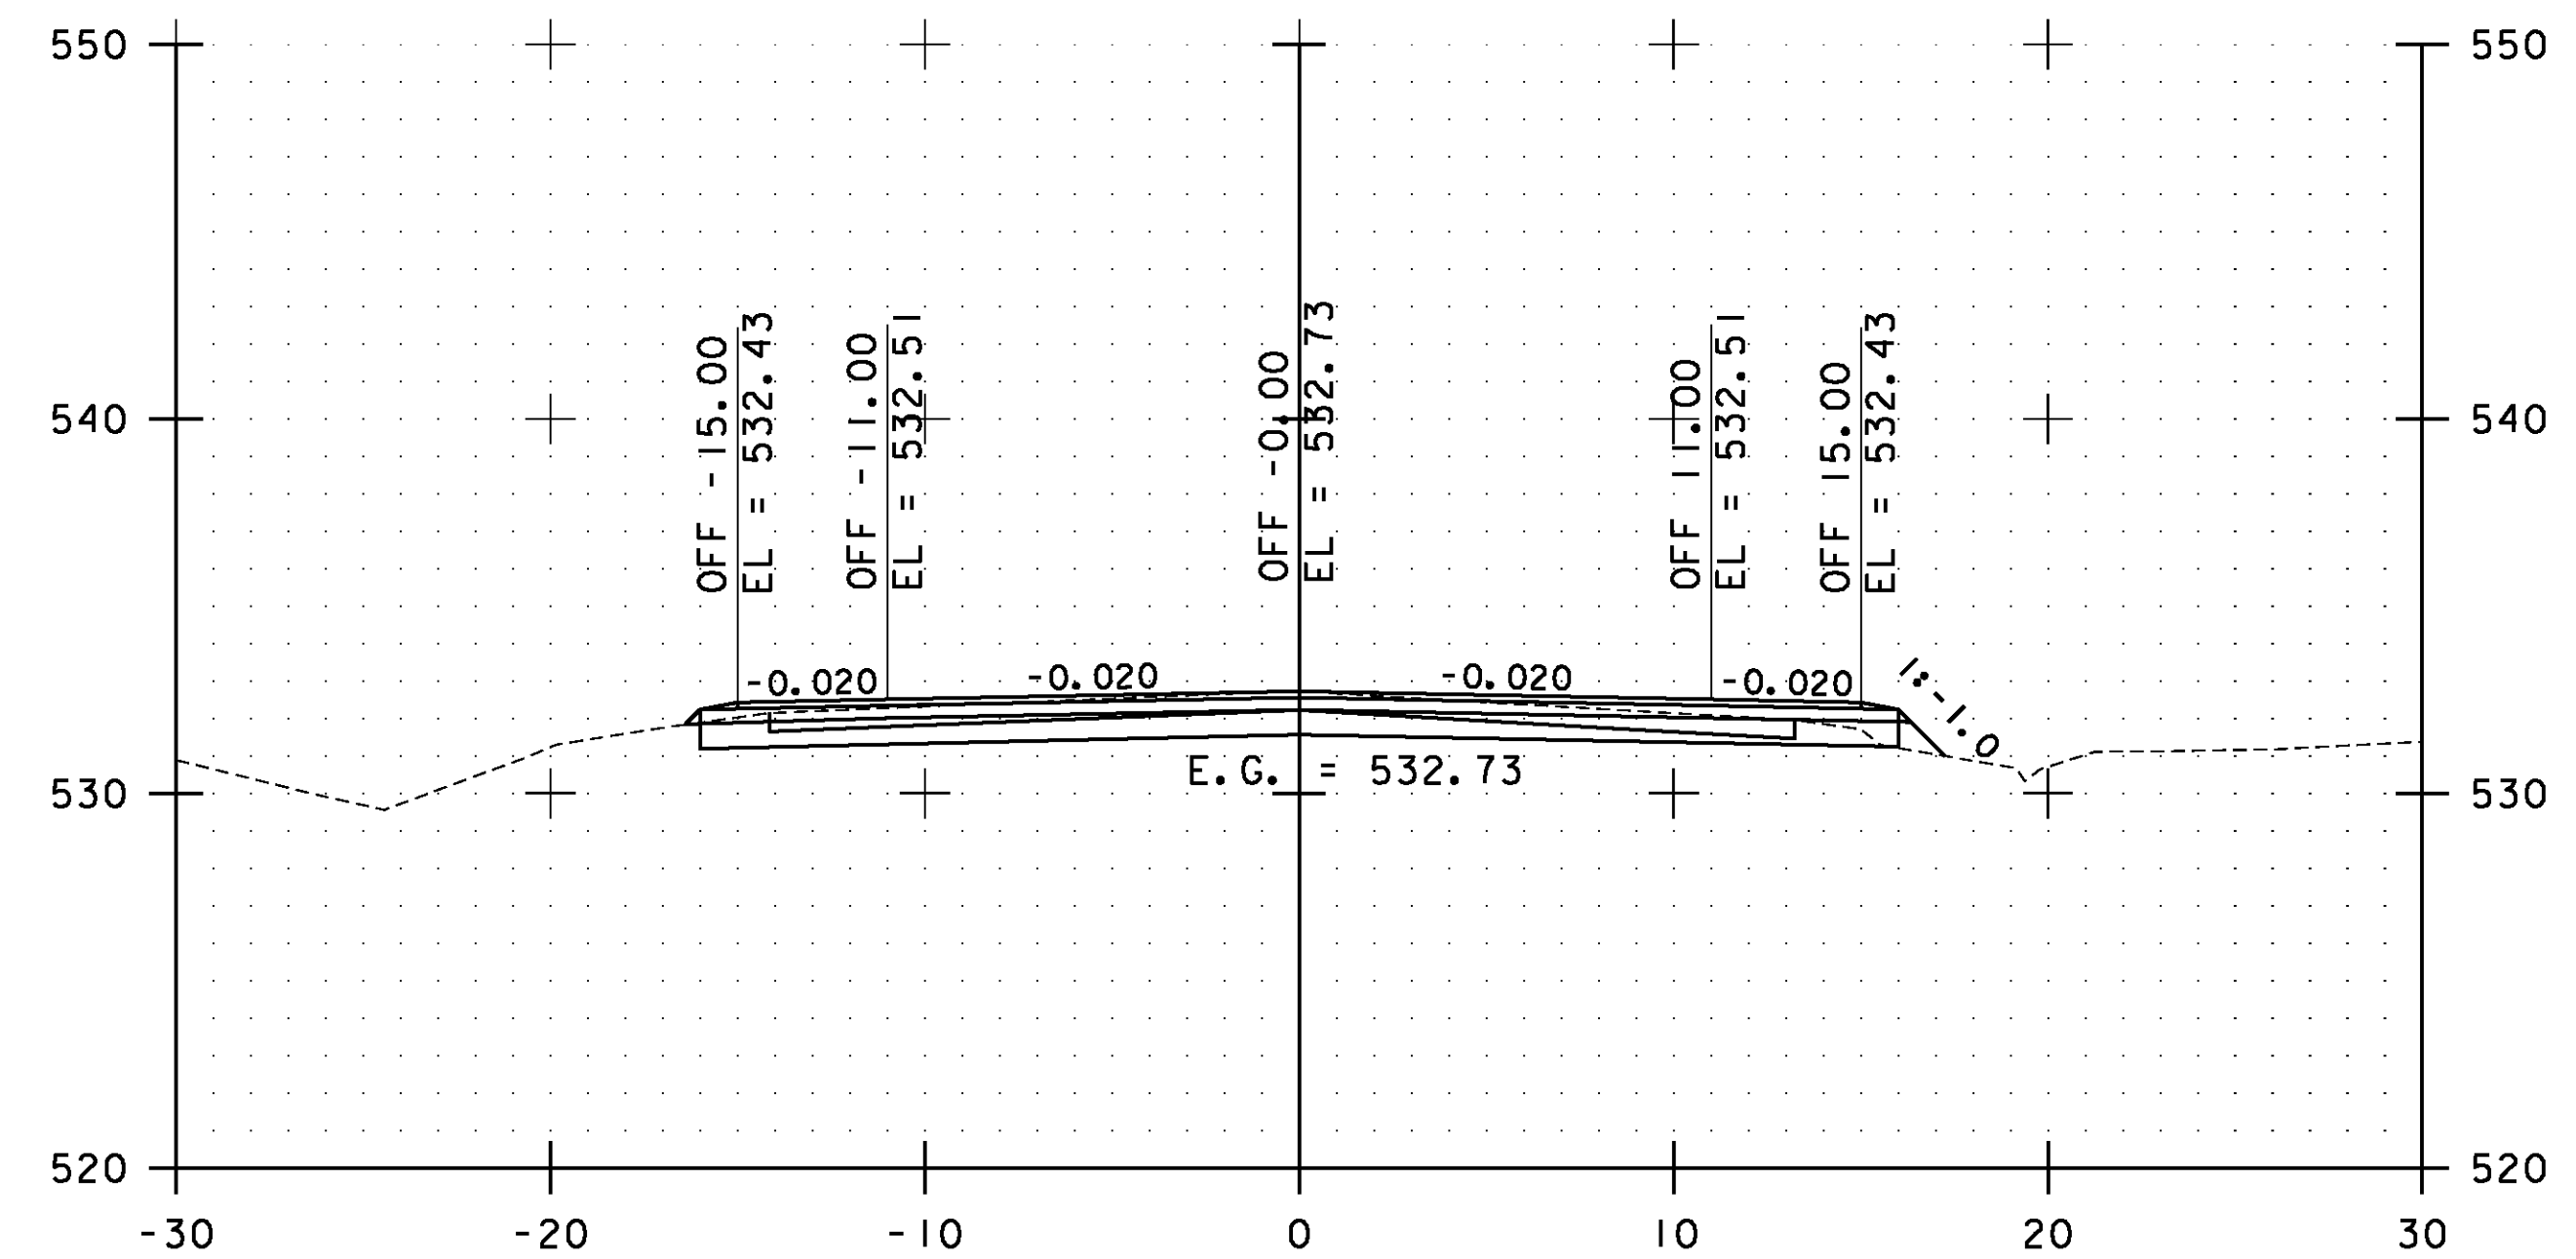

67+50.00

STA. 66+50.00 TO STA. 68+00.00

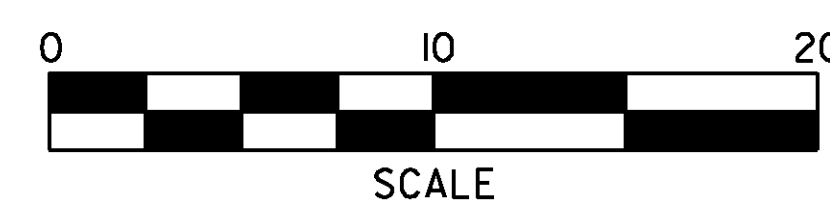

**WESTFORD  
CROSS  
SECTIONS  
SHEET #35**

PROJECT NAME: ESSEX-WESTFORD	PLOT DATE: 2/20/2013
PROJECT NUMBER: STP 2912(I)	DRAWN BY: STANTEC
FILE NAME: p10c226.dgn	CHECKED BY: STANTEC
PROJECT LEADER: JLL	SHEET 237 OF 239
DESIGNED BY: STANTEC	
IPARM FILE: p10c226xs146.i	