



68+85.12 END STP 2912 (1)

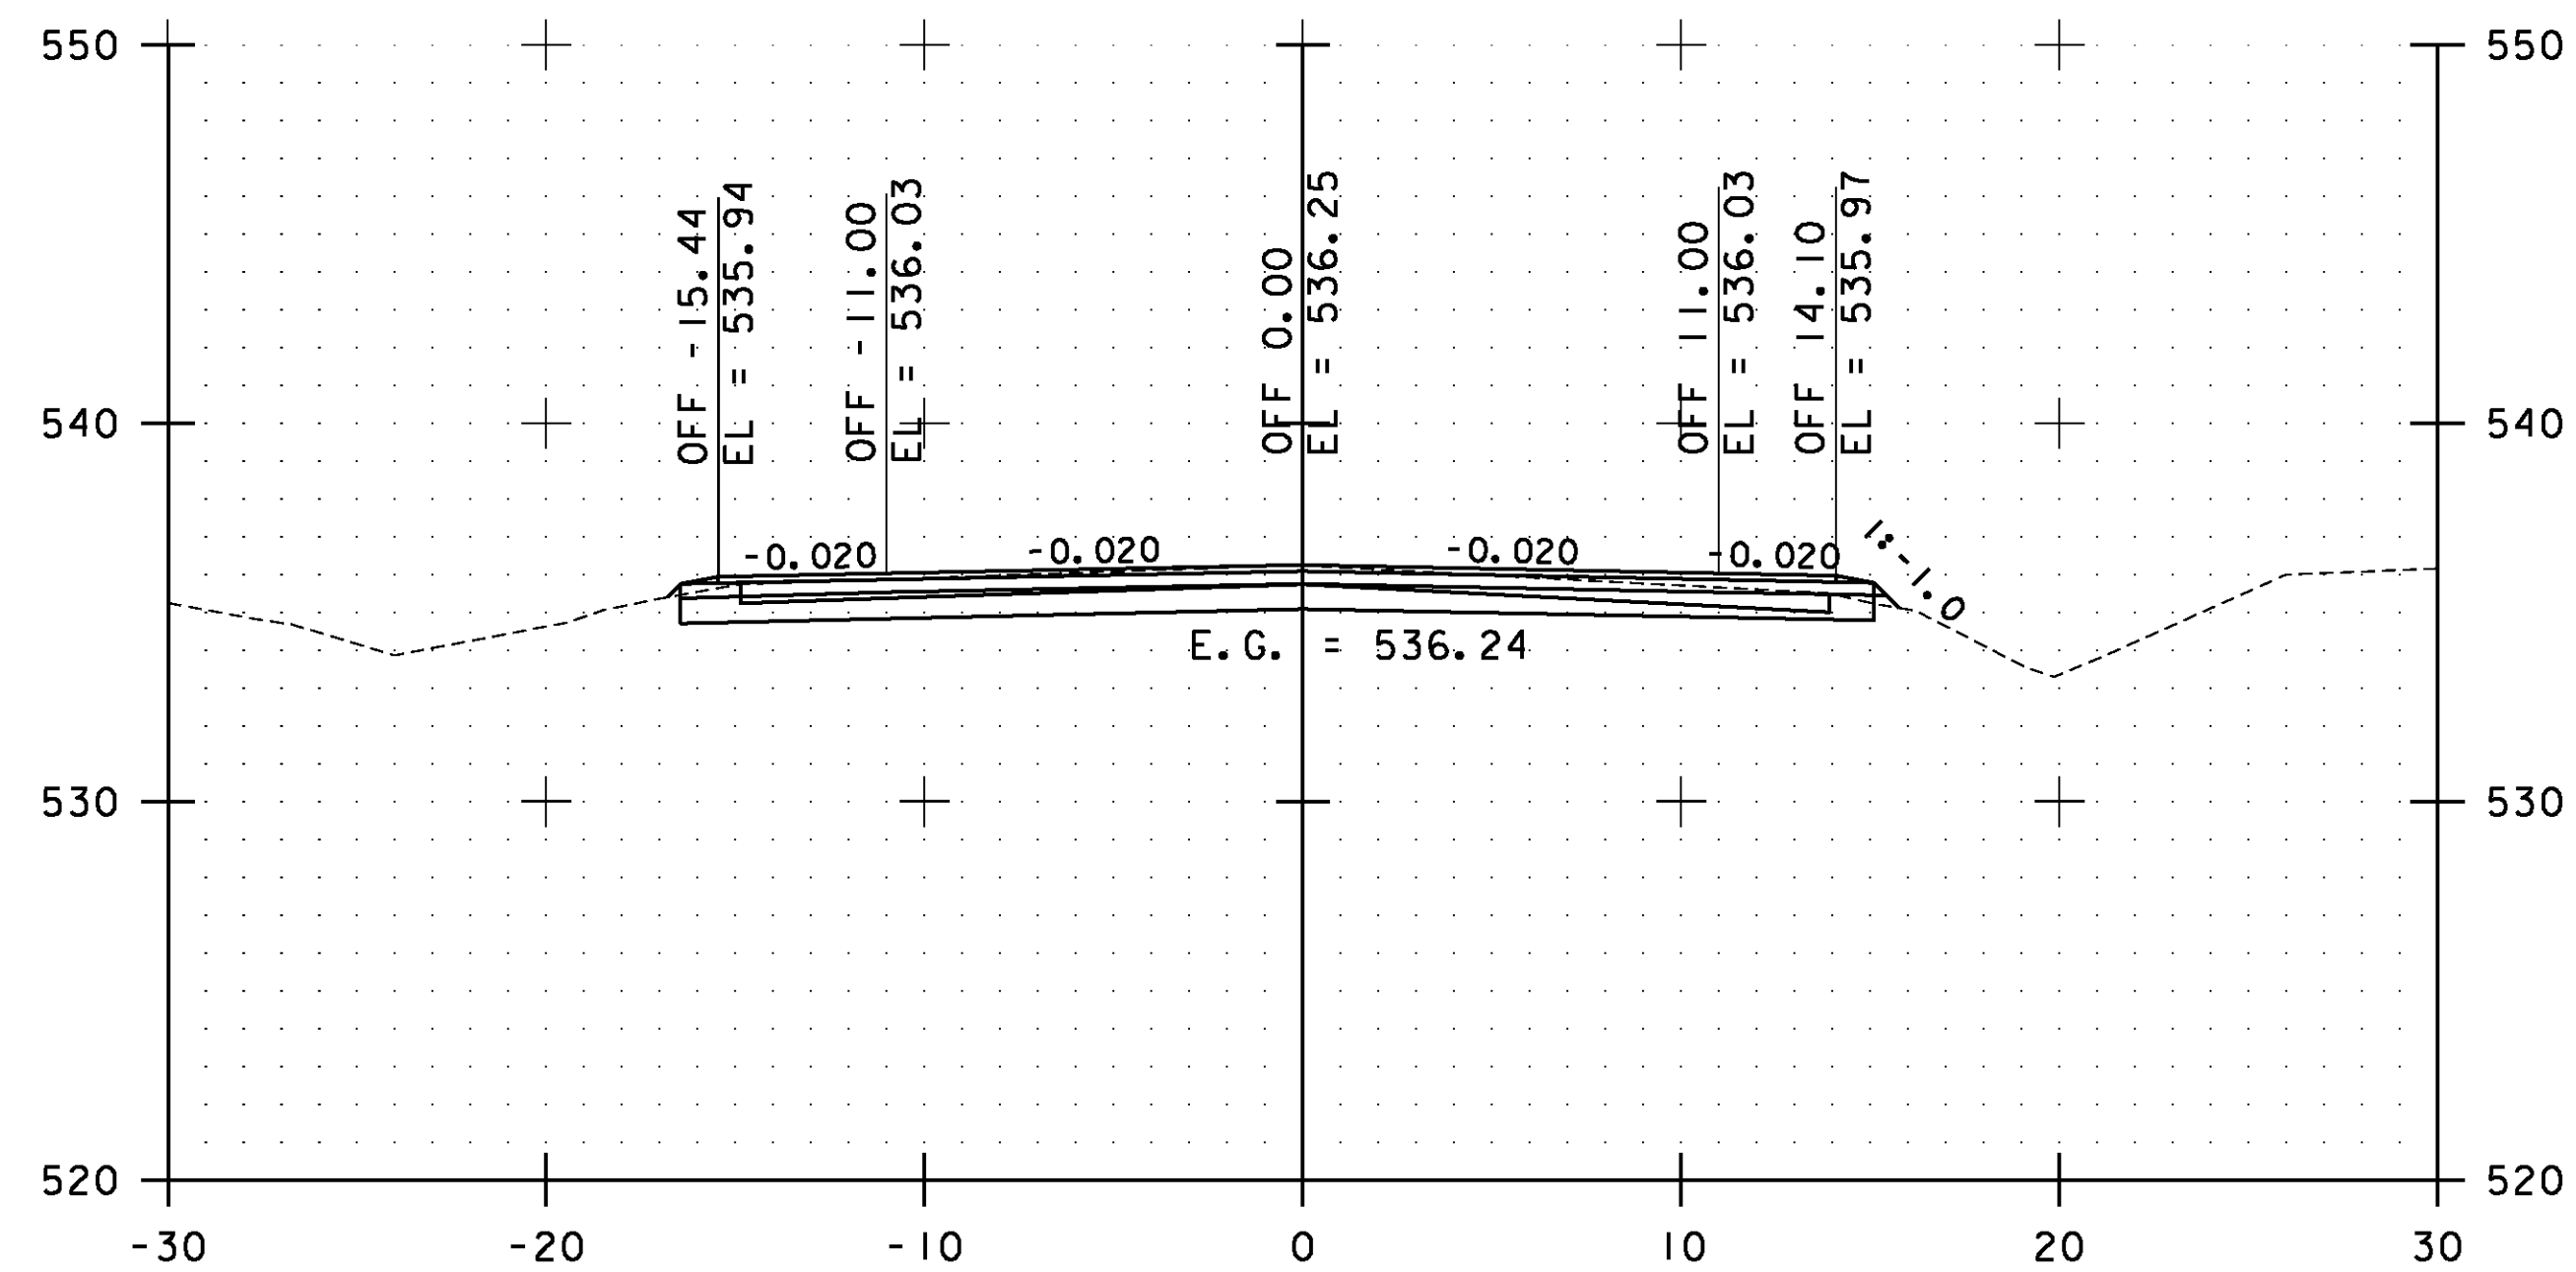

68+50.00

STA. 68+50.00 TO STA. 68+85.12

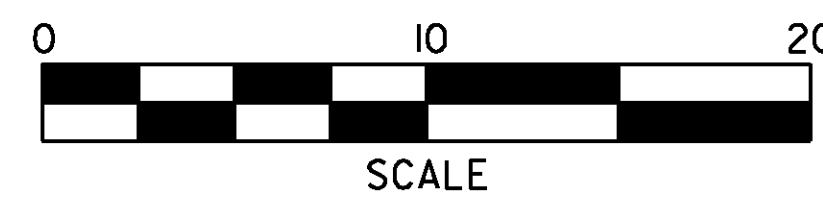

**WESTFORD
CROSS
SECTIONS
SHEET #36**

PROJECT NAME: ESSEX-WESTFORD
PROJECT NUMBER: STP 2912(1)

FILE NAME: p10c226.dgn
PROJECT LEADER: JLL
DESIGNED BY: STANTEC
IPARM FILE: p10c226xs147.i

PLOT DATE: 2/20/2013
DRAWN BY: STANTEC
CHECKED BY: STANTEC
SHEET 238 OF 239