
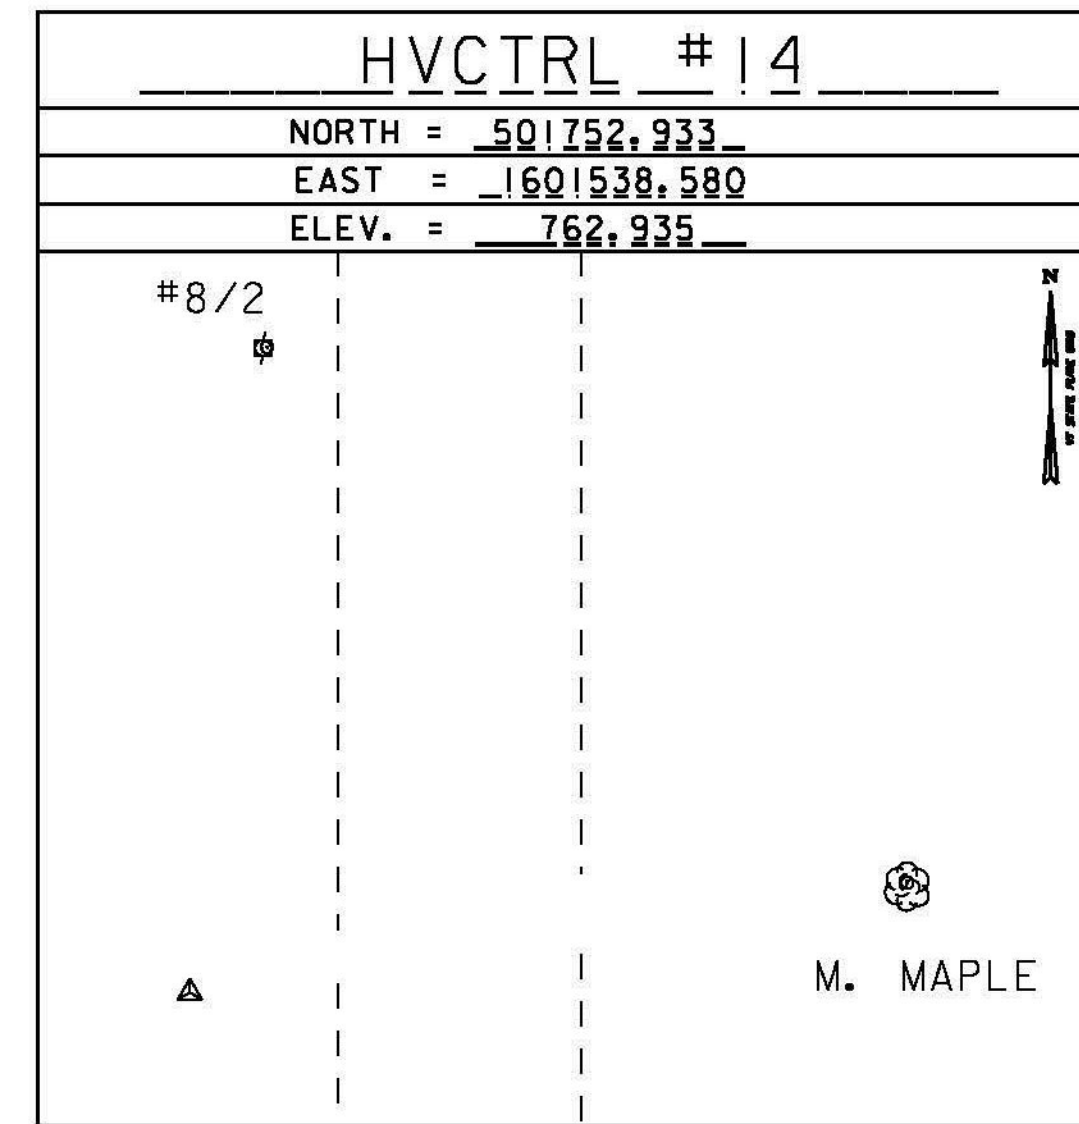
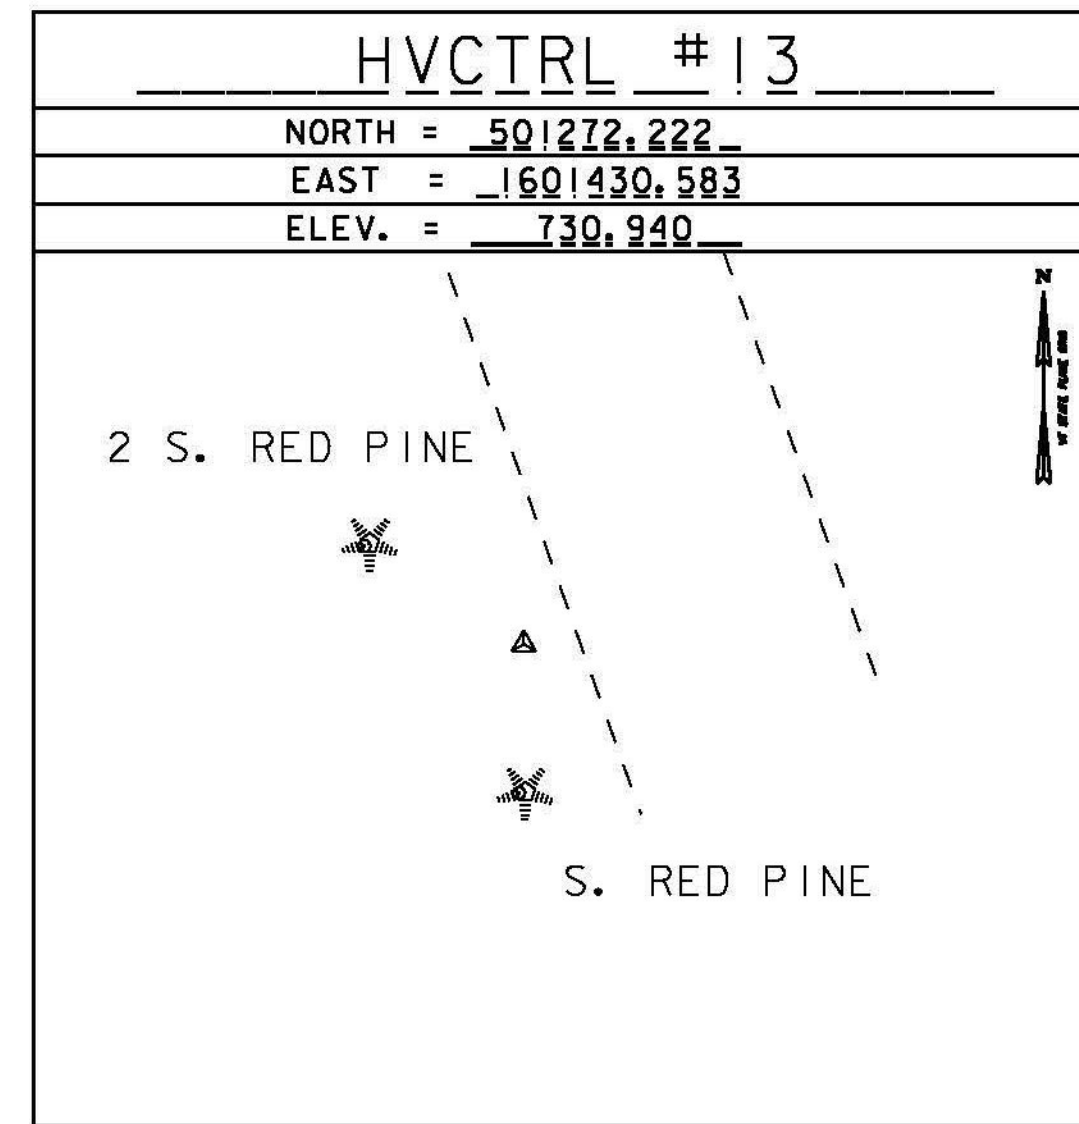
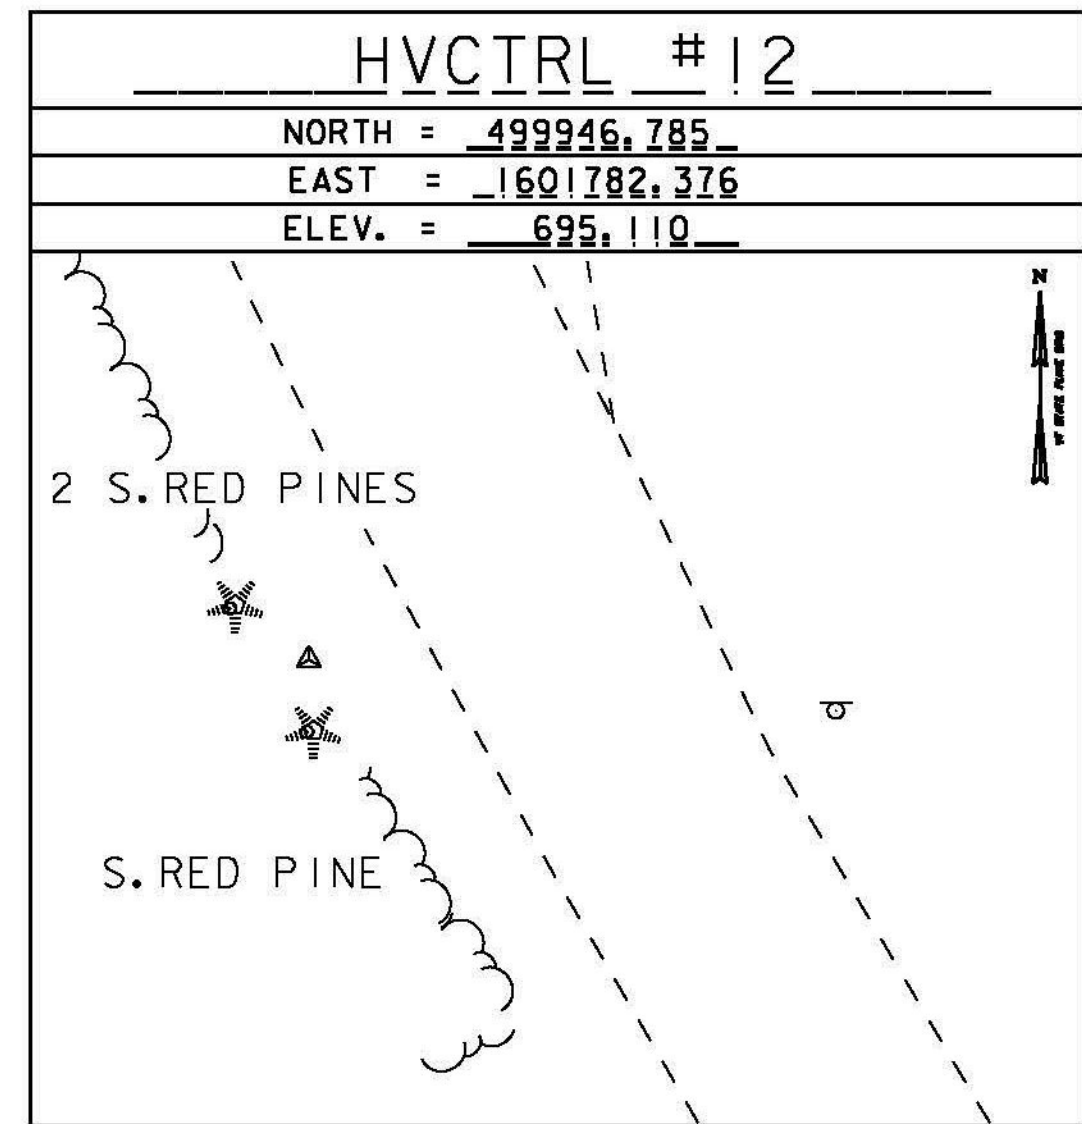
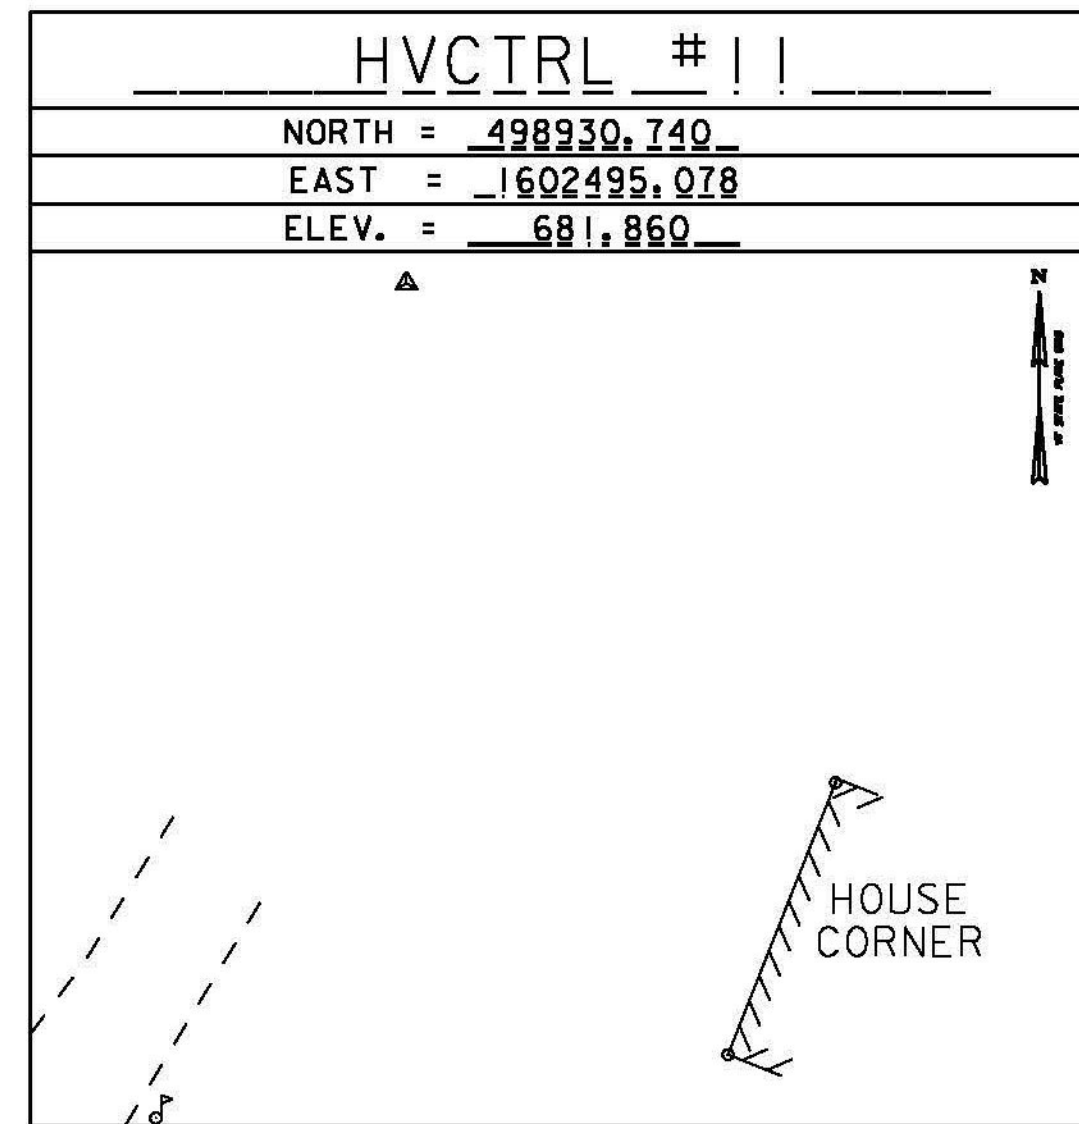


GPS CONTROL POINTS






HVCTRL #9 |
 CAMP BROOK
 NORTH = 493981.782
 EAST = 1601243.685
 ELEV. = 586.961

HVCTRL #10
 CAMP BROOK AZ MK
 NORTH = 496407.591
 EAST = 1601365.627
 ELEV. = 656.059

TRAVERSE TIES

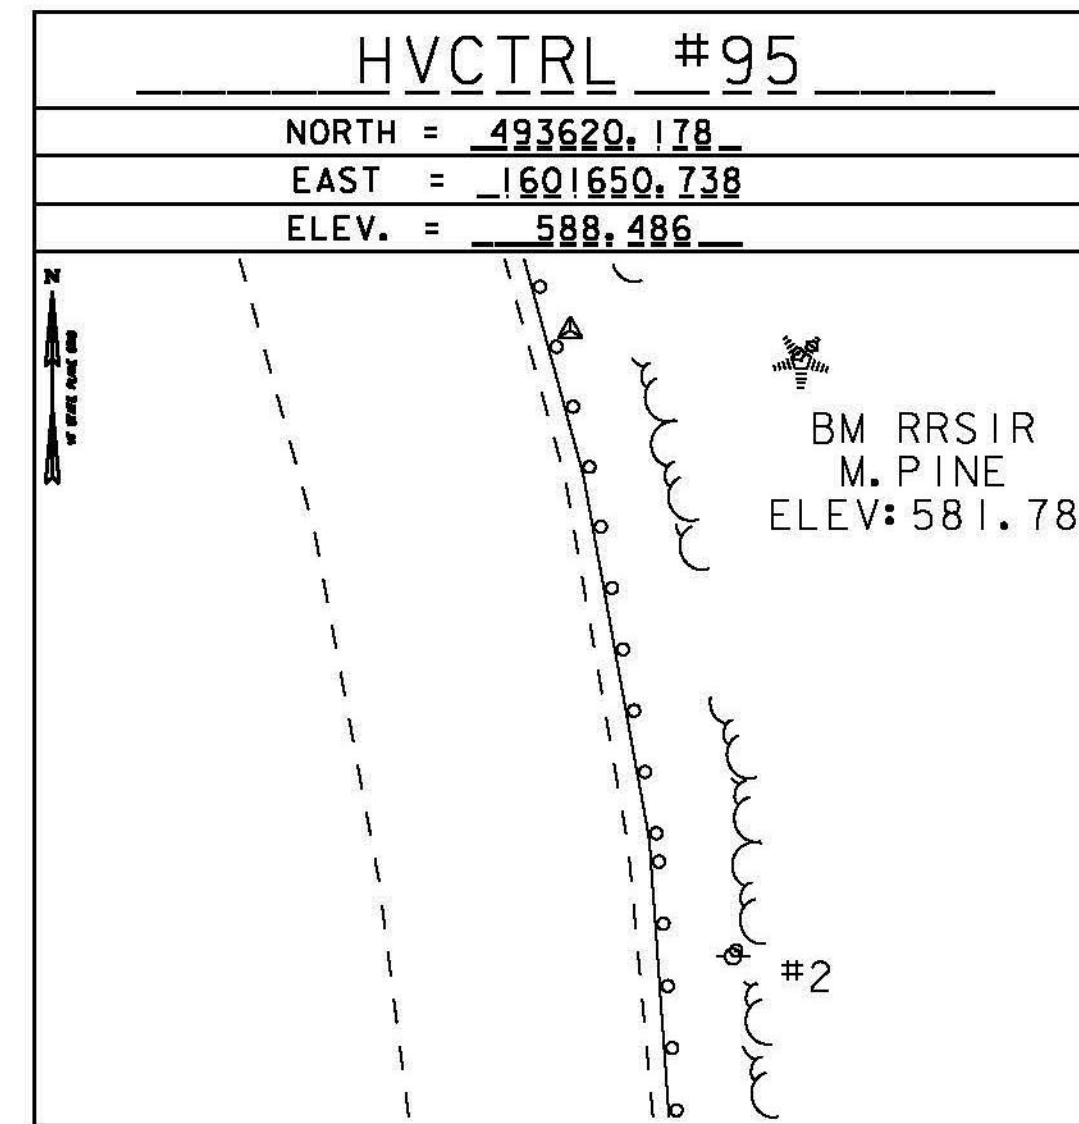

TRAVERSE TIES

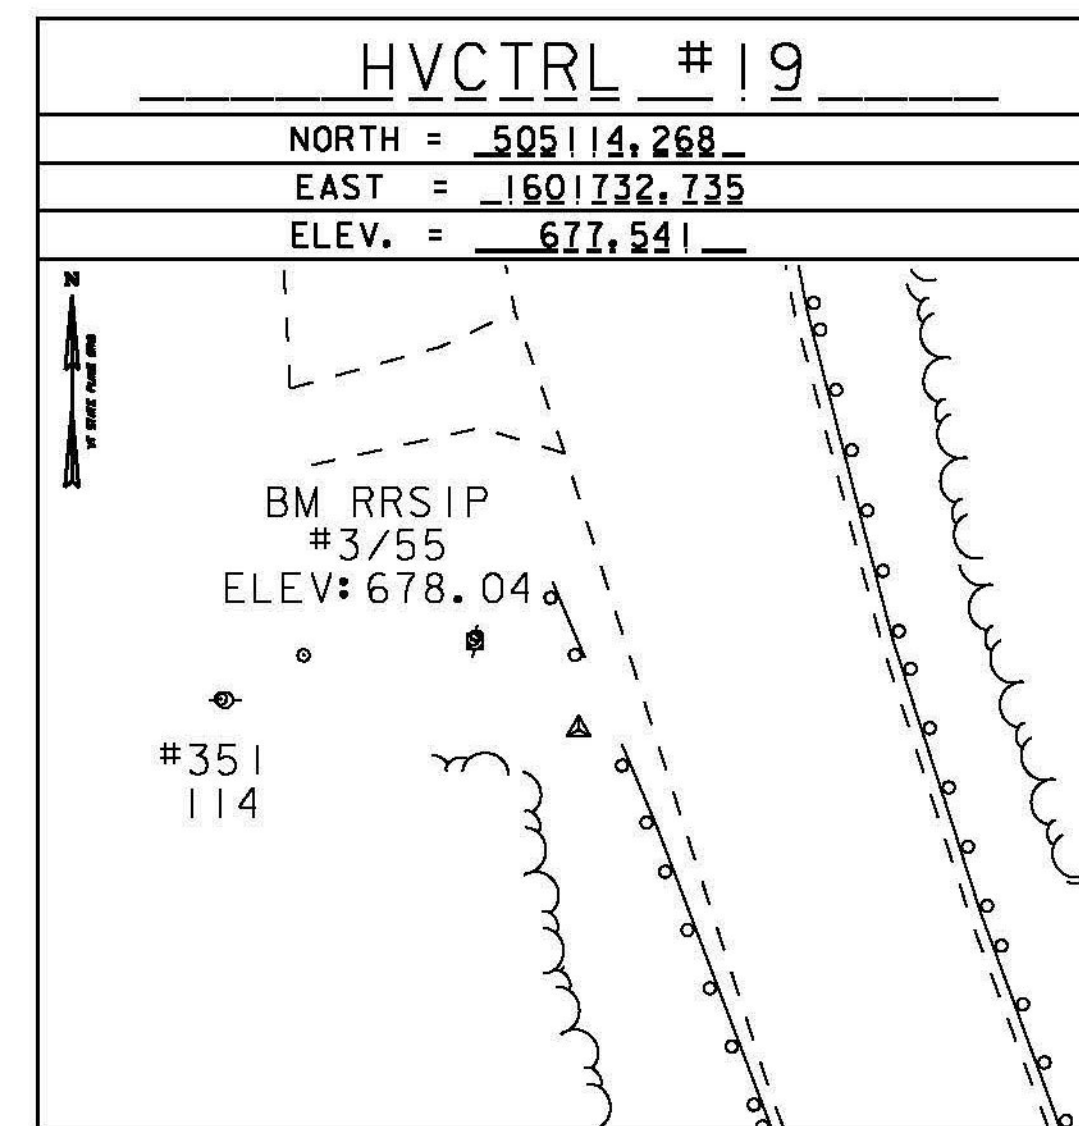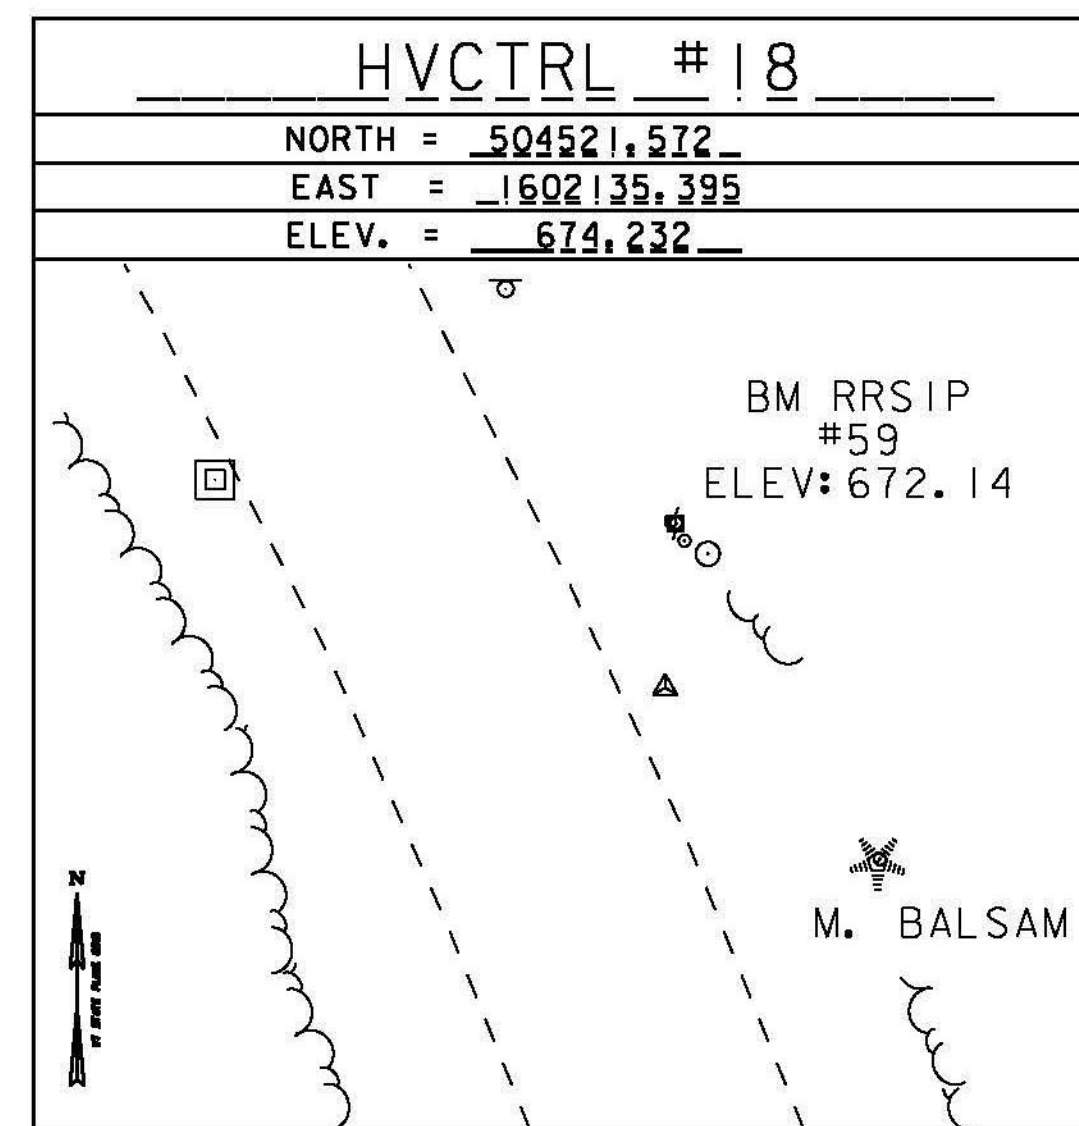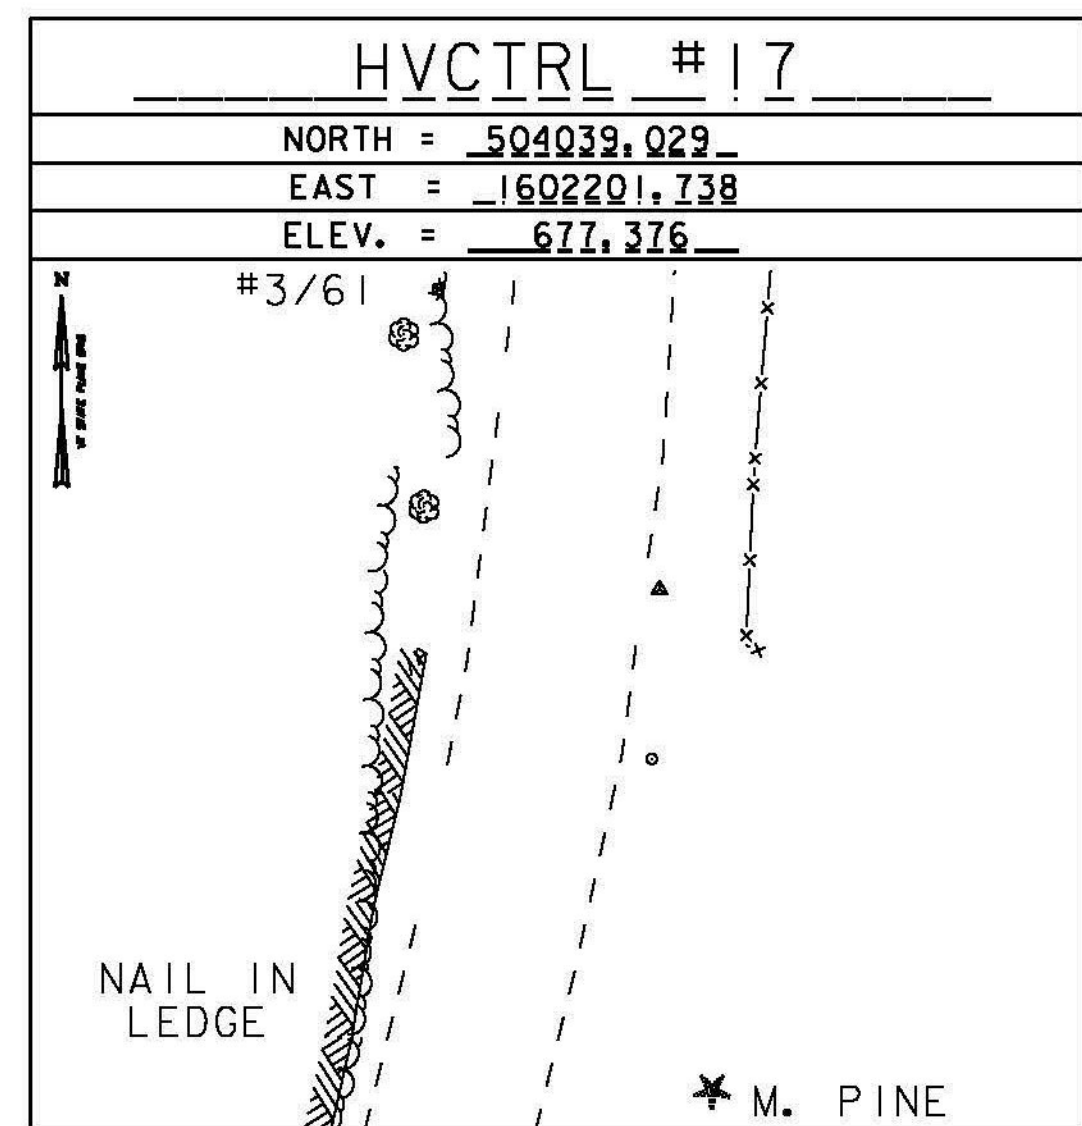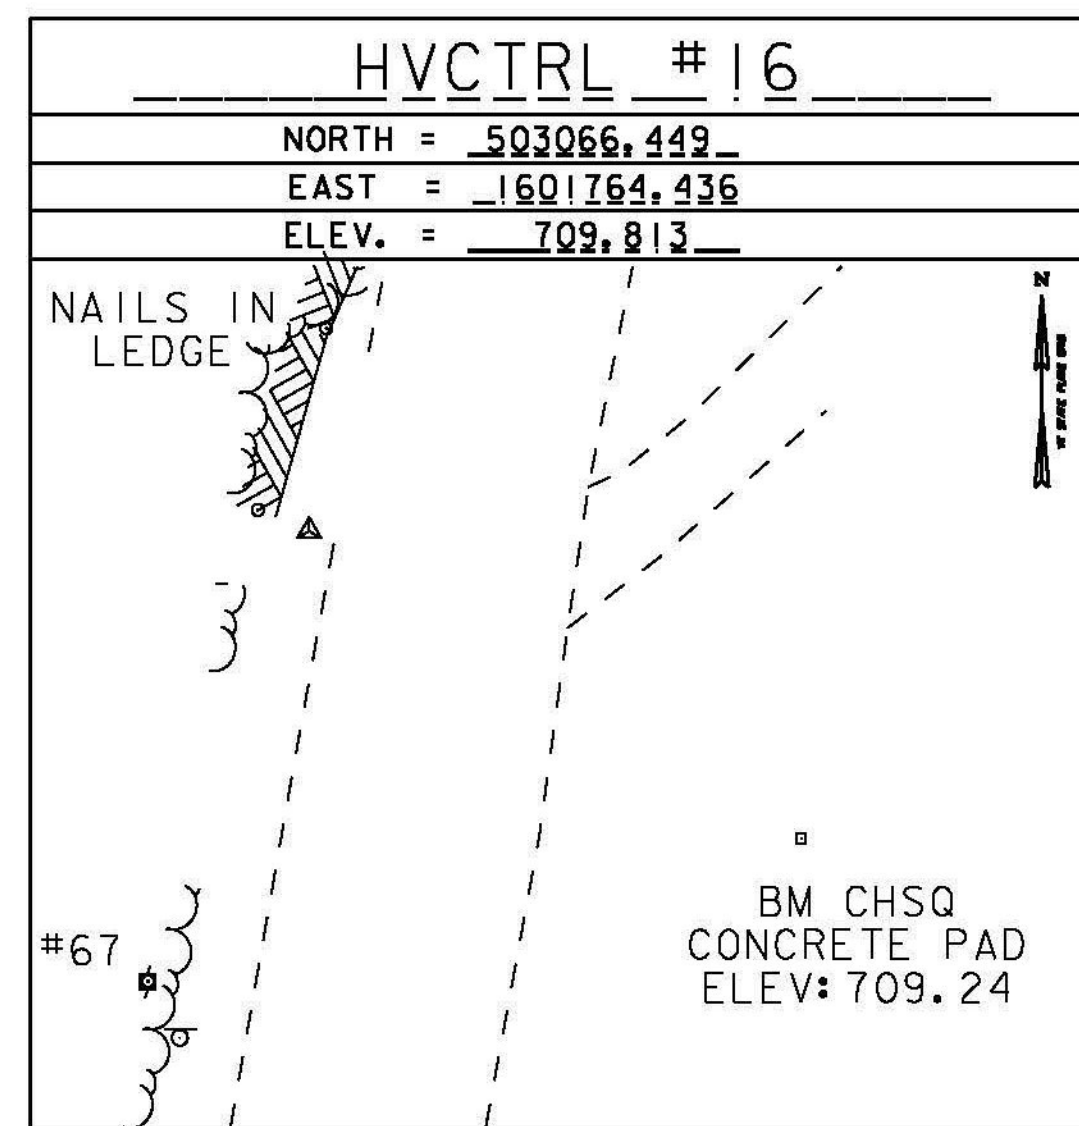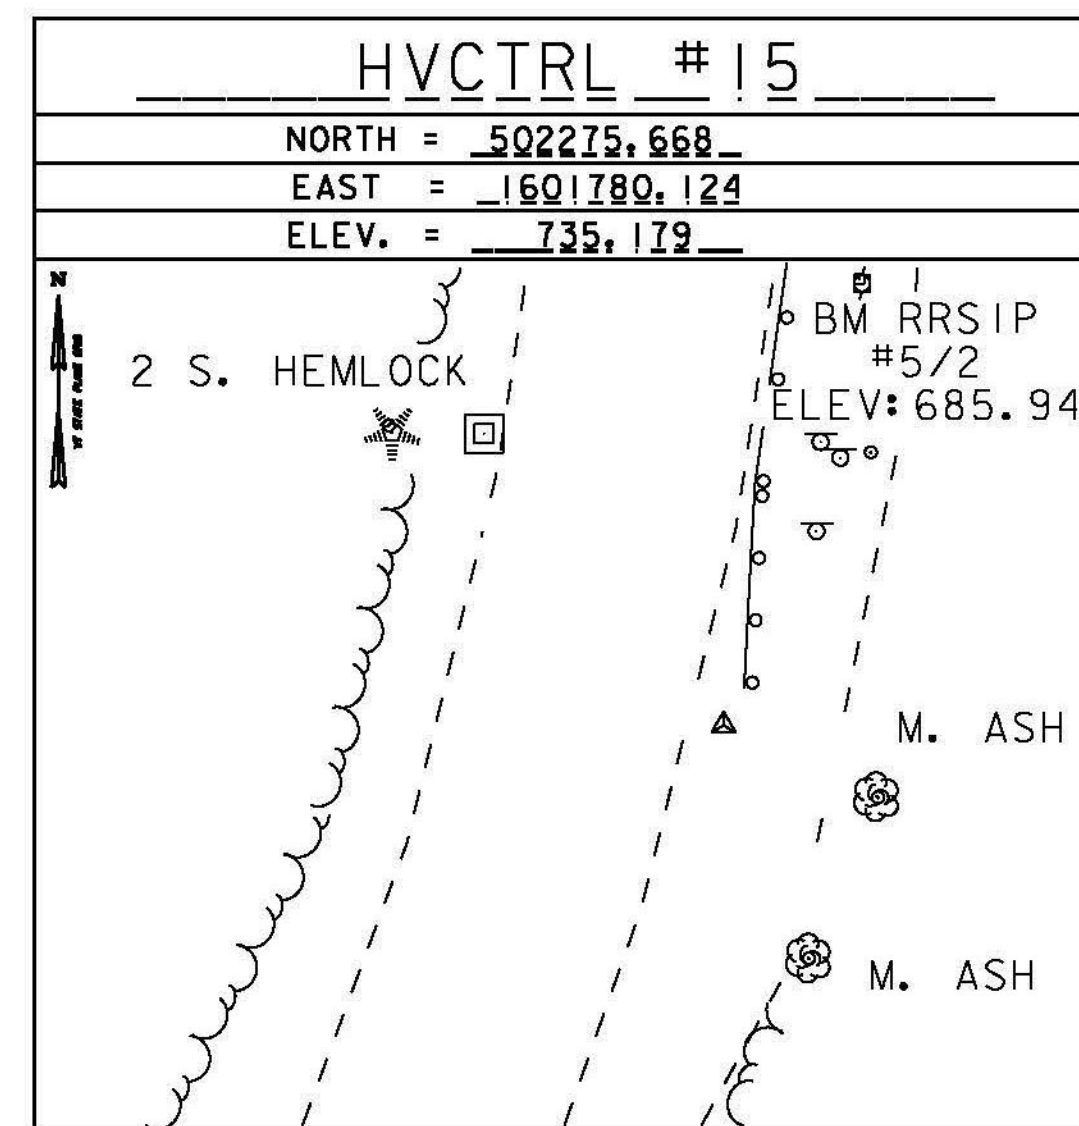

DATUM	
VERTICAL	NAVD 88
HORIZONTAL	NAD 83 CORS
ADJUSTMENT	COMPASS

PROJECT NAME: BETHEL-RANDOLPH	
PROJECT NUMBER: STP 2921(I)	
FILE NAME: z10c244+1e.dgn	PLOT DATE: 4/23/2015
PROJECT LEADER: C. LATHROP	DRAWN BY: R. BULLOCK
DESIGNED BY: S. LAMPHERE	CHECKED BY: C. LATHROP
TIE SHEET 2	SHEET 5 OF 21