

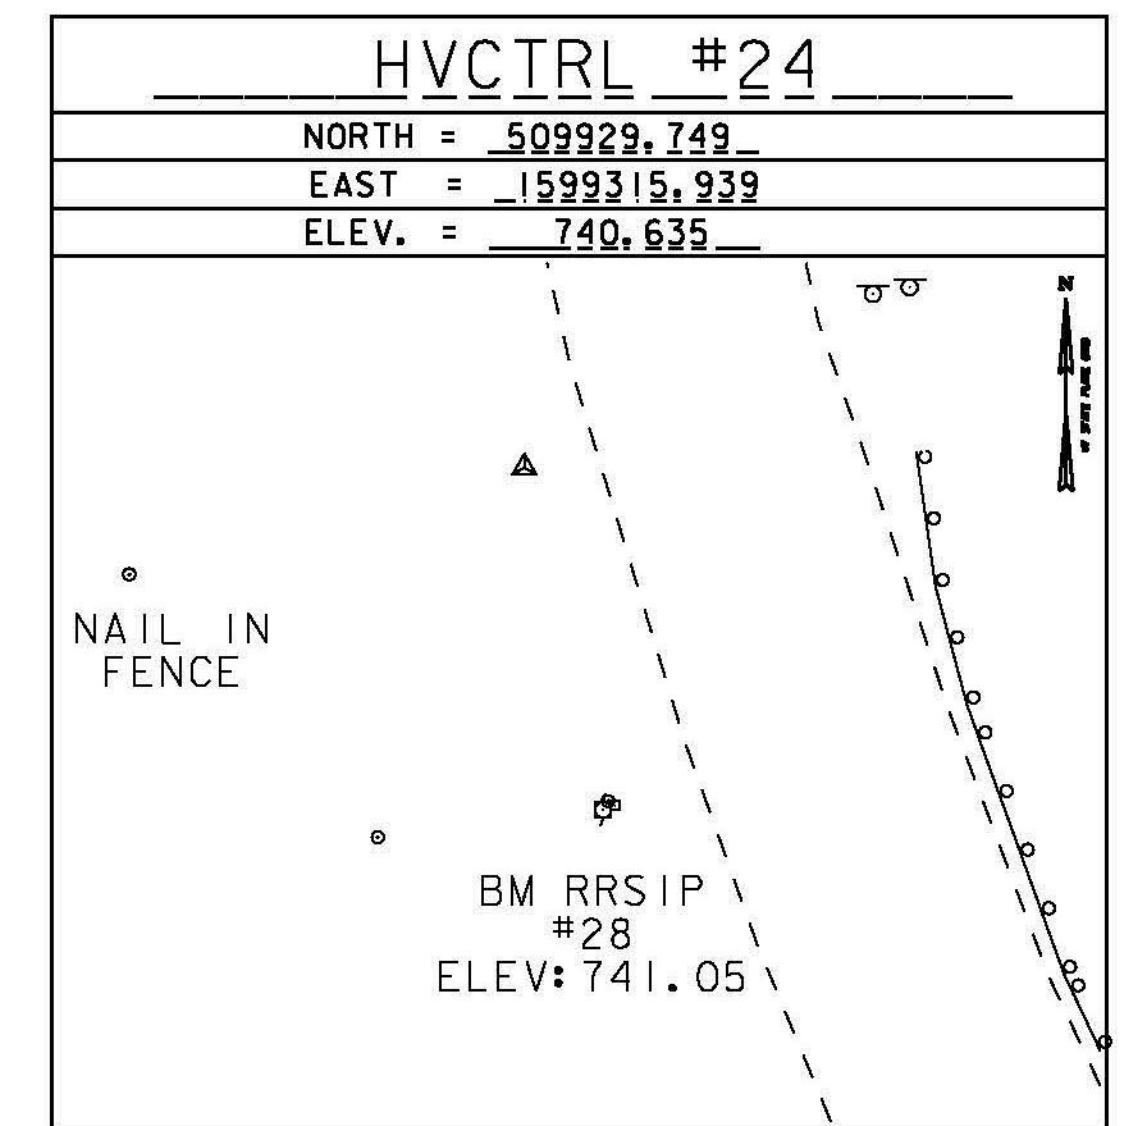
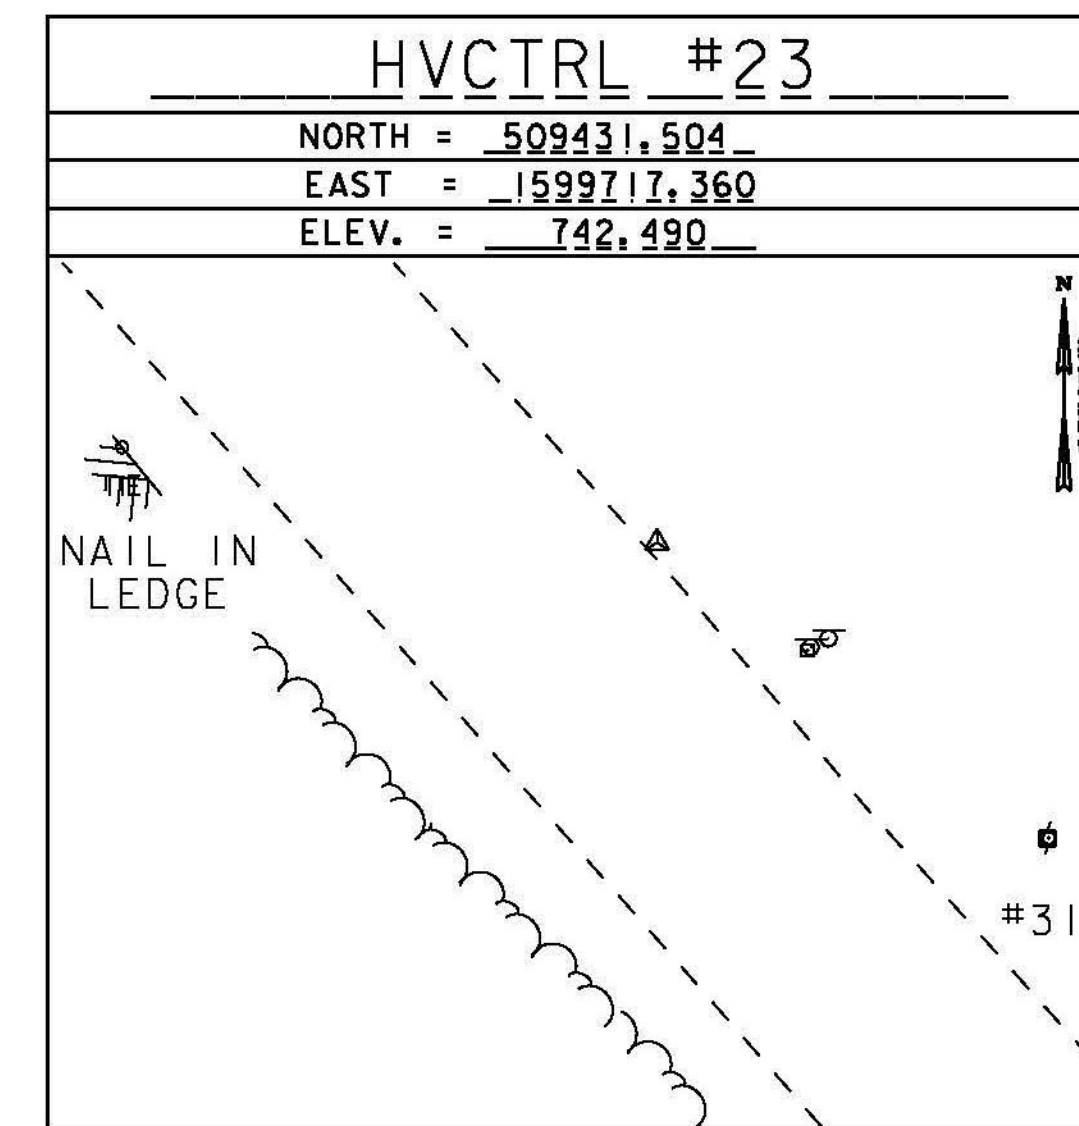
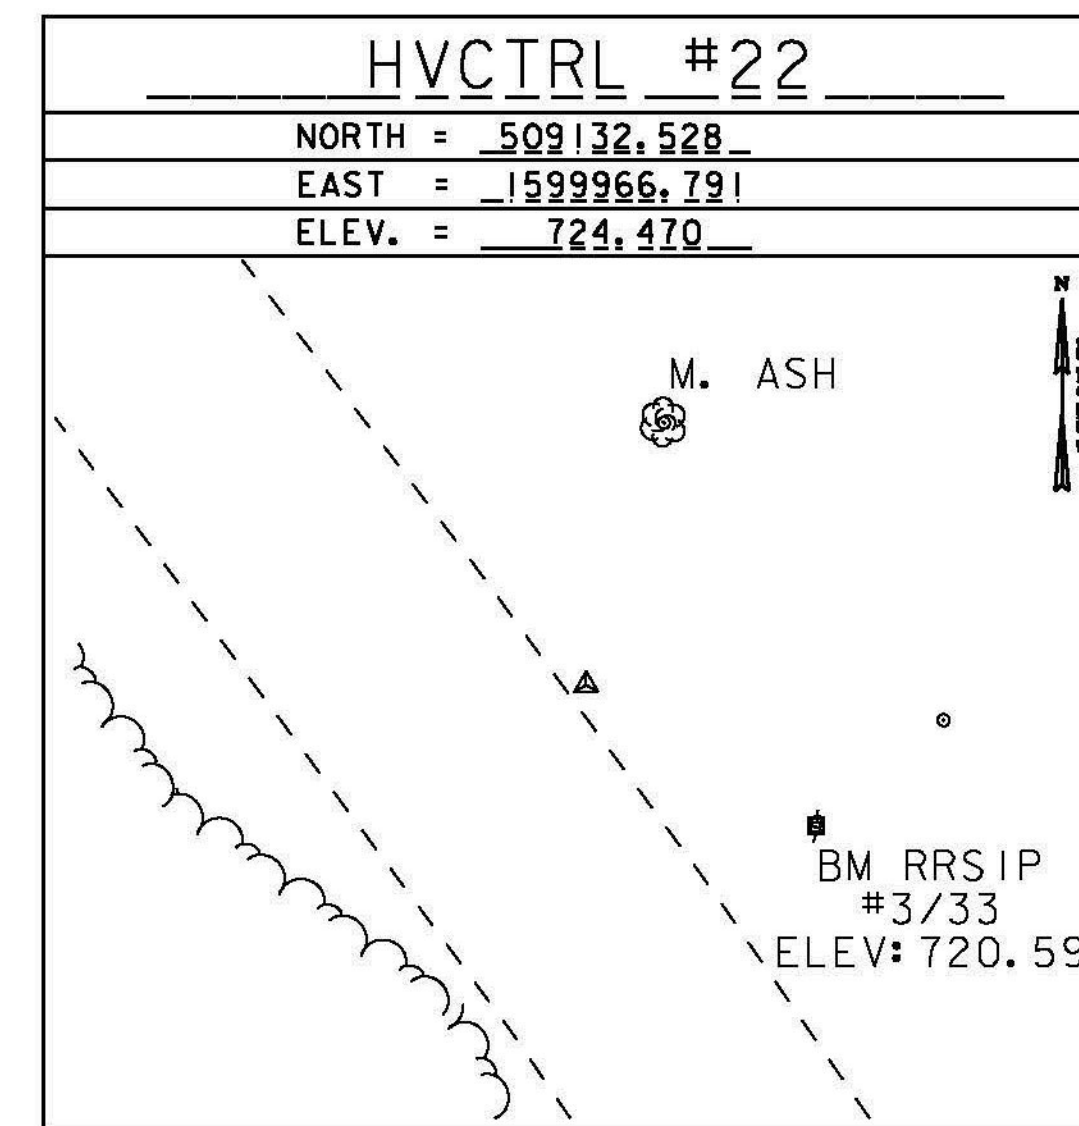
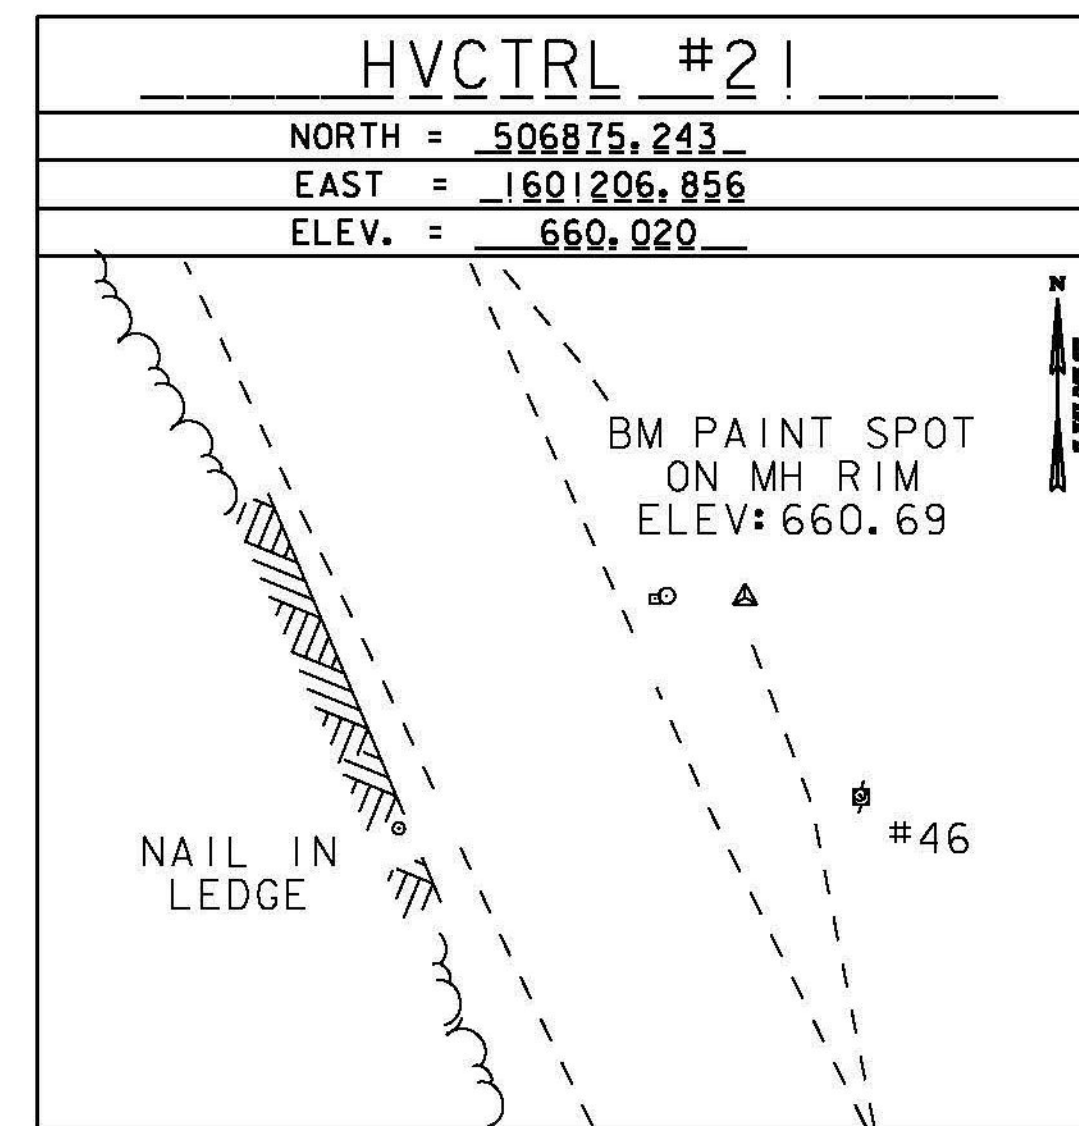
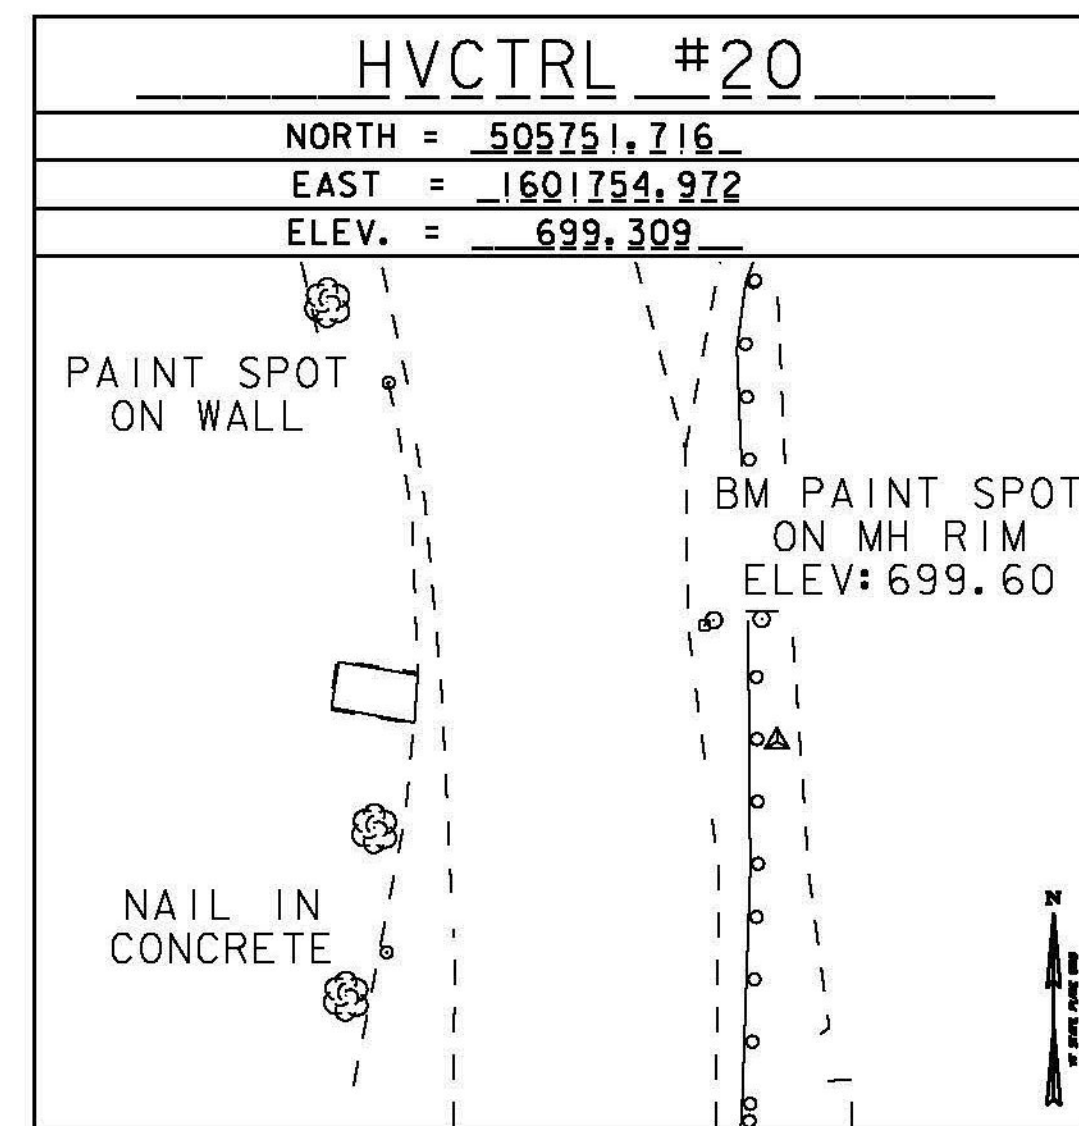
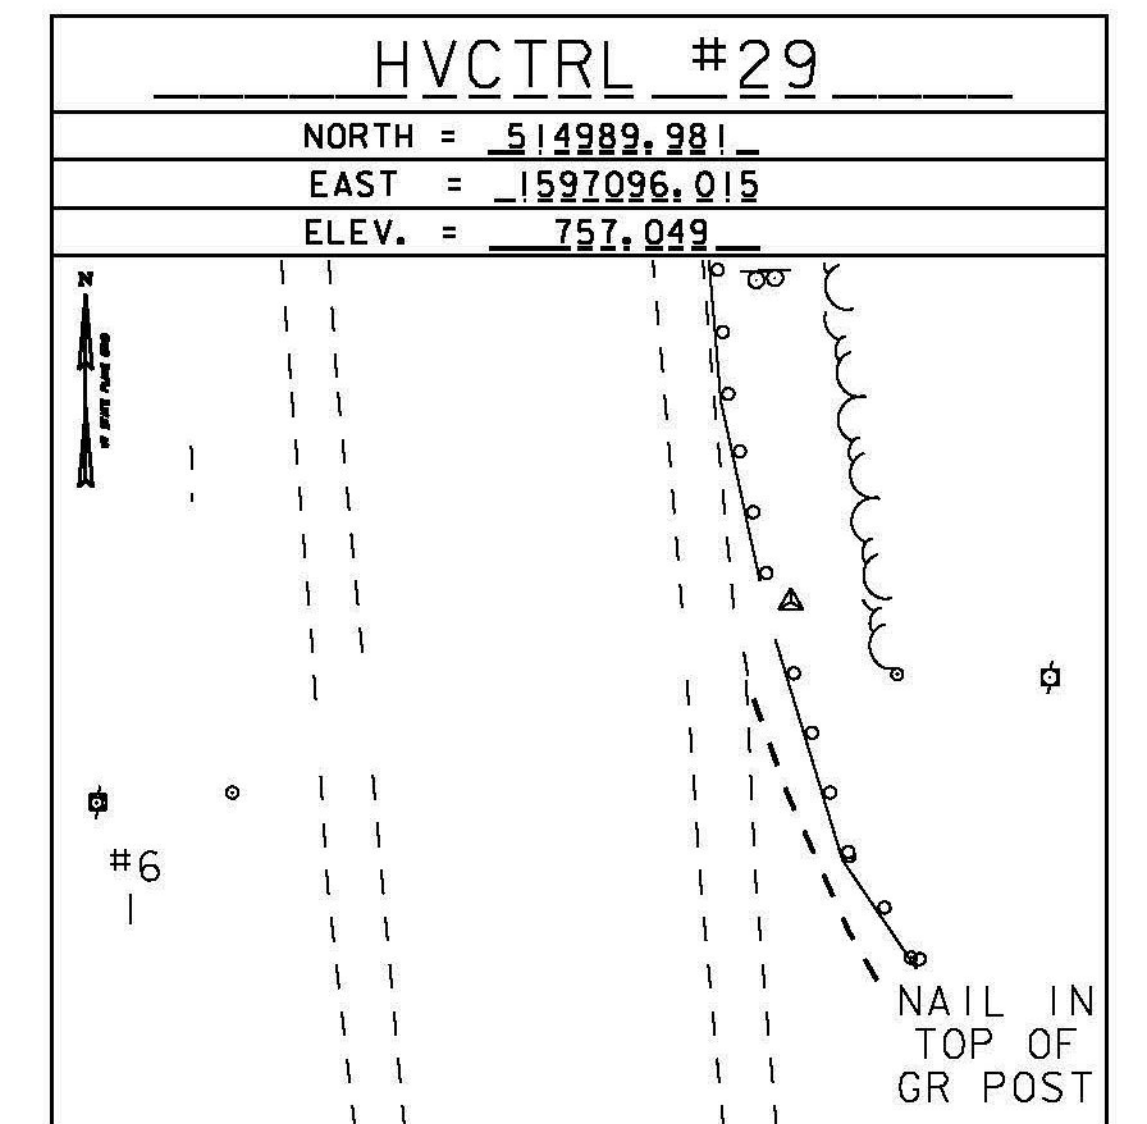
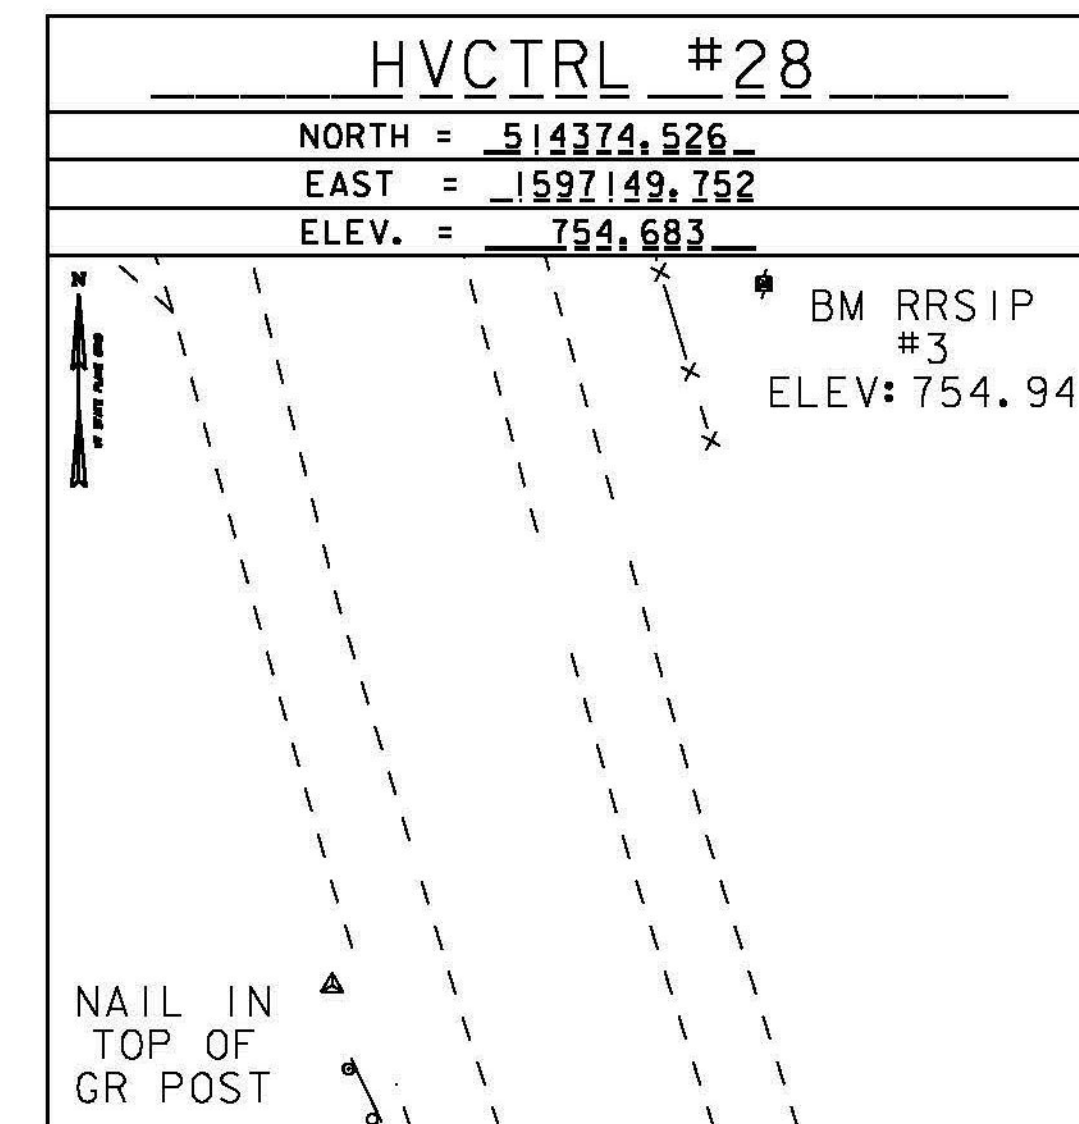
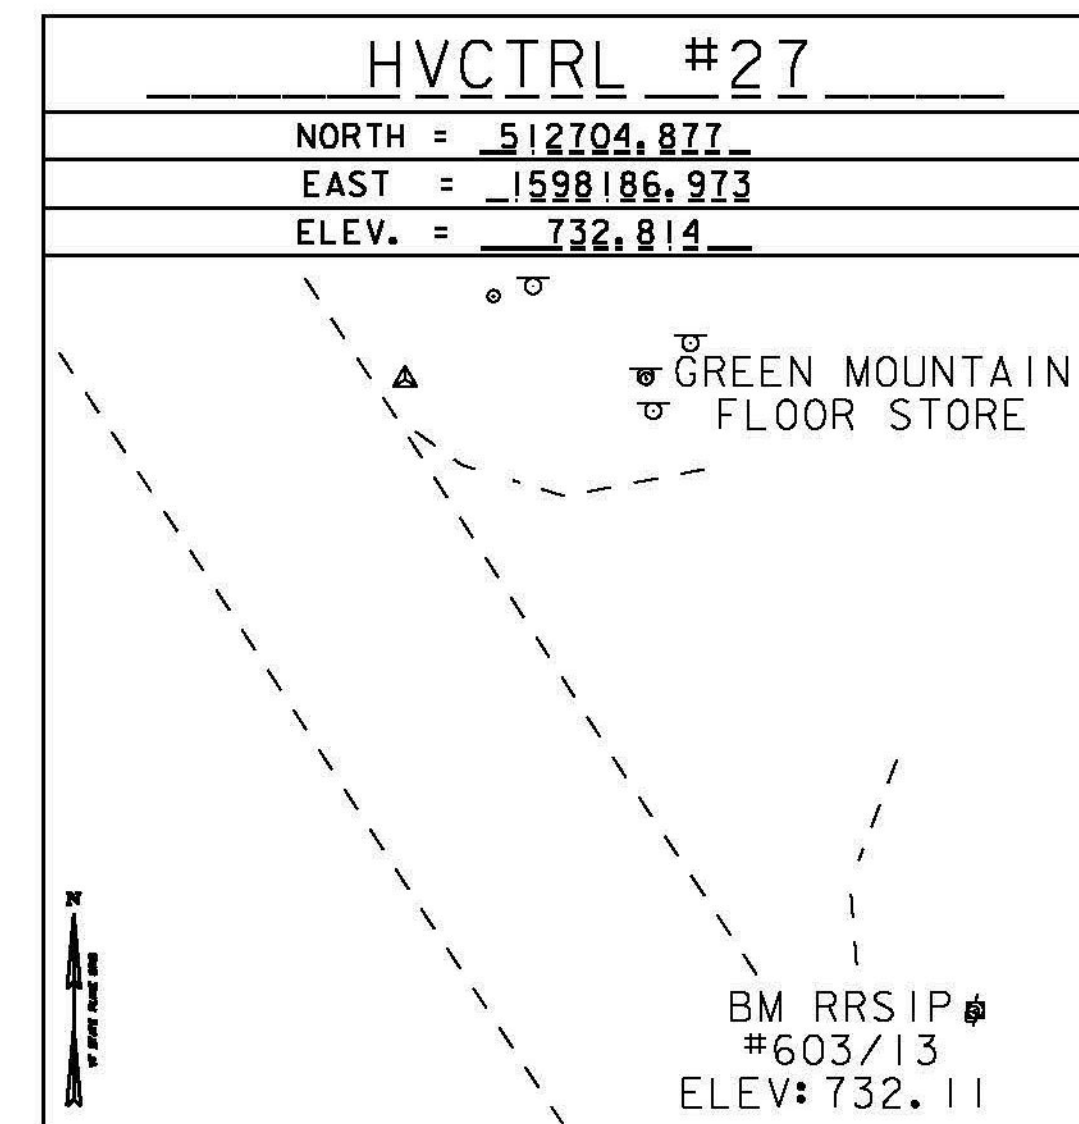


TRAVERSE TIES

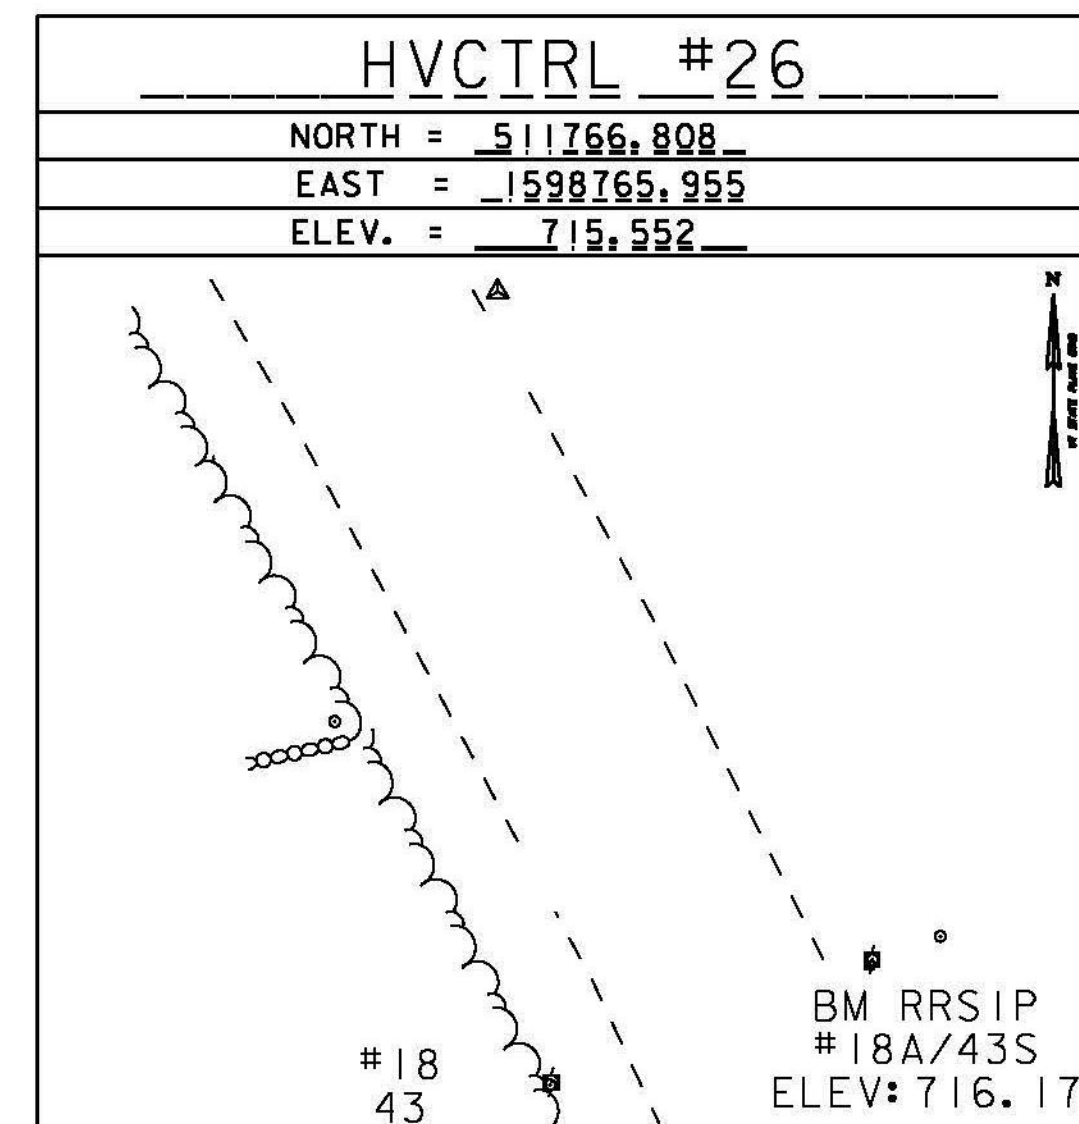

TRAVERSE TIES

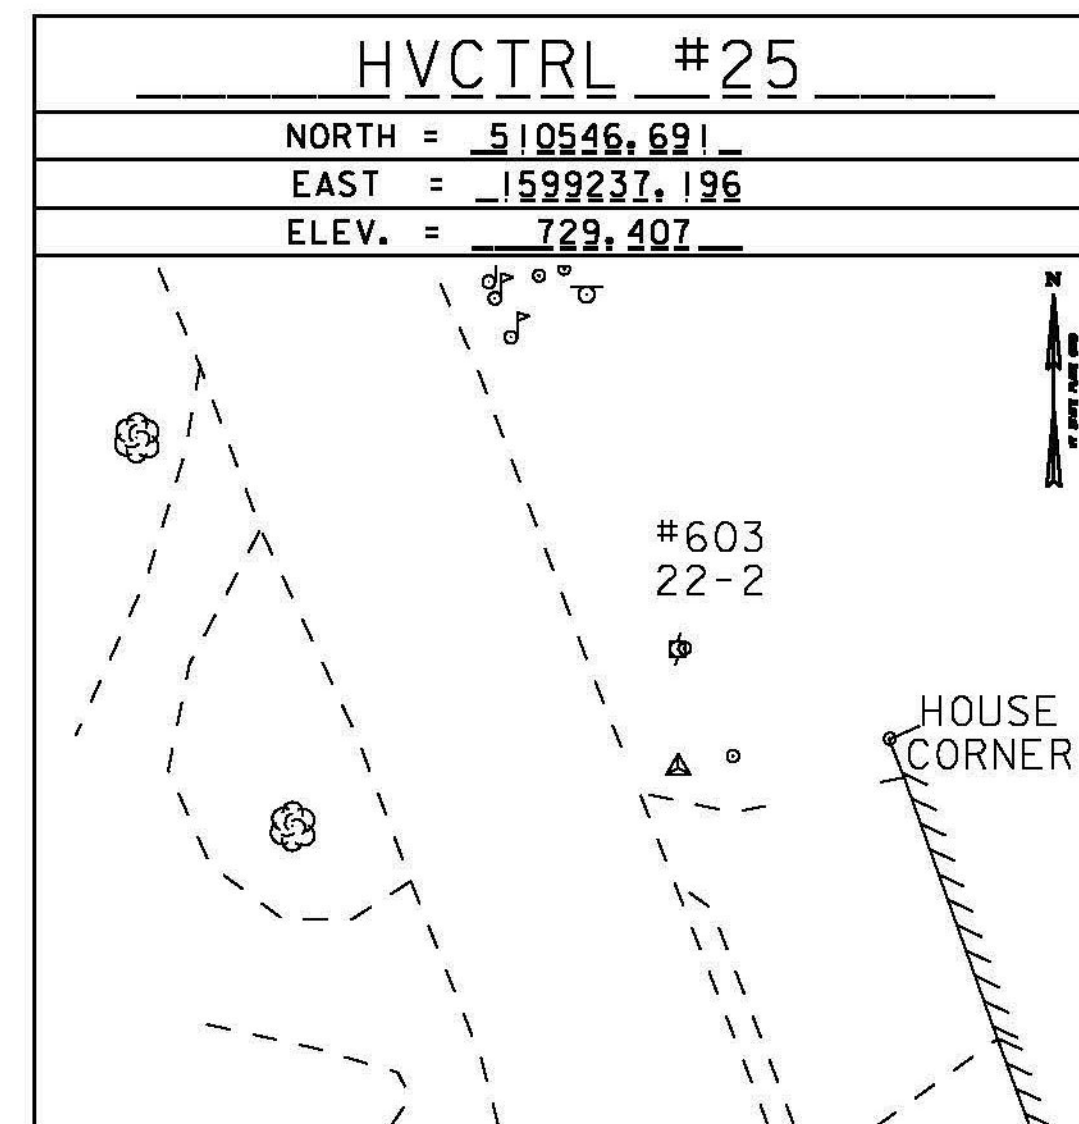

ALIGNMENT COORD

DATUM	
VERTICAL	NAVD 88
HORIZONTAL	NAD 83 CORS
ADJUSTMENT	COMPASS

PROJECT NAME:	BETHEL-RANDOLPH
PROJECT NUMBER:	STP 2921(I)
FILE NAME:	z10c244t1e.dgn
PROJECT LEADER:	C. LATHROP
DESIGNED BY:	S. LAMPHERE
TIE SHEET	3
PLOT DATE:	4/23/2015
DRAWN BY:	R. BULLOCK
CHECKED BY:	C. LATHROP
SHEET	6 OF 211