

DURABLE 4 INCH WHITE LINE, SEE OPTION ITEMS
 STA. 134+75 - STA. 140+50 (SOLID LT & RT)


TEMPORARY 4 INCH WHITE LINE, PAINT
 STA. 134+75 - STA. 140+50 (SOLID LT & RT)

DURABLE 4 INCH YELLOW LINE, POLYUREA
 STA. 134+75 - STA. 140+50 (CENTERLINE)

TEMPORARY 4 INCH YELLOW LINE, PAINT
 STA. 134+75 - STA. 140+50 (CENTERLINE)

DURABLE LETTER OR SYMBOL, POLYUREA
 STA. 135+54 LT ("SCHOOL")

CURVE #2
 DELTA = 4°36'29"
 D = 1°02'30"
 R = 5500.00'
 T = 221.29'
 L = 442.34'
 E = 4.45'
 BANKING 0.022 FT/FT
 DESIGN SPEED 35/50 MPH
 SEE SUPERELEVATION DIAGRAMS
 FOR MORE INFORMATION

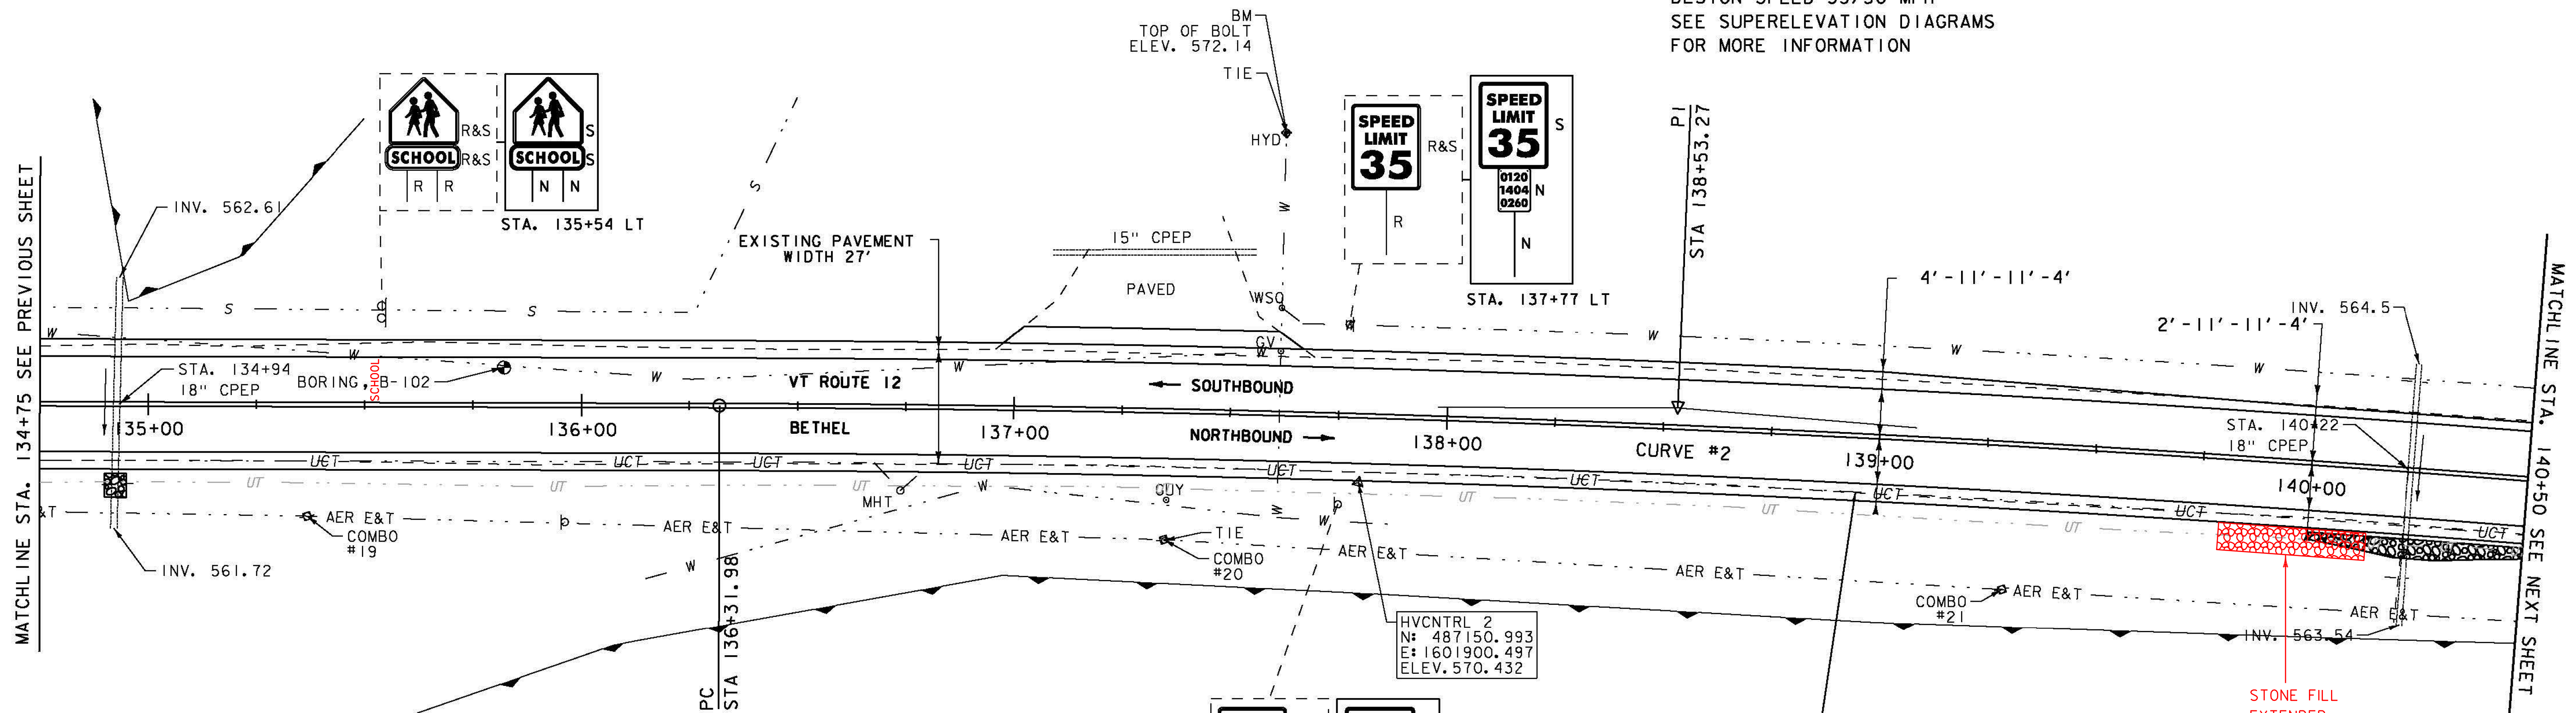

STONE FILL, TYPE I
 STA. 134+90 - STA. 134+95 RT
 STA. 140+00 - STA. 140+50 RT
 139+78

GEOTEXTILE FOR SILT FENCE
 STA. 134+90 - STA. 134+95 RT
 STA. 140+00 - STA. 140+50 RT

GRUBBING MATERIAL (6")
 STA. 134+90 - STA. 134+95 RT
 STA. 140+00 - STA. 140+50 RT

REMOVING SIGNS
 AS SHOWN - 4


ERECTING SALVAGED SIGNS
 AS SHOWN - 4

ENVIRONMENTALLY SENSITIVE LOCATIONS:

NO.	LIMITS	POS.	TYPE
I.	STA. 134+75 - STA. 140+50	RT	-
IA.	STA. 134+87 - STA. 135+50	LT	-

SIGN LEGEND

- R = REMOVE
- R&S = REMOVE AND SALVAGE
- RET = RETAIN
- S = SALVAGED
- N = NEW
- B-B = BACK TO BACK
- - = EXISTING
- = NEW

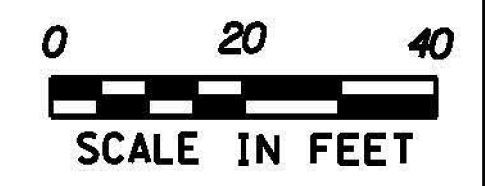

PROJECT NAME: BETHEL-RANDOLPH	PLOT DATE: 4/23/2015
PROJECT NUMBER: STP 292(I)	DRAWN BY: S. LAMPHERE
FILE NAME: z10c244bdr.dgn	CHECKED BY: C. LATHROP
PROJECT LEADER: C. LATHROP	SHEET 29 OF 21
DESIGNED BY: S. LAMPHERE	
PLAN SHEET 3	