

DURABLE 4 INCH WHITE LINE, SEE OPTION ITEMS
 STA. 140+50 - STA. 146+25 (SOLID LT & RT)



TEMPORARY 4 INCH WHITE LINE, PAINT
 STA. 140+50 - STA. 146+25 (SOLID LT & RT)

DURABLE 4 INCH YELLOW LINE, POLYUREA
 STA. 140+50 - STA. 146+25 (CENTERLINE)

TEMPORARY 4 INCH YELLOW LINE, PAINT
 STA. 140+50 - STA. 146+25 (CENTERLINE)

REMOVING SIGNS
 AS SHOWN - 4

ERECTING SALVAGED SIGNS
 AS SHOWN - 2

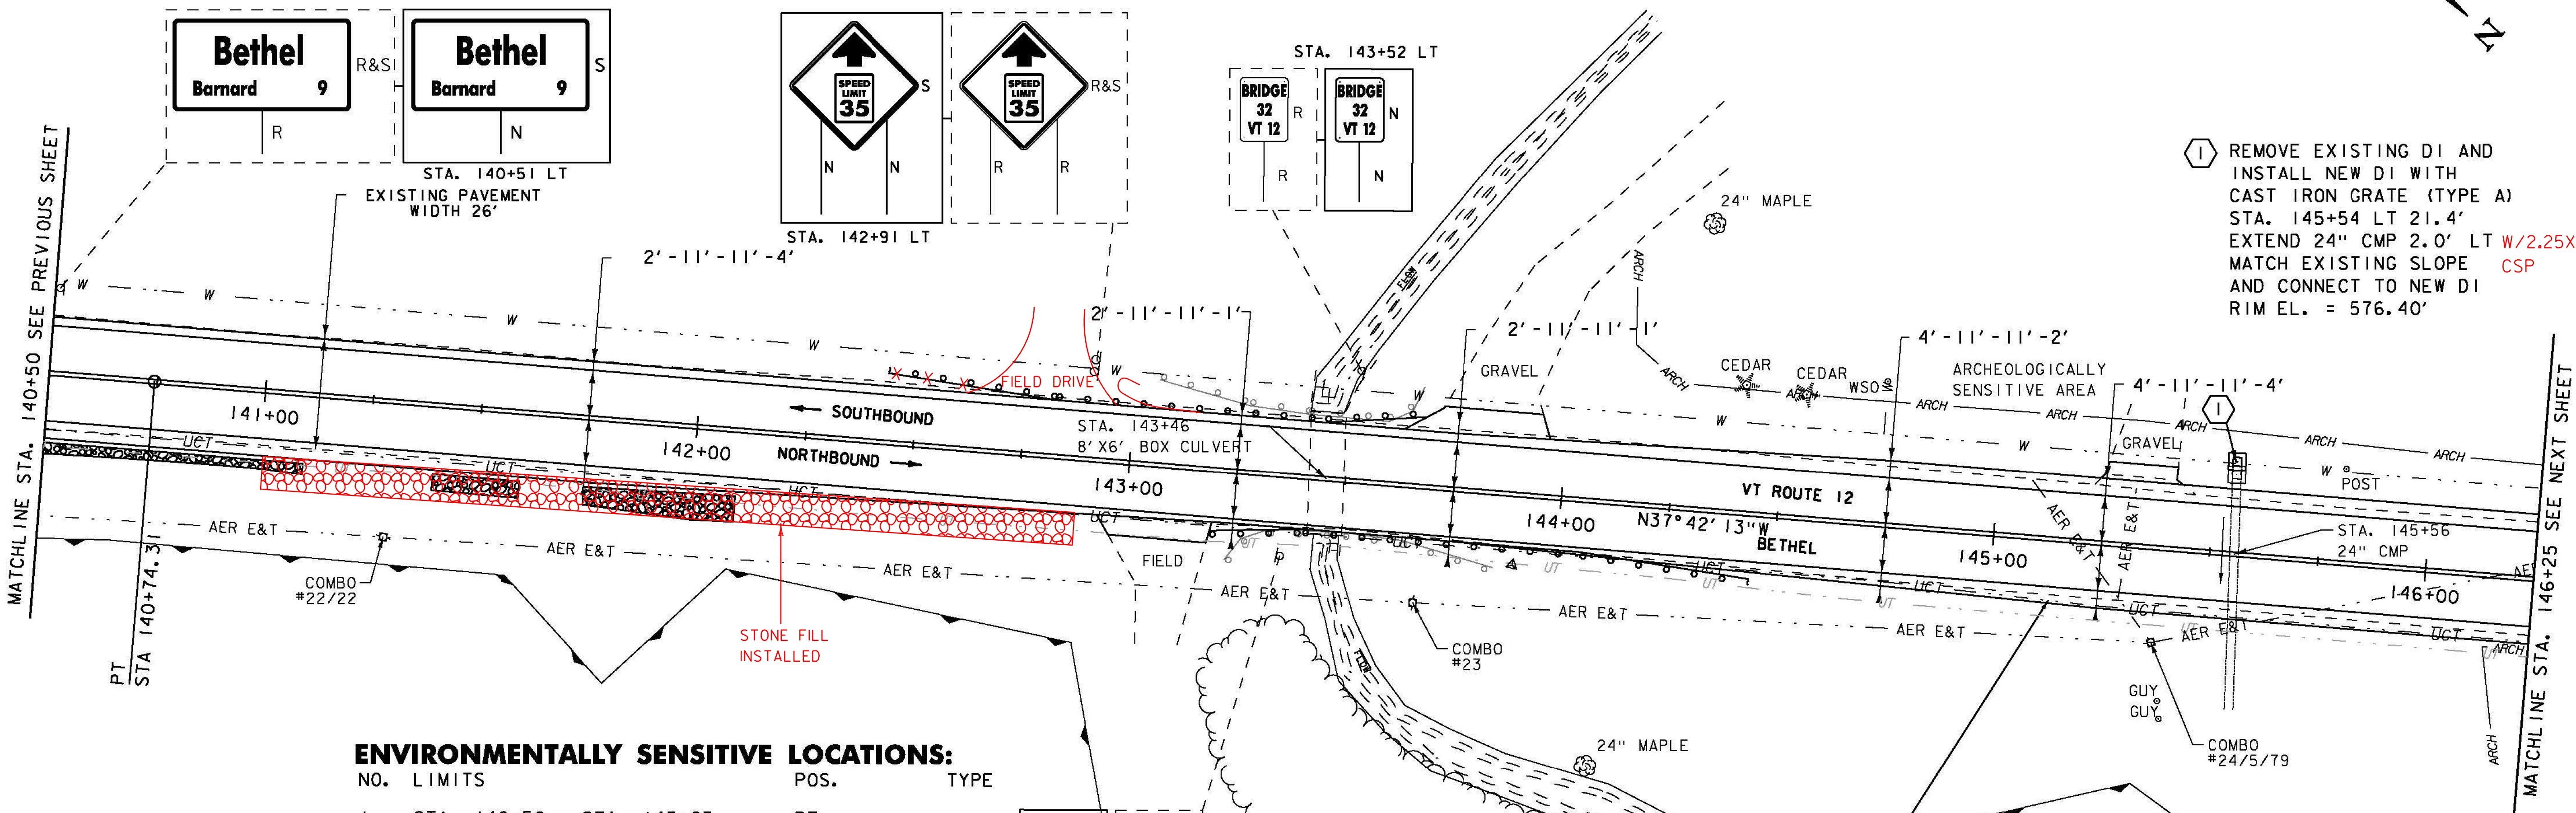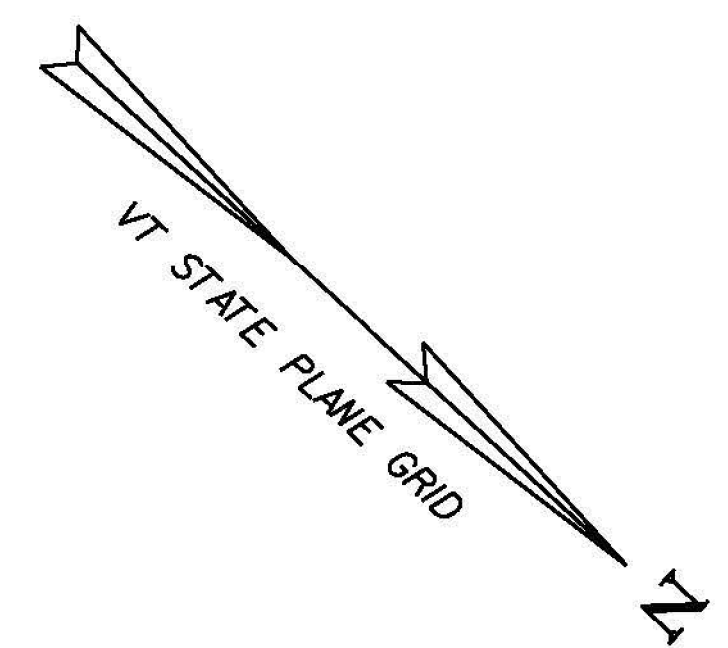

1 REMOVE EXISTING DI AND INSTALL NEW DI WITH CAST IRON GRATE (TYPE A)
 STA. 145+54 LT 21.4'
 EXTEND 24" CMP 2.0' LT W/2.25X24" CSP
 MATCH EXISTING SLOPE AND CONNECT TO NEW DI RIM EL. = 576.40'

ENVIRONMENTALLY SENSITIVE LOCATIONS:

NO.	LIMITS	POS.	TYPE
1.	STA. 140+50 - STA. 143+03	RT	-
2.	STA. 144+82 - STA. 146+25	RT	-

STEEL BEAM GUARDRAIL, GALVANIZED
 STA. 142+43 - STA. 142+55.5 LT
 STA. 143+55.5 - STA. 143+68 LT
 STA. 143+19.5 - STA. 143+32 RT
 STA. 142+32 - STA. 144+44.5 RT

STEEL BEAM GUARDRAIL, GALVANIZED W/8 FEET POSTS
 STA. 142+55.5 - STA. 143+30.5 LT
 STA. 143+57 - STA. 144+32 RT
 STA. 143+05.5 - STA. 143+30.5 LT

STEEL BEAM GUARDRAIL, GALVANIZED/NESTED W/8 FEET POSTS
 STA. 143+30.5 - STA. 143+55.5 LT
 STA. 143+32 - STA. 143+57 RT

REMOVAL AND DISPOSAL OF GUARDRAIL
 STA. 143+05.5 - STA. 143+66.5 LT
 STA. 143+23.5 - STA. 143+85.5 RT

ANCHOR FOR STEEL BEAM RAIL
 (SEE STANDARD G-1d)

STONE FILL, TYPE I
 STA. 140+50 - STA. 141+10 RT
 STA. 141+40 - STA. 141+60 RT
 STA. 141+75 - STA. 142+10 RT

GEOTEXTILE FOR SILT FENCE
 STA. 140+50 - STA. 141+10 RT
 STA. 141+40 - STA. 141+60 RT
 STA. 141+75 - STA. 142+10 RT

GRUBBING MATERIAL (6")
 STA. 140+50 - STA. 141+10 RT
 STA. 141+40 - STA. 141+60 RT
 STA. 141+75 - STA. 142+10 RT


PRECAST REINFORCED CONCRETE DROP INLET WITH CAST IRON GRATE
 STA. 145+54 LT

24" CSP .064 (2-2/3 X 1/2)
 STA. 145+54 LT 3.0'
 2.25'

STONE FILL, TYPE I
 STA. 140+50 - STA. 141+00 RT
 STA. 141+00 - STA. 142+84 RT

SIGN LEGEND

- R = REMOVE
- R&S = REMOVE AND SALVAGE
- RET = RETAIN
- S = SALVAGED
- N = NEW
- B-B = BACK TO BACK
- - = EXISTING
- = NEW

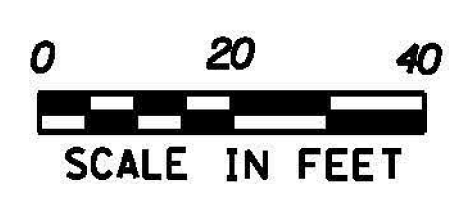

PROJECT NAME: BETHEL-RANDOLPH	PLOT DATE: 4/23/2015
PROJECT NUMBER: STP 292(I)	DRAWN BY: S. LAMPHERE
FILE NAME: z10c244bdr.dgn	CHECKED BY: C. LATHROP
PROJECT LEADER: C. LATHROP	SHEET 30 OF 21
DESIGNED BY: S. LAMPHERE	
PLAN SHEET 4	