

DURABLE 4 INCH WHITE LINE, SEE OPTION ITEMS
STA. 156+75 - STA. 162+50 (SOLID LT & RT)

TEMPORARY 4 INCH WHITE LINE, PAINT
STA. 156+75 - STA. 162+50 (SOLID LT & RT)

DURABLE 4 INCH YELLOW LINE, POLYUREA
STA. 156+75 - STA. 162+50 (CENTERLINE)

TEMPORARY 4 INCH YELLOW LINE, PAINT
STA. 156+75 - STA. 162+50 (CENTERLINE)


MILLED RUMBLE STRIPS
STA. 156+75 - STA. 162+50 (CENTERLINE)

6 INCH UNDERDRAIN PIPE
STA. 158+75 - STA. 162+50 LT

STONE FILL, TYPE
STA. 159+09 - STA. 160+00 LT

REMOVING SIGNS
AS SHOWN - 4

ERECTING SALVAGED SIGNS
AS SHOWN - 3

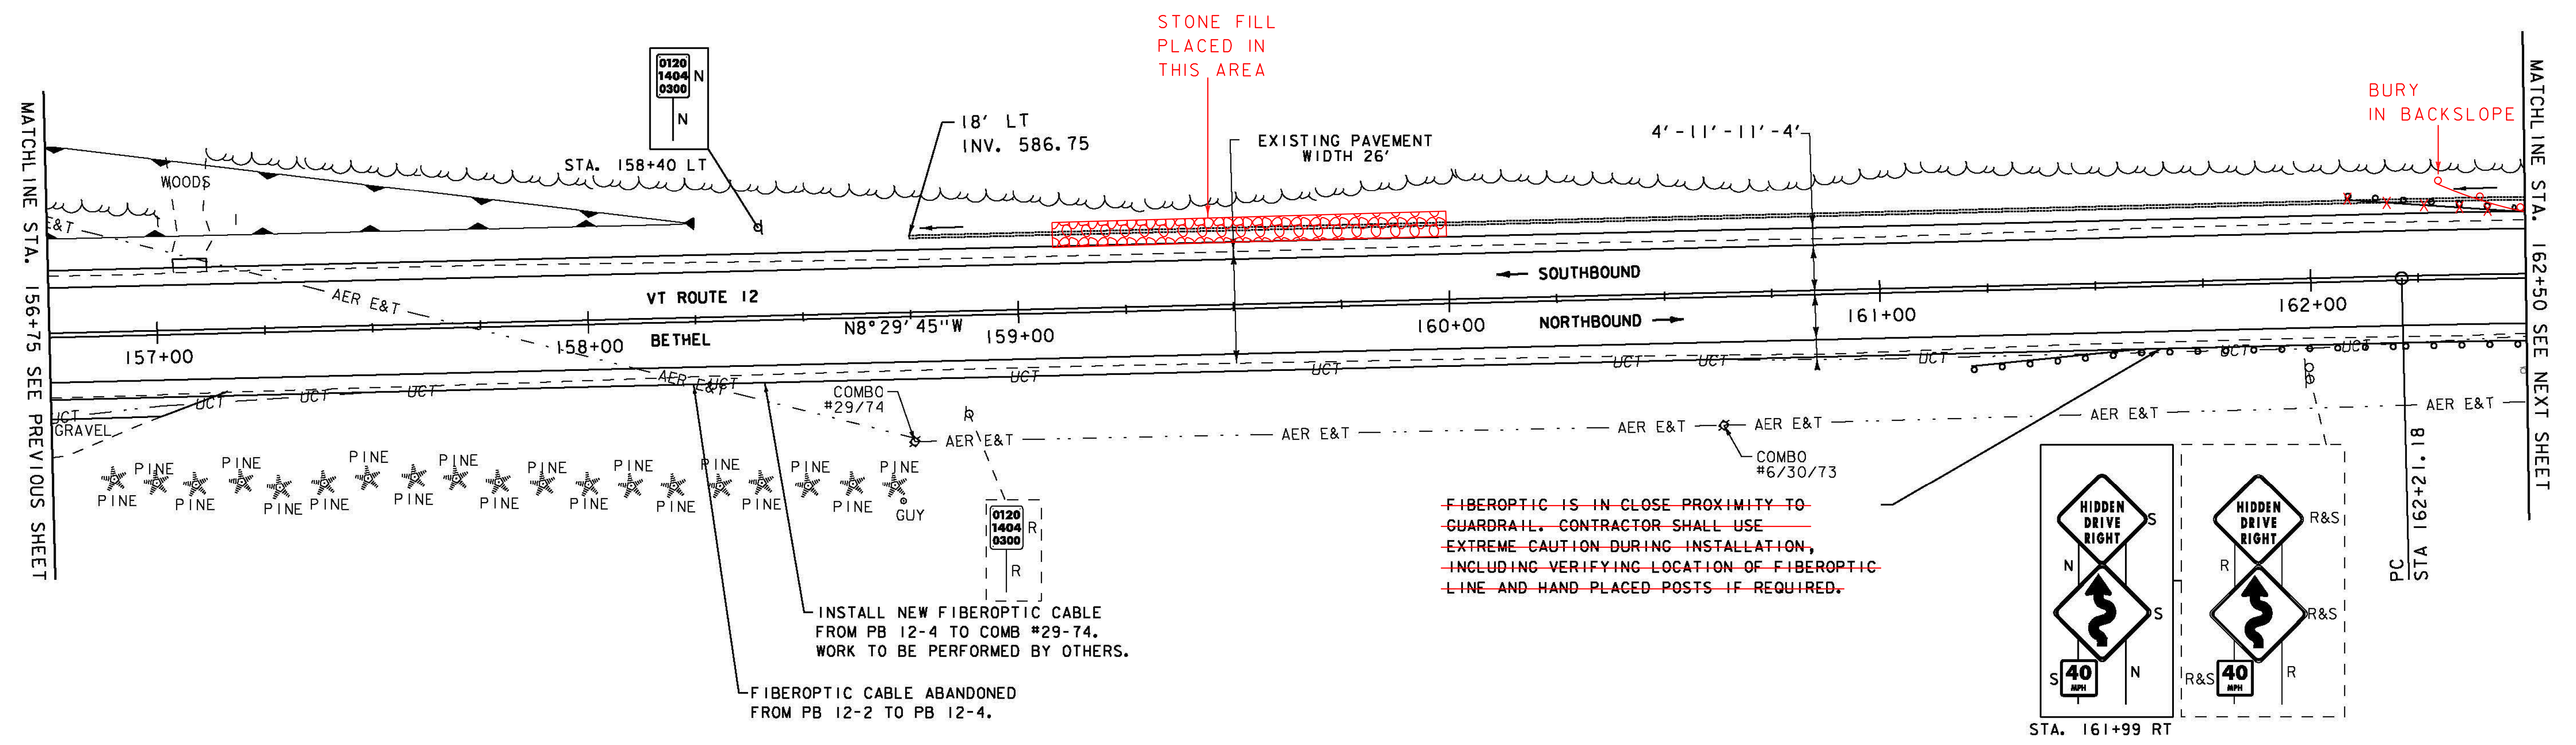

~~FIBEROPTIC IS IN CLOSE PROXIMITY TO GUARDRAIL. CONTRACTOR SHALL USE EXTREME CAUTION DURING INSTALLATION, INCLUDING VERIFYING LOCATION OF FIBEROPTIC LINE AND HAND PLACED POSTS IF REQUIRED.~~

INSTALL NEW FIBEROPTIC CABLE FROM PB 12-4 TO COMB #29-74. WORK TO BE PERFORMED BY OTHERS.

FIBEROPTIC CABLE ABANDONED FROM PB 12-2 TO PB 12-4.


REMOVAL AND DISPOSAL OF GUARDRAIL
STA. 162+46.25 - STA. 162+50 RT

SPECIAL PROVISION (BOX BEAM GUARDRAIL W/7 FEET POSTS)
STA. 161+21 - STA. 162+50 RT
STA. 162+08 - STA. 162+50 LT
162+44
(BURIED IN BACKSLOPE)

ENVIRONMENTALLY SENSITIVE LOCATIONS:

NO.	LIMITS	POS.	TYPE
3.	STA. 156+75 - STA. 158+25	LT	-

- SIGN LEGEND**
- R = REMOVE
 - R&S = REMOVE AND SALVAGE
 - RET = RETAIN
 - S = SALVAGED
 - N = NEW
 - B-B = BACK TO BACK
 - = EXISTING
 - = NEW

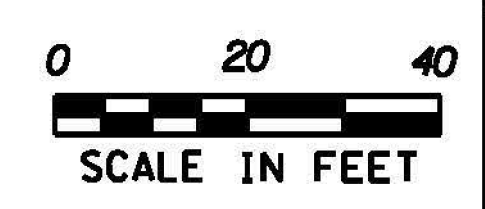

PROJECT NAME: BETHEL-RANDOLPH	FILE NAME: z10c244bdr.dgn	PLOT DATE: 4/23/2015
PROJECT NUMBER: STP 292(I)	PROJECT LEADER: C. LATHROP	DRAWN BY: S. LAMPHERE
	DESIGNED BY: S. LAMPHERE	CHECKED BY: C. LATHROP
	PLAN SHEET 7	SHEET 33 OF 21