

DURABLE 4 INCH WHITE LINE, SEE OPTION ITEMS
 STA. 162+50 - STA. 167+75 (SOLID LT & RT)

DURABLE 4 INCH YELLOW LINE, POLYUREA
 STA. 162+50 - STA. 167+75 (CENTERLINE)

MILLED RUMBLE STRIPS
 STA. 162+50 - STA. 164+00 (CENTERLINE)
 STA. 167+00 - STA. 167+75 (CENTERLINE)



~~SOLID ROCK EXCAVATION~~
 STA. 166+50 - STA. 167+75 LT

TEMPORARY 4 INCH WHITE LINE, PAINT
 STA. 162+50 - STA. 167+75 (SOLID LT & RT)

TEMPORARY 4 INCH YELLOW LINE, PAINT
 STA. 162+50 - STA. 167+75 (CENTERLINE)

6 INCH UNDERDRAIN PIPE
 STA. 162+50 - STA. 162+75 LT
 STA. 164+00 - STA. 167+75 LT
 167+70

CURVE #6
 DELTA = 38°03'45"
 D = 2°08'37" (1) D = 12°43'57" (2)
 R = 2673.00' (1) R = 450.00' (2)
 T = 280.53' (1) T = 161.41' (2)
 L = 156.62' (1) L = 272.58' (2)
 E = 14.68'
 BANKING 0.041 FT/FT, 0.080 FT/FT
 DESIGN SPEED 50/40 MPH
 SEE SUPERELEVATION DIAGRAMS
 FOR MORE INFORMATION

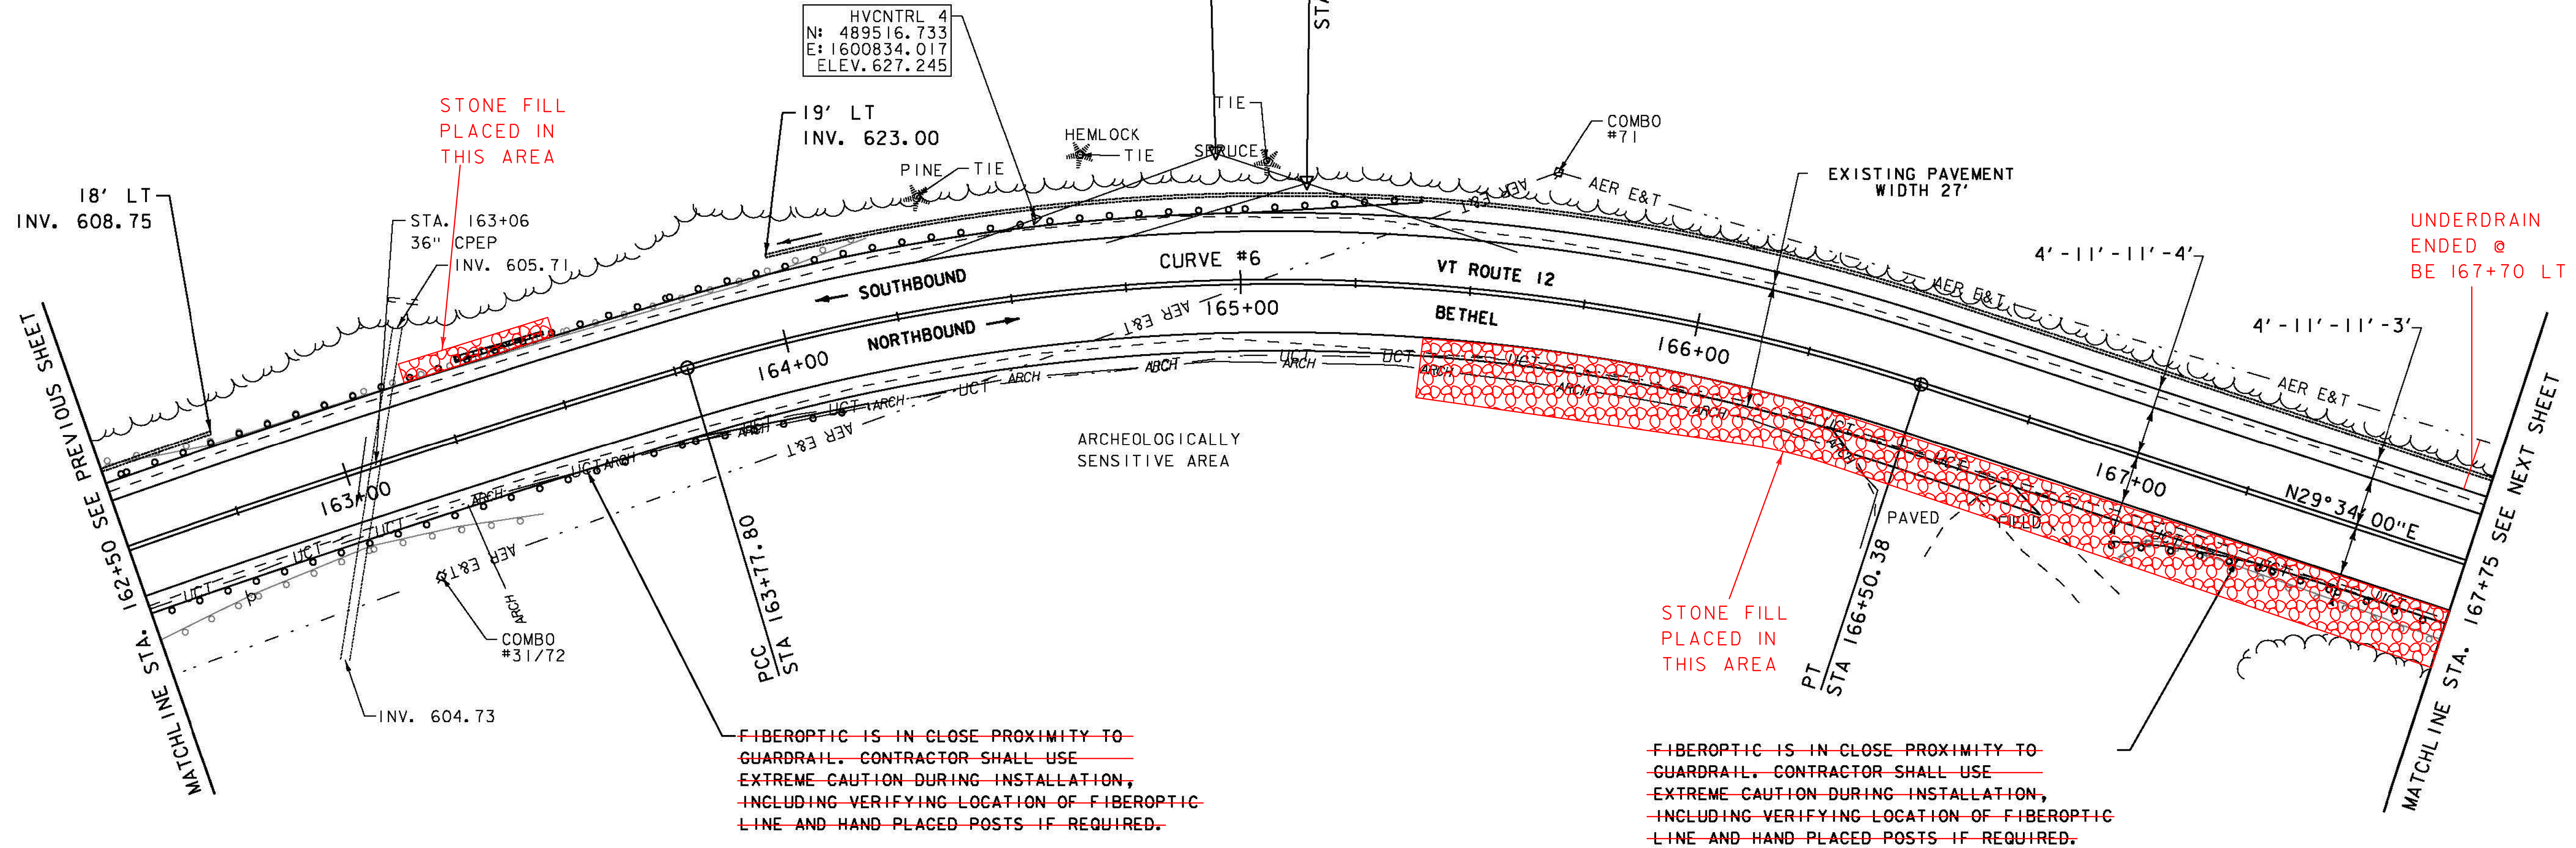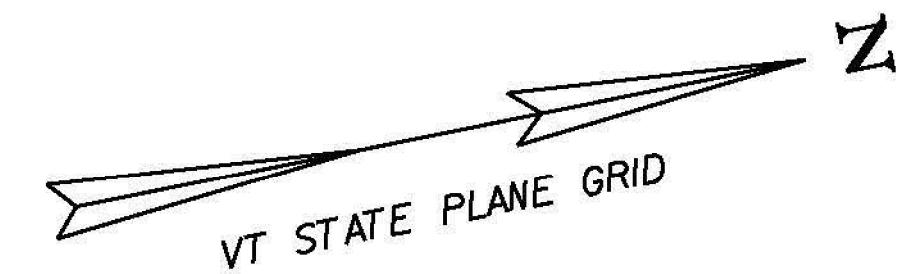

REMOVAL AND DISPOSAL OF GUARDRAIL

STA. 162+50 - STA. 163+40 RT
 STA. 162+51 - STA. 164+21.5 LT
 STA. 167+03 - STA. 167+75 RT

SPECIAL PROVISION (BOX BEAM GUARDRAIL W/7 FEET POSTS)

STA. 162+50 - STA. 164+15 RT
 STA. 162+50 - STA. 165+38 LT 165+54
 STA. 167+00 - STA. 167+75 RT

STONE FILL, TYPE I

STA. 163+30 - STA. 163+50 LT

GEOTEXTILE FOR SILT FENCE

STA. 163+30 - STA. 163+50 LT

GRUBBING MATERIAL (6")


STA. 163+30 - STA. 163+50 LT

STONE FILL, TYPE I

STA. 163+16 - STA. 163+50 RT
 STA. 165+35 - STA. 167+75 RT

SIGN LEGEND

- R = REMOVE
- R&S = REMOVE AND SALVAGE
- RET = RETAIN
- S = SALVAGED
- N = NEW
- B-B = BACK TO BACK
- - = EXISTING
- = NEW

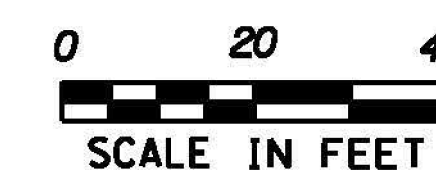

PROJECT NAME: BETHEL-RANDOLPH

PROJECT NUMBER: STP 292(1)

FILE NAME: z10c244bdr.dgn
 PROJECT LEADER: C. LATHROP
 DESIGNED BY: S. LAMPHERE
 PLAN SHEET 8

PLOT DATE: 4/23/2015
 DRAWN BY: S. LAMPHERE
 CHECKED BY: C. LATHROP
 SHEET 34 OF 211