

SOLID ROCK EXCAVATION  
STA. 167+75 - STA. 171+50 LT

REMOVING LARGE TREES  
STA. 172+90 LT

REMOVING SIGNS  
AS SHOWN - 2

ERECTING SALVAGED SIGNS  
AS SHOWN - 1

STONE FILL, TYPE I  
~~STA. 168+25 - STA. 168+50 RT~~  
~~STA. 168+30 - STA. 168+40 LT~~  
~~STA. 169+10 - STA. 169+70 RT~~  
~~STA. 171+30 - STA. 171+60 LT~~

DURABLE 4 INCH WHITE LINE, SEE OPTION ITEMS  
STA. 167+75 - STA. 173+25 (SOLID LT & RT)

DURABLE 4 INCH YELLOW LINE, POLYUREA  
STA. 167+75 - STA. 173+25 (CENTERLINE)

MILLED RUMBLE STRIPS  
STA. 167+75 - STA. 172+00 (CENTERLINE)

GEOTEXTILE FOR SILT FENCE  
STA. 168+25 - STA. 168+50 RT  
STA. 168+30 - STA. 168+40 LT  
STA. 169+10 - STA. 169+70 RT  
STA. 171+30 - STA. 171+60 LT



PRECAST REINFORCED CONCRETE DROP INLET  
STA. 167+75 LT

TEMPORARY 4 INCH WHITE LINE, PAINT  
STA. 167+75 - STA. 173+25 (SOLID LT & RT)

TEMPORARY 4 INCH YELLOW LINE, PAINT  
STA. 167+75 - STA. 173+25 (CENTERLINE)

6 INCH UNDERDRAIN PIPE  
~~STA. 167+75 - STA. 168+00 LT~~  
~~STA. 168+00 RT LT STA. 171+75 LT 171+82~~  
~~STA. 172+00 - STA. 173+25 LT~~

GRUBBING MATERIAL (6")  
STA. 168+25 - STA. 168+50 RT  
STA. 168+30 - STA. 168+40 LT  
STA. 169+10 - STA. 169+70 RT  
STA. 171+30 - STA. 171+60 LT

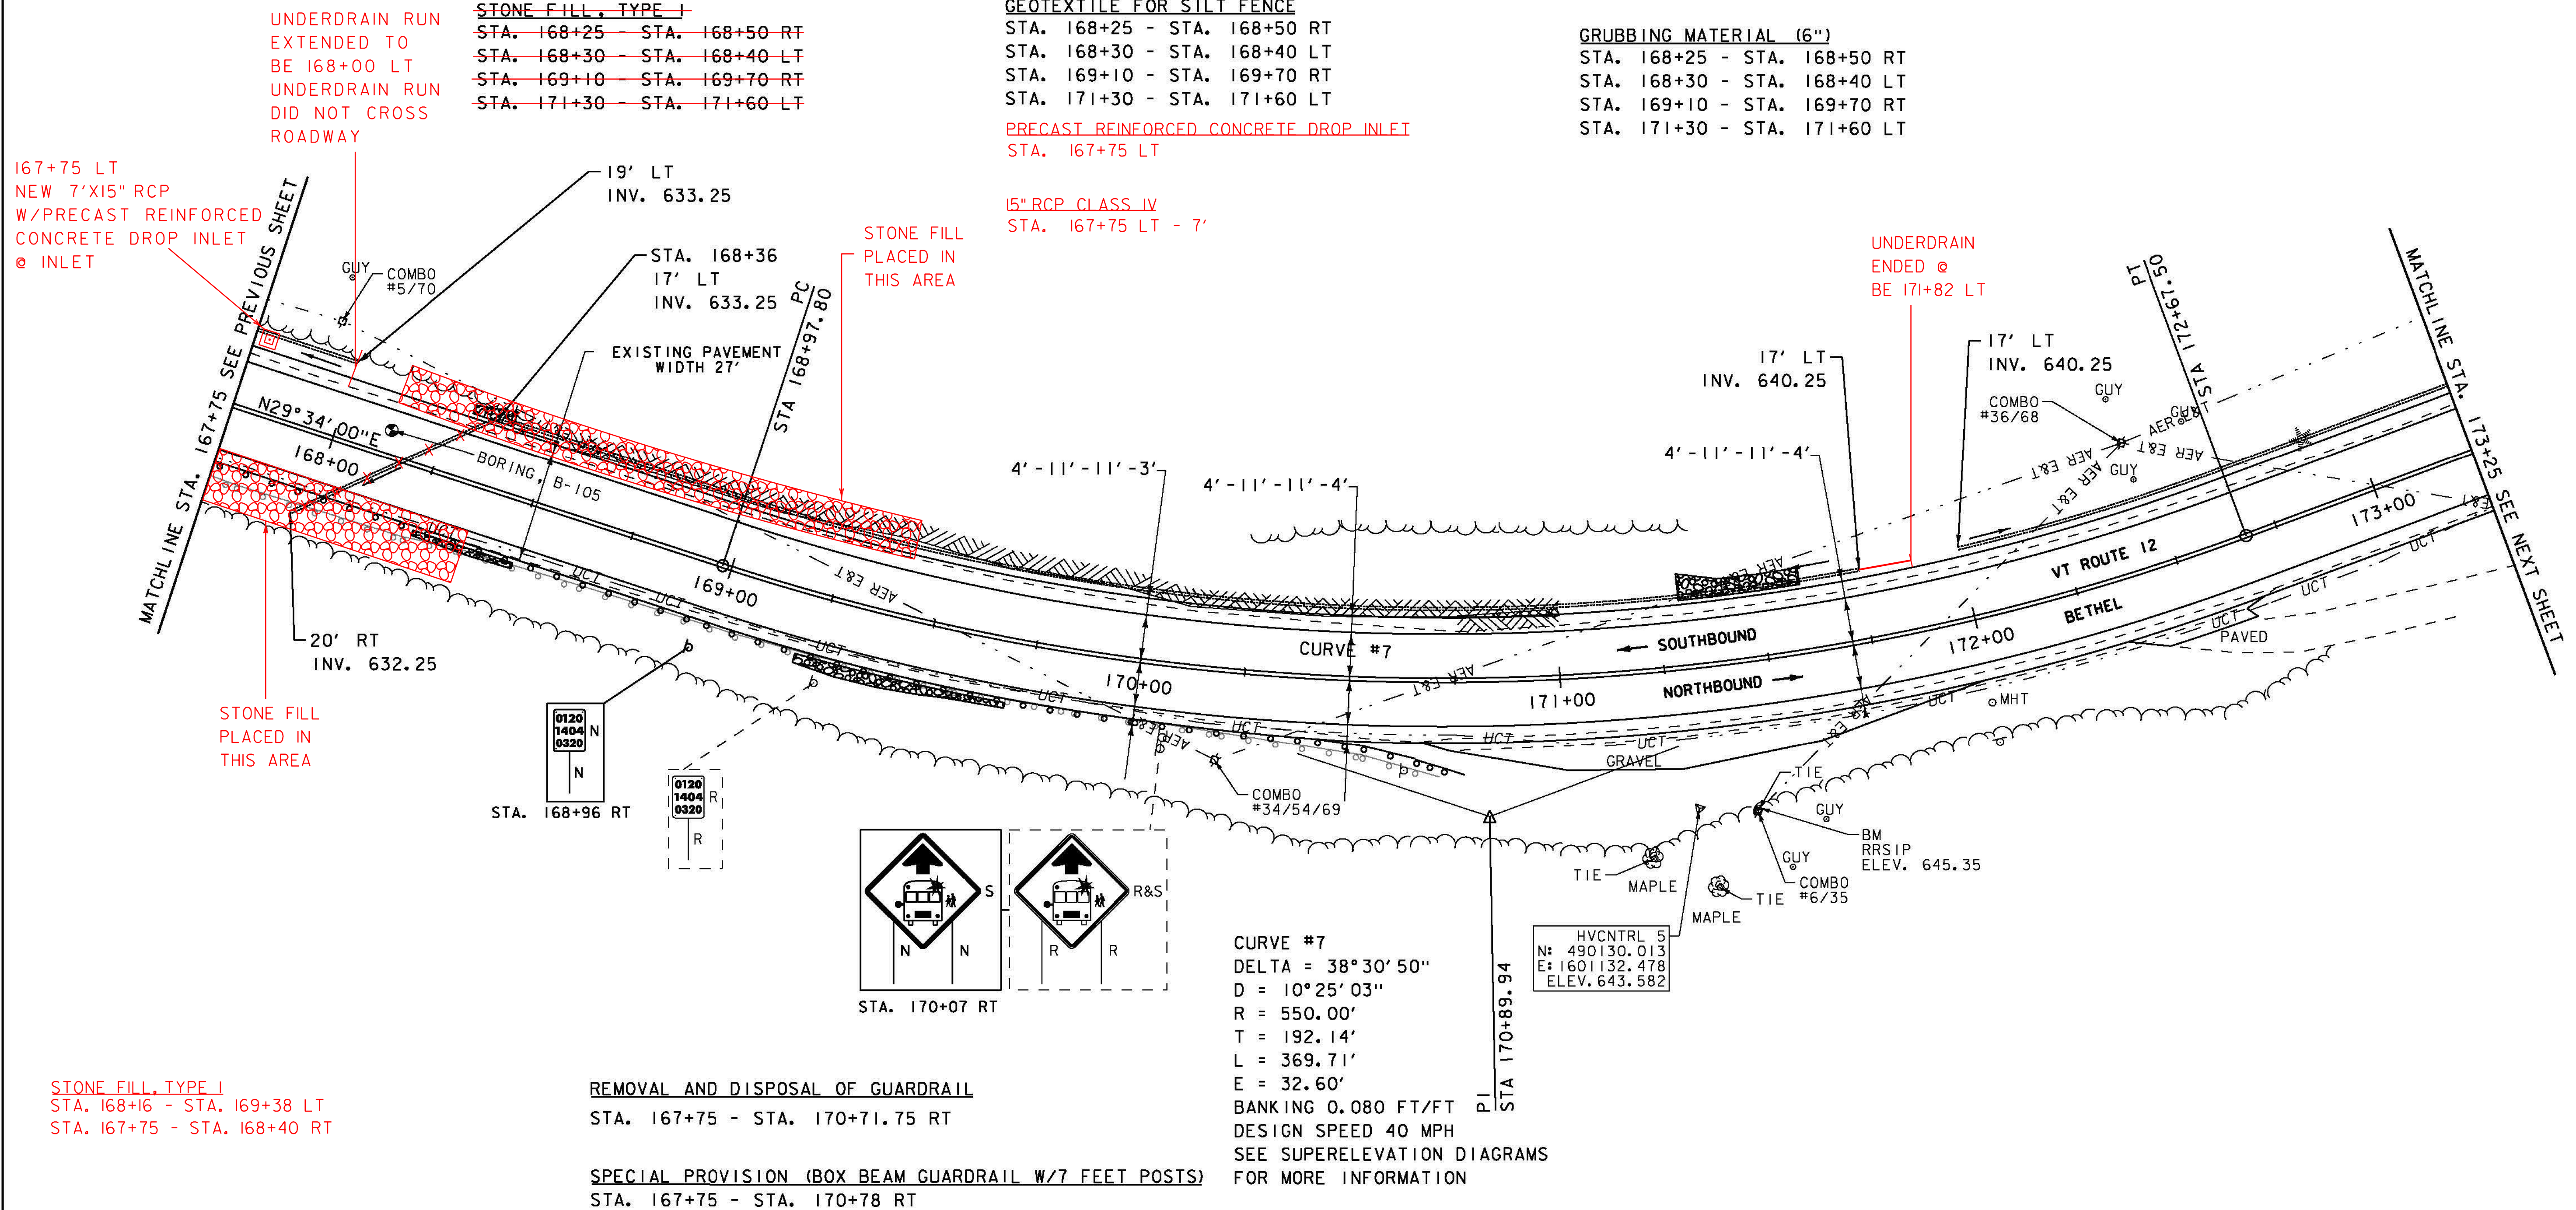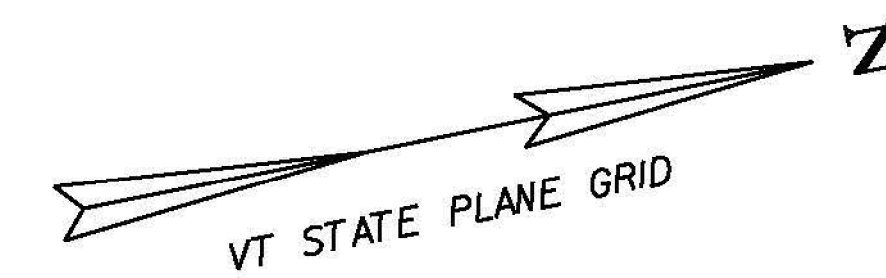

UNDERDRAIN RUN EXTENDED TO BE 168+00 LT UNDERDRAIN RUN DID NOT CROSS ROADWAY

167+75 LT NEW 7'X15" RCP W/PRECAST REINFORCED CONCRETE DROP INLET @ INLET

STONE FILL PLACED IN THIS AREA

UNDERDRAIN ENDED @ BE 171+82 LT

STONE FILL PLACED IN THIS AREA

STONE FILL, TYPE I  
STA. 168+16 - STA. 169+38 LT  
STA. 167+75 - STA. 168+40 RT

REMOVAL AND DISPOSAL OF GUARDRAIL  
STA. 167+75 - STA. 170+71.75 RT

SPECIAL PROVISION (BOX BEAM GUARDRAIL W/7 FEET POSTS)  
STA. 167+75 - STA. 170+78 RT

CURVE #7  
DELTA = 38°30'50"  
D = 10°25'03"  
R = 550.00'  
T = 192.14'  
L = 369.71'  
E = 32.60'  
BANKING 0.080 FT/FT  
DESIGN SPEED 40 MPH  
SEE SUPERELEVATION DIAGRAMS FOR MORE INFORMATION

SIGN LEGEND

- R = REMOVE
- R&S = REMOVE AND SALVAGE
- RET = RETAIN
- S = SALVAGED
- N = NEW
- B-B = BACK TO BACK
- - = EXISTING
- = NEW

PROJECT NAME: BETHEL-RANDOLPH	PLOT DATE: 4/23/2015
PROJECT NUMBER: STP 292(I)	DRAWN BY: S. LAMPHERE
FILE NAME: z10c244bdr.dgn	CHECKED BY: C. LATHROP
DESIGNED BY: S. LAMPHERE	SHEET 35 OF 211
PLAN SHEET 9	

