

DURABLE 4 INCH WHITE LINE, SEE OPTION ITEMS
 STA. 173+25 - STA. 178+75 (SOLID LT & RT)
 (WITH EDGE LINE BREAKS AT TH#38)
 STA. 175+73 LT (EDGE LINES AT TH#38)

DURABLE 4 INCH YELLOW LINE, POLYUREA
 STA. 173+25 - STA. 178+75 (CENTERLINE)
 (WITH CENTERLINE BREAKS AT TH#38)
 STA. 175+73 LT (CENTERLINE AT TH#38)

DURABLE 24" STOP BAR (SEE OPTION ITEMS)
 STA. 175+40 - STA. 175+68 LT

DURABLE LETTER OR SYMBOL (SEE OPTION ITEMS)
 STA. 175+56 LT "STOP"

TEMPORARY 4 INCH WHITE LINE, PAINT
 STA. 173+25 - STA. 178+75 (SOLID LT & RT)
 (WITH EDGE LINE BREAKS AT TH#38)
 STA. 175+73 LT (EDGE LINES AT TH#38)

TEMPORARY 4 INCH YELLOW LINE, PAINT
 STA. 173+25 - STA. 178+75 (CENTERLINE)
 (WITH CENTERLINE BREAKS AT TH#38)
 STA. 175+73 LT (CENTERLINE AT TH#38)

TEMPORARY 24" STOP BAR, PAINT
 STA. 175+40 - STA. 175+68 LT

TEMPORARY LETTER OR SYMBOL, PAINT
 STA. 175+56 LT "STOP"

6 INCH UNDERDRAIN PIPE
 STA. 173+25 - STA. 175+32 LT
 STA. 178+05 - STA. 178+75 RT
 178+00




CONNECT PROPOSED UNDERDRAIN
 TO CATCH BASIN (PAY ITEM
 900.620 "SPECIAL PROVISION
 (CORING CONCRETE)")

35' LT
 INV. 629.50



STA. 175+04
 17' LT AER E&T

4' - 11' - 11' - 4'

COMBO #67/36.5

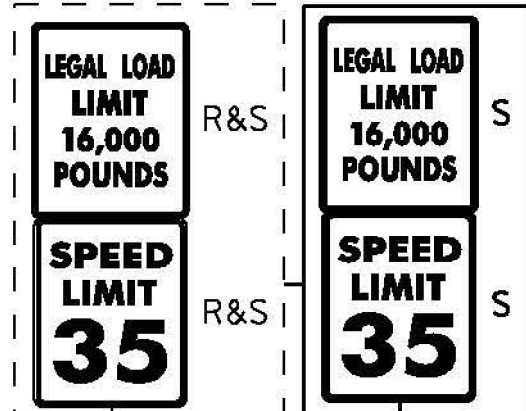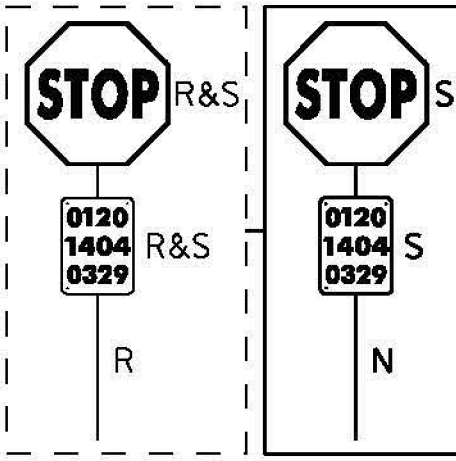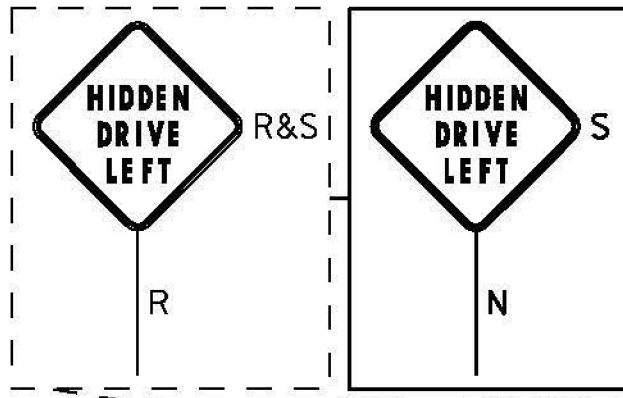

CURVE #8
 DELTA = 37°41'54"
 D = 10°21'39" (1) D = 4°35'01" (2)
 R = 553.00' (1) R = 1250.00' (2)
 T = 205.51' (1) T = 294.50' (2)
 L = 269.01' (1) L = 214.37' (2)
 E = 36.95'
 BANKING 0.060 FT/FT, 0.055 FT/FT
 DESIGN SPEED 40/50 MPH
 SEE SUPERELEVATION DIAGRAMS
 FOR MORE INFORMATION

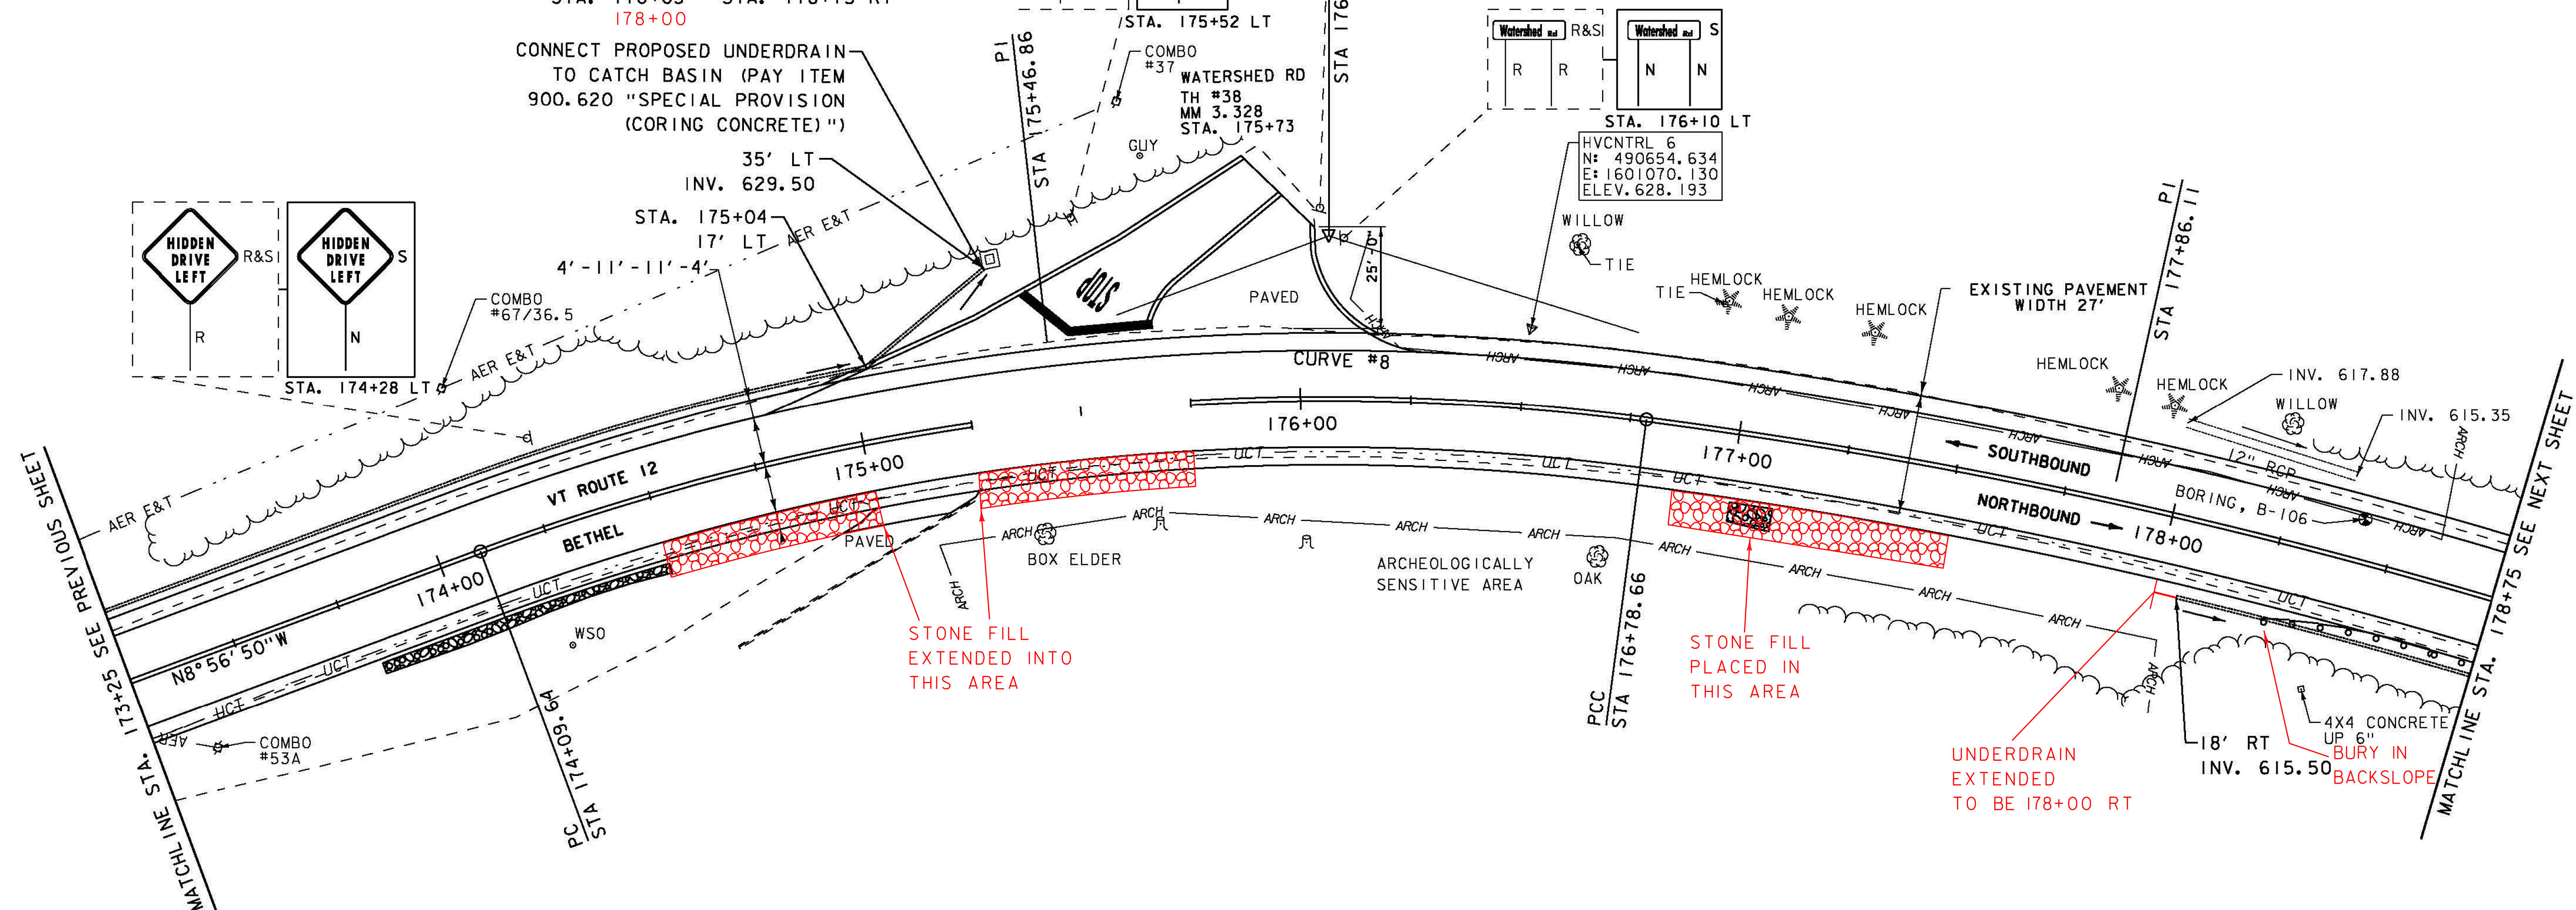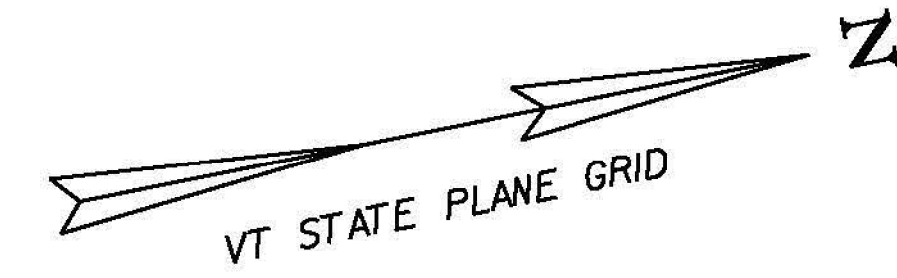

STONE FILL
 EXTENDED INTO
 THIS AREA

STONE FILL
 PLACED IN
 THIS AREA

UNDERDRAIN
 EXTENDED
 TO BE 178+00 RT

STONE FILL, TYPE J 175+00
 STA. 173+80 - STA. 174+50 RT
 176+88 STA. 177+00 - STA. 177+10 RT
 STA. 175+25 - STA. 175+75 RT

GEOTEXTILE FOR SILT FENCE
 STA. 173+80 - STA. 174+50 RT
 STA. 177+00 - STA. 177+10 RT

GRUBBING MATERIAL (6")
 STA. 173+80 - STA. 174+50 RT
 STA. 177+00 - STA. 177+10 RT

SPECIAL PROVISION (BOX BEAM GUARDRAIL W/7 FEET POSTS)
 STA. 178+20.50 - STA. 178+75 RT

SPECIAL PROVISION (CORING CONCRETE)
 STA. 175+32 LT


REMOVING SIGNS
 AS SHOWN - 6

ERECTING SALVAGED SIGNS
 AS SHOWN - 6

REHAB. DROP INLETS, CATCH BASINS, OR MANHOLES, CLASS J
 STA. 175+32 LT

SIGN LEGEND

- R = REMOVE
- R&S = REMOVE AND SALVAGE
- RET = RETAIN
- S = SALVAGED
- N = NEW
- B-B = BACK TO BACK
- - = EXISTING
- = NEW

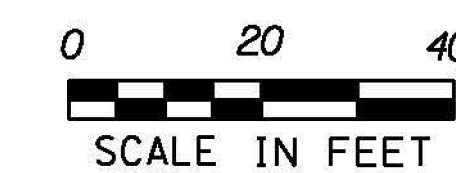

PROJECT NAME: BETHEL-RANDOLPH
 PROJECT NUMBER: STP 292(1)

FILE NAME: z10c244bdr.dgn
 PROJECT LEADER: C. LATHROP
 DESIGNED BY: S. LAMPHERE
 PLAN SHEET 10

PLOT DATE: 4/23/2015
 DRAWN BY: S. LAMPHERE
 CHECKED BY: C. LATHROP
 SHEET 36 OF 211