

CURVE #13
 DELTA = 75°49'59"
 D = 7°17'56" (1) D = 2°16'25" (2) D = 0°17'11" (3)
 R = 785.00' (1) R = 2520.00' (2) R = 20000.00' (3)
 T = 623.04' (1) T = 939.24' (2)
 L = 951.88' (1) L = 259.64' (2) L = 158.46' (3)
 E = 217.20'
 BANKING 0.060 FT/FT, 0.042 FT/FT, NORMAL CROWN
 DESIGN SPEED 50 MPH
 SEE SUPERELEVATION DIAGRAMS
 FOR MORE INFORMATION

DURABLE 4 INCH WHITE LINE, SEE OPTION ITEMS
 STA. 211+75 - STA. 217+50 (SOLID LT & RT)
 (WITH EDGE LINE BREAKS AT TH#2)
 STA. 211+85 LT (EDGE LINE AT TH#2)
 STA. 215+30 LT (EDGE LINE AT TH#2)

DURABLE 4 INCH YELLOW LINE, POLYUREA
 STA. 211+75 - STA. 217+50 (CENTERLINE)
 (WITH CENTERLINE BREAKS AT TH#2 & TH#2)
 STA. 211+85 LT (CENTERLINE AT TH#2)
 STA. 215+30 LT (CENTERLINE AT TH#2)

DURABLE 24" STOP BAR (SEE OPTION ITEMS)
 STA. 212+05 - STA. 212+12 LT
 STA. 214+54 - STA. 214+91 LT

DURABLE LETTER OR SYMBOL (SEE OPTION ITEMS)
 STA. 212+16 LT "STOP"
 STA. 214+63 LT "STOP"

TEMPORARY 4 INCH WHITE LINE, PAINT
 STA. 211+75 - STA. 217+50 (SOLID LT & RT)
 (WITH EDGE LINE BREAKS AT TH#2)
 STA. 211+85 LT (EDGE LINE AT TH#2)
 STA. 215+30 LT (EDGE LINE AT TH#2)

TEMPORARY 4 INCH YELLOW LINE, PAINT
 STA. 211+75 - STA. 217+50 (CENTERLINE)
 (WITH CENTERLINE BREAKS AT TH#2 & TH#2)
 STA. 211+85 LT (CENTERLINE AT TH#2)
 STA. 215+30 LT (CENTERLINE AT TH#2)

TEMPORARY 24" STOP BAR, PAINT
 STA. 212+05 - STA. 212+12 LT
 STA. 214+54 - STA. 214+91 LT

TEMPORARY LETTER OR SYMBOL, PAINT
 STA. 212+16 LT "STOP"
 STA. 214+63 LT "STOP"

STONE FILL, TYPE 1
 STA. 213+80 - STA. 214+00 RT


GEOTEXTILE FOR SILT FENCE
 STA. 213+80 - STA. 214+00 RT

GRUBBING MATERIAL (6")
 STA. 213+80 - STA. 214+00 RT

REMOVING SIGNS
 AS SHOWN - 5

ERECTING SALVAGED SIGNS
 AS SHOWN - 4

SIGN LEGEND
 R = REMOVE
 R&S = REMOVE AND SALVAGE
 RET = RETAIN
 S = SALVAGED
 N = NEW
 B-B = BACK TO BACK
 - - = EXISTING
 — = NEW

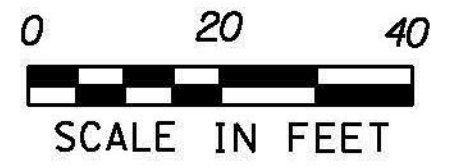

PROJECT NAME: BETHEL-RANDOLPH
 PROJECT NUMBER: STP 2921(I)

FILE NAME: z10c244bdr.dgn
 PROJECT LEADER: C. LATHROP
 DESIGNED BY: S. LAMPHERE
 PLAN SHEET 17

PLOT DATE: 4/23/2015
 DRAWN BY: S. LAMPHERE
 CHECKED BY: C. LATHROP
 SHEET 43 OF 211