

DURABLE 4 INCH WHITE LINE, SEE OPTION ITEMS
STA. 217+50 - STA. 222+75 (SOLID LT & RT)

TEMPORARY 4 INCH WHITE LINE, PAINT
STA. 217+50 - STA. 222+75 (SOLID LT & RT)

DURABLE 4 INCH YELLOW LINE, POLYUREA
STA. 217+50 - STA. 222+75 (CENTERLINE)

TEMPORARY 4 INCH YELLOW LINE, PAINT
STA. 217+50 - STA. 222+75 (CENTERLINE)

REHAB DROP INLETS, CATCH BASINS,
OR MANHOLES, CLASS I
STA. 220+45 LT

MILLED RUMBLE STRIPS
STA. 221+25 - STA. 222+75 (CENTERLINE)

STONE FILL, TYPE I
STA. 220+25 - STA. 220+30 LT
STA. 220+40 - STA. 220+60 LT



REMOVING SIGNS
AS SHOWN - 2

ERECTING SALVAGED SIGNS
AS SHOWN - 2

GEOTEXTILE FOR SILT FENCE
STA. 220+25 - STA. 220+30 LT
STA. 220+40 - STA. 220+60 LT

GRUBBING MATERIAL (6")
STA. 220+25 - STA. 220+30 LT
STA. 220+40 - STA. 220+60 LT

18" CPEP(SL)
STA. 220+43 RT-6'

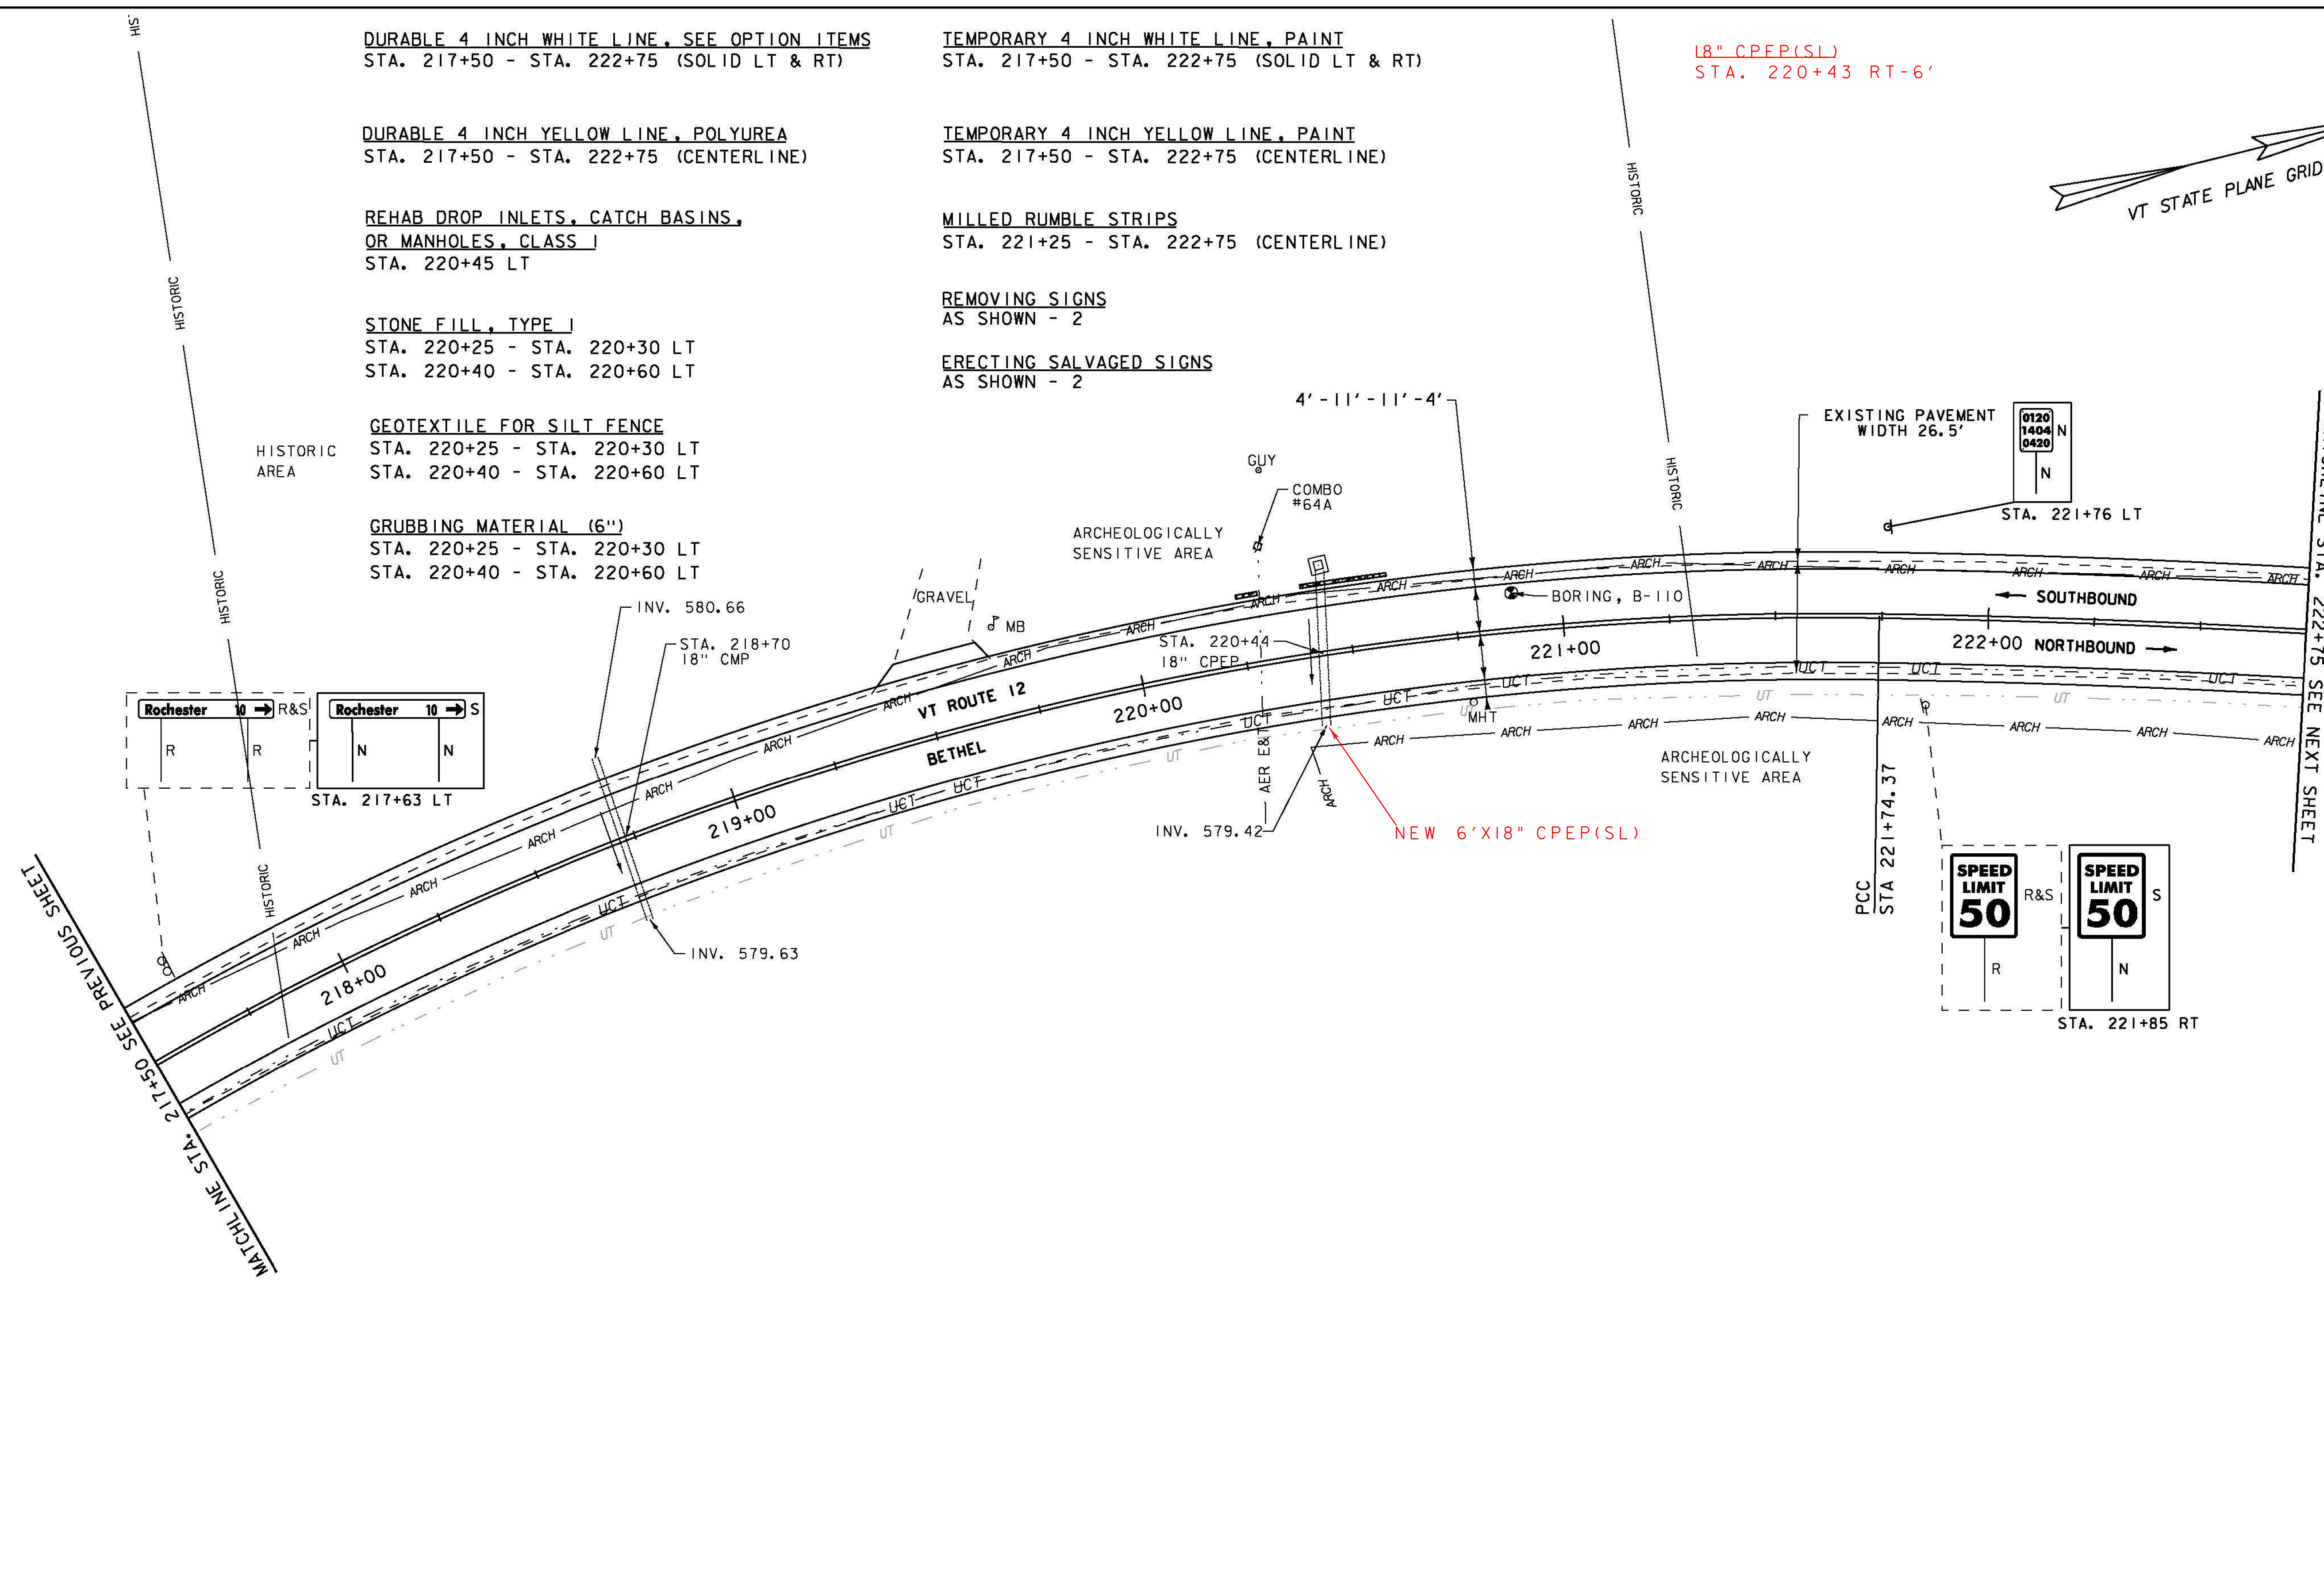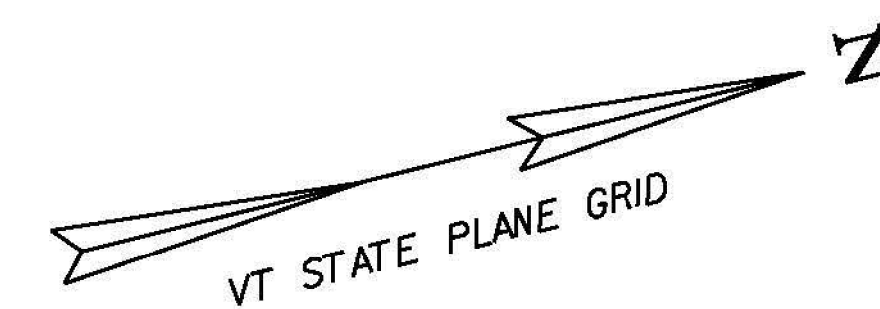

MATCHLINE STA. 217+50 SEE PREVIOUS SHEET

MATCHLINE STA. 222+75 SEE NEXT SHEET

SIGN LEGEND

- R = REMOVE
- R&S = REMOVE AND SALVAGE
- RET = RETAIN
- S = SALVAGED
- N = NEW
- B-B = BACK TO BACK
- - = EXISTING
- = NEW

PROJECT NAME: BETHEL-RANDOLPH	
PROJECT NUMBER: STP 292(I)	
FILE NAME: z10c244bdr.dgn	PLOT DATE: 4/23/2015
PROJECT LEADER: C. LATHROP	DRAWN BY: S. LAMPHERE
DESIGNED BY: S. LAMPHERE	CHECKED BY: C. LATHROP
PLAN SHEET 18	SHEET 44 OF 211

