


STA. 291+19 LT
 CURVE #23
 DELTA = 26°42'08"
 D = 5°12'31" (1) D = 9°42'40" (2)
 R = 1100.00' (1) R = 590.00' (2)
 T = 197.34' (1) T = 149.51' (2)
 L = 142.29' (1) L = 198.65' (2)
 E = 17.56'
 BANKING 0.057 FT/FT, 0.060 FT/FT
 DESIGN SPEED 50 MPH
 SEE SUPERELEVATION DIAGRAMS
 FOR MORE INFORMATION

HVCNTRL 13
 N: 501272.222
 E: 1601430.583
 ELEV. 730.940

GILEAD BROOK RD
 TH #7
 MM 5.525
 STA. 291+72

Gilead Brook
 R&S
 STA. 291+92 LT

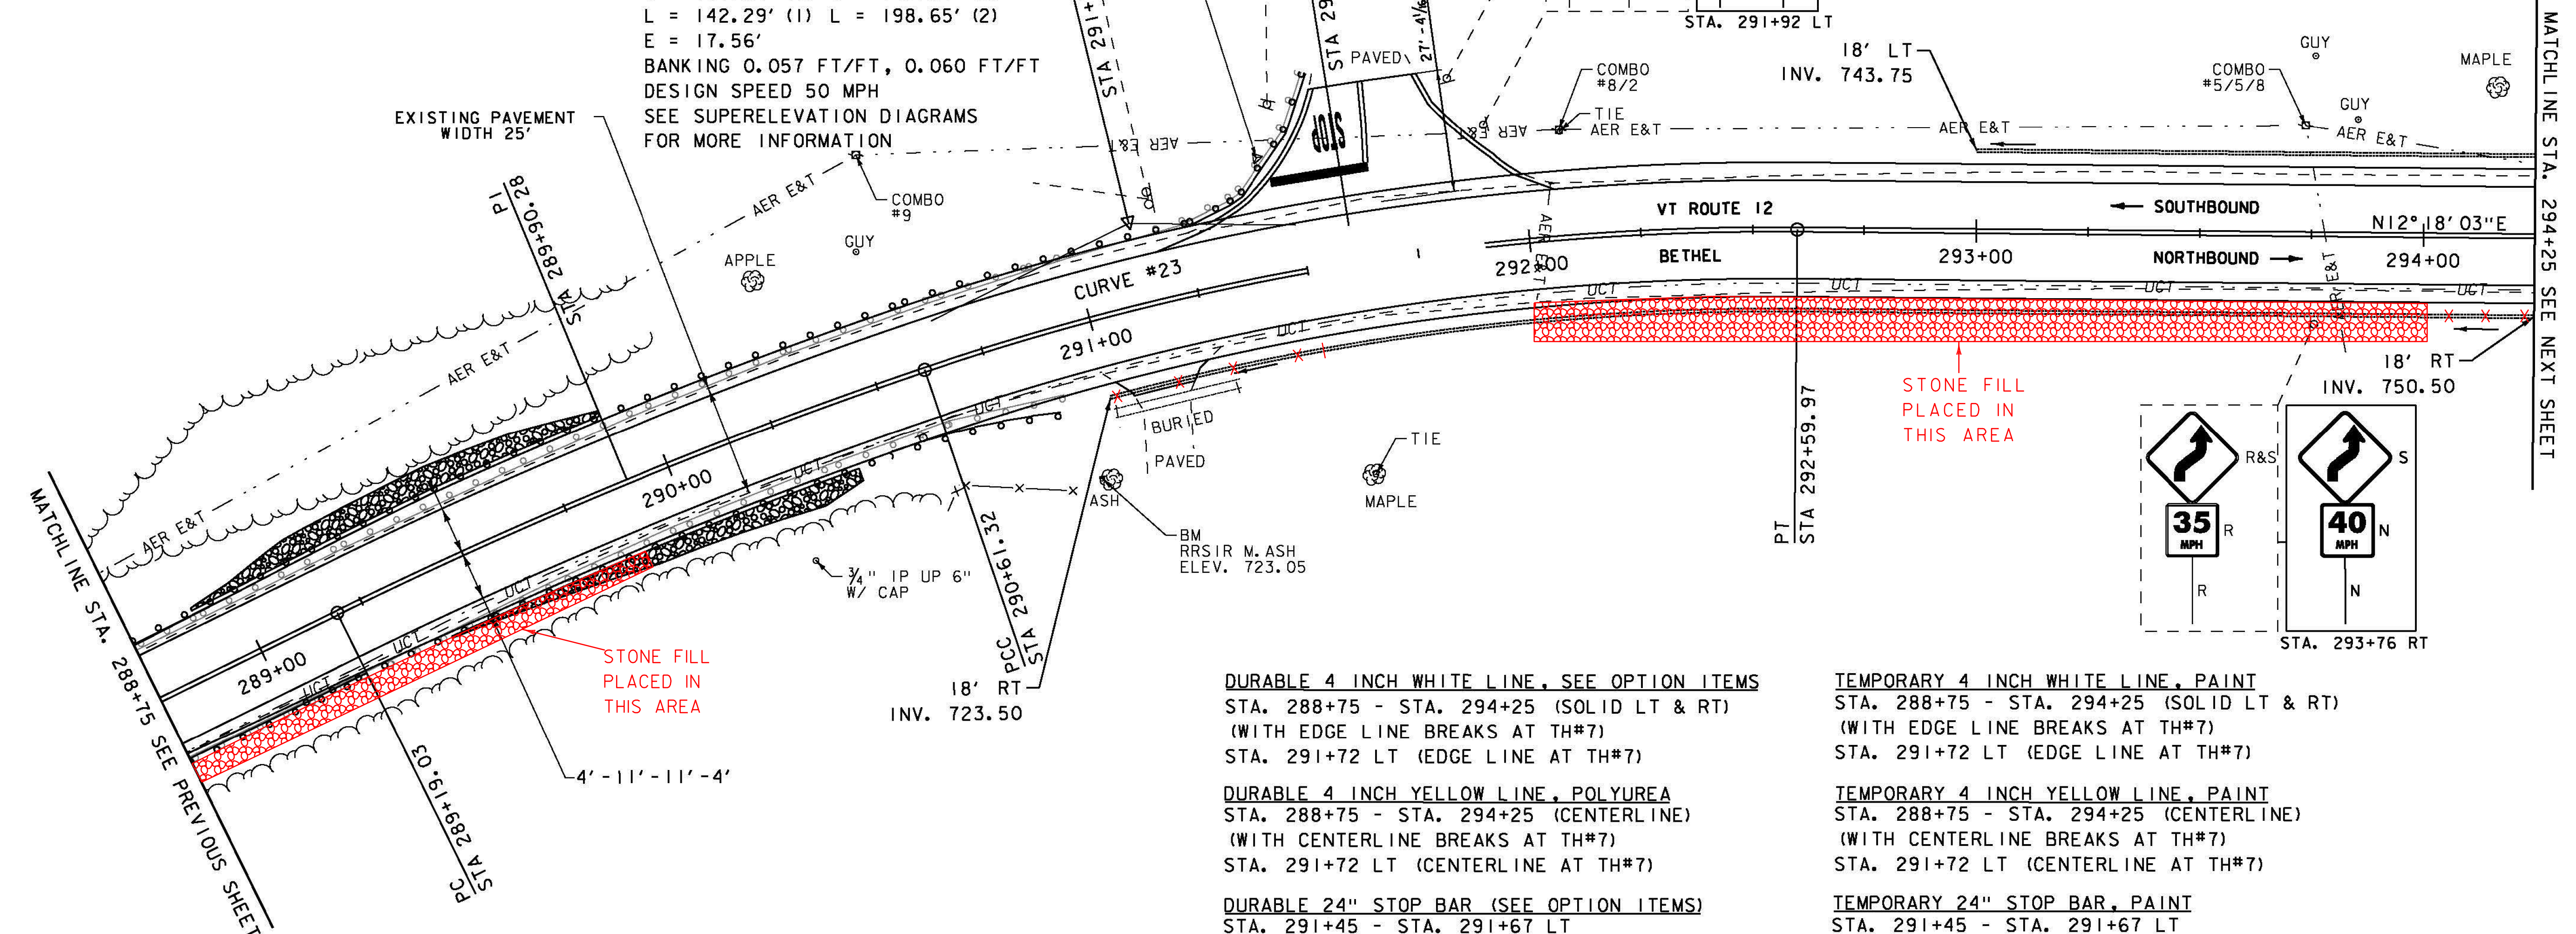

MATCH LINE STA. 288+75 SEE PREVIOUS SHEET
 MATCH LINE STA. 294+25 SEE NEXT SHEET

~~6 INCH UNDERDRAIN PIPE~~
~~STA. 291+00 - STA. 294+25 RT~~

~~REMOVAL AND DISPOSAL OF GUARDRAIL~~
~~STA. 288+75 - STA. 290+93 RT~~
~~STA. 288+75 - STA. 291+56 LT~~

~~STEEL BEAM GUARDRAIL, GALVANIZED~~
~~W/8 FEET POSTS~~
~~STA. 288+75 - STA. 290+76 RT~~
~~STA. 288+75 - STA. 291+38.5 LT~~

~~STEEL BEAM GUARDRAIL, GALVANIZED~~
~~STA. 290+76 - STA. 290+88.5 RT~~
~~STA. 291+38.5 - STA. 291+51 LT~~
~~STA. 290+36 - STA. 290+86 RT~~

ANCHOR FOR STEEL BEAM GUARDRAIL
 STA. 290+82 RT

DURABLE 4 INCH WHITE LINE, SEE OPTION ITEMS
 STA. 288+75 - STA. 294+25 (SOLID LT & RT)
 (WITH EDGE LINE BREAKS AT TH#7)
 STA. 291+72 LT (EDGE LINE AT TH#7)

DURABLE 4 INCH YELLOW LINE, POLYUREA
 STA. 288+75 - STA. 294+25 (CENTERLINE)
 (WITH CENTERLINE BREAKS AT TH#7)
 STA. 291+72 LT (CENTERLINE AT TH#7)

DURABLE 24" STOP BAR (SEE OPTION ITEMS)
 STA. 291+45 - STA. 291+67 LT

DURABLE LETTER OR SYMBOL (SEE OPTION ITEMS)
 STA. 291+60 LT "STOP"

STONE FILL, TYPE I
 STA. 288+90 - STA. 289+90 LT
 STA. 288+75 - STA. 290+40 RT
 STA. 292+00 - STA. 294+00 RT

GEOTEXTILE FOR SILT FENCE
 STA. 288+90 - STA. 289+90 LT
 STA. 289+40 - STA. 290+40 RT

GRUBBING MATERIAL (6")
 STA. 288+90 - STA. 289+90 LT
 STA. 289+40 - STA. 290+40 RT

TEMPORARY 4 INCH WHITE LINE, PAINT
 STA. 288+75 - STA. 294+25 (SOLID LT & RT)
 (WITH EDGE LINE BREAKS AT TH#7)
 STA. 291+72 LT (EDGE LINE AT TH#7)

TEMPORARY 4 INCH YELLOW LINE, PAINT
 STA. 288+75 - STA. 294+25 (CENTERLINE)
 (WITH CENTERLINE BREAKS AT TH#7)
 STA. 291+72 LT (CENTERLINE AT TH#7)

TEMPORARY 24" STOP BAR, PAINT
 STA. 291+45 - STA. 291+67 LT

TEMPORARY LETTER OR SYMBOL, PAINT
 STA. 291+60 LT "STOP"


~~6 INCH UNDERDRAIN PIPE~~
~~STA. 293+00 - STA. 294+25 LT~~

~~REMOVING SIGNS~~
 AS SHOWN - 7

~~ERECTING SALVAGED SIGNS~~
 AS SHOWN - 6

6 INCH UNDERDRAIN PIPE
 STA. 292+50 - STA. 294+00 LT
 STA. 291+49 - STA. 293+89 RT

SIGN LEGEND
 R = REMOVE
 R&S = REMOVE AND SALVAGE
 RET = RETAIN
 S = SALVAGED
 N = NEW
 B-B = BACK TO BACK
 - - = EXISTING
 — = NEW

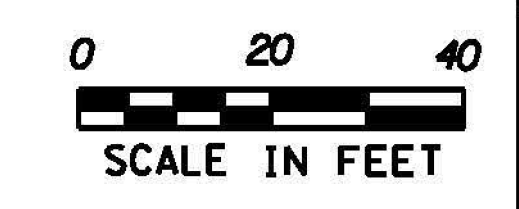

PROJECT NAME:	BETHEL-RANDOLPH	FILE NAME:	z10c244bdr.dgn	PLOT DATE:	4/23/2015
PROJECT NUMBER:	STP 292(I)	PROJECT LEADER:	C. LATHROP	DRAWN BY:	S. LAMPHERE
		DESIGNED BY:	S. LAMPHERE	CHECKED BY:	C. LATHROP
		PLAN SHEET 31		SHEET 57 OF 211	