

REHAB DROP INLETS, CATCH BASINS,
OR MANHOLES, CLASS I
STA. 330+92 RT

DURABLE 4 INCH WHITE LINE, SEE OPTION ITEMS
STA. 327+75 - STA. 333+50 (SOLID LT & RT)
DURABLE 4 INCH YELLOW LINE, POLYUREA
STA. 327+75 - STA. 333+50 (CENTERLINE)



REMOVING SIGNS
AS SHOWN - 4

ERECTING SALVAGED SIGNS
AS SHOWN - 1

TEMPORARY 4 INCH WHITE LINE, PAINT
STA. 327+75 - STA. 333+50 (SOLID LT & RT)
TEMPORARY 4 INCH YELLOW LINE, PAINT
STA. 327+75 - STA. 333+50 (CENTERLINE)


~~6 INCH UNDERDRAIN PIPE~~
~~STA. 332+50 - STA. 333+50 LT~~

CURVE #29
DELTA = 39°02'13"
D = 7°26'28"
R = 770.00'
T = 272.95'
L = 524.62'
E = 46.95'
BANKING 0.080 FT/FT
DESIGN SPEED 50 MPH
SEE SUPERELEVATION DIAGRAMS
FOR MORE INFORMATION

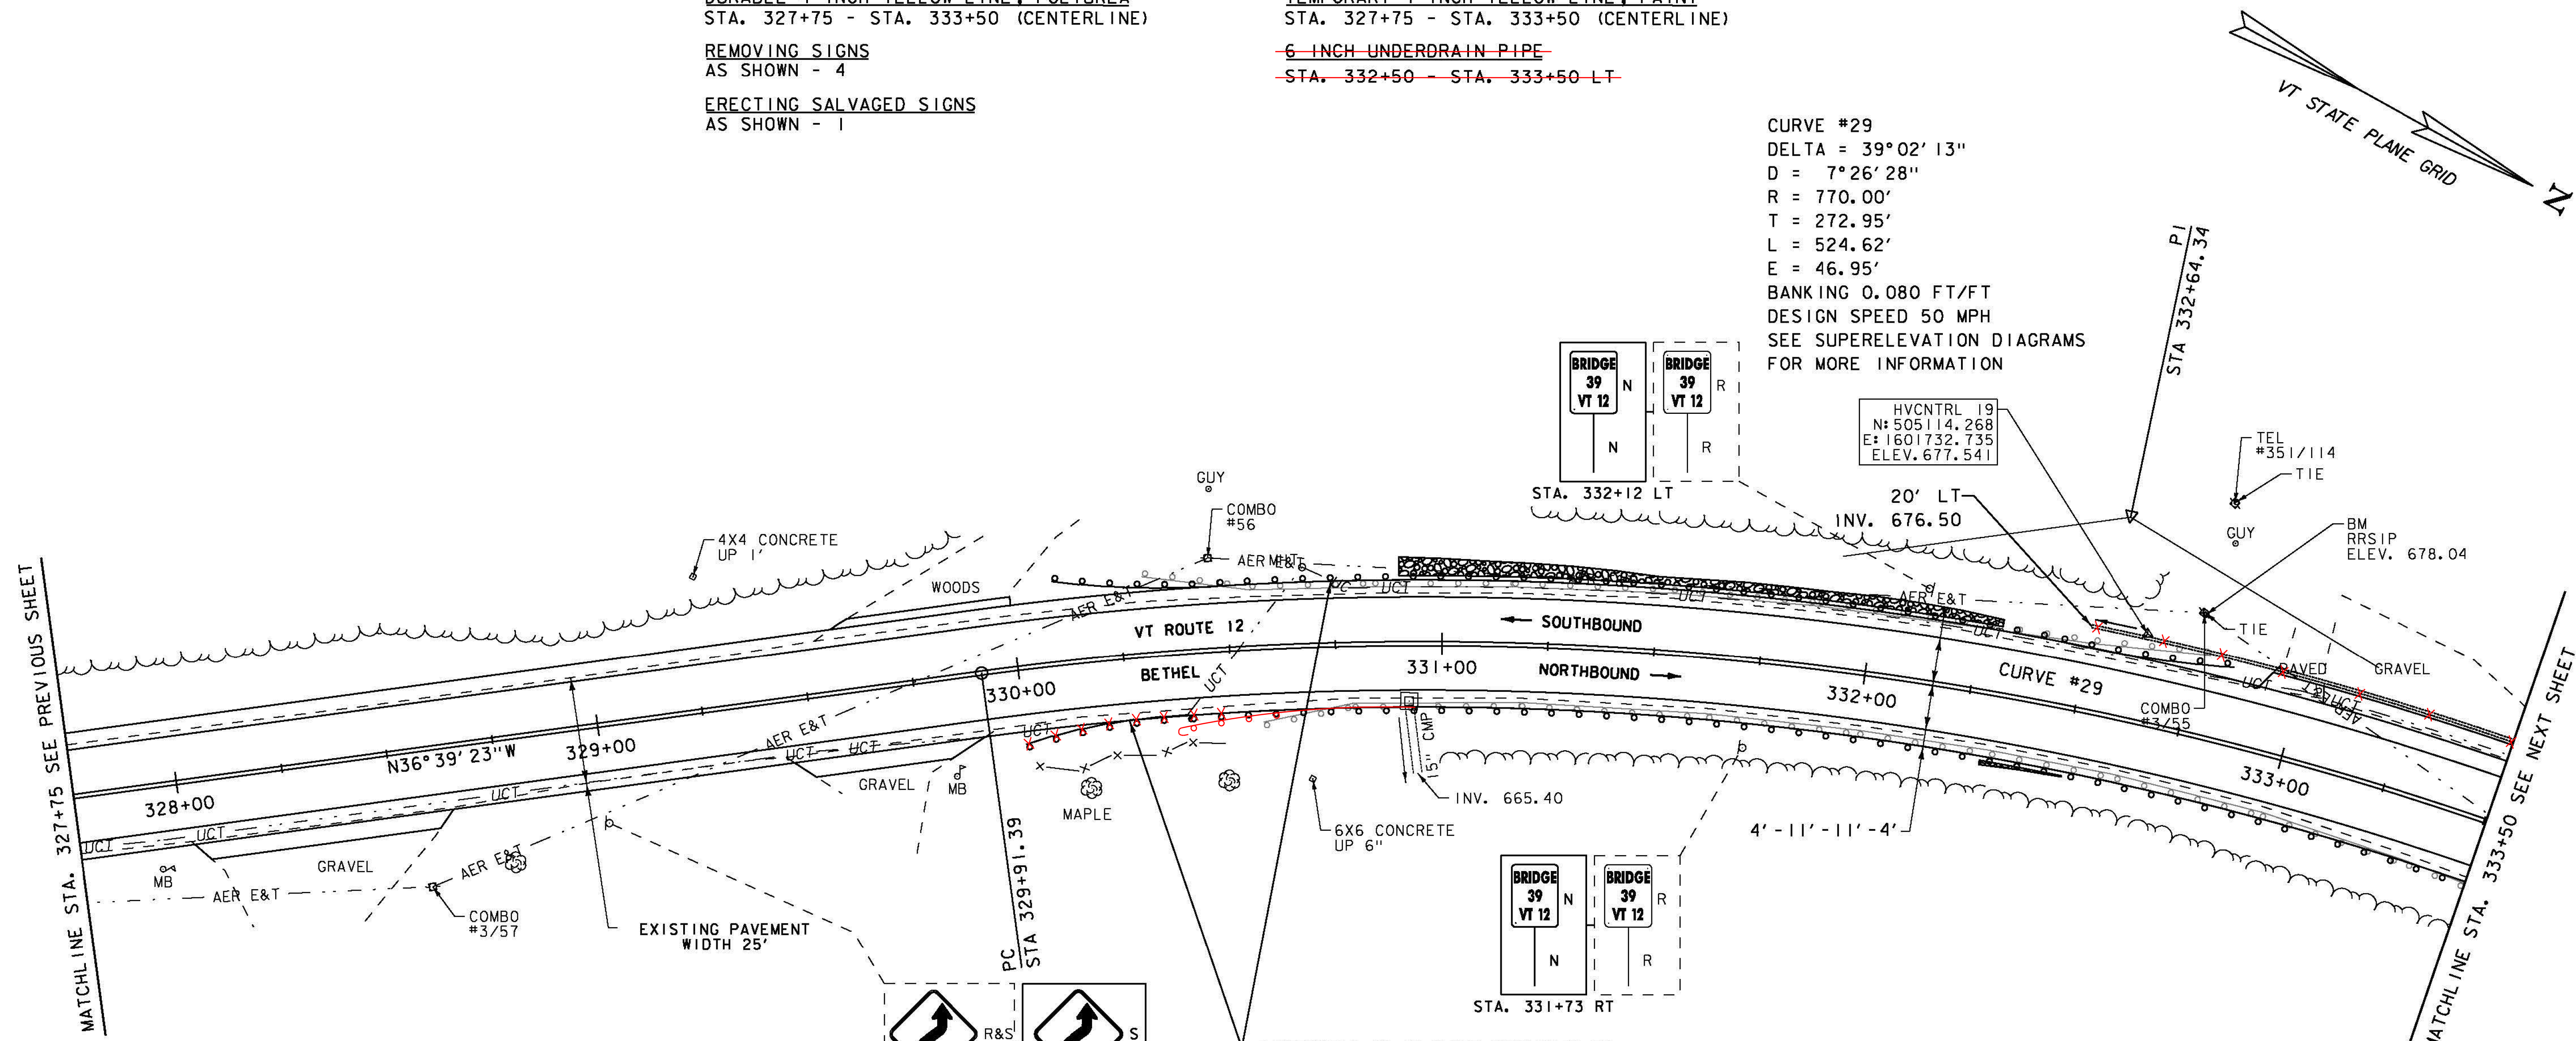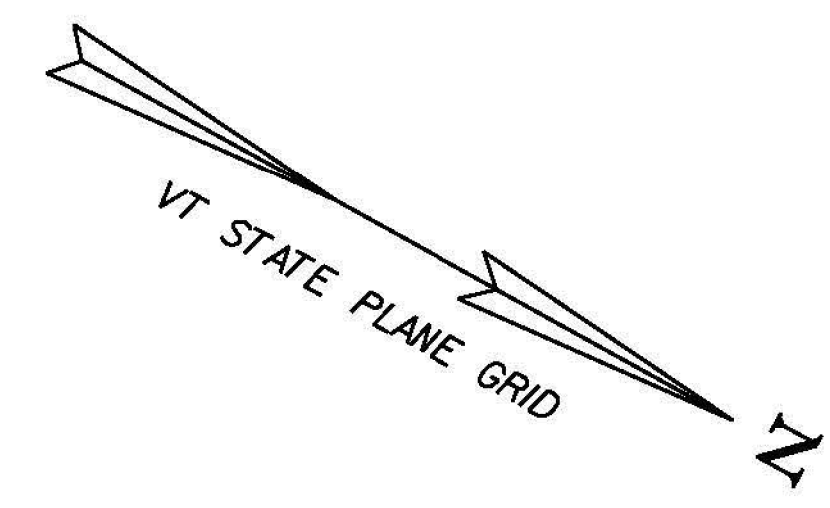

MATCHLINE STA. 327+75 SEE PREVIOUS SHEET

MATCHLINE STA. 333+50 SEE NEXT SHEET

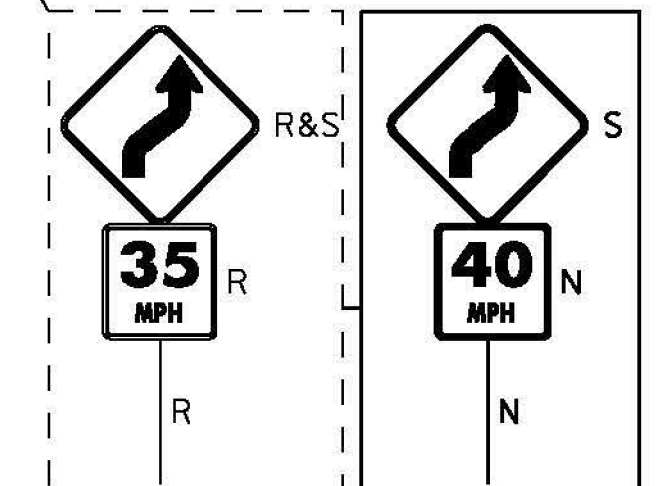

FIBEROPTIC IS IN CLOSE PROXIMITY TO GUARDRAIL. CONTRACTOR SHALL USE EXTREME CAUTION DURING INSTALLATION, INCLUDING VERIFYING LOCATION OF FIBEROPTIC LINE AND HAND PLACED POSTS IF REQUIRED.

TREATED TIMBER CURB
STA. ~~330+00~~ - STA. 333+50 RT
~~330+90~~

STONE FILL, TYPE I
STA. 330+90 - STA. 332+30 LT
STA. 332+30 - STA. 332+50 RT


REMOVAL AND DISPOSAL OF GUARDRAIL
STA. 330+31 - STA. 332+78 LT
STA. 330+57 - STA. 333+50 RT

GEOTEXTILE FOR SILT FENCE
STA. 330+90 - STA. 332+30 LT
STA. 332+30 - STA. 332+50 RT

~~330+32~~
SPECIAL PROVISION (BOX BEAM GUARDRAIL W/7 FEET POSTS)
STA. ~~330+00~~ - STA. 333+50 RT
STA. ~~330+10~~ - STA. 332+80 LT
~~330+02~~

GRUBBING MATERIAL (6")
STA. 330+90 - STA. 332+30 LT
STA. 332+30 - STA. 332+50 RT

SIGN LEGEND
R = REMOVE
R&S = REMOVE AND SALVAGE
RET = RETAIN
S = SALVAGED
N = NEW
B-B = BACK TO BACK
-- = EXISTING
— = NEW

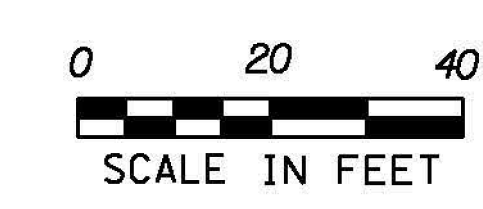

PROJECT NAME: BETHEL-RANDOLPH	PLOT DATE: 4/23/2015
PROJECT NUMBER: STP 292(I)	DRAWN BY: S. LAMPHERE
FILE NAME: z10c244bdr.dgn	CHECKED BY: C. LATHROP
PROJECT LEADER: C. LATHROP	SHEET 64 OF 211
DESIGNED BY: S. LAMPHERE	
PLAN SHEET 38	