

DURABLE 4 INCH WHITE LINE, SEE OPTION ITEMS
 STA. 338+75 - STA. 344+25 (SOLID LT & RT)

TEMPORARY 4 INCH WHITE LINE, PAINT
 STA. 338+75 - STA. 344+25 (SOLID LT & RT)

DURABLE 4 INCH YELLOW LINE, POLYUREA
 STA. 338+75 - STA. 340+40 (CENTERLINE)
~~STA. 340+40 - STA. 344+25 (SOLID LT, DASHED RT)~~



TEMPORARY 4 INCH YELLOW LINE, PAINT
 STA. 338+75 - STA. 340+40 (CENTERLINE)
 STA. 340+40 - STA. 344+25 (SOLID LT, DASHED RT)

MILLED RUMBLE STRIPS
 STA. 341+00 - STA. 344+25 (CENTERLINE)

6 INCH UNDERDRAIN PIPE
 STA. ~~341+50~~ - STA. 344+25 LT
 342+50

REMOVING SIGNS
 AS SHOWN - 3

ERECTING SALVAGED SIGNS
 AS SHOWN - 3

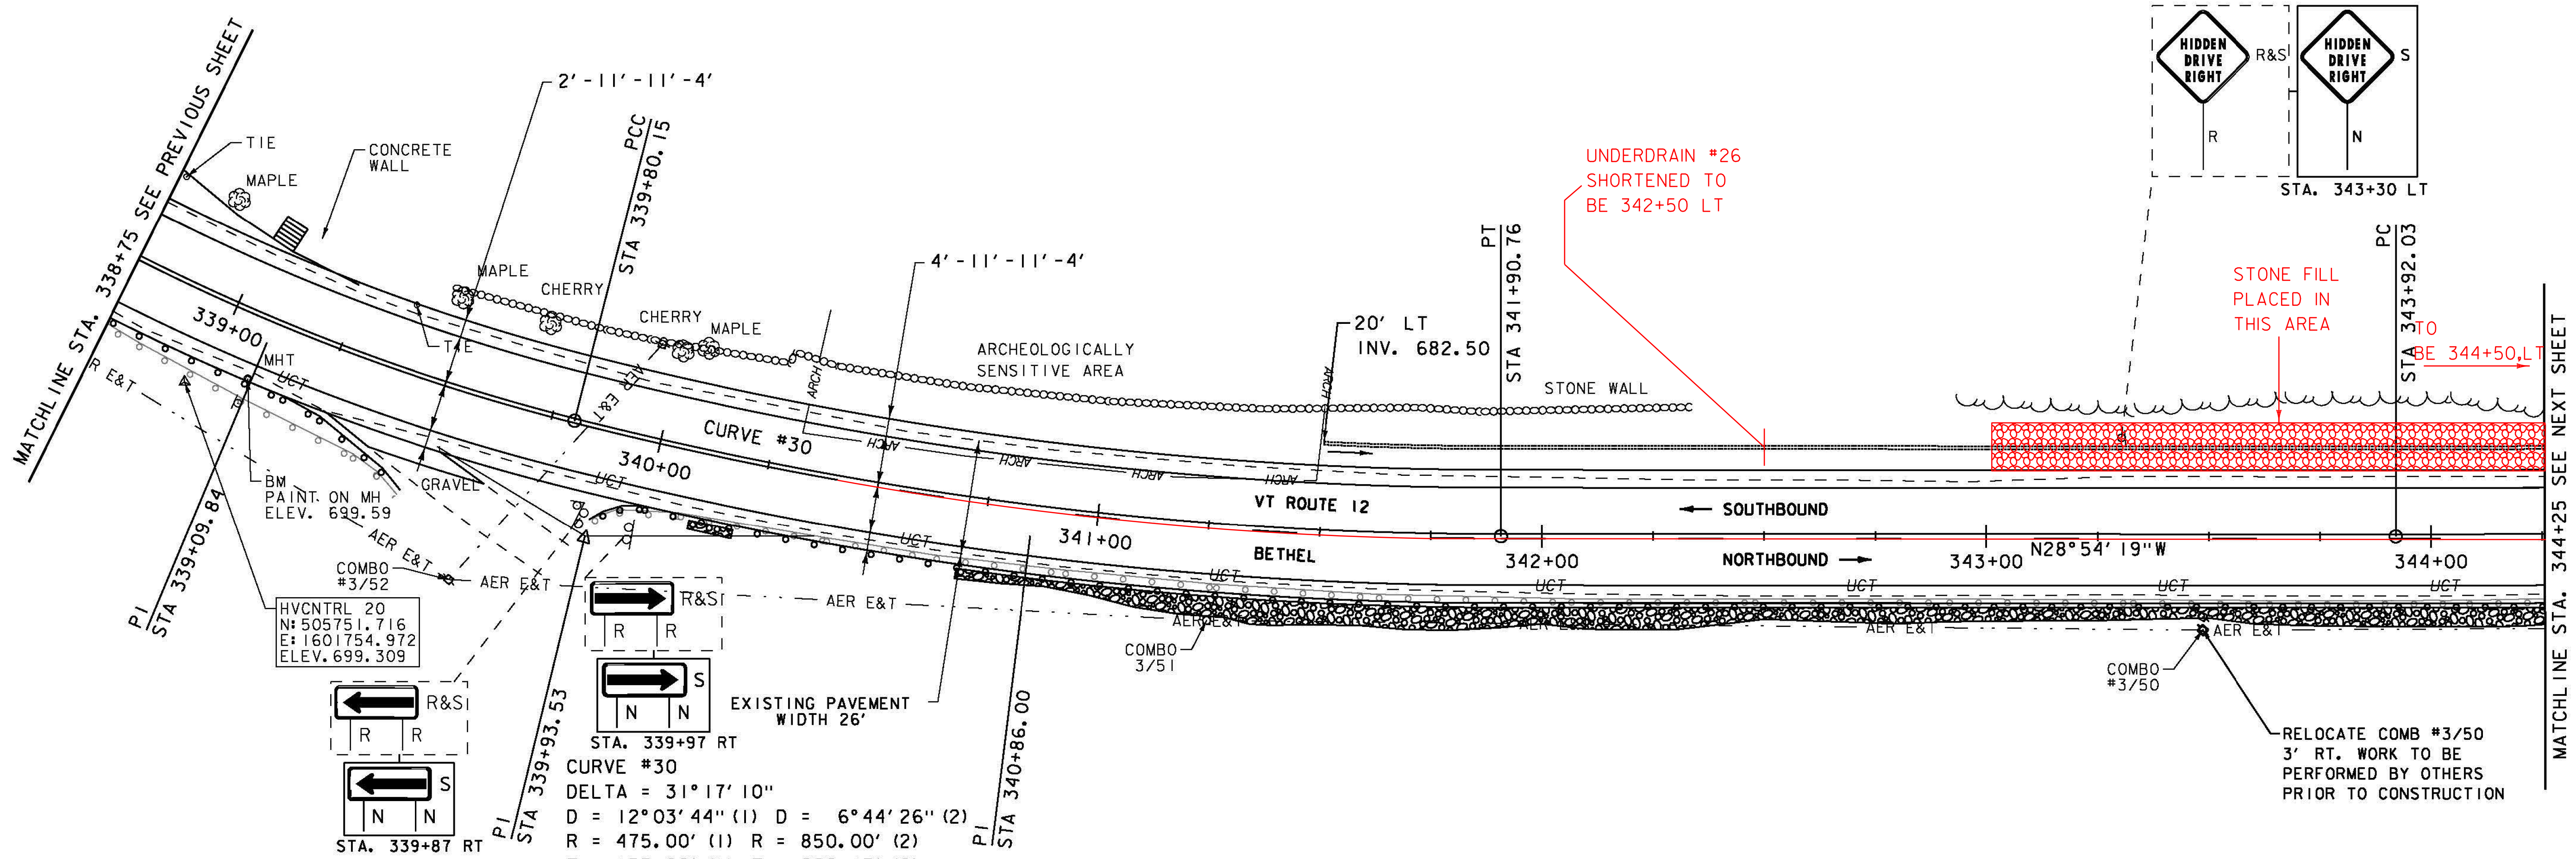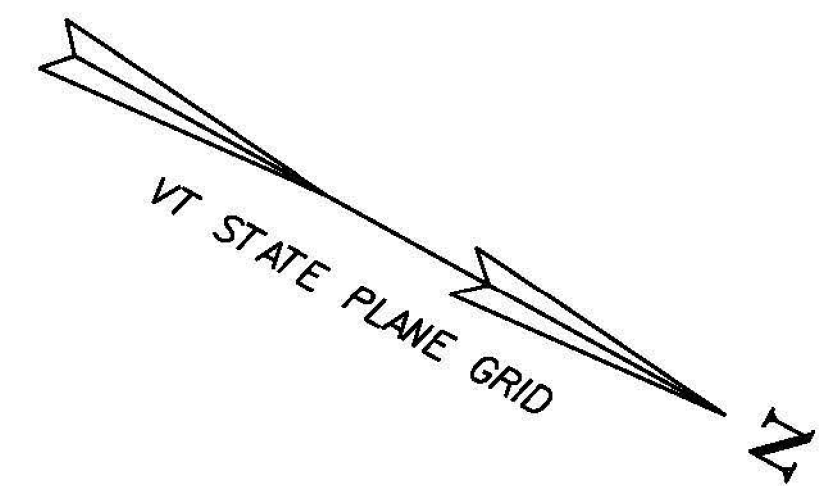

COMBO #3/52
 HVCNTRL 20
 N: 505751.716
 E: 1601754.972
 ELEV. 699.309

COMBO #3/51

COMBO #3/50

RELOCATE COMB #3/50
 3' RT. WORK TO BE
 PERFORMED BY OTHERS
 PRIOR TO CONSTRUCTION

EXISTING PAVEMENT
 WIDTH 26'

STA. 339+97 RT
 CURVE #30
 DELTA = 31°17'10"
 D = 12°03'44" (1) D = 6°44'26" (2)
 R = 475.00' (1) R = 850.00' (2)
 T = 155.06' (1) T = 206.13' (2)
 L = 141.68' (1) L = 210.61' (2)
 E = 24.67'
 BANKING 0.080 FT/FT, 0.080 FT/FT
 DESIGN SPEED 40 MPH
 SEE SUPERELEVATION DIAGRAMS
 FOR MORE INFORMATION

STONE FILL, TYPE I
 STA. 340+10 - STA. 340+20 RT
 STA. 340+70 - STA. 344+25 RT
 STA. 343+00 - STA. 344+25 LT

GEOTEXTILE FOR SILT FENCE
 STA. 340+10 - STA. 340+20 RT
 STA. 340+70 - STA. 344+25 RT



GRUBBING MATERIAL (6")
 STA. 340+10 - STA. 340+20 RT
 STA. 340+70 - STA. 344+25 RT

REMOVAL AND DISPOSAL OF GUARDRAIL
 STA. 338+75 - STA. 339+47 RT
 STA. 339+89 - STA. 344+25 RT

SPECIAL PROVISION (BOX BEAM GUARDRAIL W/7 FEET POSTS)
 STA. 338+75 - STA. 339+48 RT
 STA. ~~339+89~~ - STA. 344+25 RT
 339+85

SIGN LEGEND

R = REMOVE
 R&S = REMOVE AND SALVAGE
 RET = RETAIN
 S = SALVAGED
 N = NEW
 B-B = BACK TO BACK
 - - = EXISTING
 — = NEW

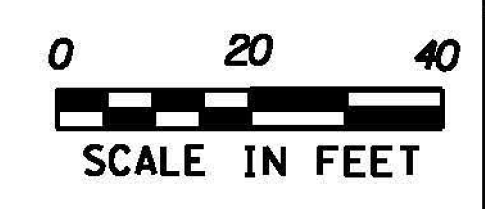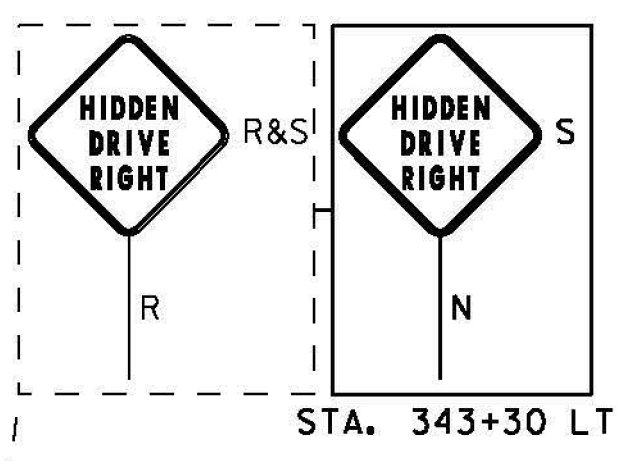

PROJECT NAME: BETHEL-RANDOLPH	PLOT DATE: 4/23/2015
PROJECT NUMBER: STP 292(I)	DRAWN BY: S. LAMPHERE
FILE NAME: z10c244bdr.dgn	CHECKED BY: C. LATHROP
DESIGNED BY: S. LAMPHERE	SHEET 66 OF 211
PLAN SHEET 40	