

DURABLE 4 INCH WHITE LINE, SEE OPTION ITEMS
 STA. 344+25 - STA. 350+25 (SOLID LT & RT)

TEMPORARY 4 INCH WHITE LINE, PAINT
 STA. 344+25 - STA. 350+25 (SOLID LT & RT)

~~DURABLE 4 INCH YELLOW LINE, POLYUREA
 STA. 344+25 - STA. 348+22 (SOLID LT, DASHED RT)
 STA. 348+22 - STA. 350+25 (DASHED RT)
 CENTERLINE~~



TEMPORARY 4 INCH YELLOW LINE, PAINT
 STA. 344+25 - STA. 348+22 (SOLID LT, DASHED RT)
 STA. 348+22 - STA. 350+25 (DASHED RT)

MILLED RUMBLE STRIPS
 STA. 344+25 - STA. 350+25 (CENTERLINE)

6 INCH UNDERDRAIN PIPE
 STA. 344+25 - STA. 345+00
 STA. 345+25 - STA. 349+50 LT
 349+75

REMOVING SIGNS
 AS SHOWN - 2

ERECTING SALVAGED SIGNS
 AS SHOWN - 1

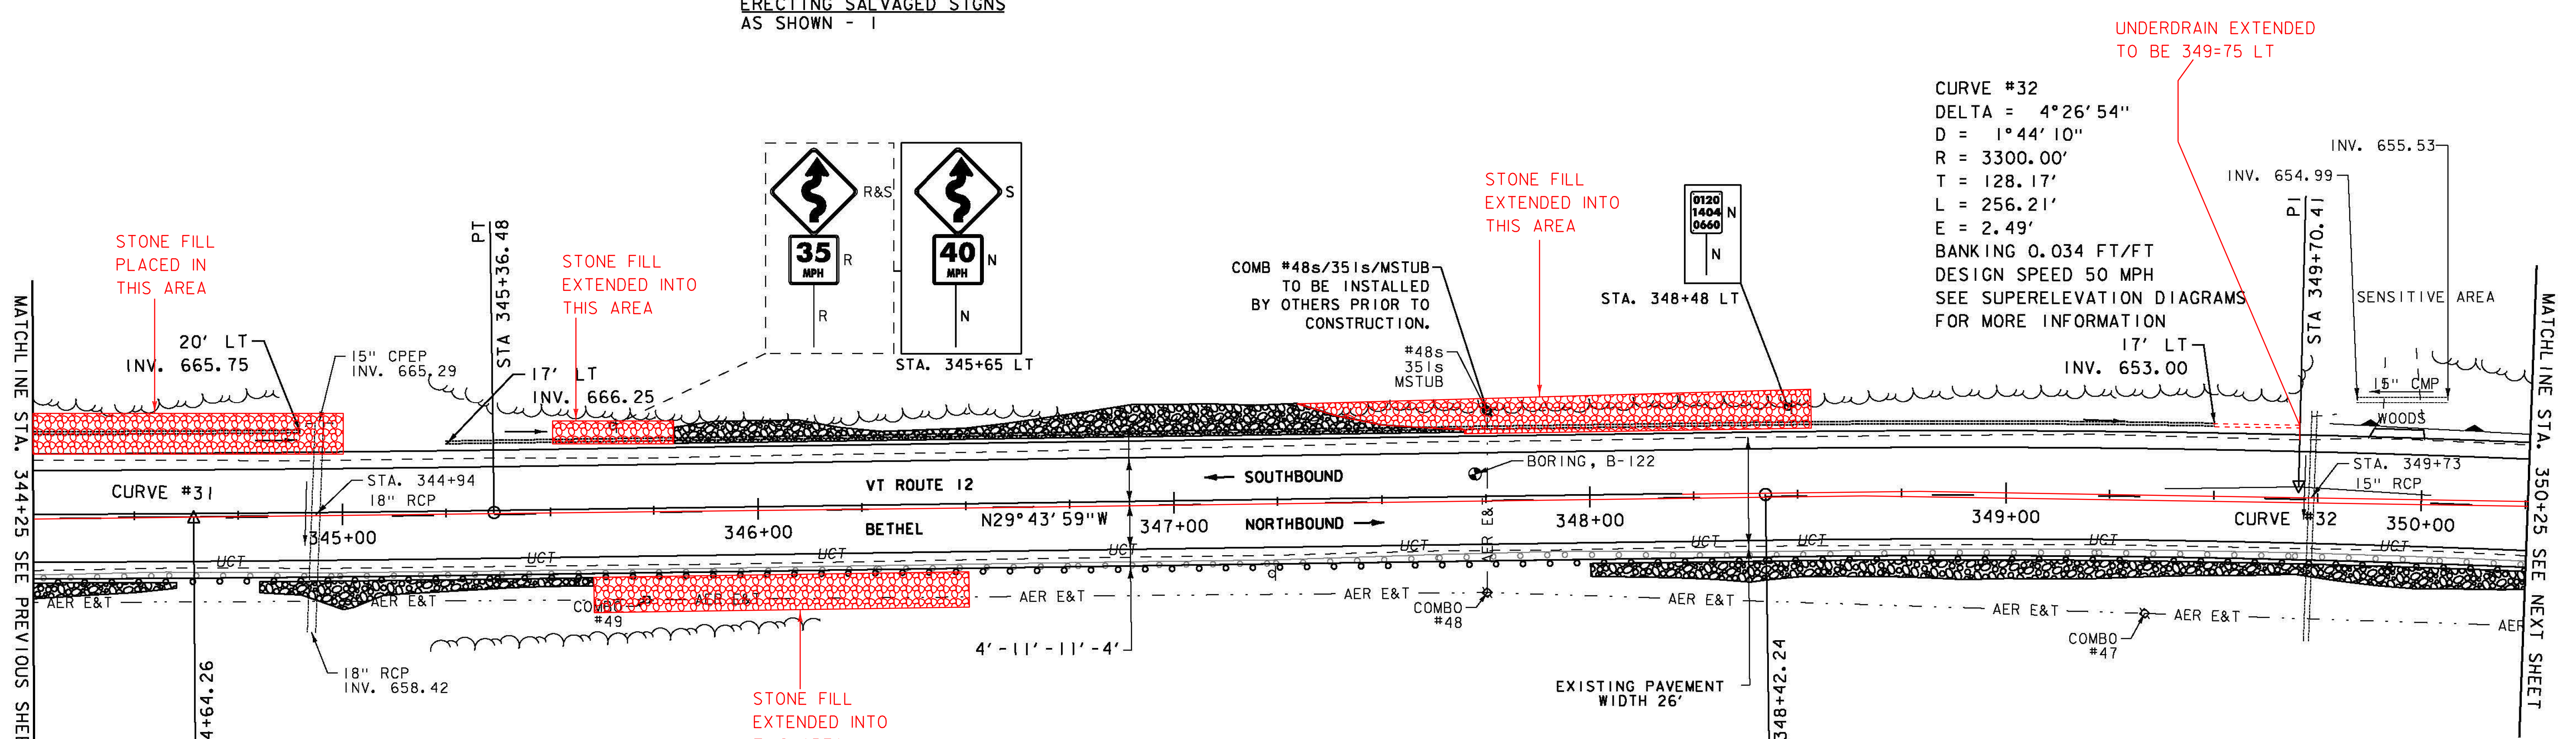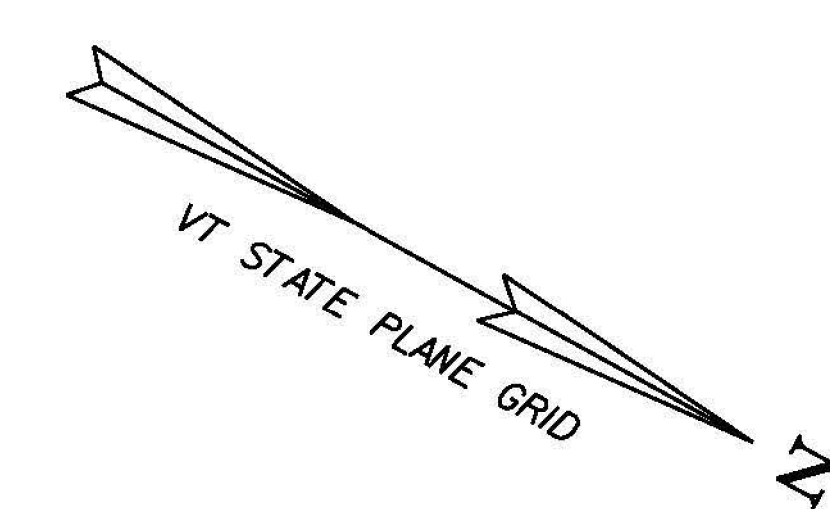

CURVE #32
 DELTA = 4°26'54"
 D = 1°44'10"
 R = 3300.00'
 T = 128.17'
 L = 256.21'
 E = 2.49'
 BANKING 0.034 FT/FT
 DESIGN SPEED 50 MPH
 SEE SUPERELEVATION DIAGRAMS
 FOR MORE INFORMATION

CURVE #31
 DELTA = 0°49'39"
 D = 0°34'23"
 R = 10000.00'
 T = 72.23'
 L = 144.45'
 E = 0.26'
 BANKING NORMAL CROWN
 DESIGN SPEED 50 MPH
 SEE SUPERELEVATION DIAGRAMS
 FOR MORE INFORMATION

REMOVAL AND DISPOSAL OF GUARDRAIL
 STA. 344+25 - STA. 350+25 RT

SPECIAL PROVISION (BOX BEAM GUARDRAIL W/7 FEET POSTS)
 STA. 344+25 - STA. 350+25 RT

SIGN LEGEND
 R = REMOVE
 R&S = REMOVE AND SALVAGE
 RET = RETAIN
 S = SALVAGED
 N = NEW
 B-B = BACK TO BACK
 - - = EXISTING
 — = NEW


STONE FILL, TYPE I
 STA. 344+25 - STA. 344+60 RT
 STA. 344+80 - STA. 345+60 RT 346+50
 STA. 345+80 - STA. 347+70 LT 348+50
 STA. 348+00 - STA. 350+25 RT
 STA. 344+25 - STA. 345+00 LT

GEOTEXTILE FOR SILT FENCE
 STA. 344+25 - STA. 344+60 RT
 STA. 344+80 - STA. 345+60 RT
 STA. 345+75 - STA. 347+70 LT
 STA. 347+95 - STA. 350+25 RT

GRUBBING MATERIAL (6")
 STA. 344+25 - STA. 344+60 RT
 STA. 344+80 - STA. 345+60 RT
 STA. 345+75 - STA. 347+70 LT
 STA. 347+95 - STA. 350+25 RT

ENVIRONMENTALLY SENSITIVE LOCATIONS:

NO.	LIMITS	POS.	TYPE
8.	STA. 349+77 - STA. 350+25	LT	-

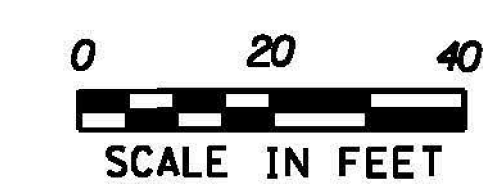

PROJECT NAME: BETHEL-RANDOLPH	PLOT DATE: 4/23/2015
PROJECT NUMBER: STP 292(I)	DRAWN BY: S. LAMPHERE
FILE NAME: z10c244bdr.dgn	CHECKED BY: C. LATHROP
DESIGNED BY: S. LAMPHERE	SHEET 67 OF 211
PLAN SHEET 41	