


DURABLE 4 INCH WHITE LINE, SEE OPTION ITEMS
 STA. 350+25 - STA. 355+50 (SOLID LT & RT)

TEMPORARY 4 INCH WHITE LINE, PAINT
 STA. 350+25 - STA. 355+50 (SOLID LT & RT)

³⁵⁰⁺⁵⁸
 6 INCH UNDERDRAIN PIPE
 STA. ~~350+70~~ - STA. 353+00 LT
 STA. ~~353+16~~ - STA. 355+50 LT
 353+20

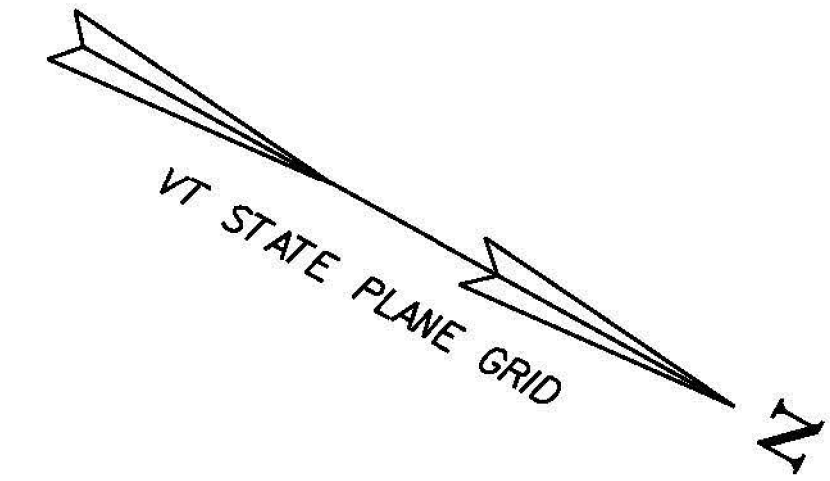


~~DURABLE 4 INCH YELLOW LINE, POLYUREA~~
~~STA. 350+25 - STA. 351+90 (DASHED RT)~~
 STA. ~~351+90~~ - STA. 355+50 (~~DASHED LT, SOLID RT~~)
 350+25 CENTERLINE

TEMPORARY 4 INCH YELLOW LINE, PAINT
 STA. 350+25 - STA. 351+90 (DASHED RT)
 STA. 351+90 - STA. 355+50 (DASHED LT, SOLID RT)

MILLED RUMBLE STRIPS
 STA. 350+25 - STA. 355+50 (CENTERLINE)

ENVIRONMENTALLY SENSITIVE LOCATIONS:

NO.	LIMITS	POS.	TYPE
8.	STA. 350+25 - STA. 350+64	LT	-

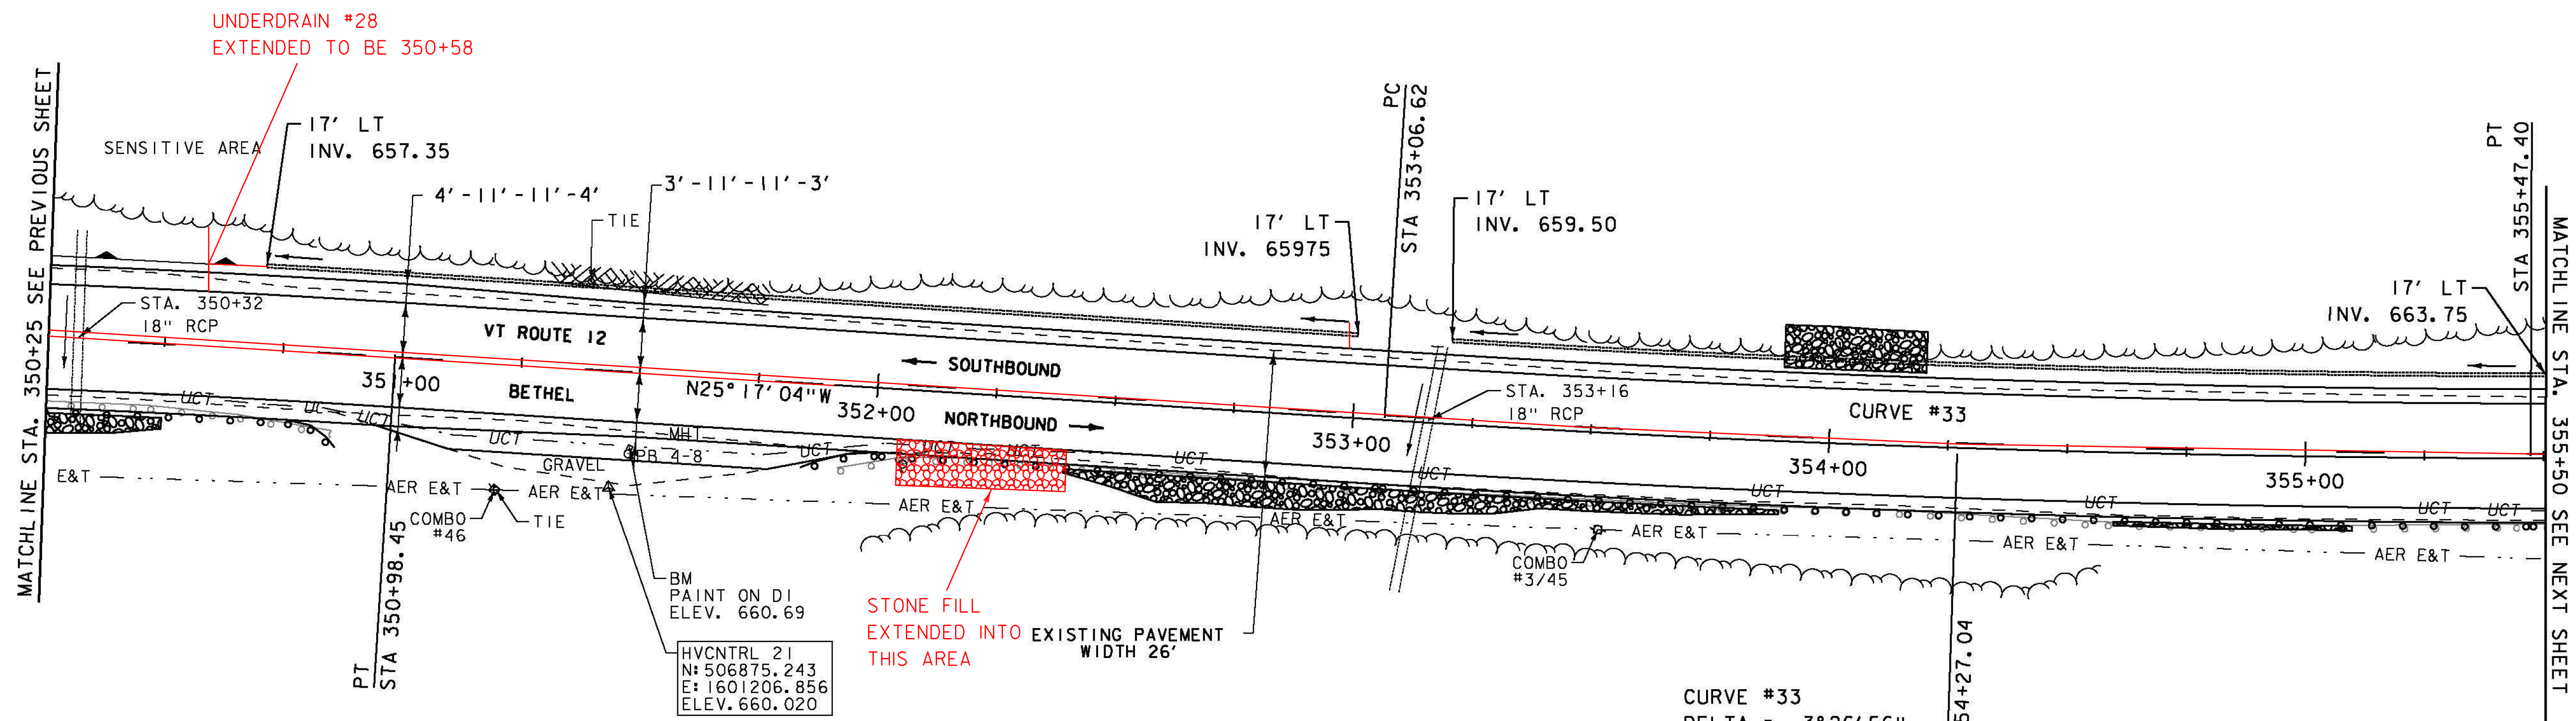

CURVE #33
 DELTA = 3°26'56"
 D = 1°25'57"
 R = 4000.00'
 T = 120.43'
 L = 240.78'
 E = 1.81'
 BANKING 0.029 FT/FT
 DESIGN SPEED 50 MPH
 SEE SUPERELEVATION DIAGRAMS
 FOR MORE INFORMATION

SOLID ROCK EXCAVATION

STA. ~~351+00~~ - STA. 355+50 LT
 350+70

REMOVAL AND DISPOSAL OF GUARDRAIL

STA. 350+25 - STA. 350+86 RT
 STA. 351+92.5 - STA. 355+50 RT

SPECIAL PROVISION (BOX BEAM GUARDRAIL W/7 FEET POSTS)

STA. 350+25 - STA. 350+86 RT
 STA. 351+86 - STA. 355+50 RT

STONE FILL, TYPE I

STA. 350+25 - STA. 350+50 RT
 352+04 STA. ~~352+40~~ - STA. 353+90 RT
 STA. 353+90 - STA. 354+20 LT
 STA. 354+60 - STA. 355+10 RT

GEOTEXTILE FOR SILT FENCE


STA. 350+25 - STA. 350+50 RT
 STA. 352+40 - STA. 353+90 RT
 STA. 353+90 - STA. 354+20 LT
 STA. 354+60 - STA. 355+10 RT

GRUBBING MATERIAL (6")

STA. 350+25 - STA. 350+50 RT
 STA. 352+40 - STA. 353+90 RT
 STA. 353+90 - STA. 354+20 LT
 STA. 354+60 - STA. 355+10 RT

SIGN LEGEND

- R = REMOVE
- R&S = REMOVE AND SALVAGE
- RET = RETAIN
- S = SALVAGED
- N = NEW
- B-B = BACK TO BACK
- - = EXISTING
- = NEW

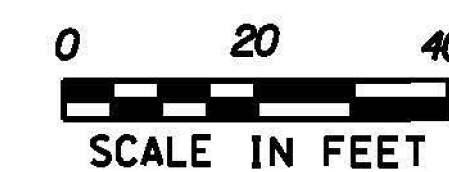

PROJECT NAME: BETHEL-RANDOLPH	PLOT DATE: 4/23/2015
PROJECT NUMBER: STP 292(I)	DRAWN BY: S. LAMPHERE
FILE NAME: z10c244bdr.dgn	CHECKED BY: C. LATHROP
PROJECT LEADER: C. LATHROP	SHEET 68 OF 211
DESIGNED BY: S. LAMPHERE	
PLAN SHEET 42	