

DURABLE 4 INCH WHITE LINE, SEE OPTION ITEMS
 STA. 355+50 - STA. 361+25 (SOLID LT & RT)

TEMPORARY 4 INCH WHITE LINE, PAINT
 STA. 355+50 - STA. 361+25 (SOLID LT & RT)

DURABLE 4 INCH YELLOW LINE, POLYUREA
~~STA. 355+50 - STA. 357+10 (DASHED LT, SOLID RT)~~
 STA. ~~357+10~~ - STA. 361+25 (CENTERLINE)
 355+50

TEMPORARY 4 INCH YELLOW LINE, PAINT
 STA. 355+50 - STA. 357+10 (DASHED LT, SOLID RT)
 STA. 357+10 - STA. 361+25 (CENTERLINE)

MILLED RUMBLE STRIPS
 STA. 355+50 - STA. 361+25 (CENTERLINE)

SOLID ROCK EXCAVATION
 STA. 355+50 - STA. 357+60 LT



6 INCH UNDERDRAIN PIPE
 STA. 355+67 - STA. 358+50 LT
 STA. 358+65 - STA. 360+00 LT
 STA. 360+00 - STA. 361+25 LT

PRECAST REINFORCED CONCRETE
DROP INLET WITH CAST IRON GRATE
 STA. 358+65 LT

15" RCP CLASS IV
 STA. 358+65 LT ~~3.0'~~
 7.5'

(11) INSTALL NEW DI WITH CAST IRON GRATE (TYPE A)
 STA. 358+65 LT 21.0'
 EXTEND 15" RCP 3.0' LT
 MATCH EXISTING SLOPE AND CONNECT TO NEW DI
 6" UD EL. IN = 672.50
 NEW 7.5'X15" RCP CULV.

STONE FILL PLACED IN THIS AREA

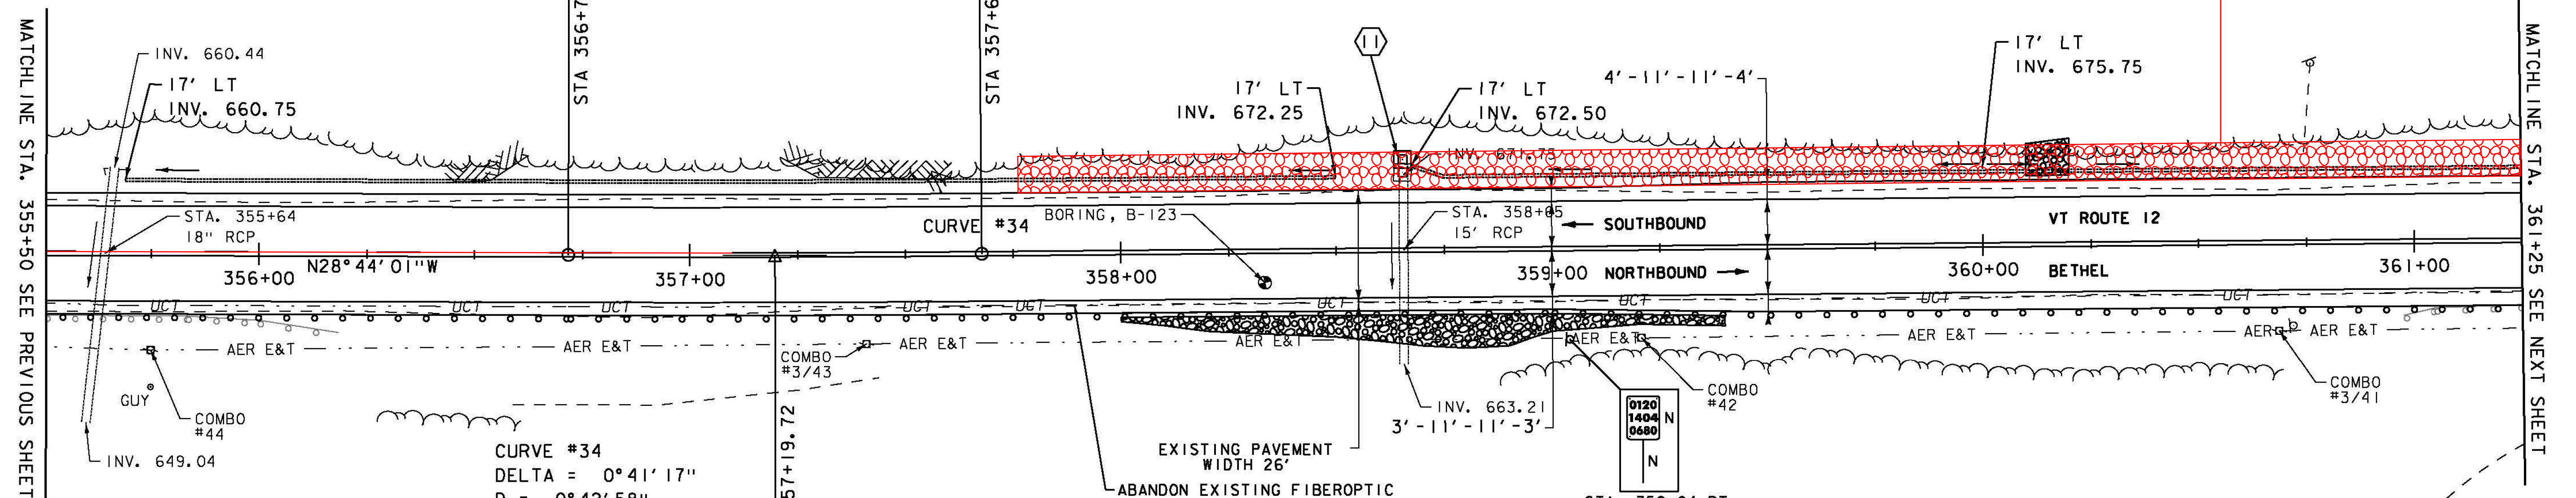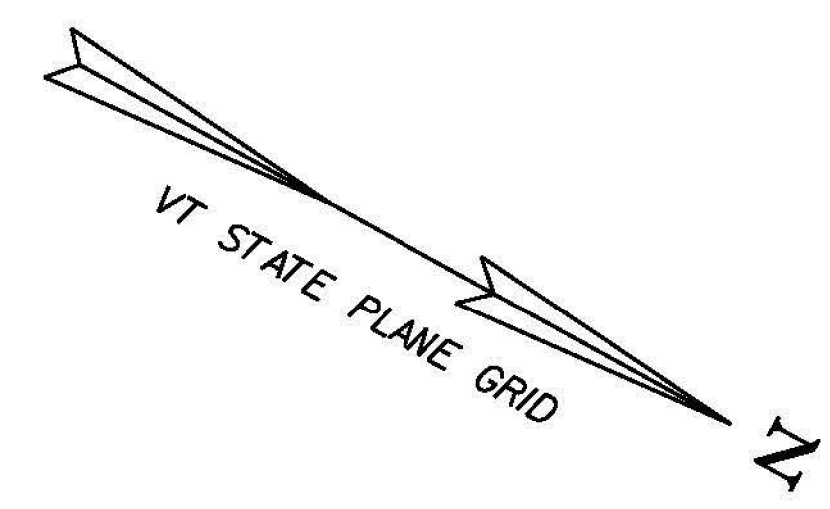

CURVE #34
 DELTA = 0°41'17"
 D = 0°42'58"
 R = 8000.00'
 T = 48.04'
 L = 96.08'
 E = 0.14'
 BANKING NORMAL CROWN
 DESIGN SPEED 50 MPH
 SEE SUPERELEVATION DIAGRAMS
 FOR MORE INFORMATION

STONE FILL, TYPE I
 STA. 358+00 - STA. 359+40 RT
 STA. ~~360+10~~ - STA. ~~360+20~~ LT
 STA. ~~357+75~~ - STA. ~~361+25~~ LT


REMOVAL AND DISPOSAL OF GUARDRAIL
 STA. 355+50 - STA. 356+18.5 RT
 STA. 360+97.5 - STA. 361+25 RT

SPECIAL PROVISION (BOX BEAM GUARDRAIL W/7 FEET POSTS)
 STA. 355+50 - STA. 361+25 RT

GEOTEXTILE FOR SILT FENCE
 STA. 358+00 - STA. 359+40 RT
 STA. 360+10 - STA. 360+20 LT

GRUBBING MATERIAL (6")
 STA. 358+00 - STA. 359+40 RT
 STA. 360+10 - STA. 360+20 LT

SIGN LEGEND
 R = REMOVE
 R&S = REMOVE AND SALVAGE
 RET = RETAIN
 S = SALVAGED
 N = NEW
 B-B = BACK TO BACK
 - - = EXISTING
 — = NEW

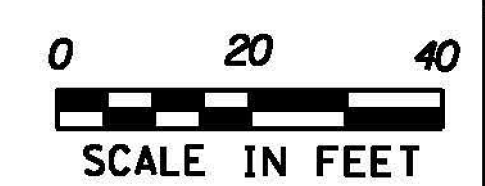

PROJECT NAME: BETHEL-RANDOLPH
 PROJECT NUMBER: STP 292(1)
 FILE NAME: z10c244bdr.dgn
 PROJECT LEADER: C. LATHROP
 DESIGNED BY: S. LAMPHERE
 PLAN SHEET 43
 PLOT DATE: 4/23/2015
 DRAWN BY: S. LAMPHERE
 CHECKED BY: C. LATHROP
 SHEET 69 OF 211