

STONE FILL, TYPE I
 STA. 361+25 - STA. 361+70 LT
 STA. 362+00 - STA. 363+00 LT

DURABLE 4 INCH WHITE LINE, SEE OPTION ITEMS
 STA. 361+25 - STA. 366+75 (SOLID LT & RT)

TEMPORARY 4 INCH WHITE LINE, PAINT
 STA. 361+25 - STA. 366+75 (SOLID LT & RT)

STEEL BEAM GUARDRAIL, GALVANIZED
 STA. 362+62.5 - STA. 362+87.5 LT
 STA. 363+87.5 - STA. 364+12.5 LT

DURABLE 4 INCH YELLOW LINE, POLYUREA
 STA. 361+25 - STA. 366+75 (CENTERLINE)

TEMPORARY 4 INCH YELLOW LINE, PAINT
 STA. 361+25 - STA. 366+75 (CENTERLINE)

MILLED RUMBLE STRIPS
 STA. 361+25 - STA. 364+00 (CENTERLINE)

6 INCH UNDERDRAIN PIPE
 STA. 361+25 - STA. 363+00 LT
 STA. 363+00 - STA. 366+75 LT
 STA. 366+60 - STA. 366+75 LT

STEEL BEAM GUARDRAIL, GALVANIZED W/8 FEET POSTS
 STA. 363+62.5 - STA. 363+87.5 LT
 STA. 362+87.5 - STA. 363+37.5 LT

REMOVAL AND DISPOSAL OF GUARDRAIL
 STA. 361+25 - STA. 363+61.5 RT
 STA. 366+09 - STA. 366+75 RT

ANCHOR FOR STEEL BEAM GUARDRAIL
 STA. 362+75 LT
 STA. 364+00 LT

STEEL BEAM GUARDRAIL, NESTED W/8 FEET POSTS
 STA. 363+37.5 - STA. 363+62.5 LT

SPECIAL PROVISION (BOX BEAM GUARDRAIL W/7 FEET POSTS)

STA. 361+25 - STA. 363+68 RT
 STA. 361+75 - STA. 365+05 LT
 STA. 366+12 - STA. 366+75 RT

REHAB. DROP INLETS, CATCH BASINS, OR MANHOLES, CLASS I
 STA. 366+63 LT


SPECIAL PROVISION (CORING CONCRETE)
 STA. 366+63 (CORE INTO DROP INLET)

ENVIRONMENTALLY SENSITIVE LOCATIONS:


NO.	LIMITS	POS.	TYPE
10.	STA. 362+99 - STA. 365+86	LT	-

EXISTING DRIVE PIPE
 STA. 365+45 - STA. 366+05 LT

EXISTING DRIVE
 STA. 365+50 - STA. 366+00 LT

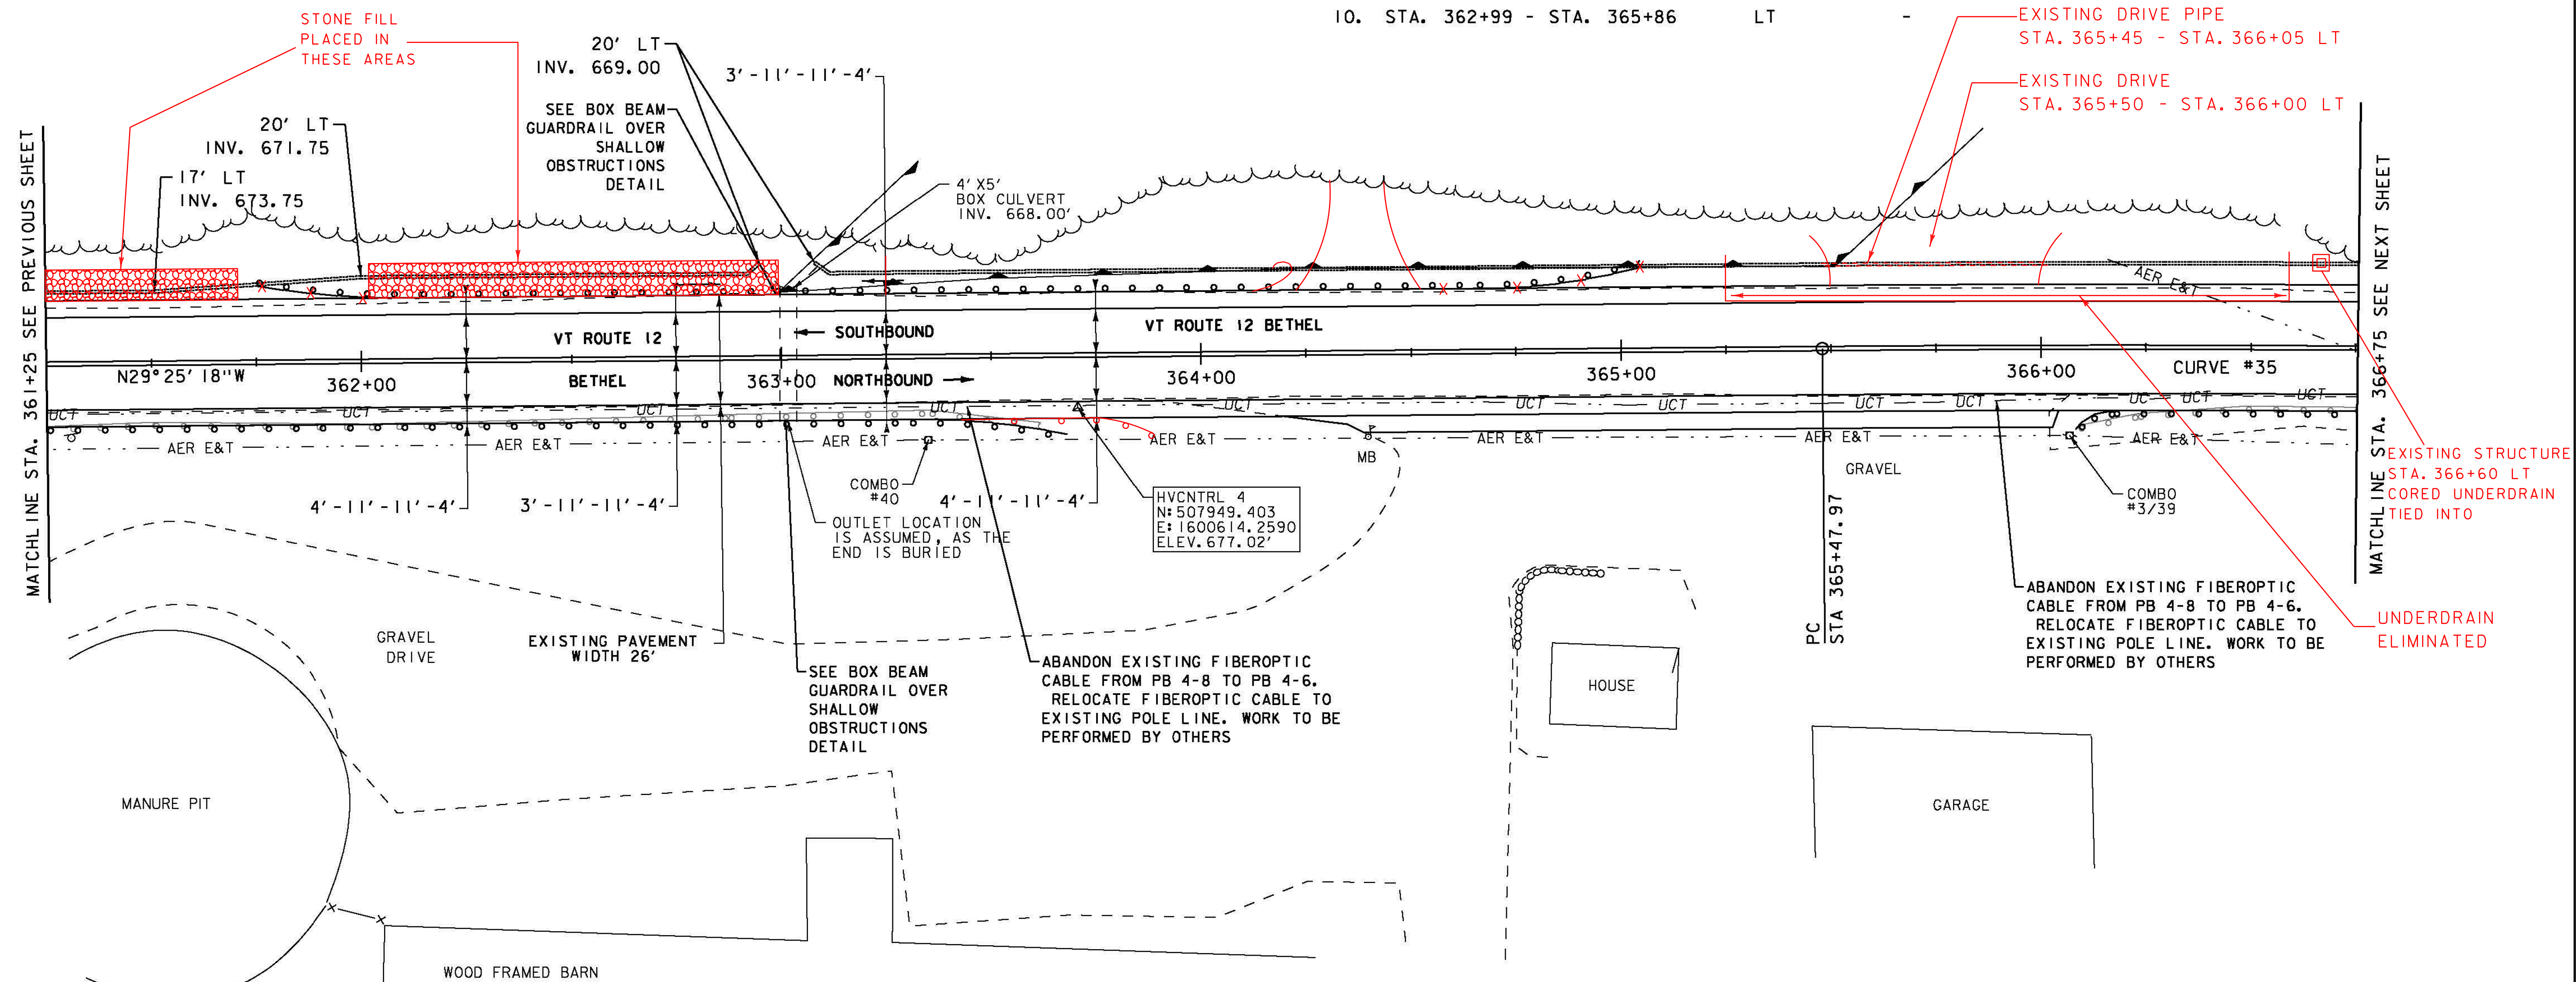

SIGN LEGEND
 R = REMOVE
 R&S = REMOVE AND SALVAGE
 RET = RETAIN
 S = SALVAGED
 N = NEW
 B-B = BACK TO BACK
 - - = EXISTING
 — = NEW

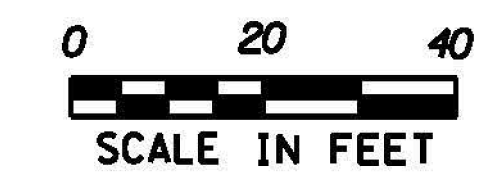

PROJECT NAME: BETHEL-RANDOLPH	PROJECT NUMBER: STP 292(I)
FILE NAME: z10c244bdr.dgn	PLOT DATE: 4/23/2015
PROJECT LEADER: C. LATHROP	DRAWN BY: S. LAMPHERE
DESIGNED BY: S. LAMPHERE	CHECKED BY: C. LATHROP
PLAN SHEET 44	SHEET 70 OF 211

